


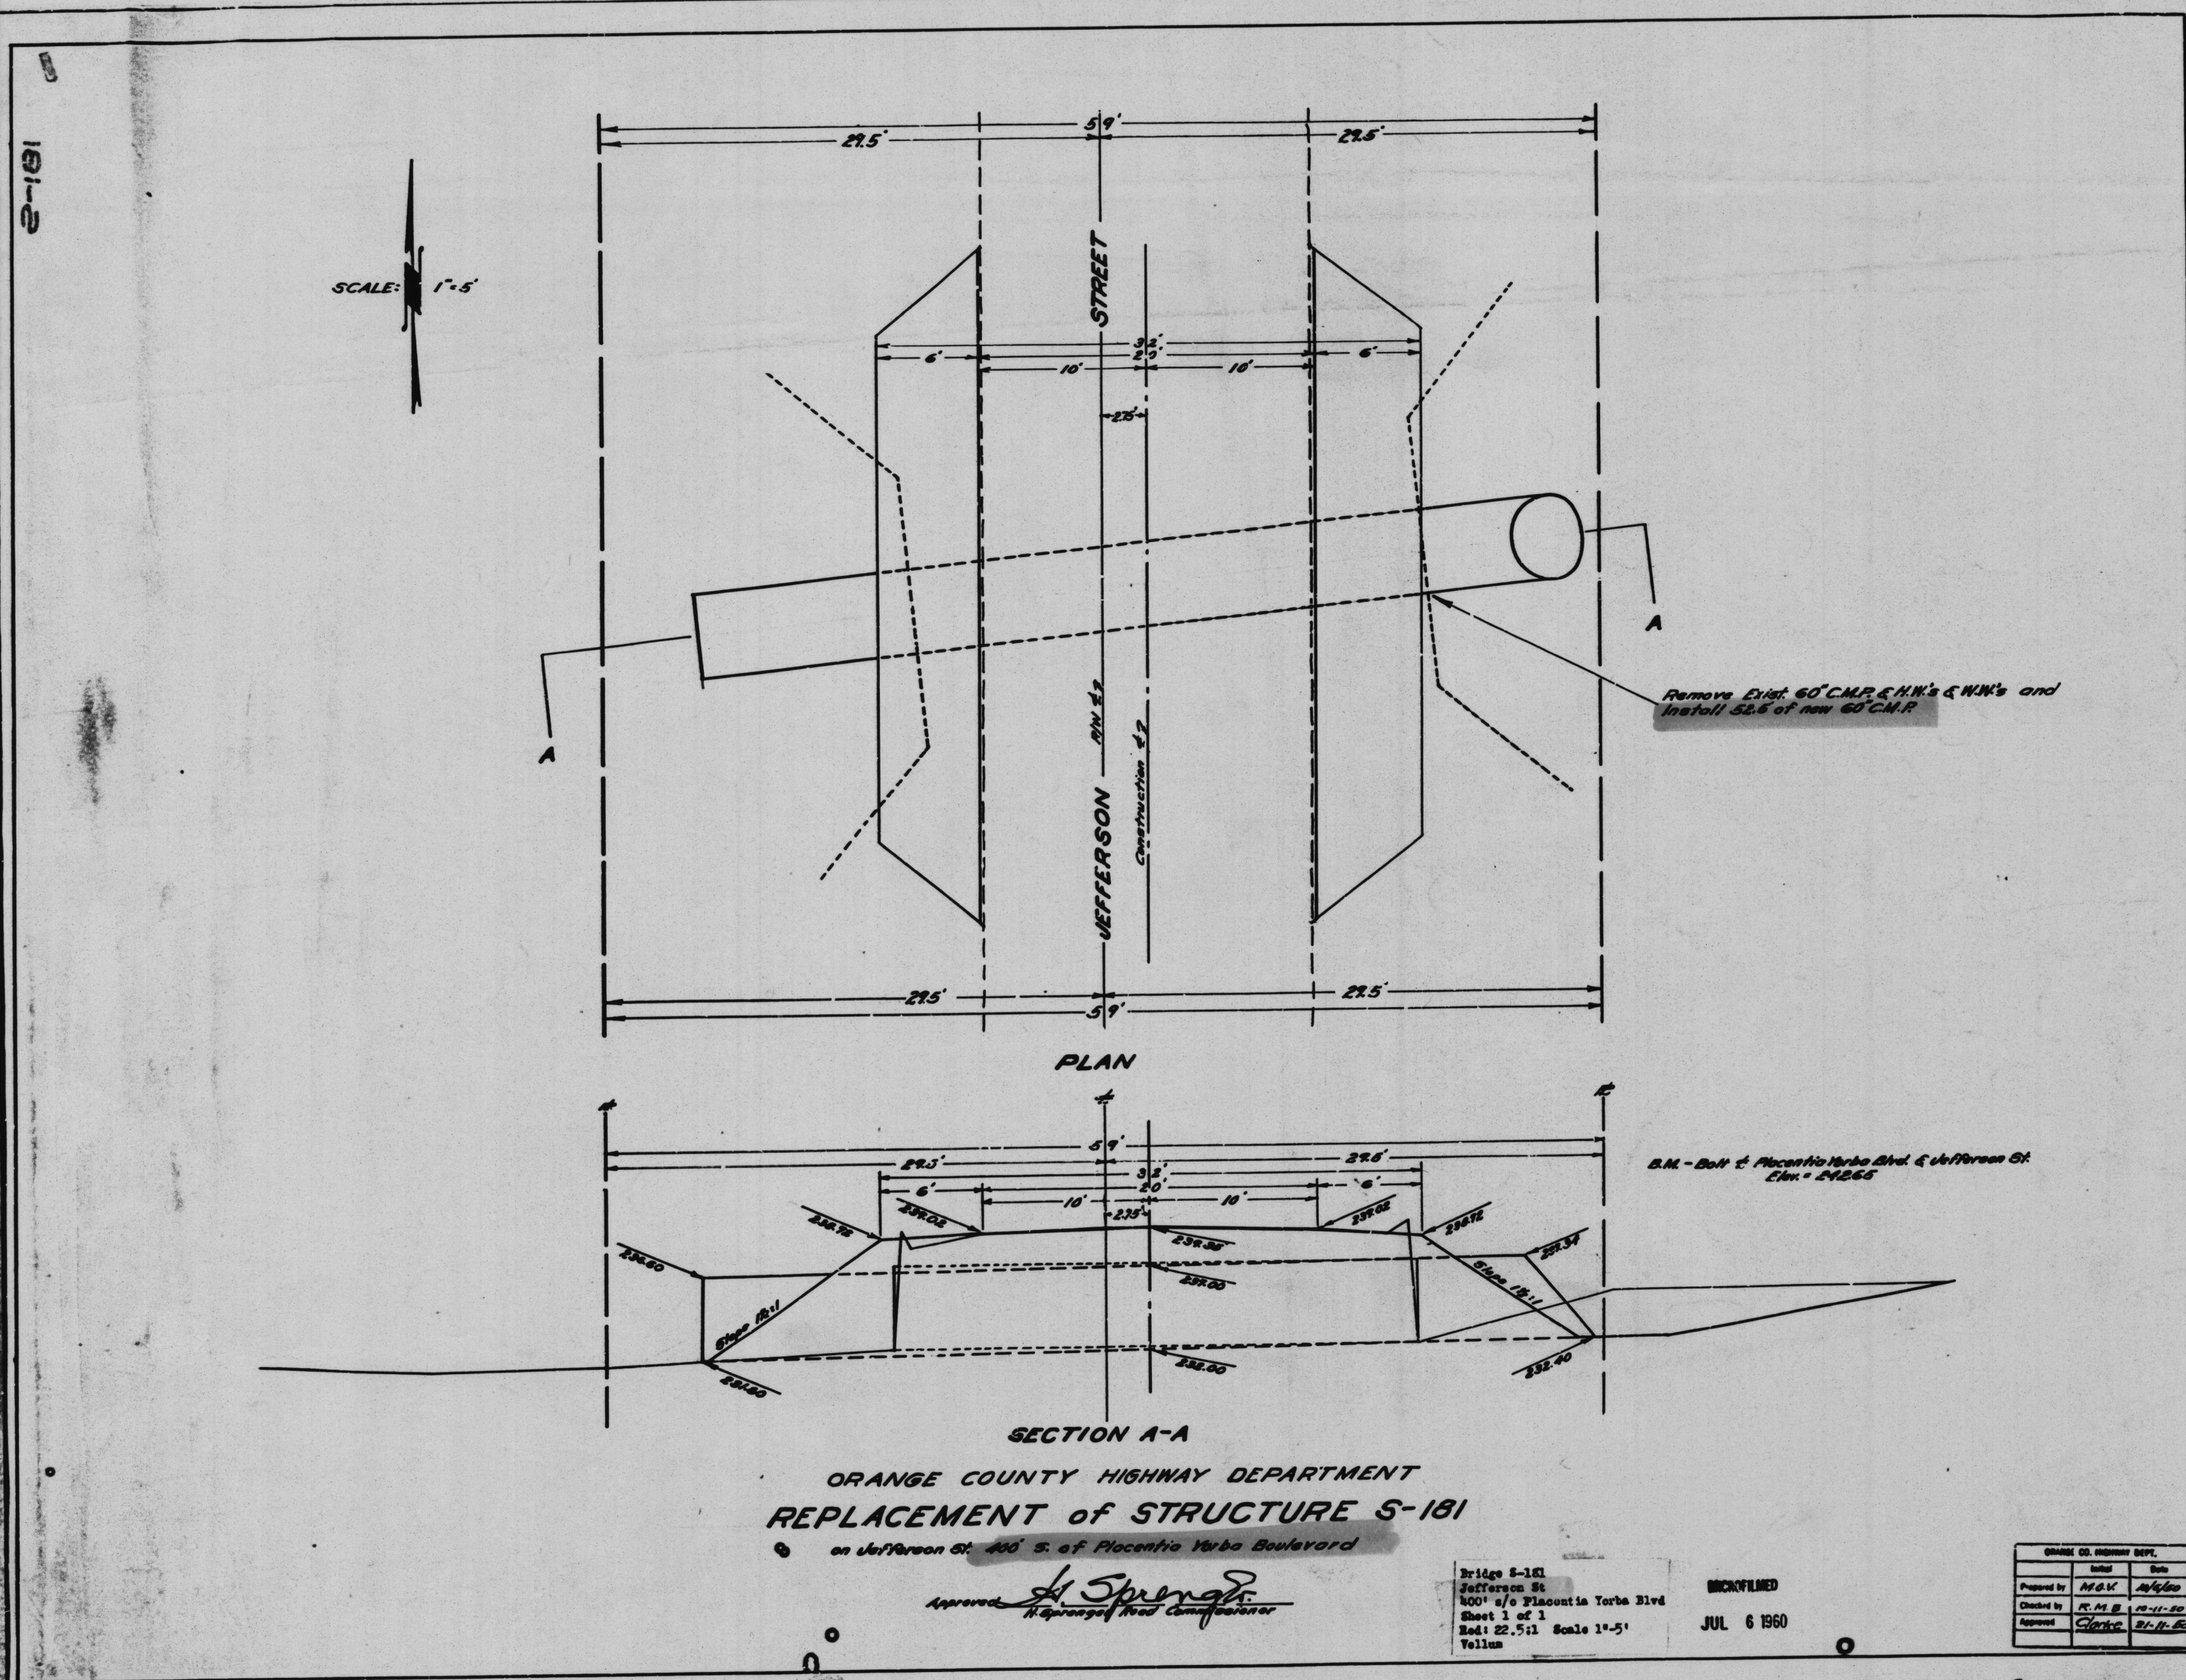

#14675 1950
S-181
JEFFERSON ST.
400' S. of Piacentia Yorda Blvd.
Thom: 739-J4