
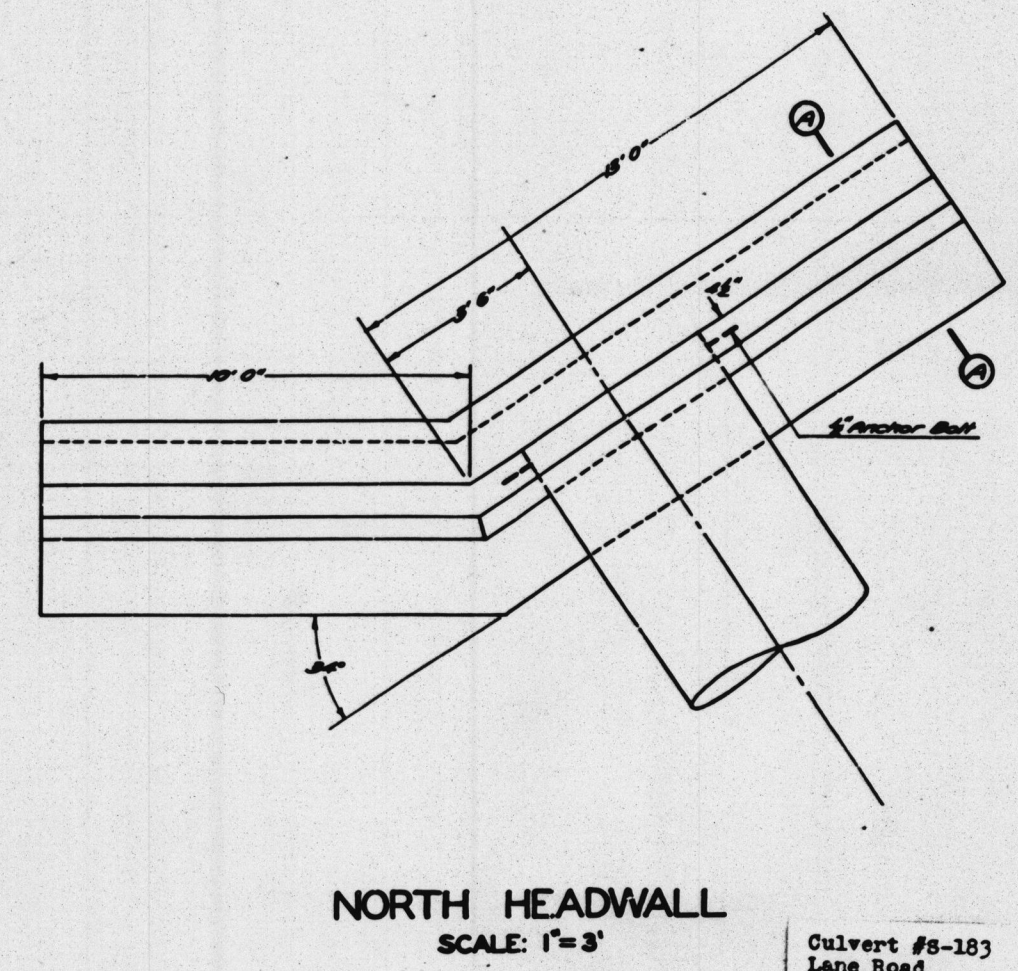
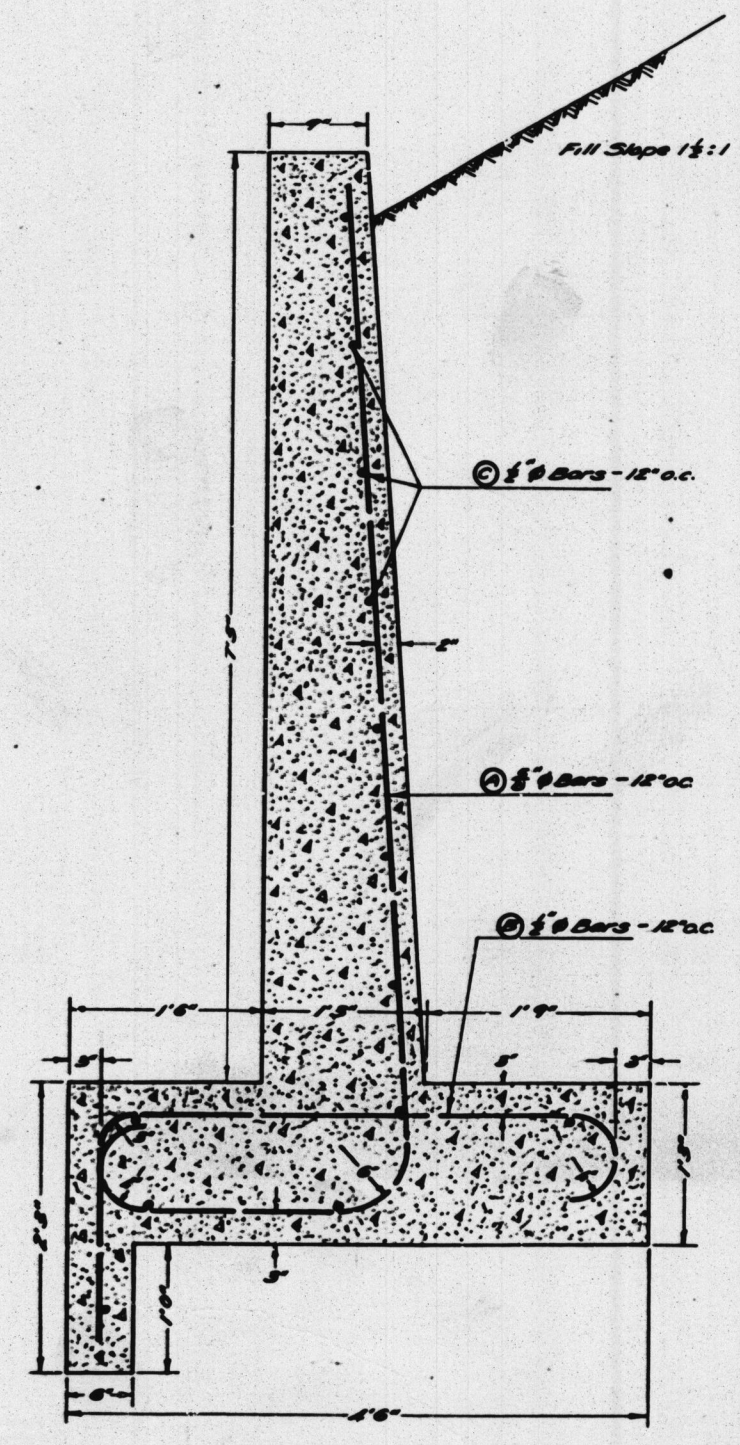
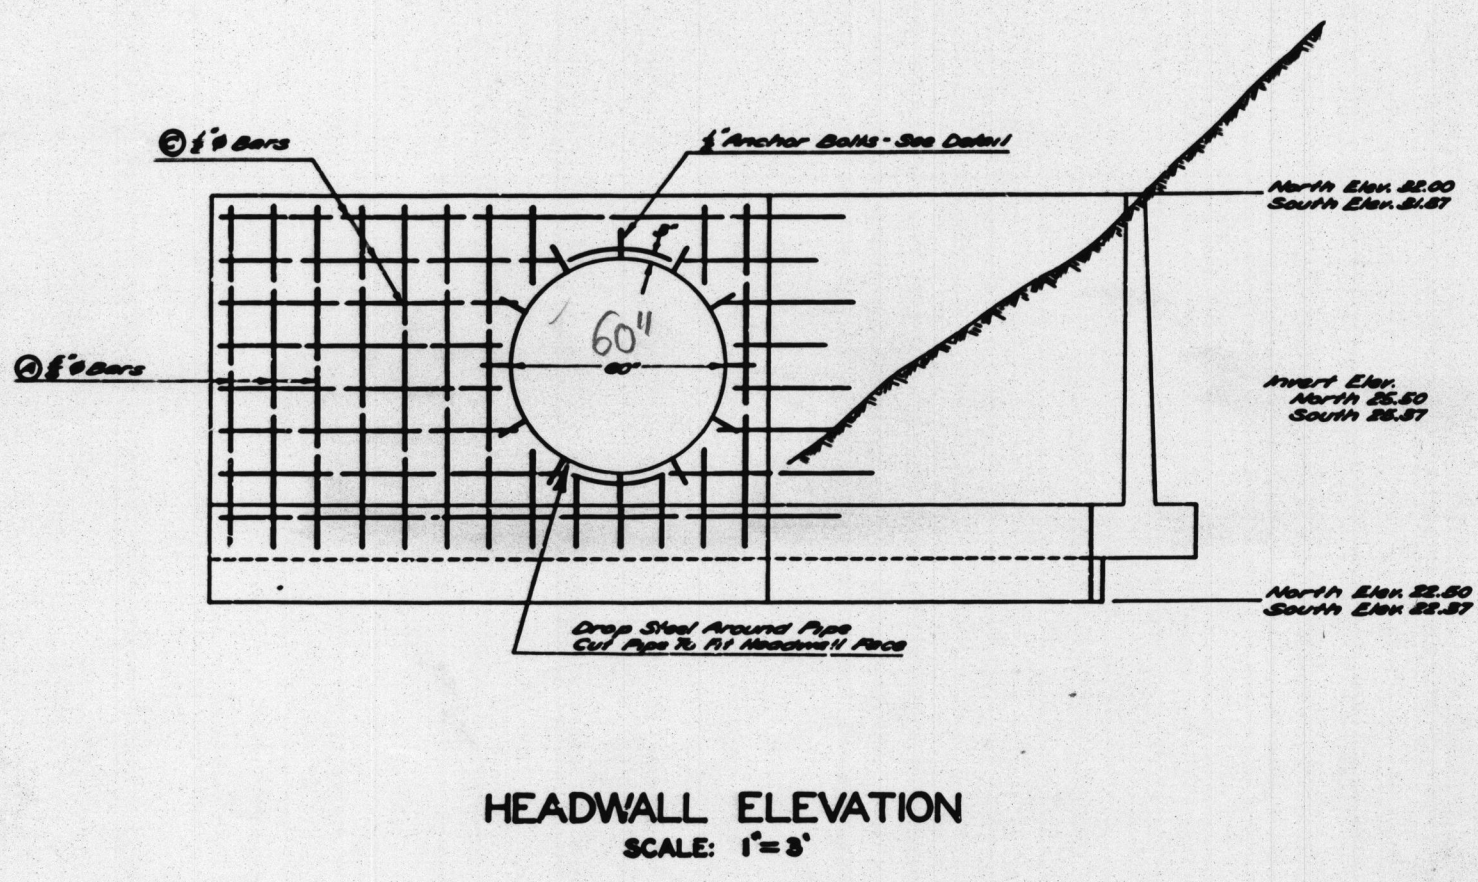
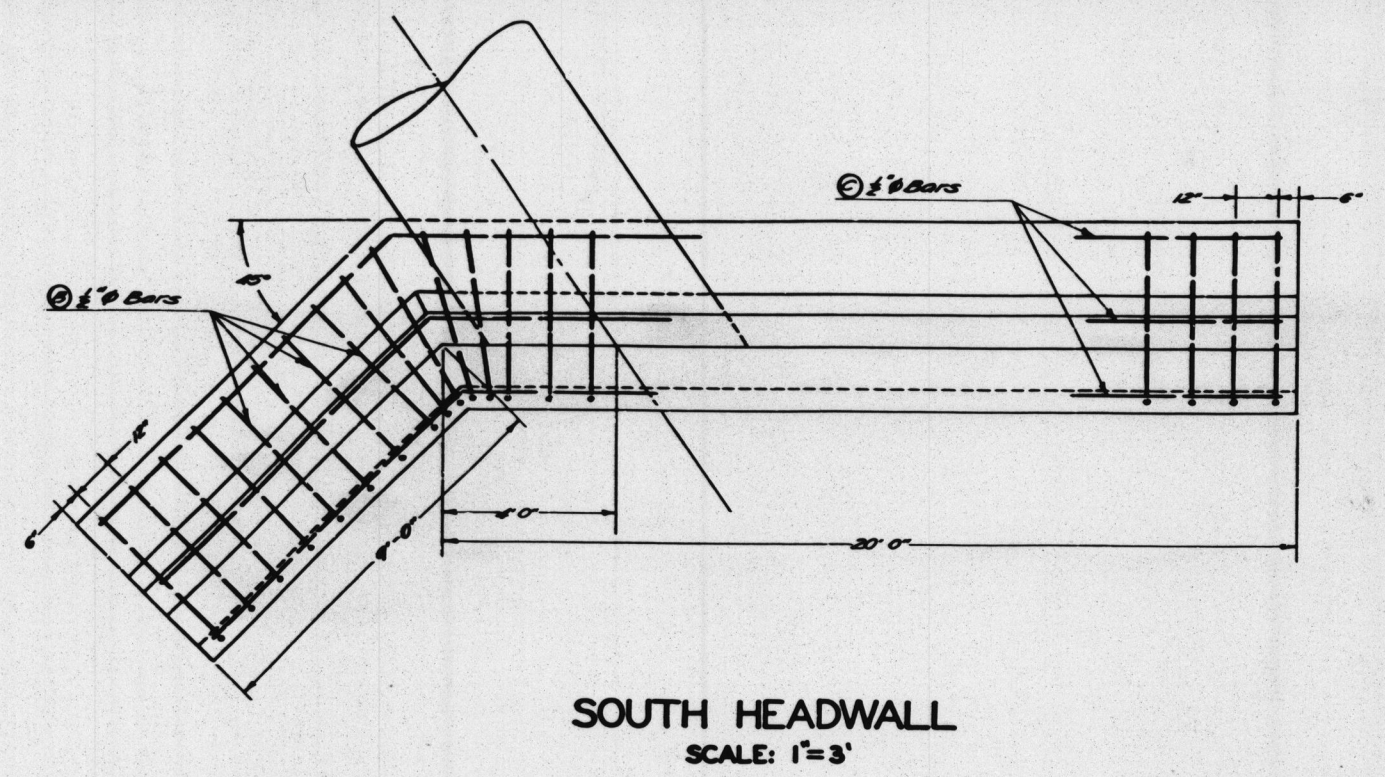
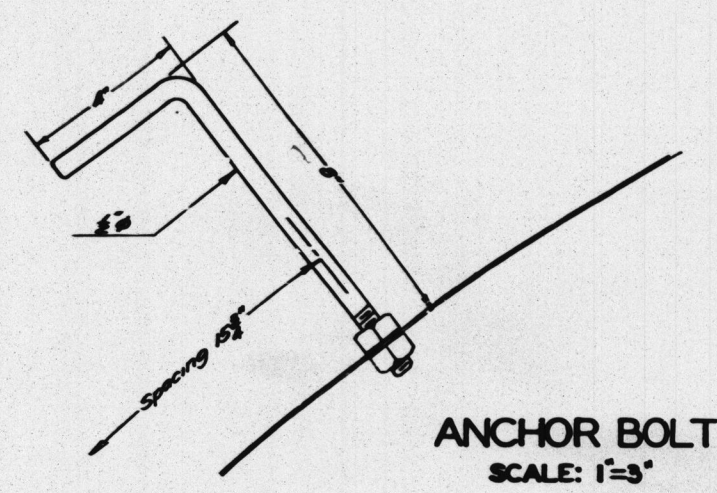


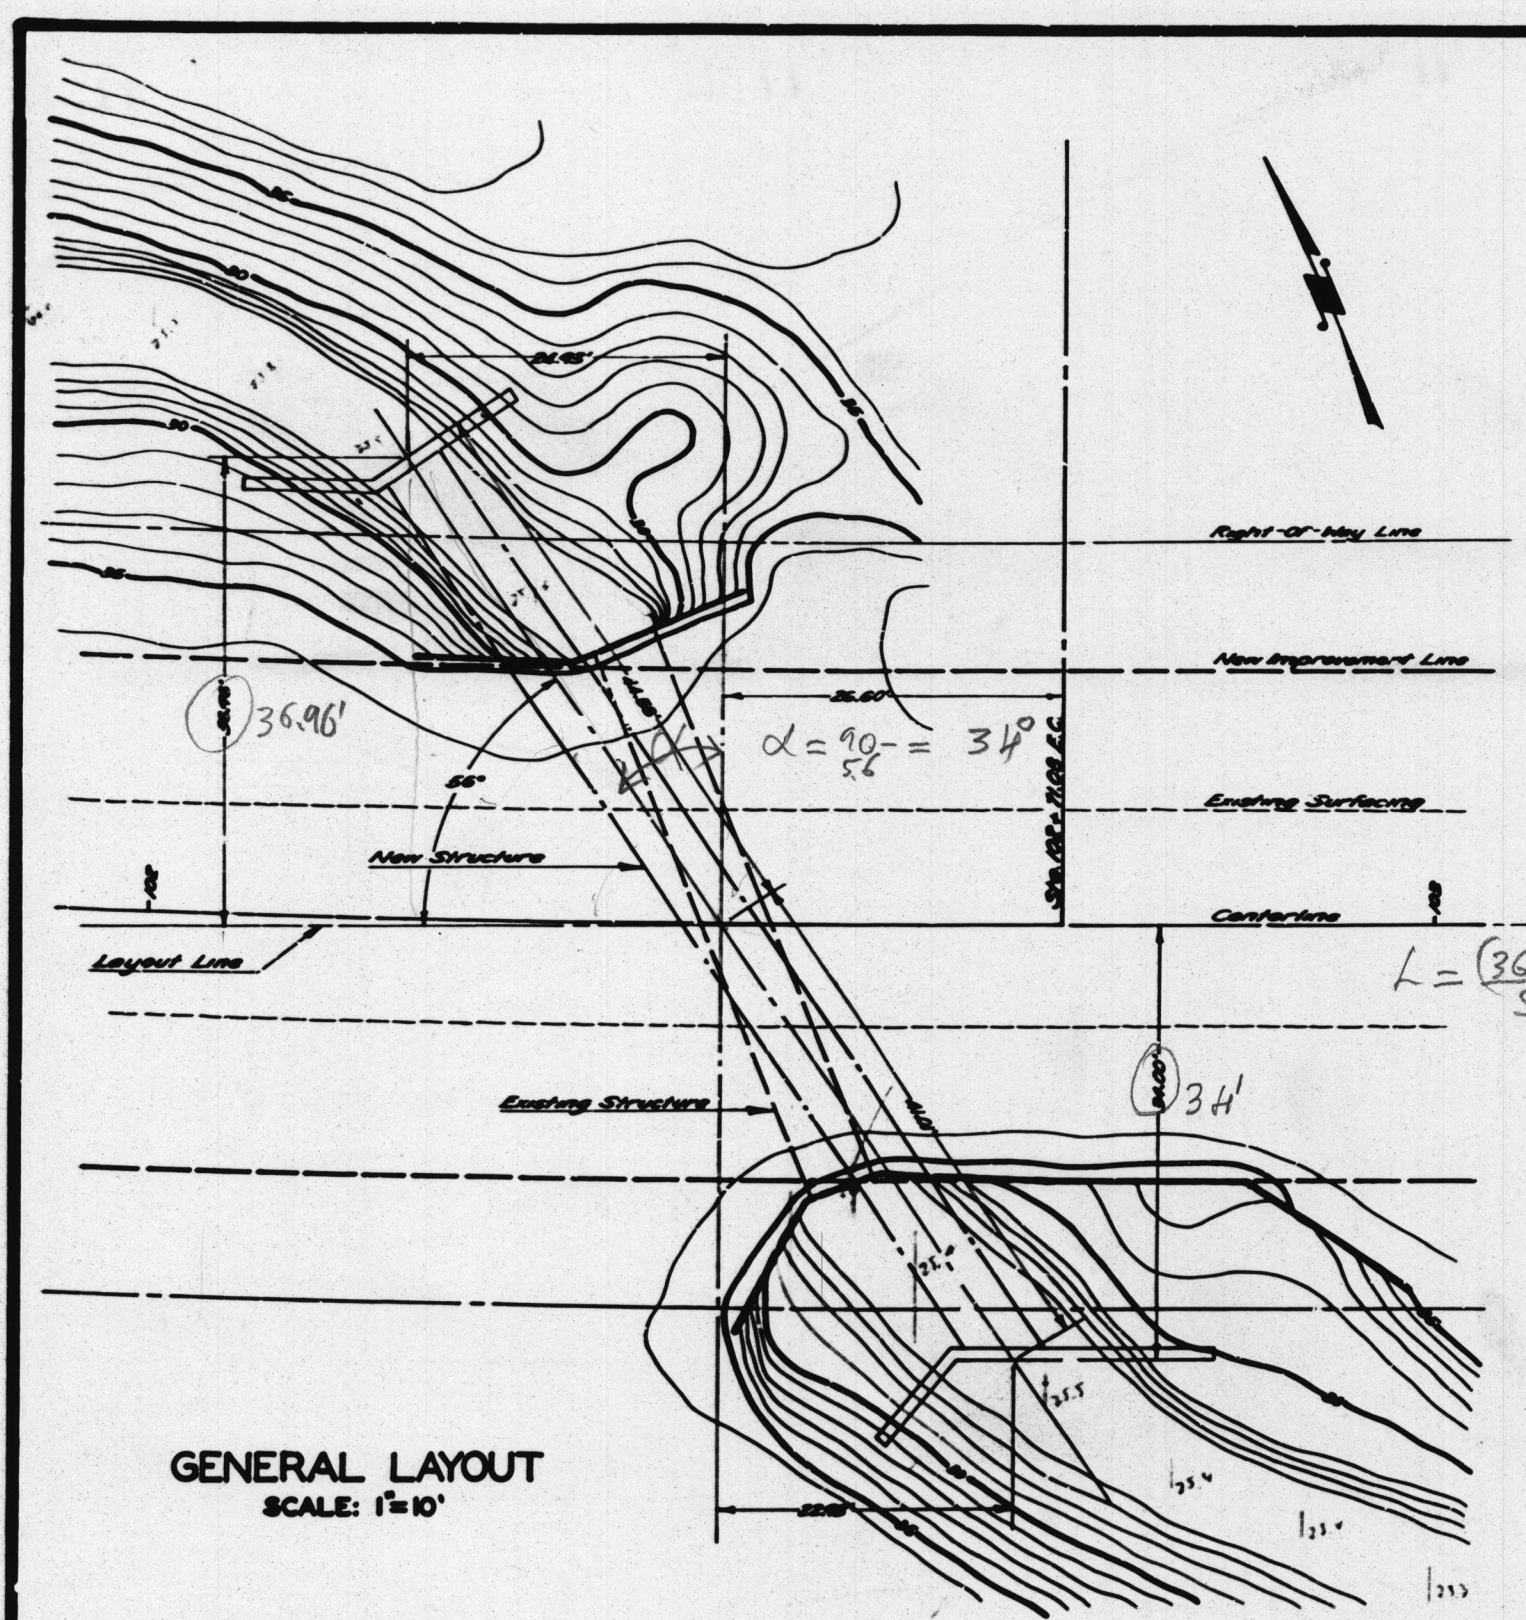

Culvert #8-183
Lane Road
Culvert Detail
Sheet 1 of 1
Red: 23.5.1 / Scale as shown
Linen

ORANGE COUNTY HIGHWAY DEPT.
LANE ROAD
CULVERT DETAIL (S-183)
STA. 102+44.5
5183
587
SHEET 7 OF 7

MICROFILMED
JUL 1 1960

#14616 before 1960
S-183