


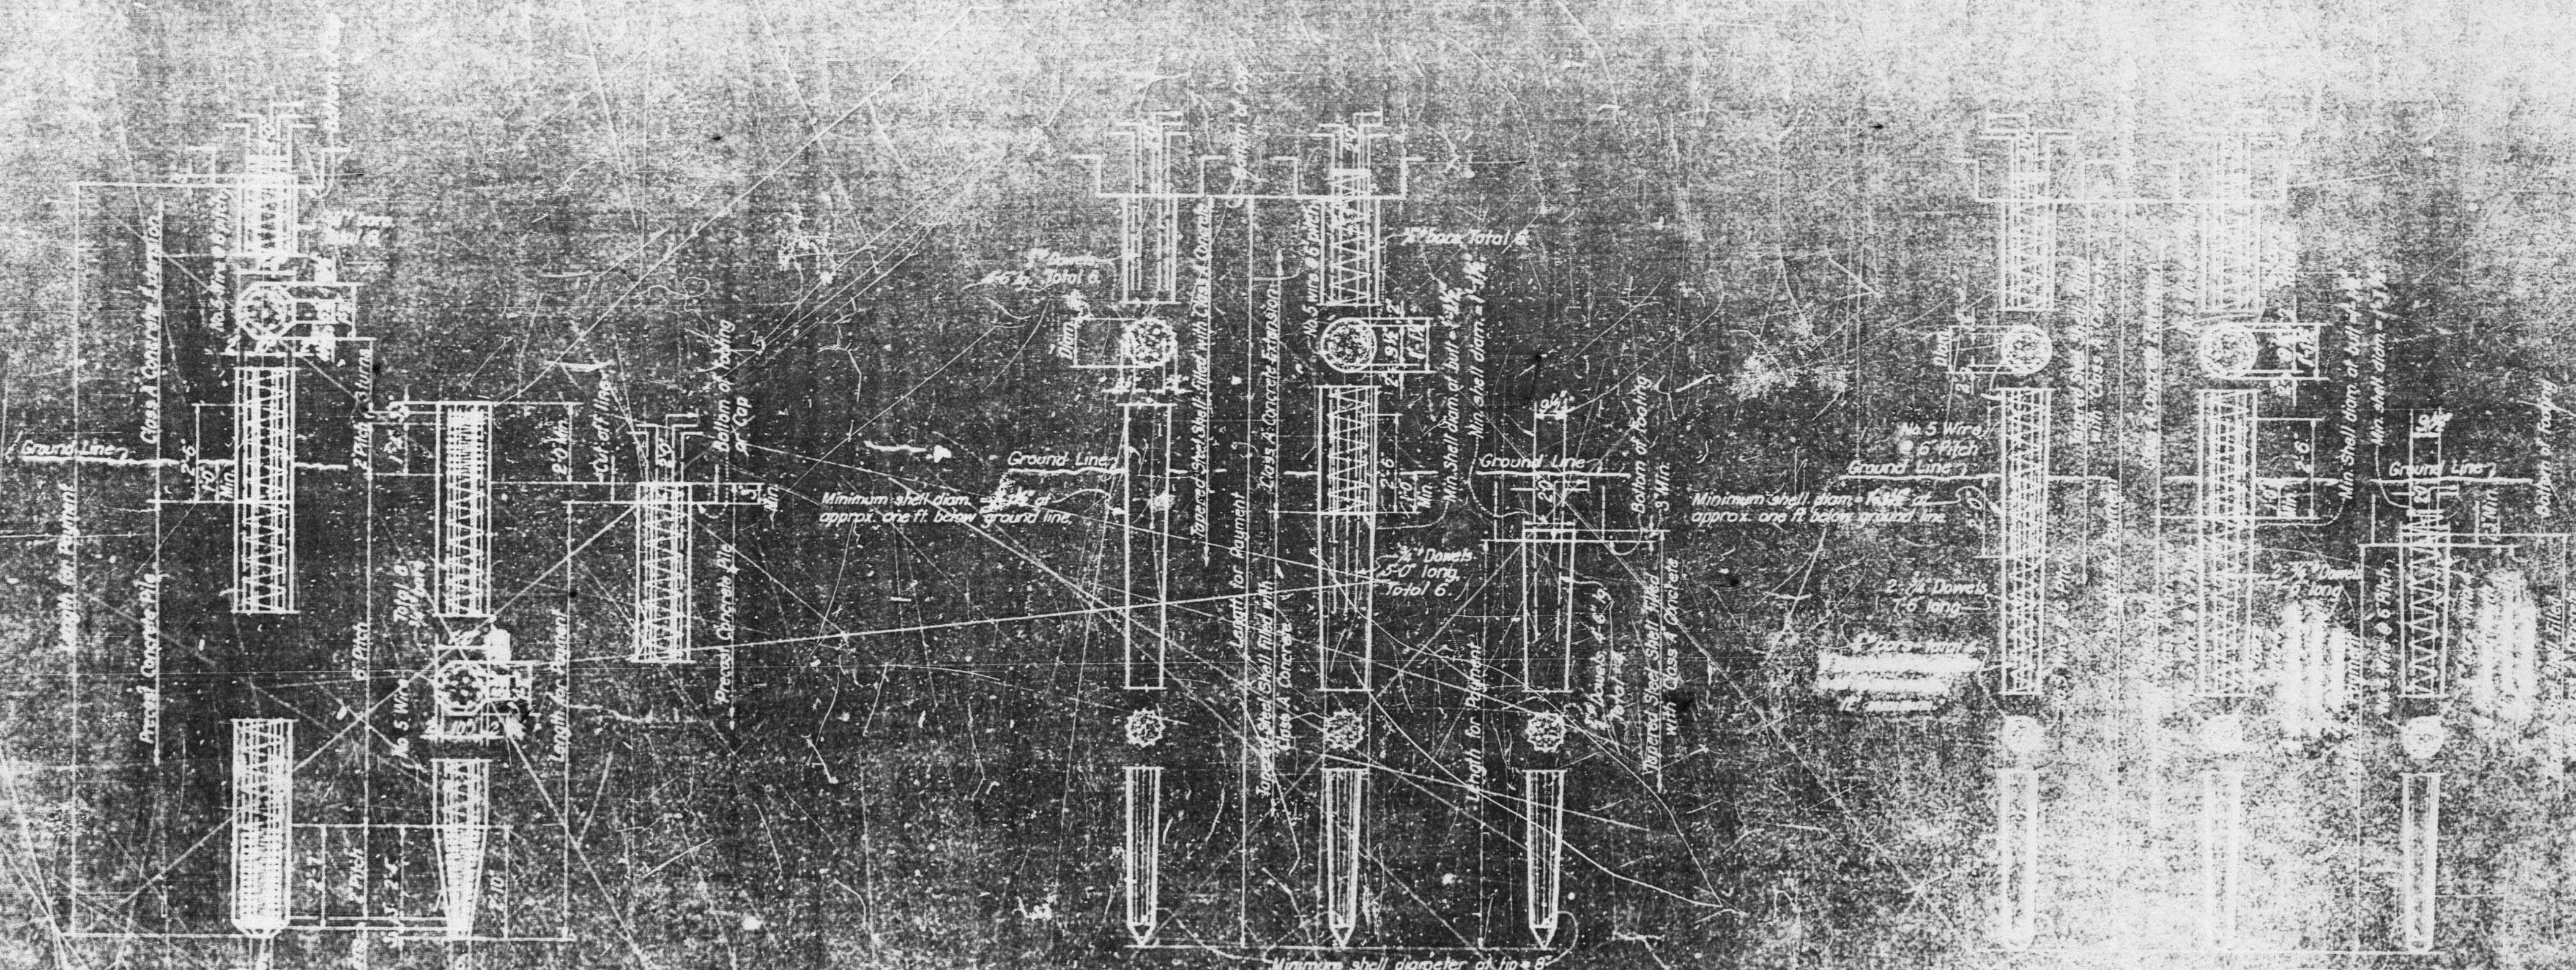

**CAST-IN-PLACE CONCRETE PILE
ALTERNATIVE B**

Design Load 32 kips
Drive to 50 tons bearing value

SA
OK
OK
OK
RE
Bayer

AS BUILT
CORRECTIONS BY
DATE

WKS. MD
JUN 18 1962