
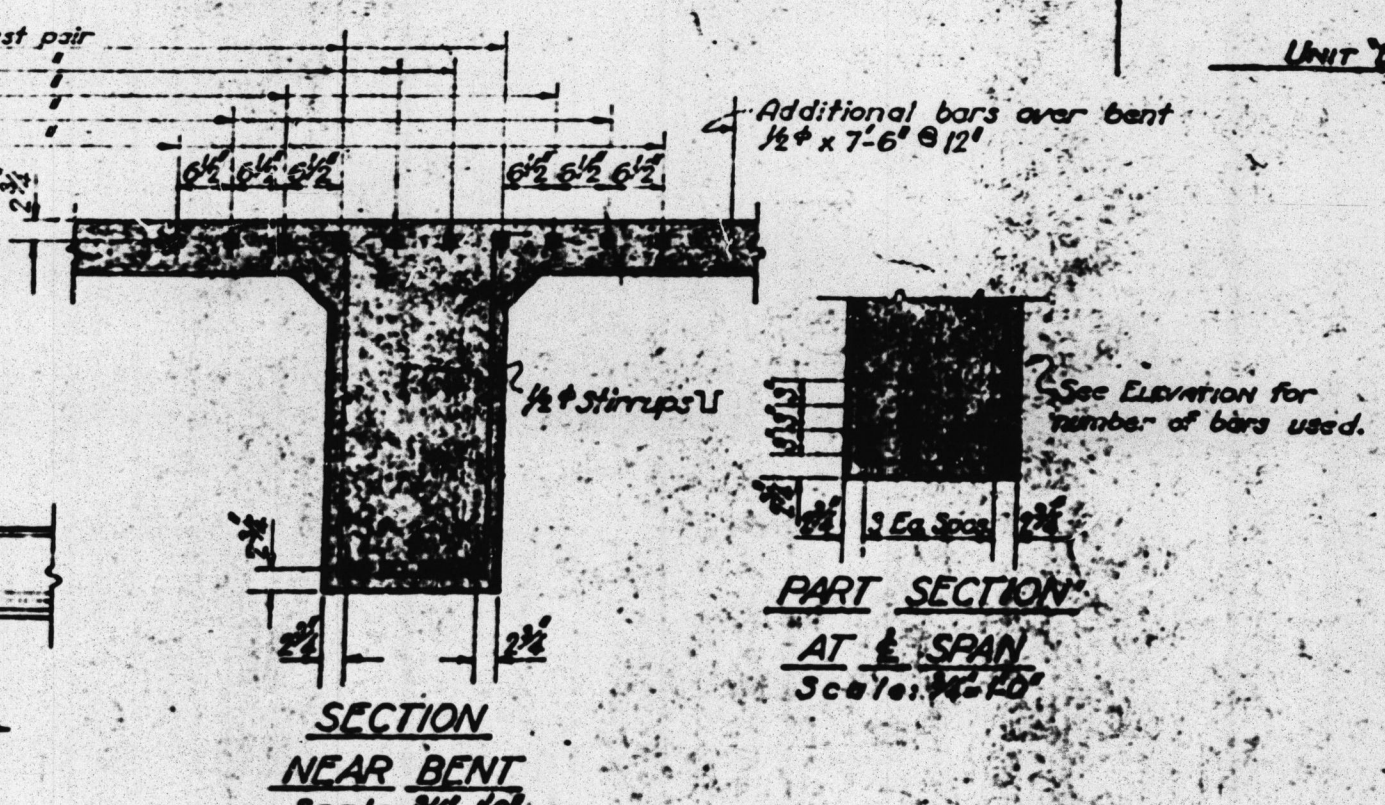


BRIDGE DEPARTMENT

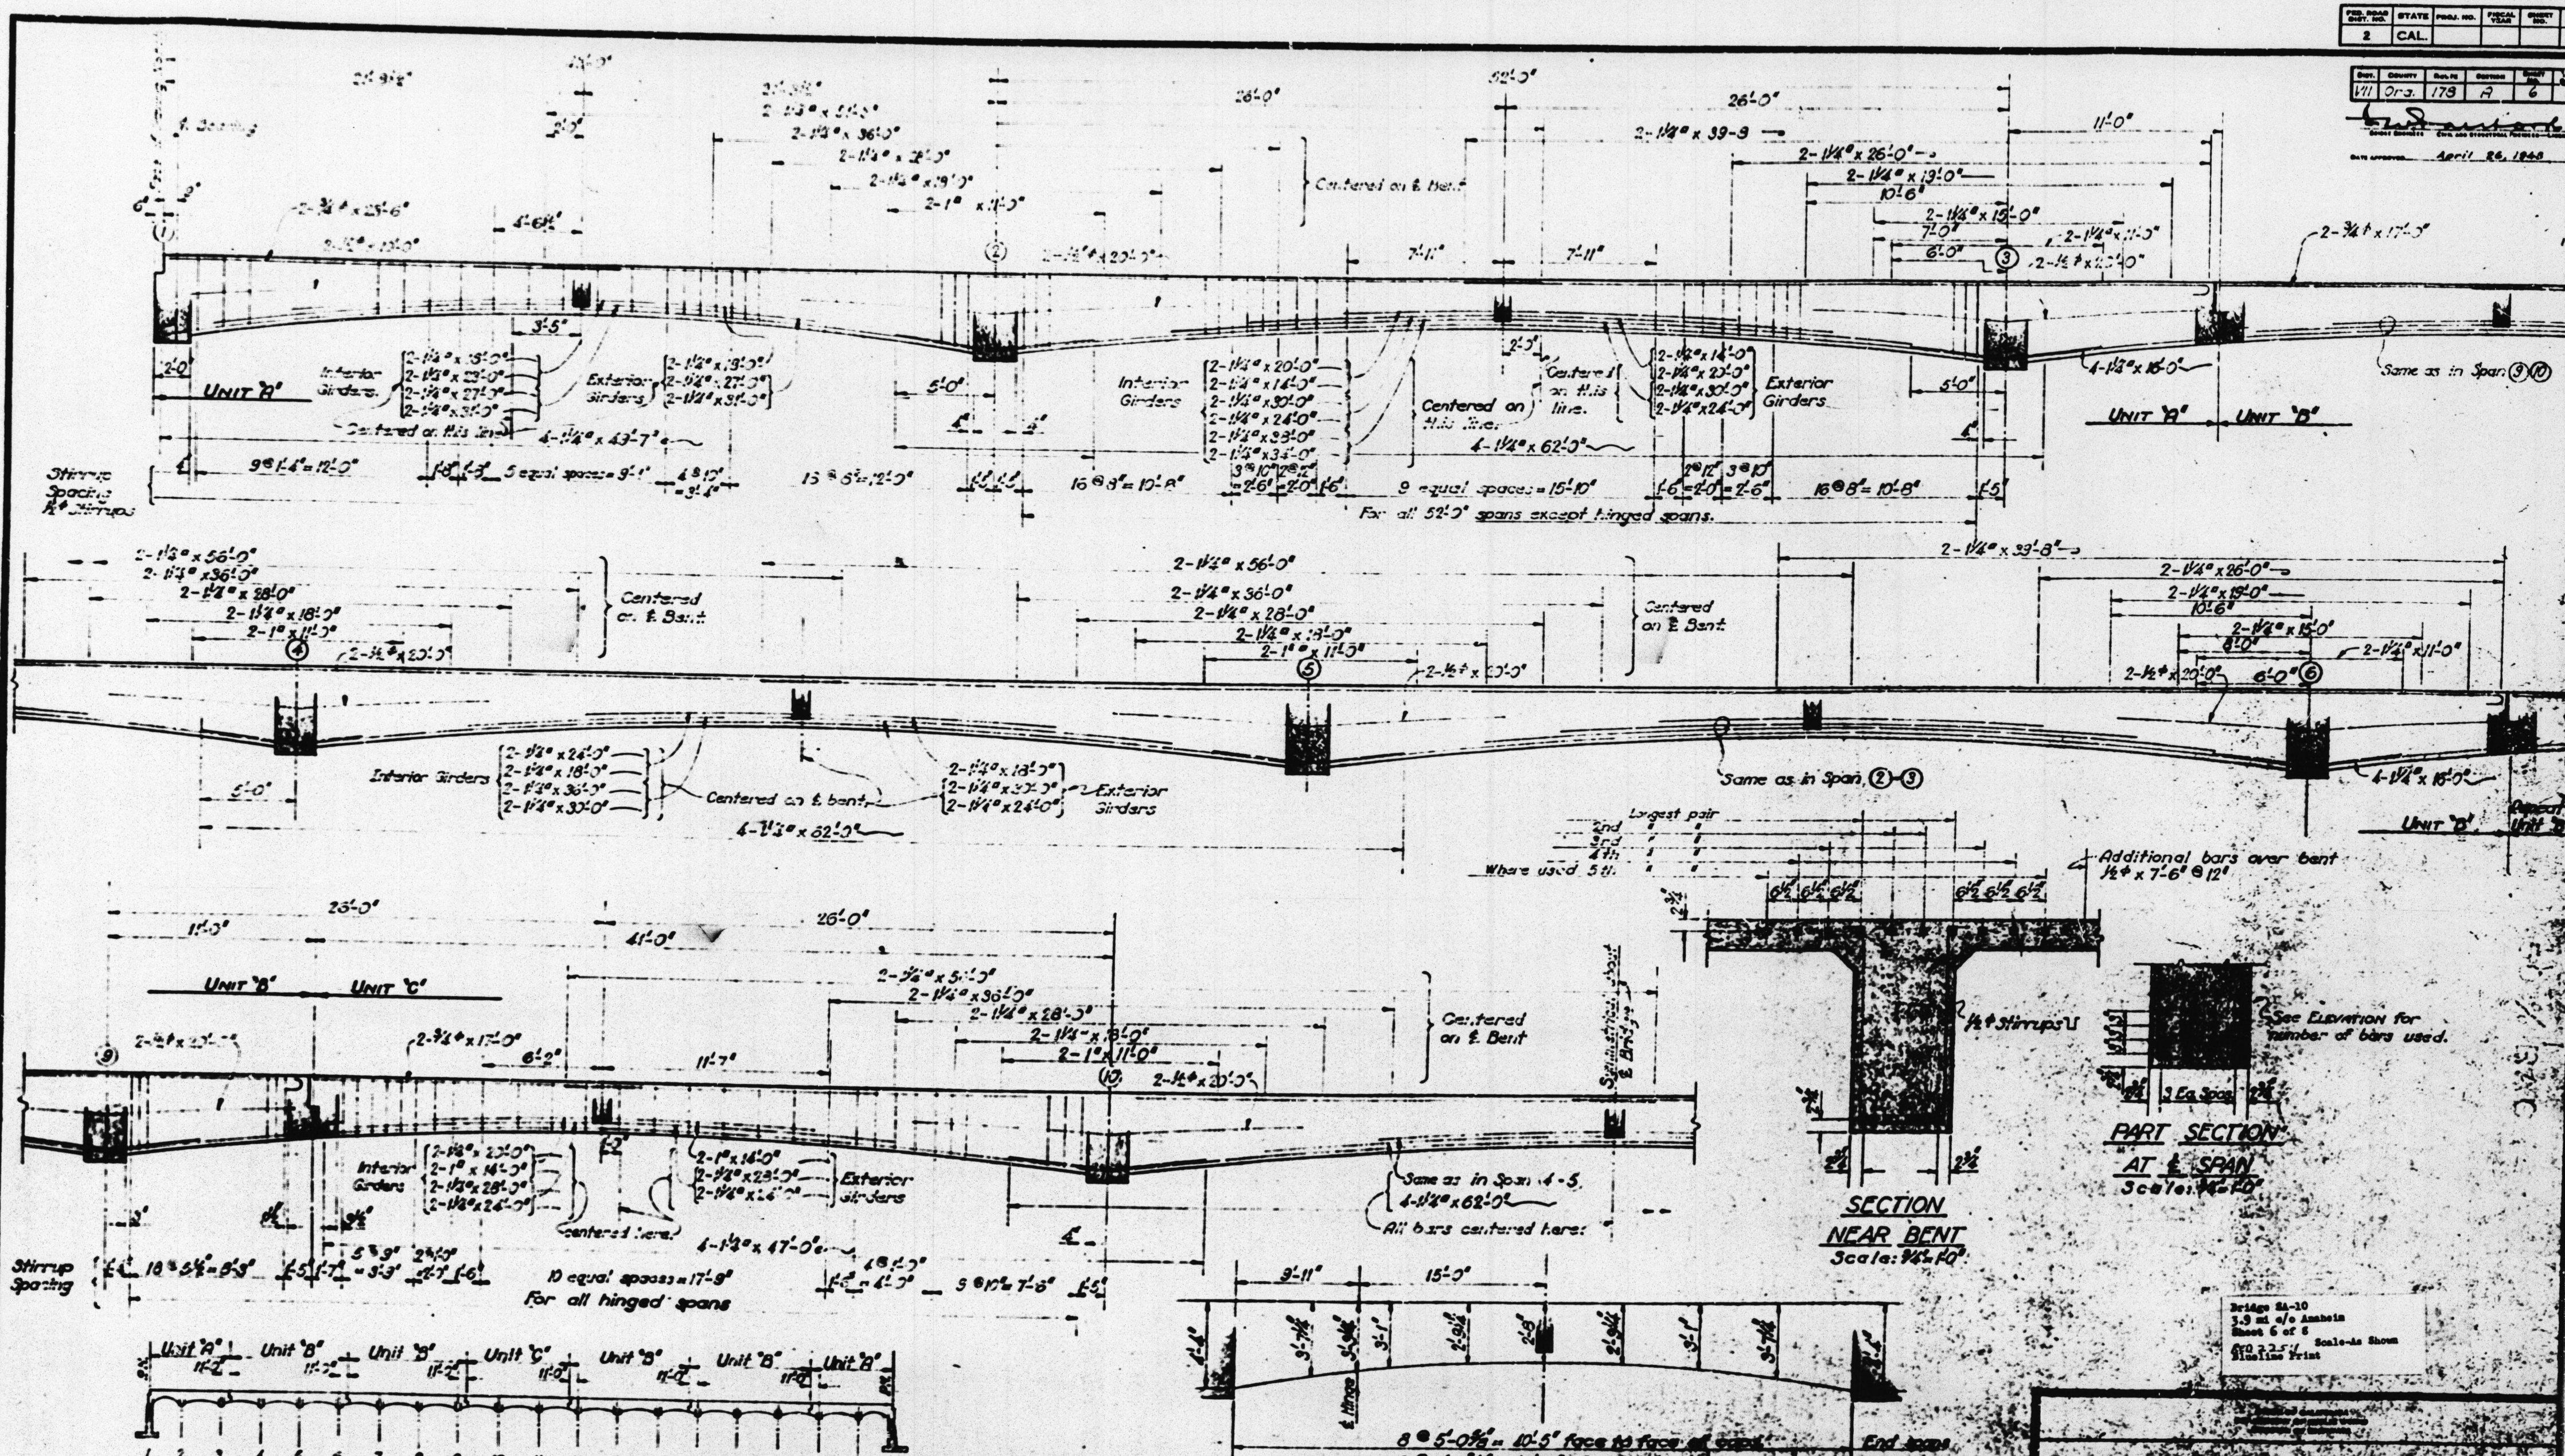

KEY ELEVATION
Not to Scale

GIRDER DEPTHS
Not to Scale

BRIDGE 54-10
1.5 mi. e/o Anaheim
Sheet 6 of 6
Scale as Shown
Schematic Print

BRIDGE ACROSS SANTA ANA RIVER

GIRDER DETAILS