
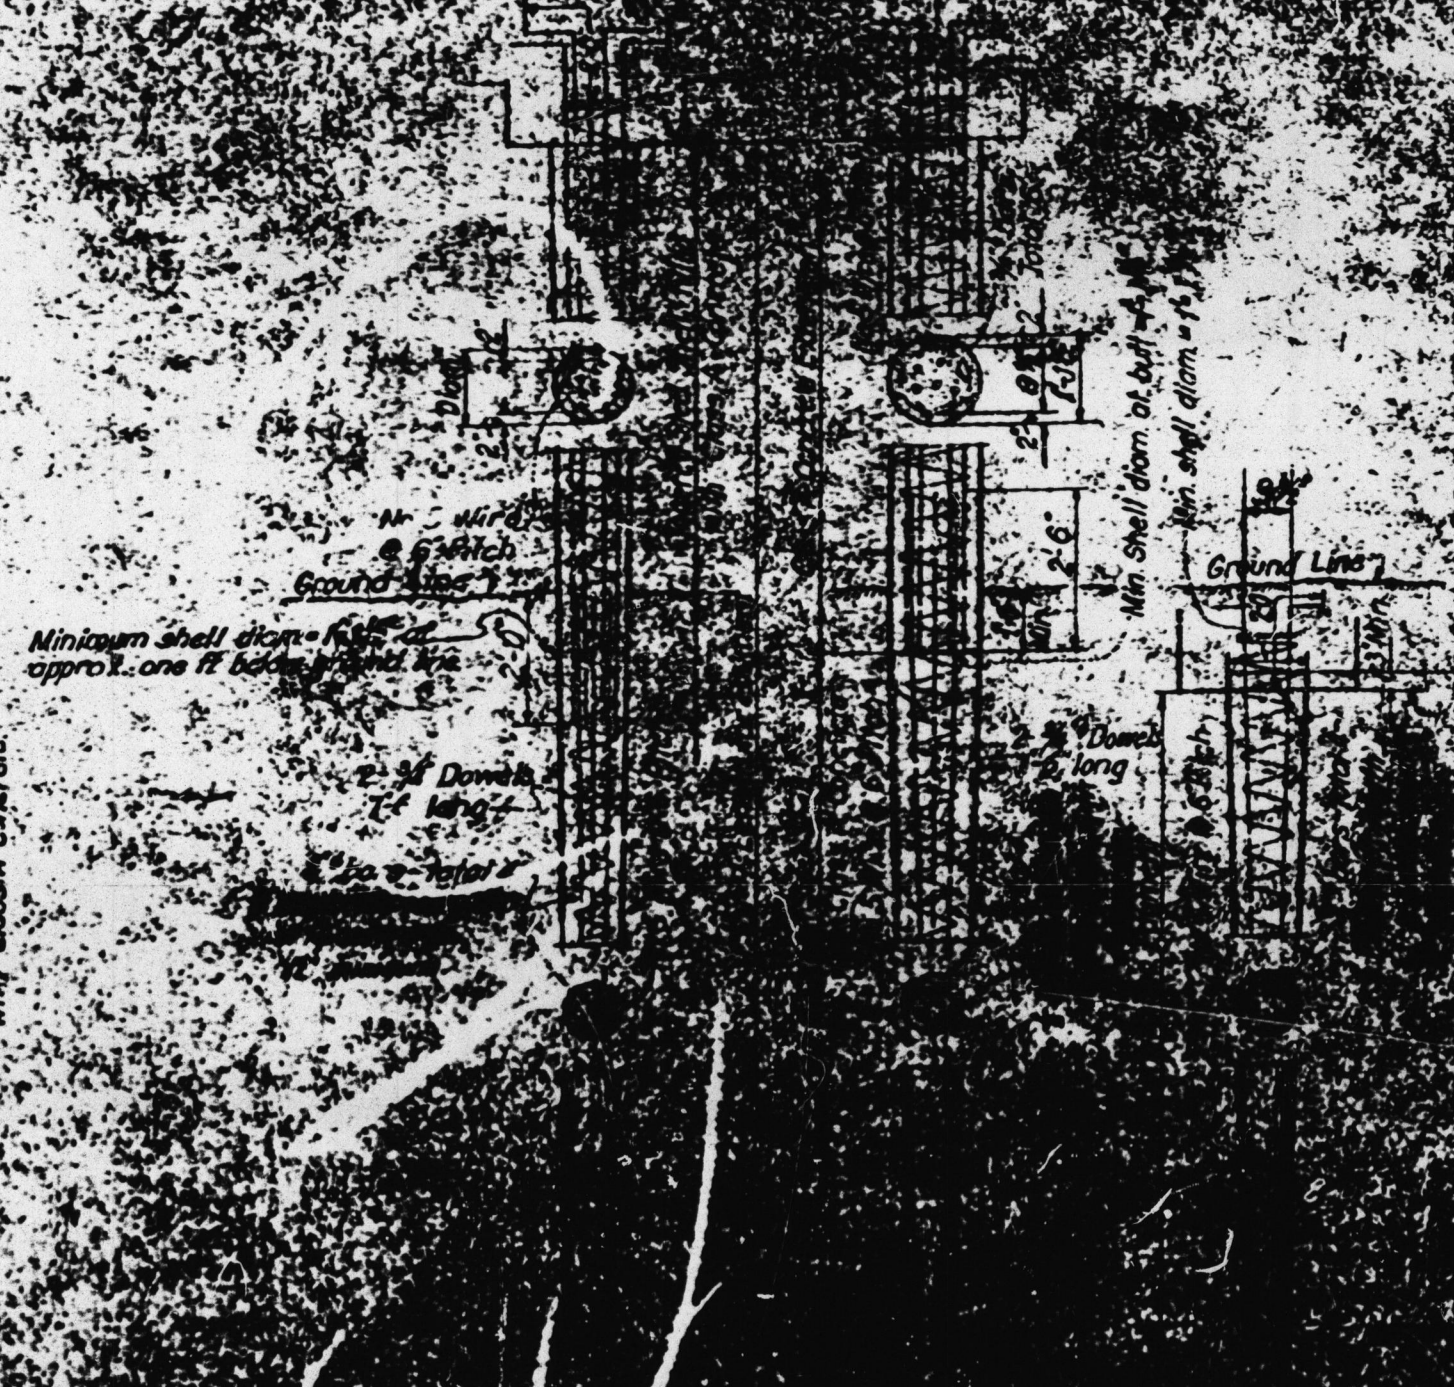
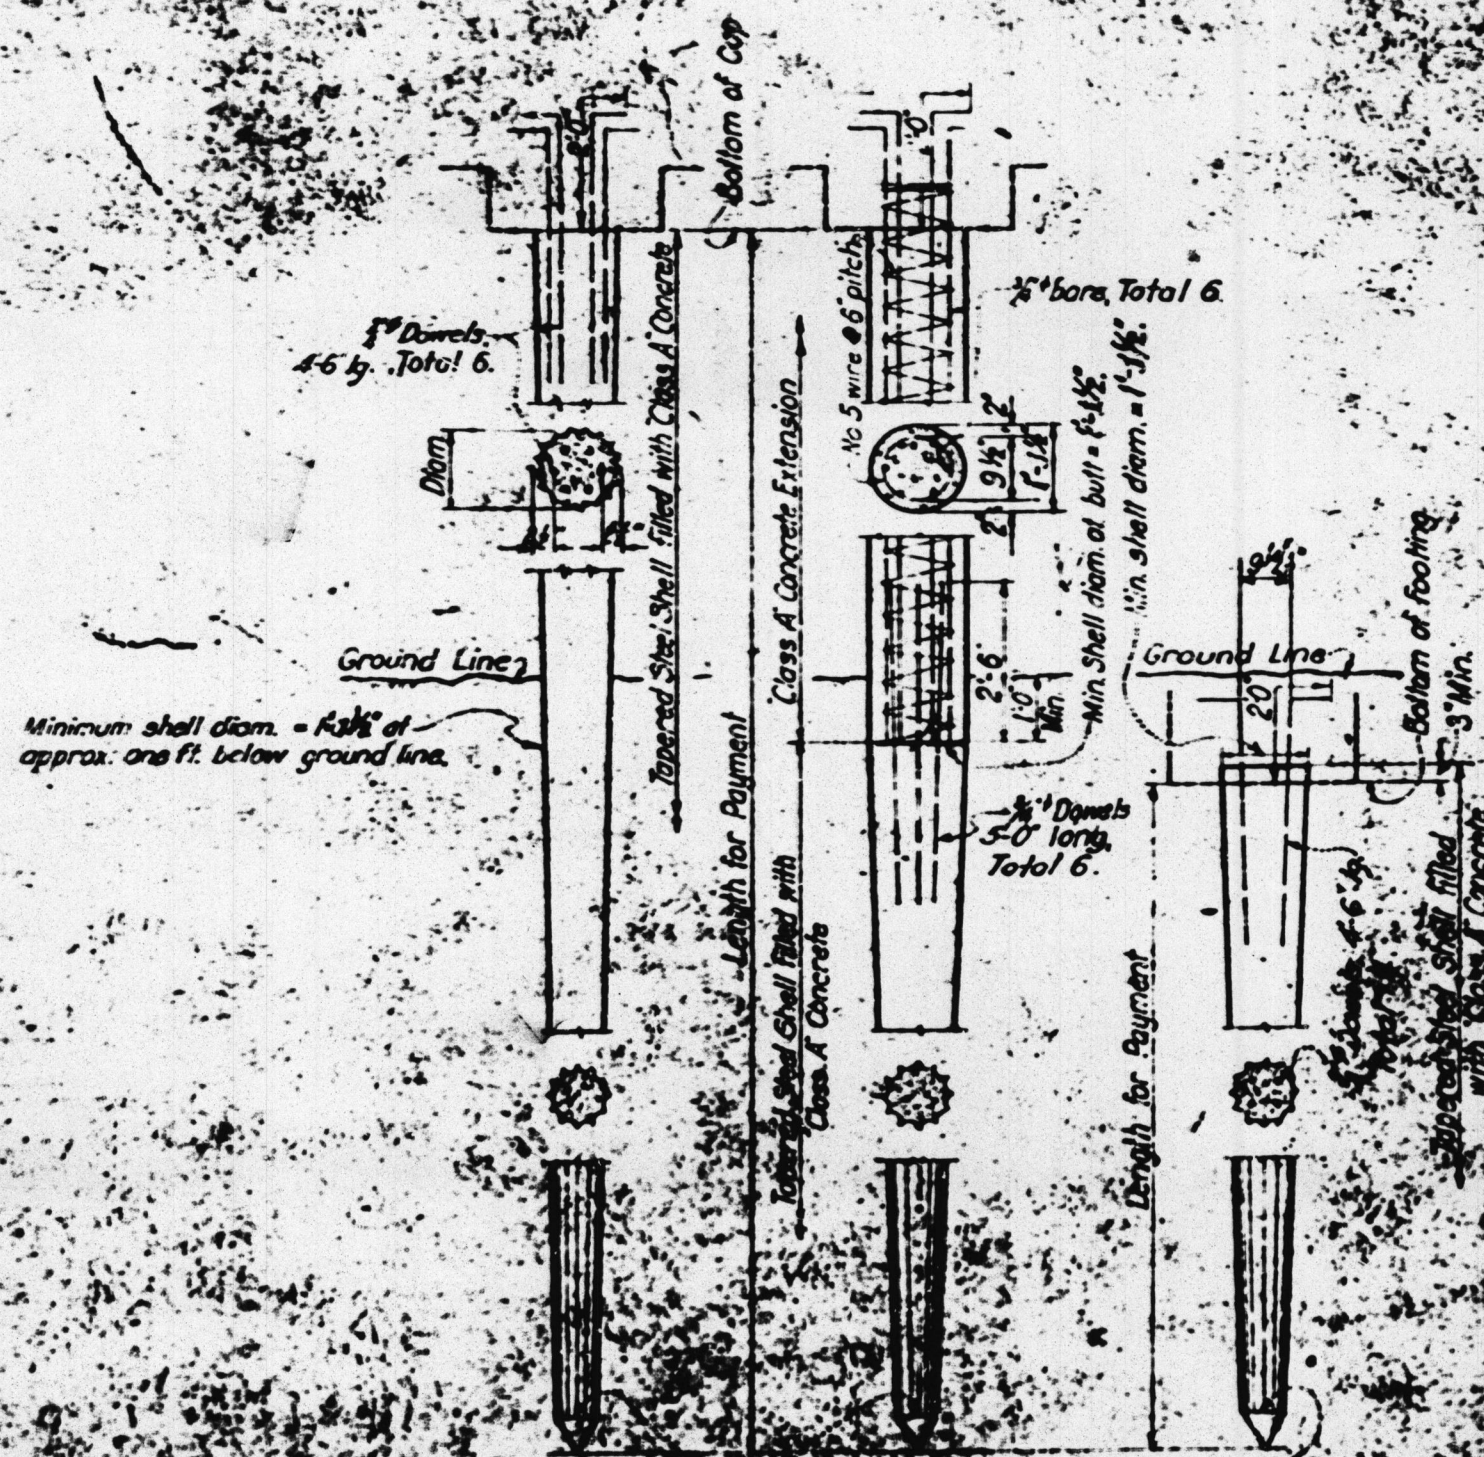


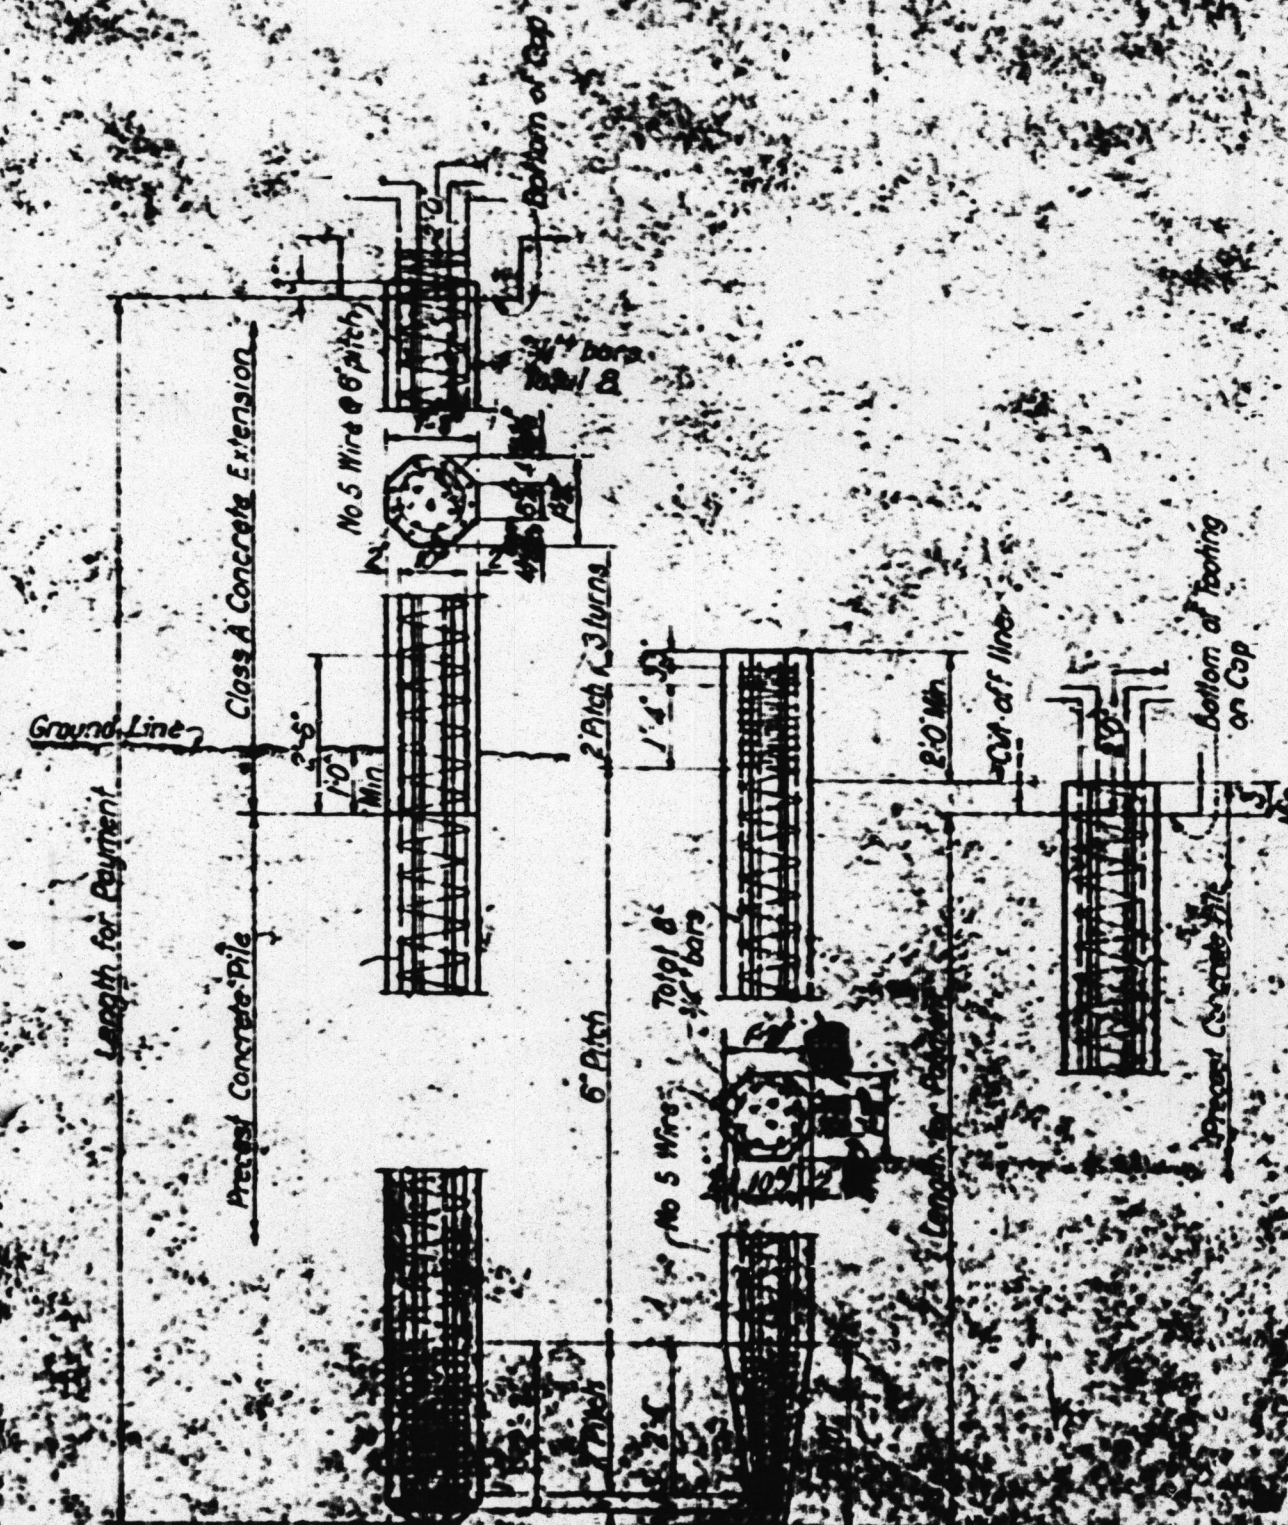

AS BUILT

Bridge 24-10
3.9 mi. e/o Anaheim
Sheet 5 of 6
X/O 2.5" Scale as Shown
Baseline Print

V.12-16