

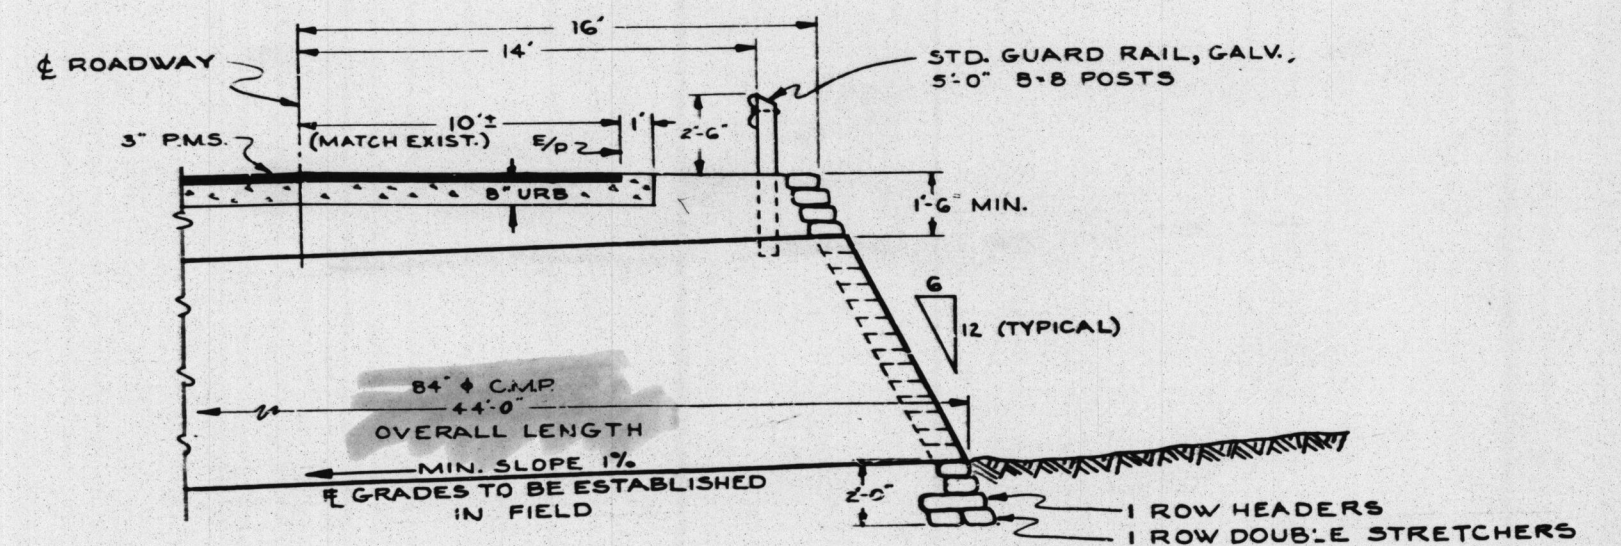


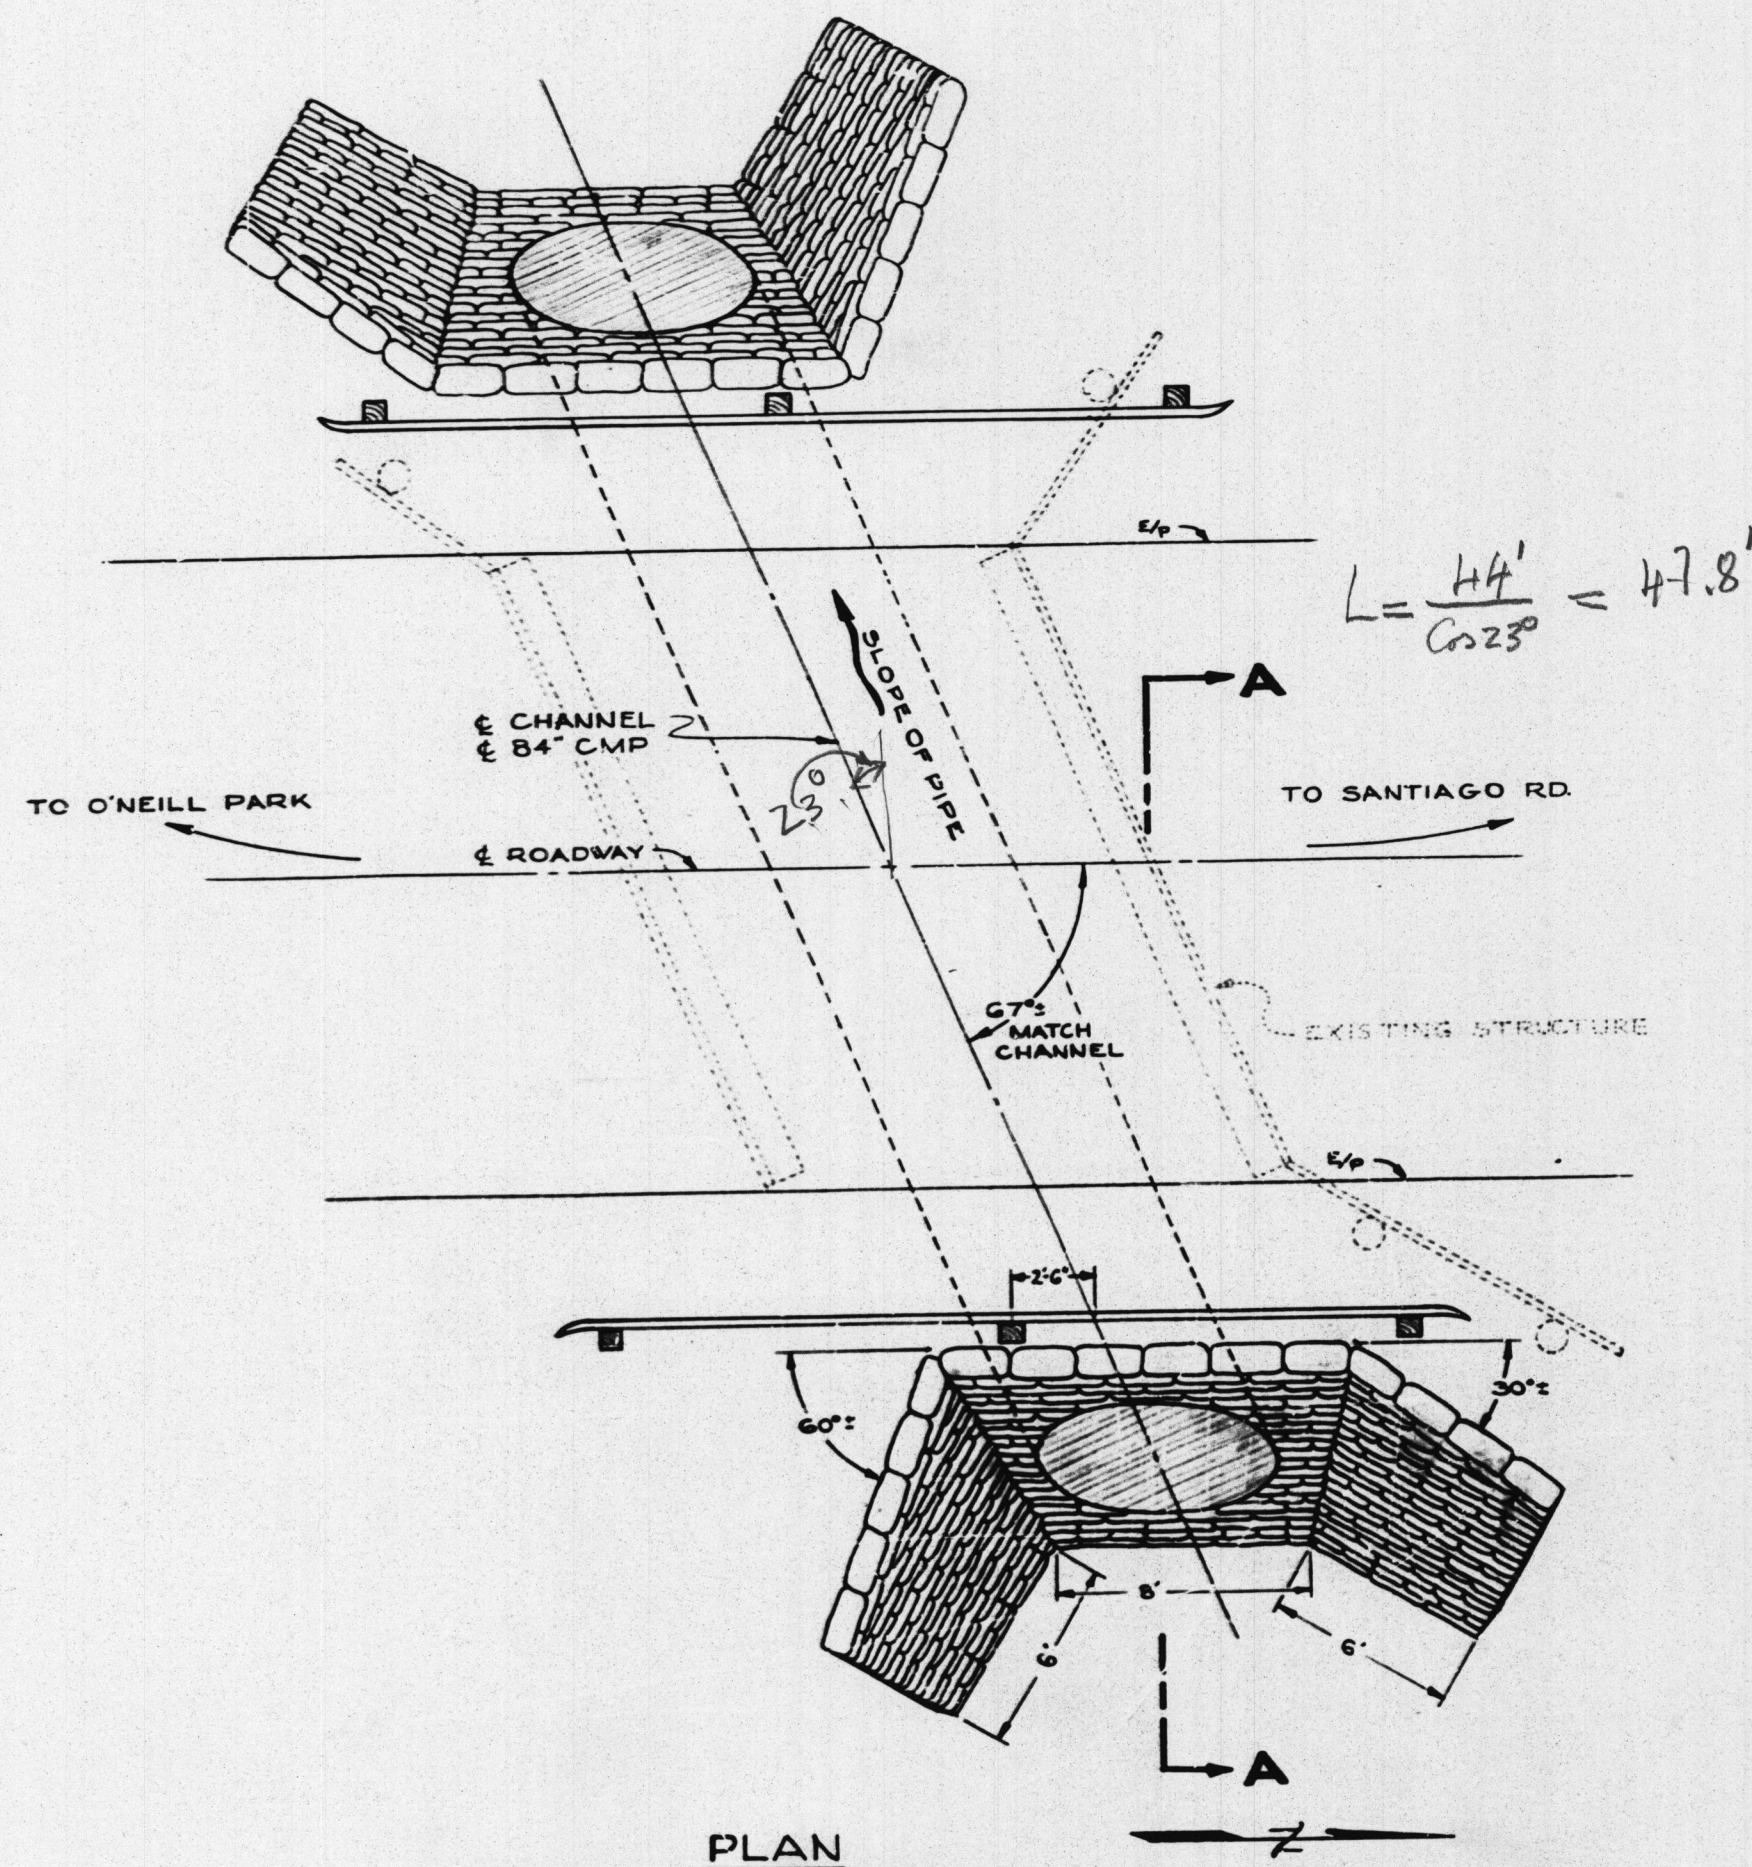

SECTION A-A

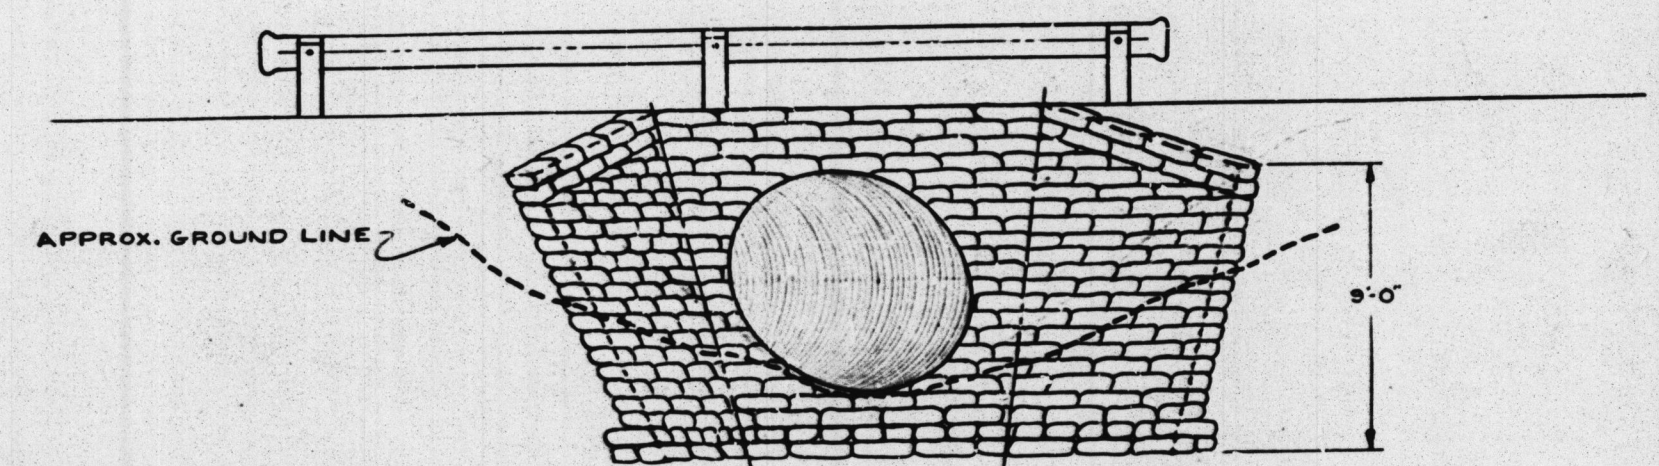


ELEVATION

Bridge S-69
Live Oak Canyon Rd.
Sheet 1 of 1
Red. Ratio 22.5:1
Scale 1"=40'
Pencil Sketch

NOTES:

1. REMOVE DECK & CAPS OF EXISTING BRIDGE. POSTS & BULKHEADS MAY REMAIN UNLESS HAMPERING INSTALLATION OF PROPOSED STRUCTURE.
2. PIPE SHALL BE 84" x 8 GA. ASPHALT-COATED CMP.
3. RIP-RAP TO BE SACKED CONCRETE AS SHOWN OR RUBBLE MASONRY WITH VERTICAL FRONT FACE, 1:5 FILL FACE, 15" MIN. THICKNESS, HEADWALLS 12' LONG, WINGWALLS 6' LONG, HEIGHTS & DIRECTIONS AS SHOWN.
4. BACKFILL EVENLY BOTH SIDES IN 6' WELL-TAMPED LIFTS.
5. PIPE LENGTHS & POSITIONS:

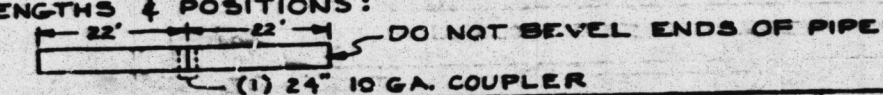

UNRECORDED
JUN 1, 1962

ROAD COMMISSIONER 9-21-59
RE #7872

ORANGE COUNTY HIGHWAY DEPARTMENT	
S-69	
LIVE OAK CANYON ROAD	
2.45 Mi. S/Modjeska Grade Rd.	
STRUCTURE REPLACEMENT	
PLAN & DETAILS	
SCALE: 1" = 40'	SHEET 1 OF 1

S-69 #14573 1959

S-69

Live Oak Canyon Road

LIVE OAK CYN Rd

Thomas 863 AG