


9 10 11 12 13 14

6 17 18 19 20 21 22 23 24 25 26 27 28 29 30 31 32 33 34 35 36 37 38 39 40 41 42 43 44 45 46 47

49 50 51 52 53 54 55

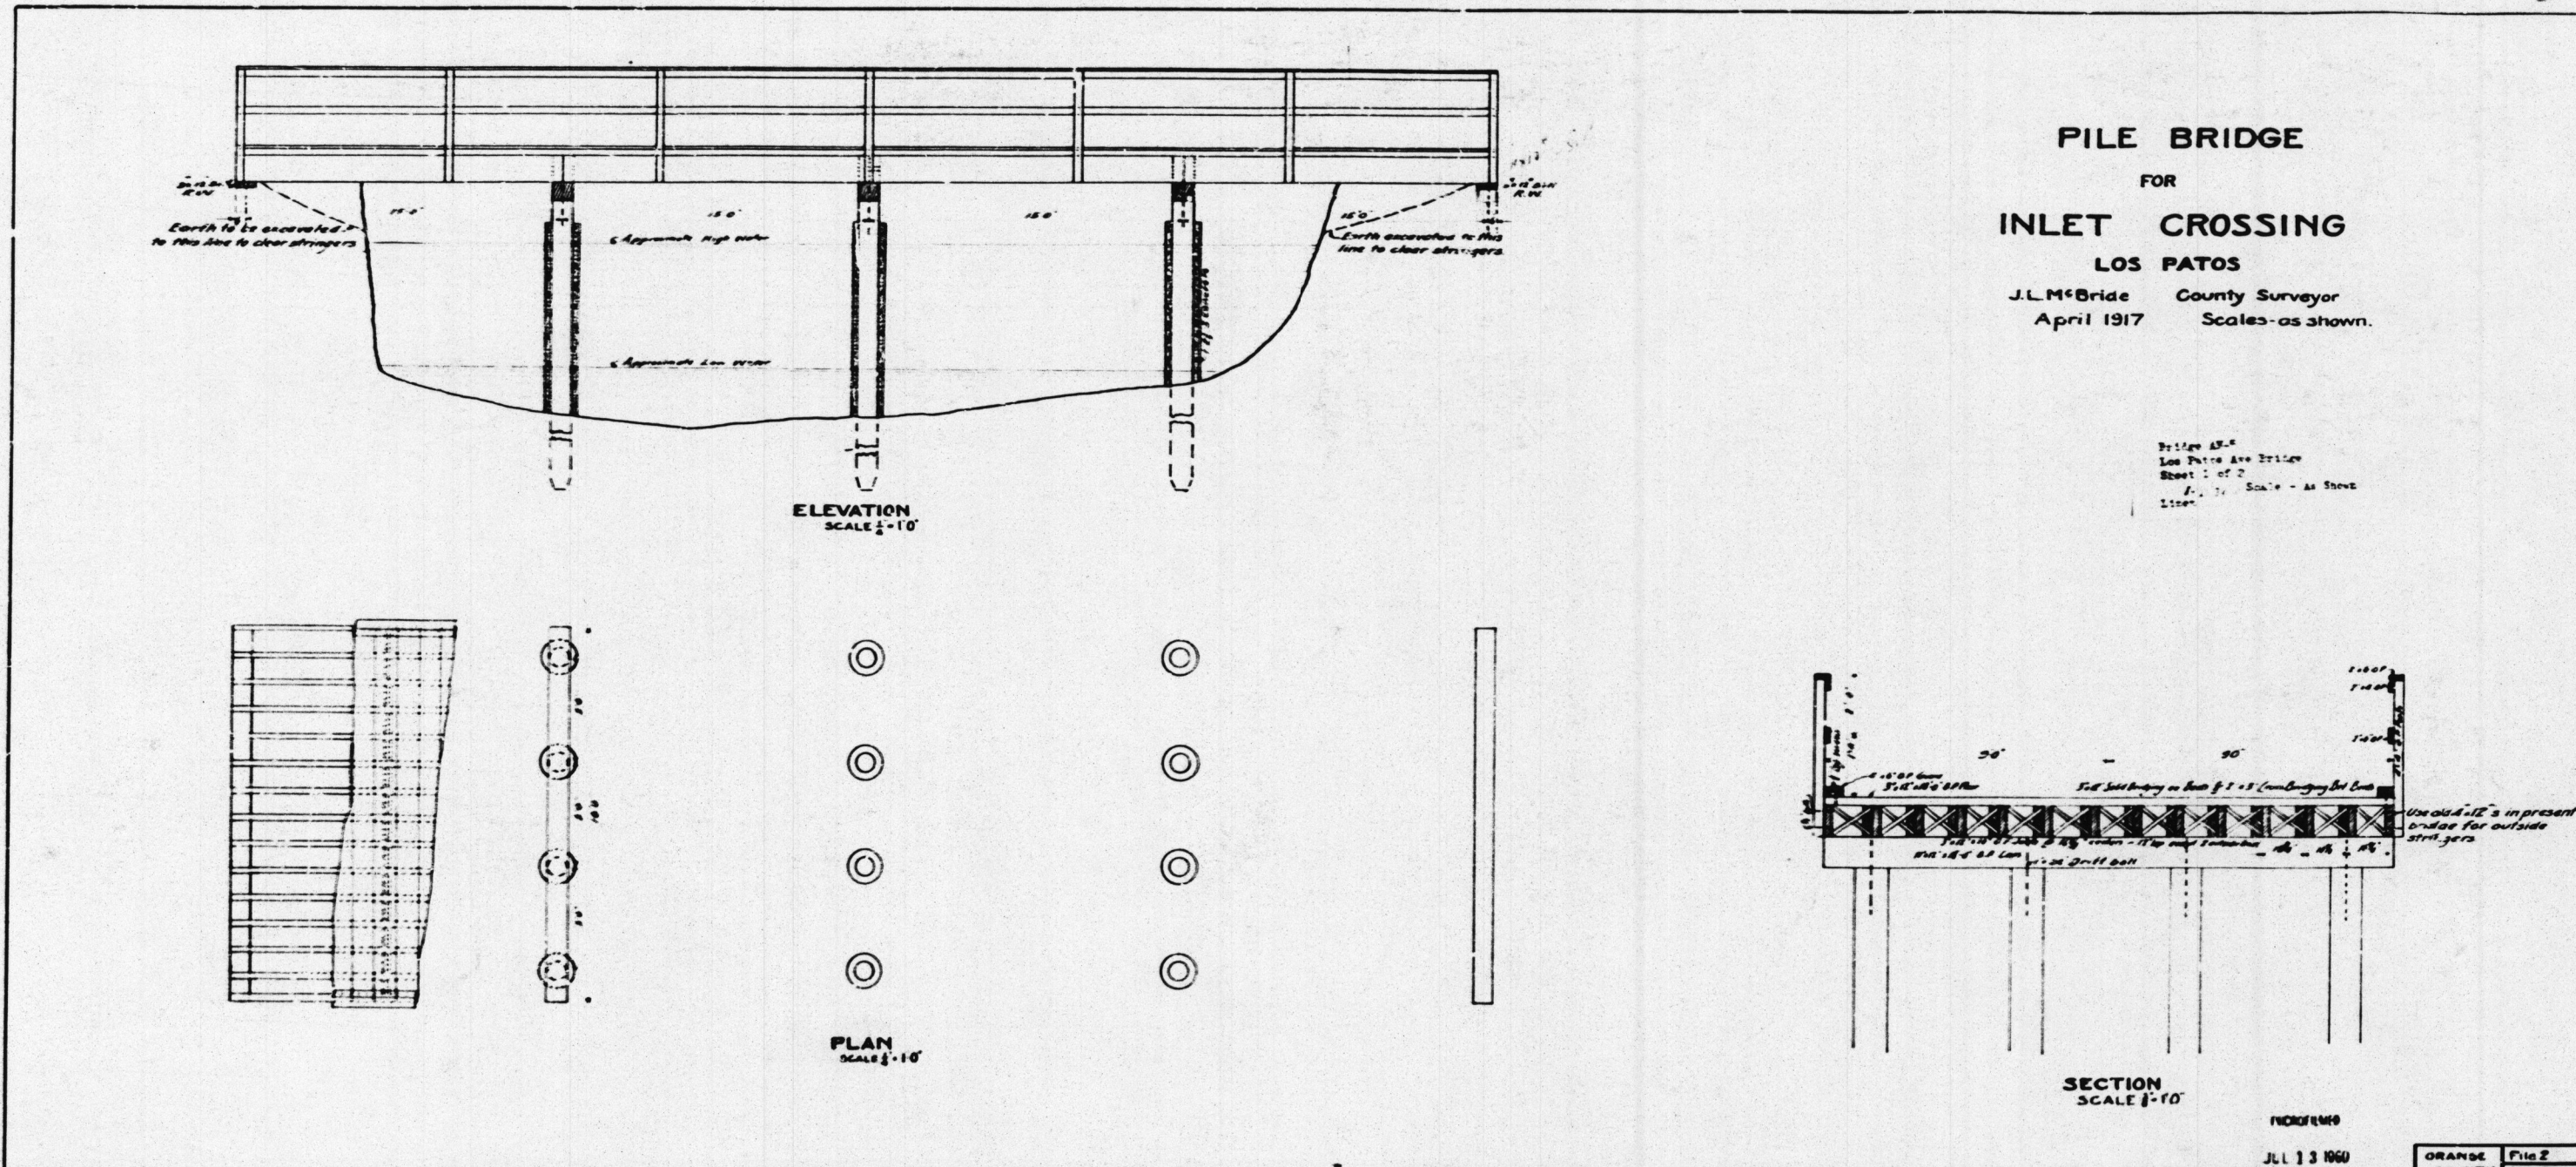

#14504
AN-5
1917

LOS PATOS AVE. BRIDGE
over Anaheim Bay (Sunset Channel)

Thomas: 857-B1