



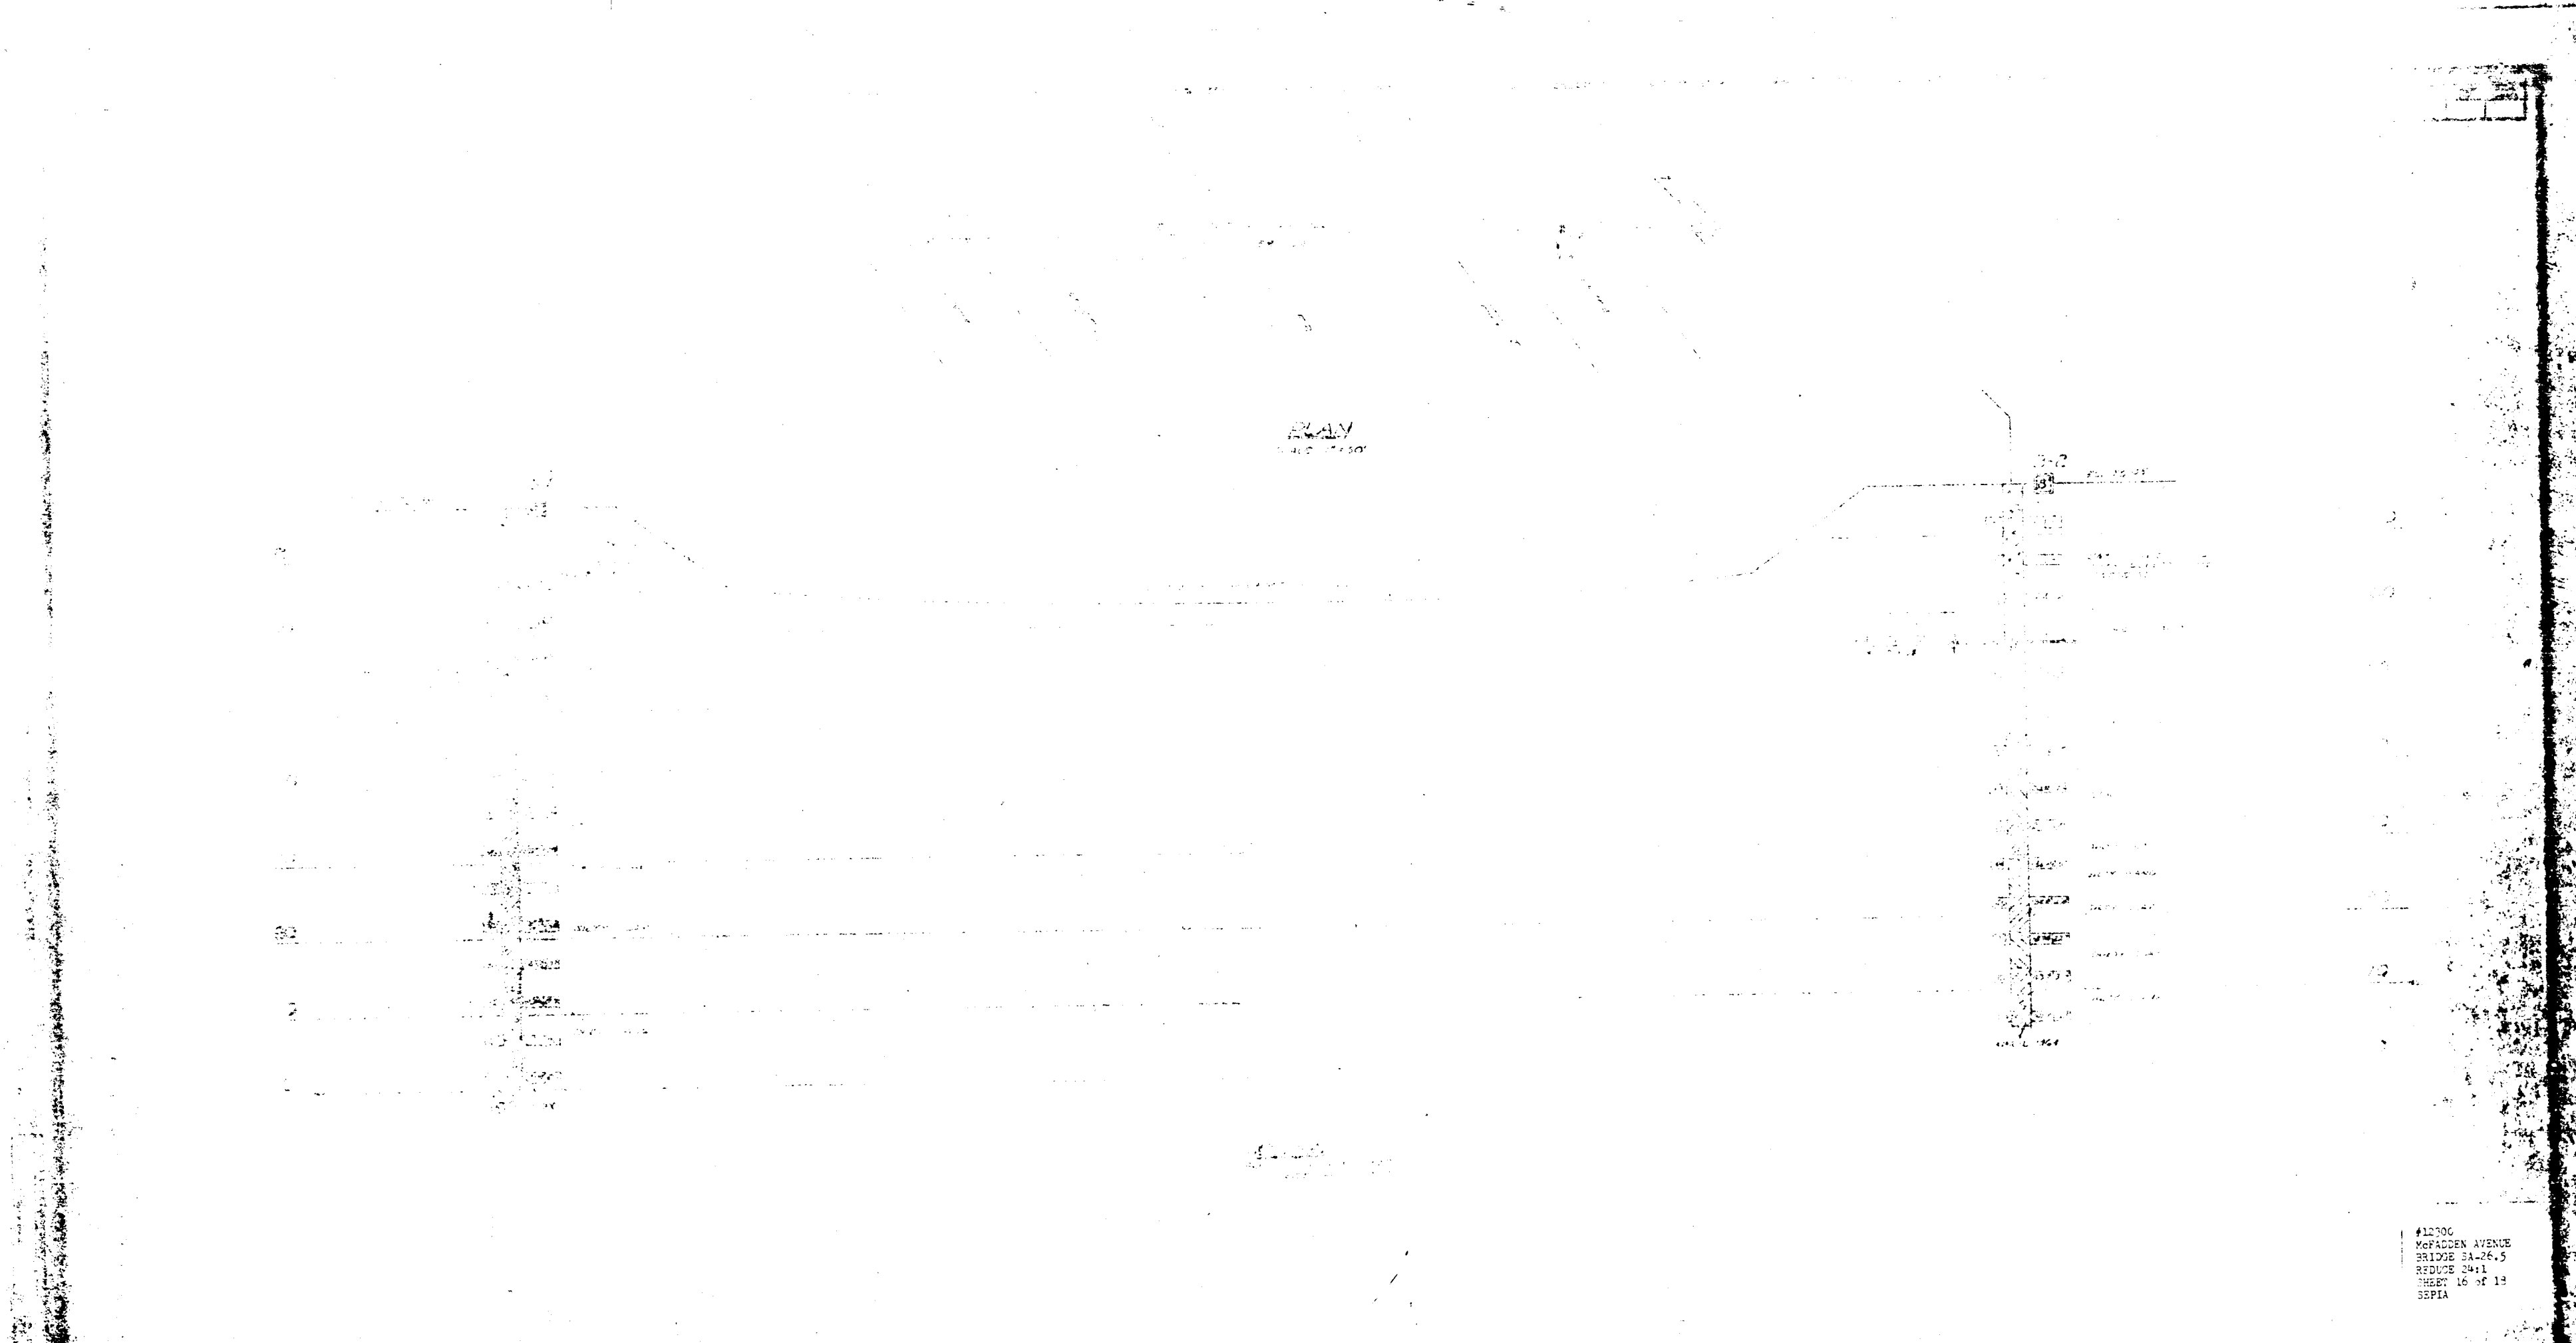

#12300
MCFADDEN AVENUE
BRIDGE SA-26.5
REDUCE 24:1
SHEET 16 of 18
SEP 14

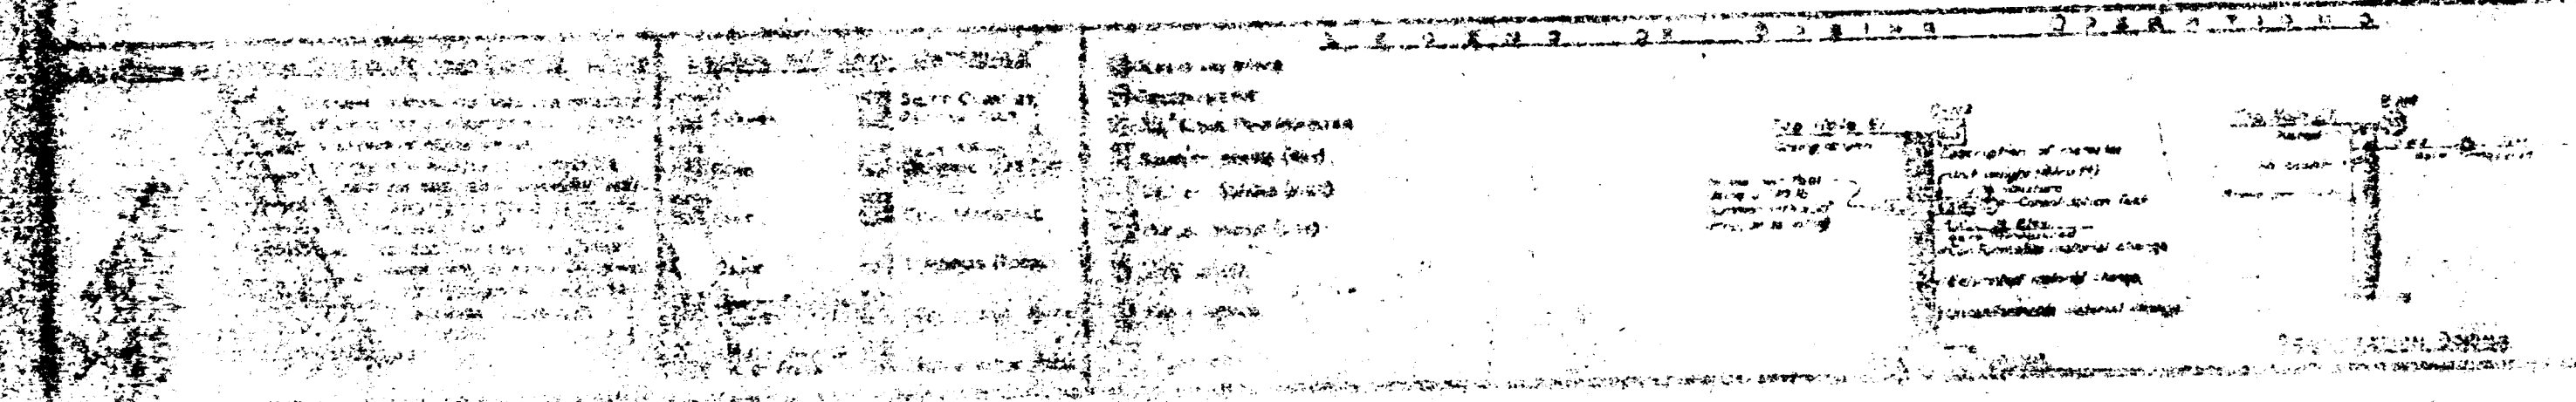

MCFADDEN AVENUE BRIDGE WIDENING
OVER THE
SANTA ANA RIVER
BRIDGE
LOW OF WATER
16 of 18
AS E

DR. #13 (12300)