



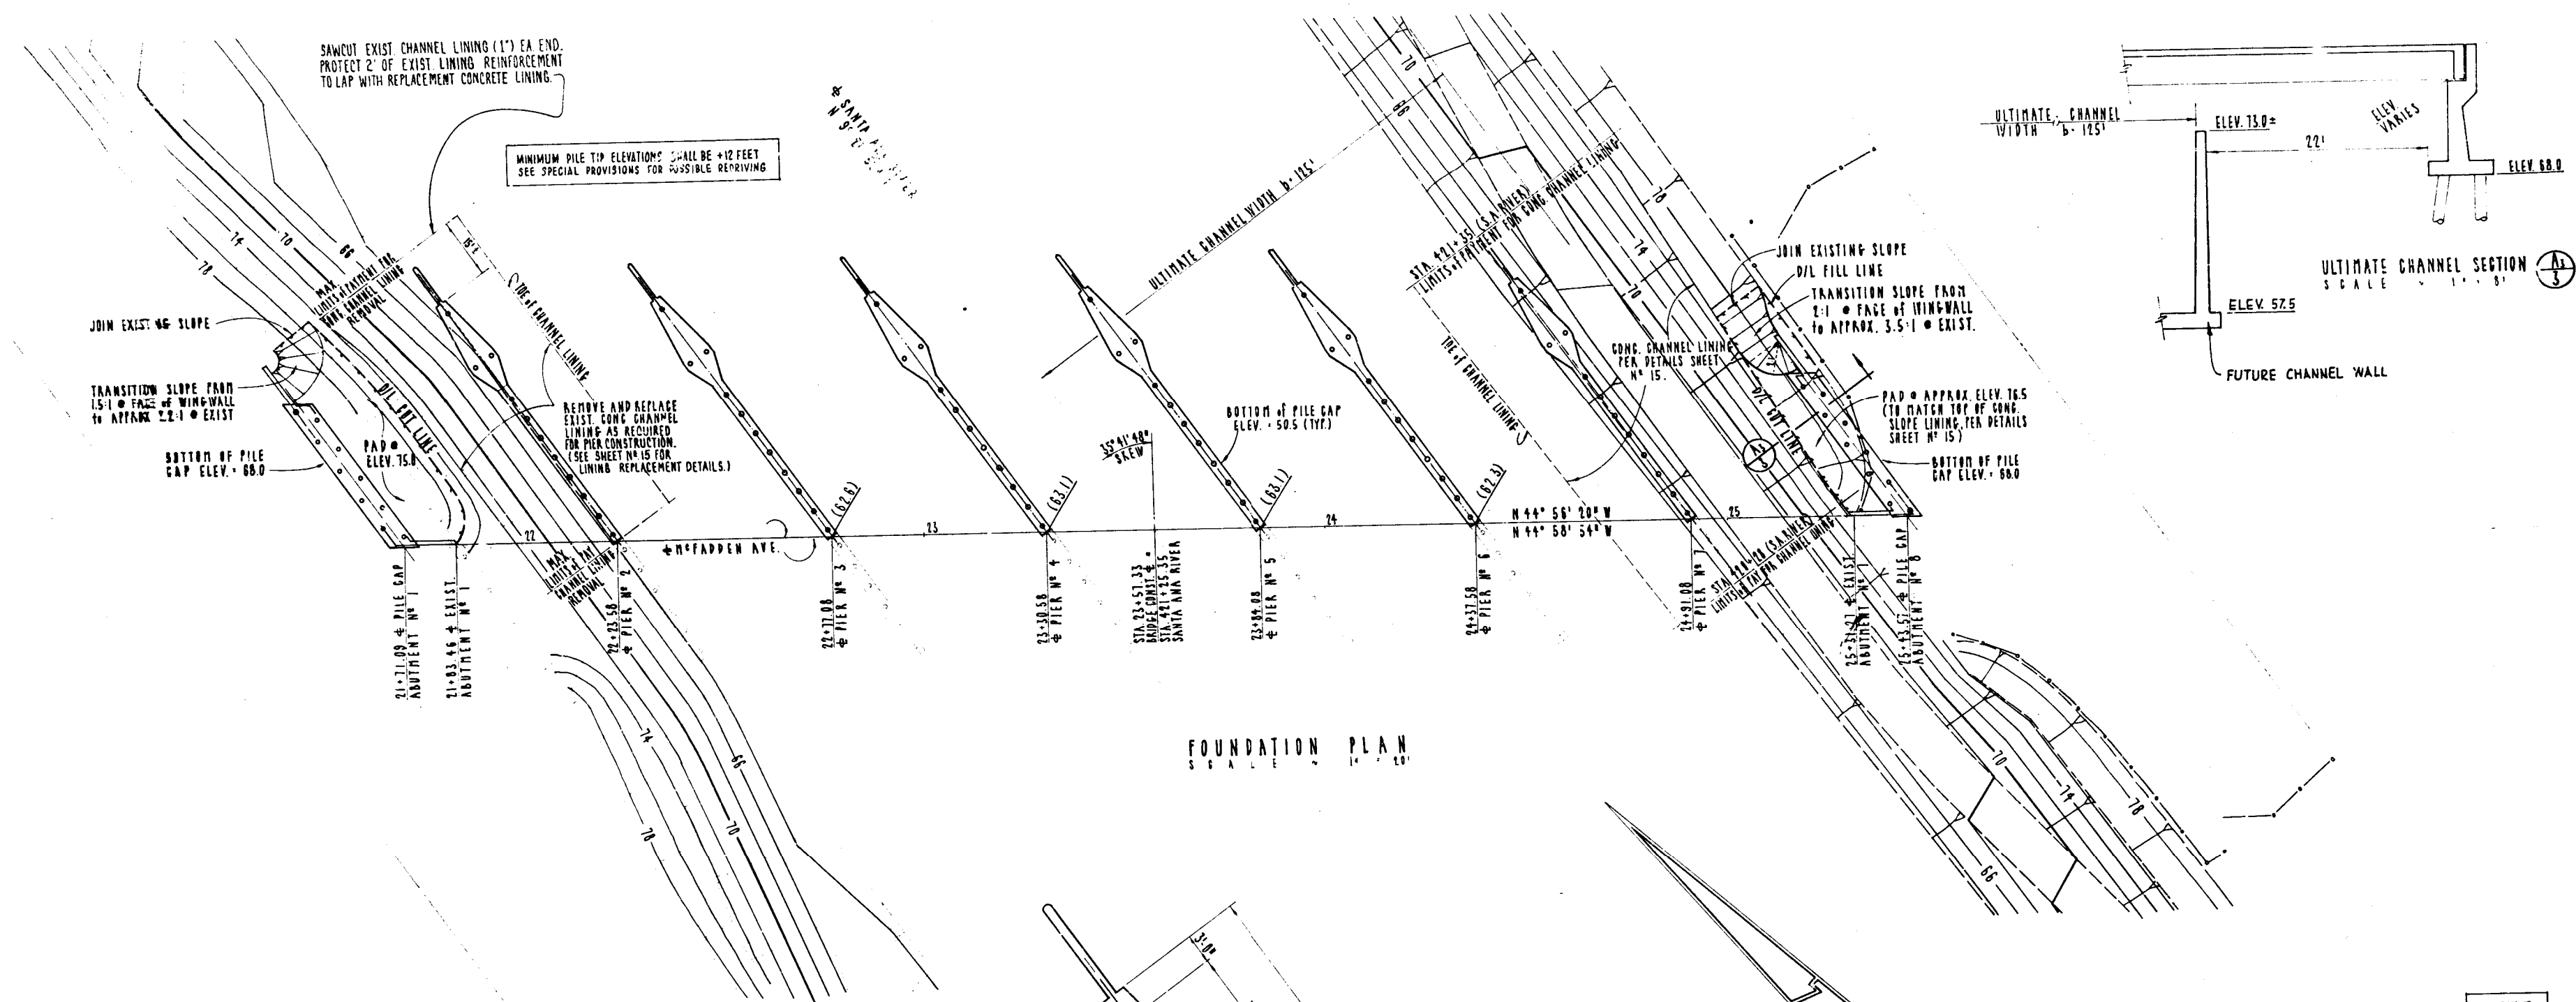

		CUTOFF ELEV.	SPEC. PILE TIP ELEV.	MIN. PILE LENGTH	AS BUILT AVERAGE TIP PILE ELEV.
ABUT	1	68.25	12.00	56.25	11.25
PIER	2	50.75	12.00	38.75	10.76
PIER	3	50.75	12.00	38.75	9.58
PIER	4	50.75	12.00	38.75	9.66
PIER	5	50.75	12.00	38.75	11.17
PIER	6	50.75	12.00	38.75	10.97
PIER	7	50.75	12.00	38.75	10.75
ABUT	8	68.25	12.00	56.25	11.92

NOTES

1. PILE TYPE : GLASS TO CONCRETE PILES
2. EXISTING SLOPES ARE APPROXIMATE ONLY

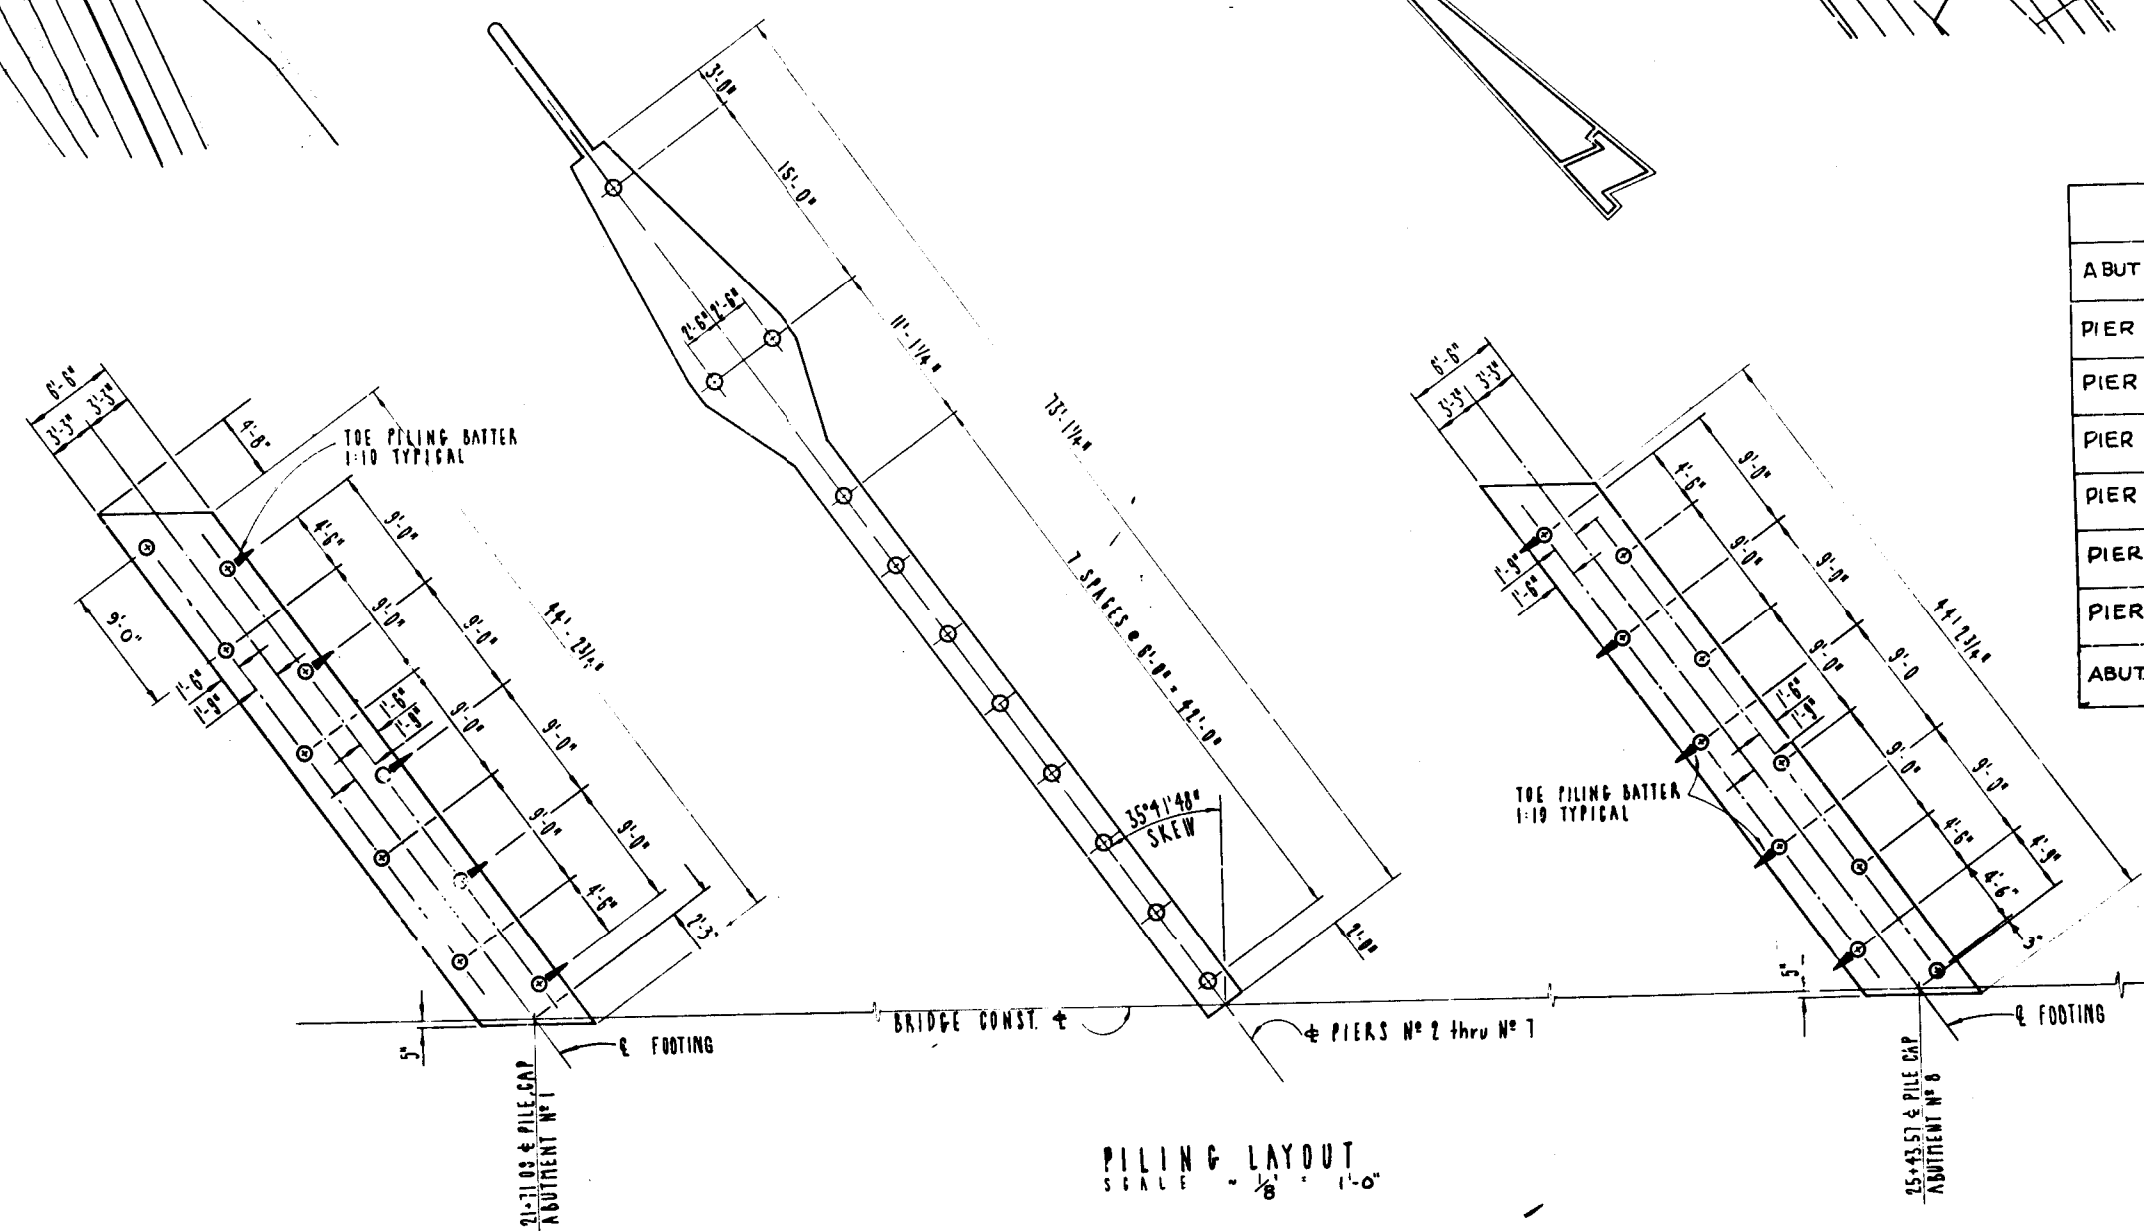

ORANGE COUNTY ROAD DEPARTMENT

No. 50074
 Date 11-1-54
 City LOS ANGELES
 State CA

**McFADDEN AVENUE BRIDGE WIDENING
 OVER THE
 SANTA ANA RIVER**

FOUNDATION PLAN

SCALE AS NOTED

SHEET 3 of 18

DR. #13 (12300)