
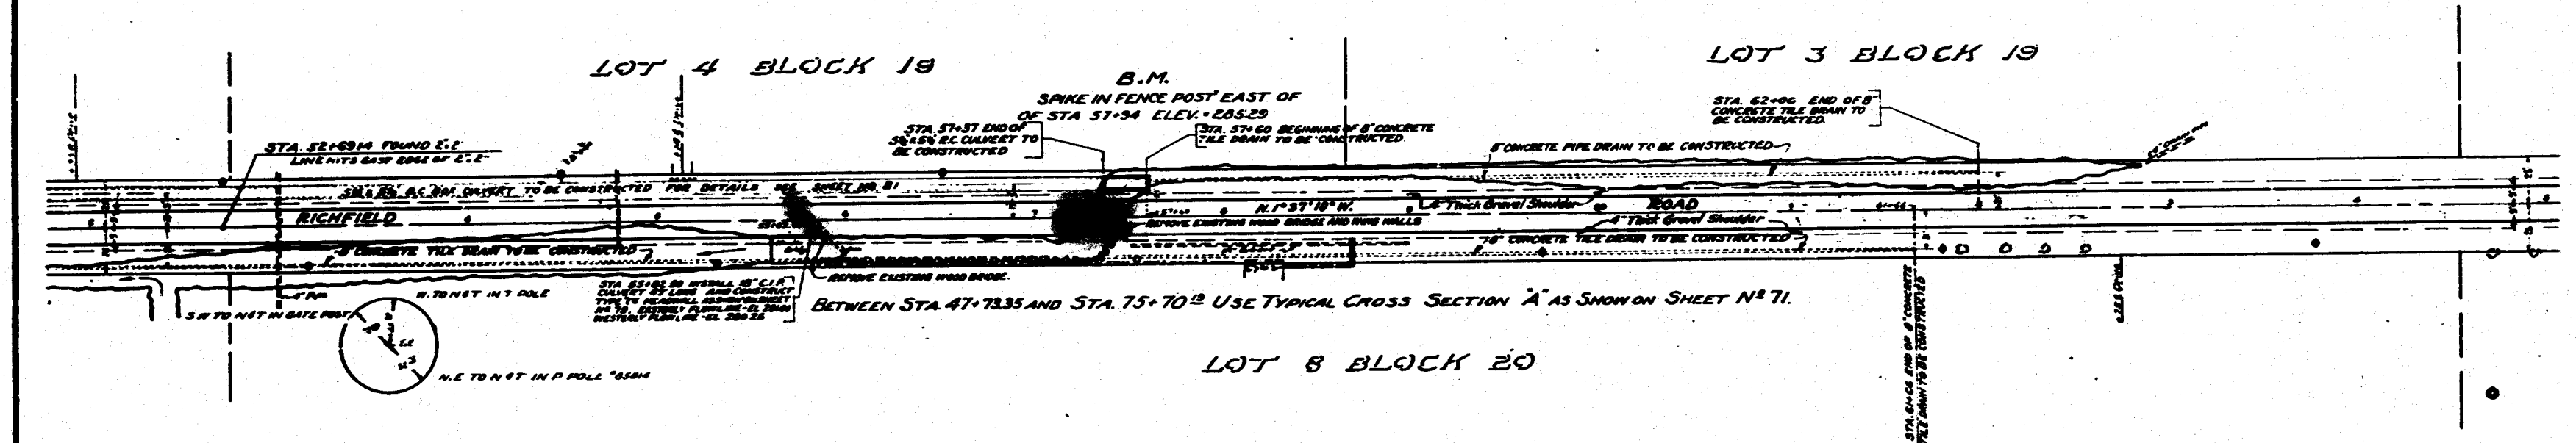


ACQUISITION AND IMPROVEMENT DIST. NO. 1.
SHEET NO 65 OF 104 SHEETS
Scale: - 1"=50' Hor. 1"=5' Vert.
Approved _____ Engineer _____


YORBA LINDA TRACT

M.M.S. PAGES 17-18

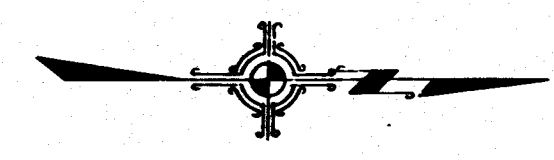

Culvert # S-199
Remodeling of Culvert
at Morris Ave & Richfield Rd
Sheet 2 of 3
Scale 1"=50' H
1"=5' V
Blue-line Print

Points on left vertical line are ground elevations on center line.
Points on right vertical line represent crown grades of paving.
Elevations shown on plans and referred to in specifications are the
number of feet above the U.S. Coast and Geodetic Datum Plane.

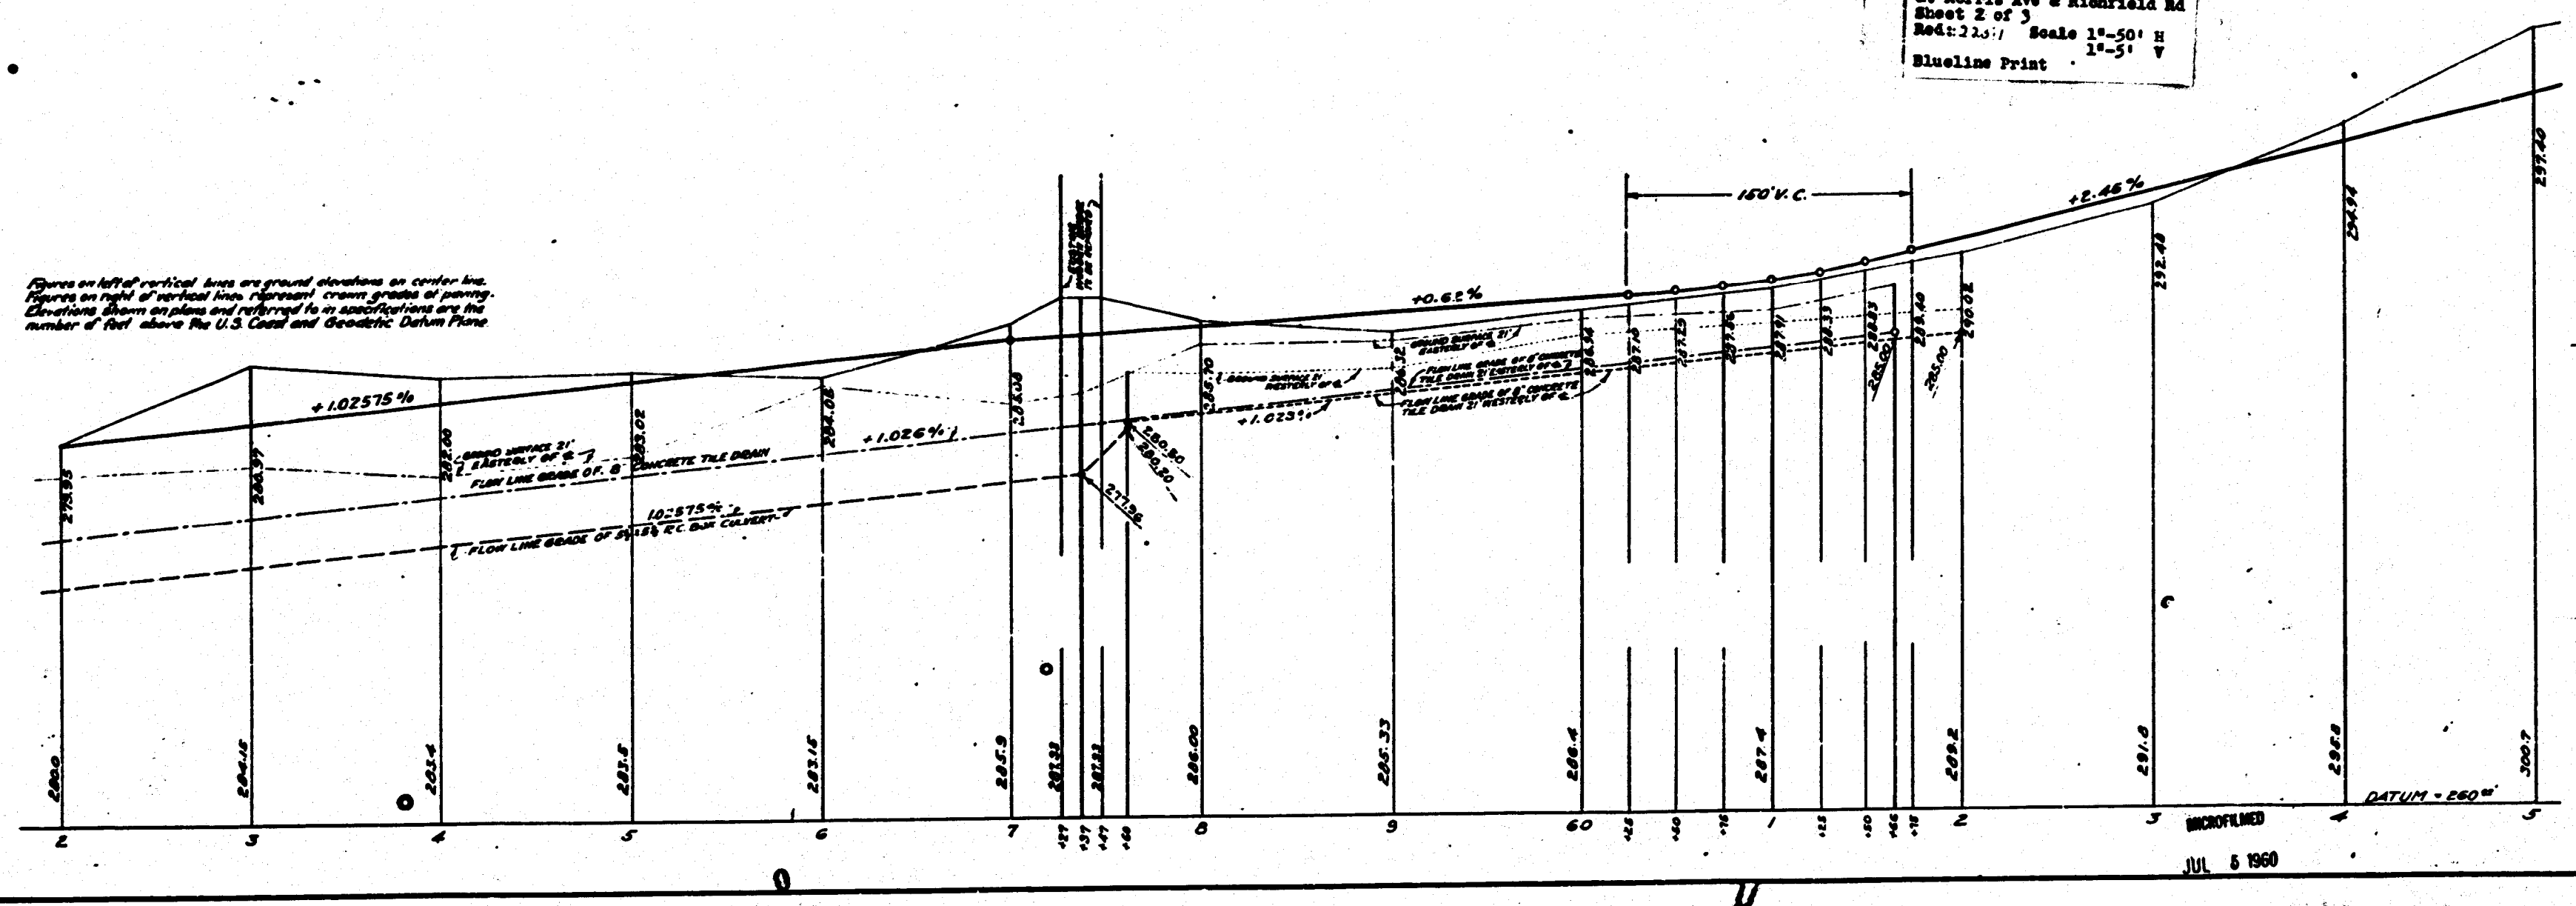

MICROFILMED
JUL 5 1960

S-199