


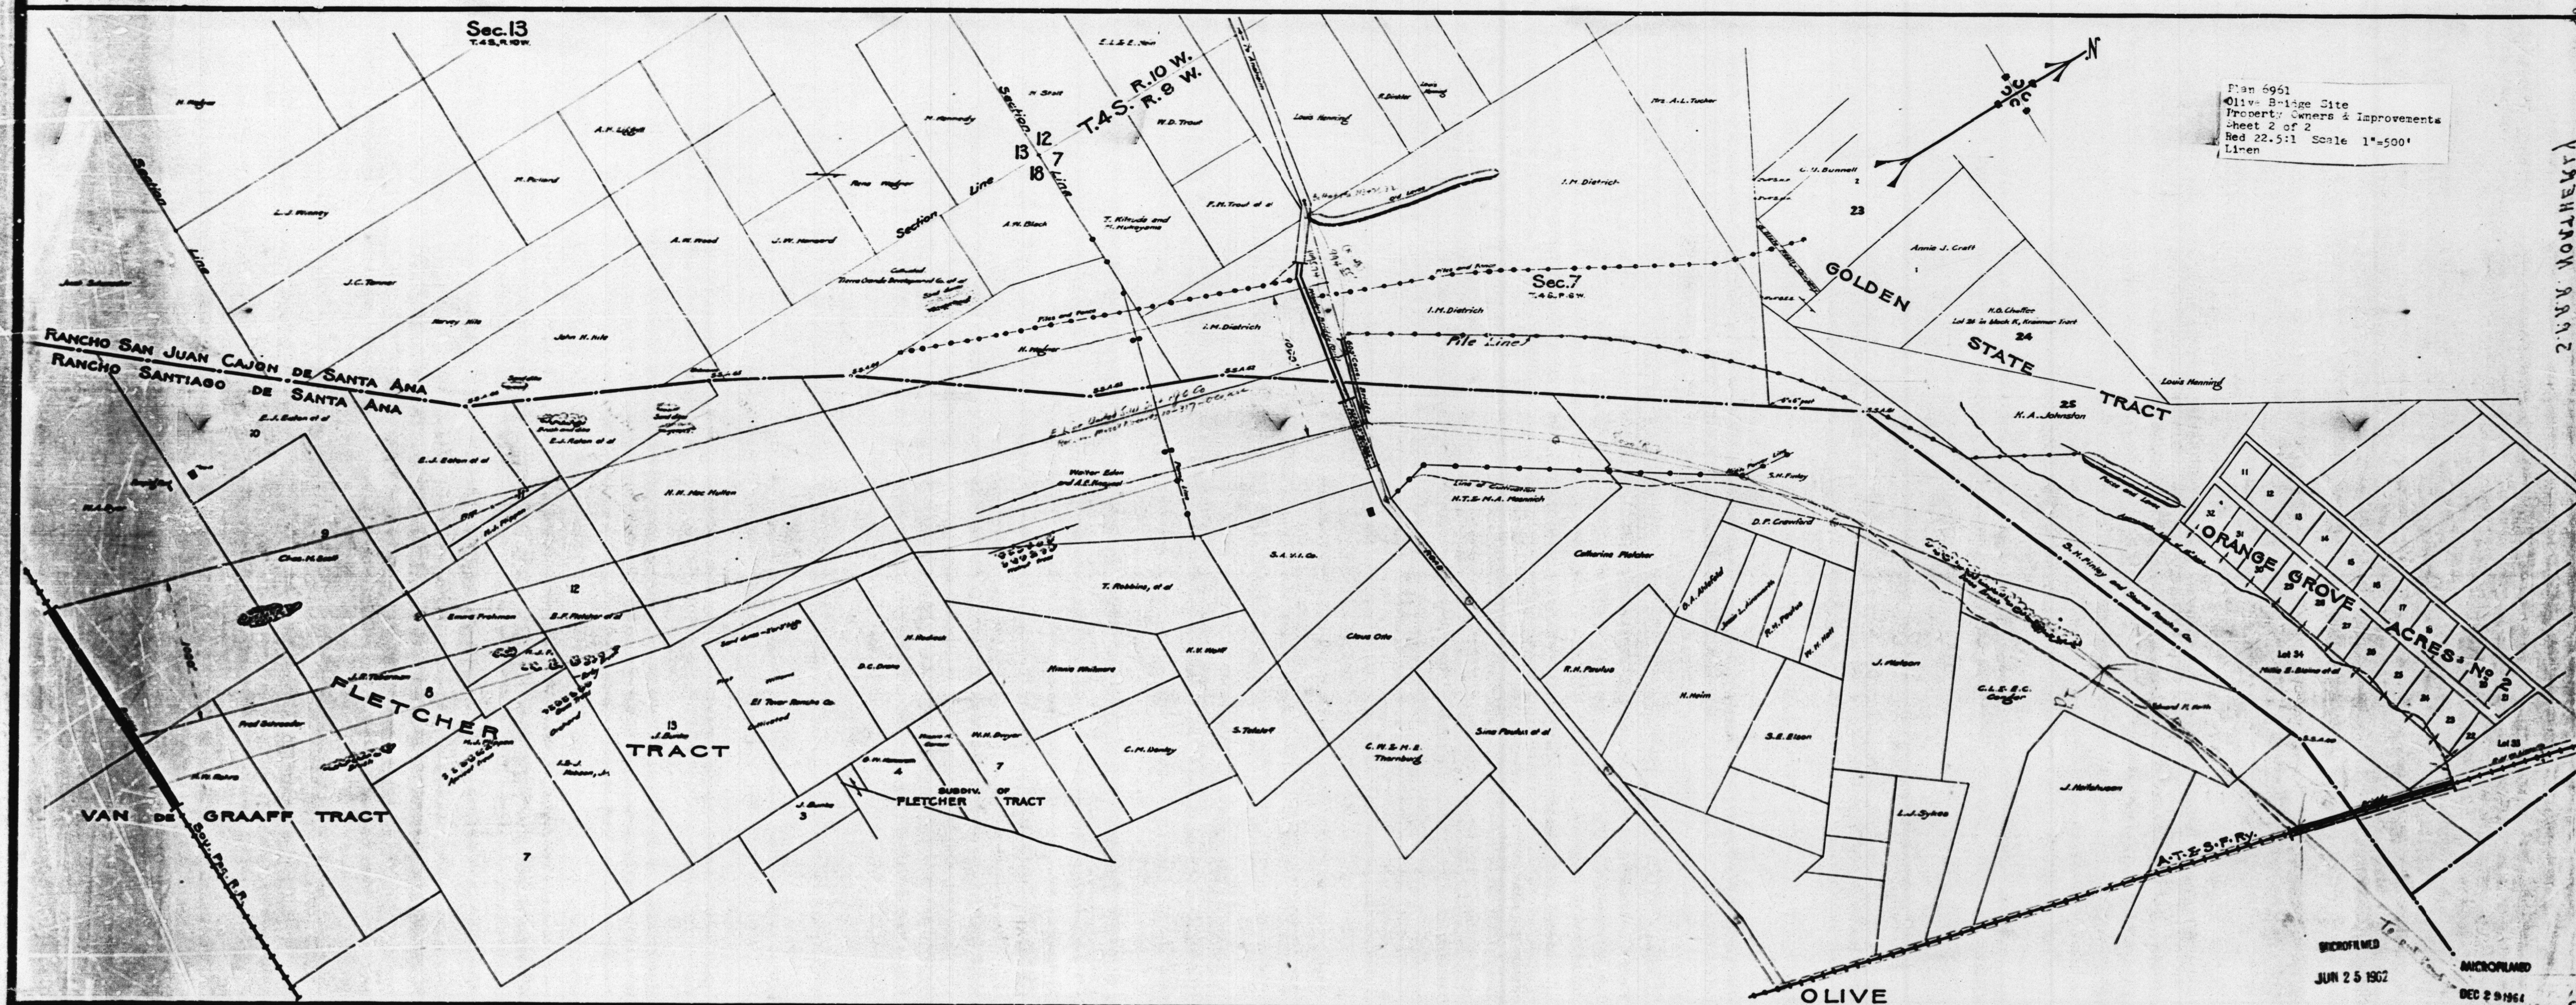

Doc: (6964)

Olive Bridge Site

sheet 2 of 2

Dr # 1 (L961)

УДК 62-75