


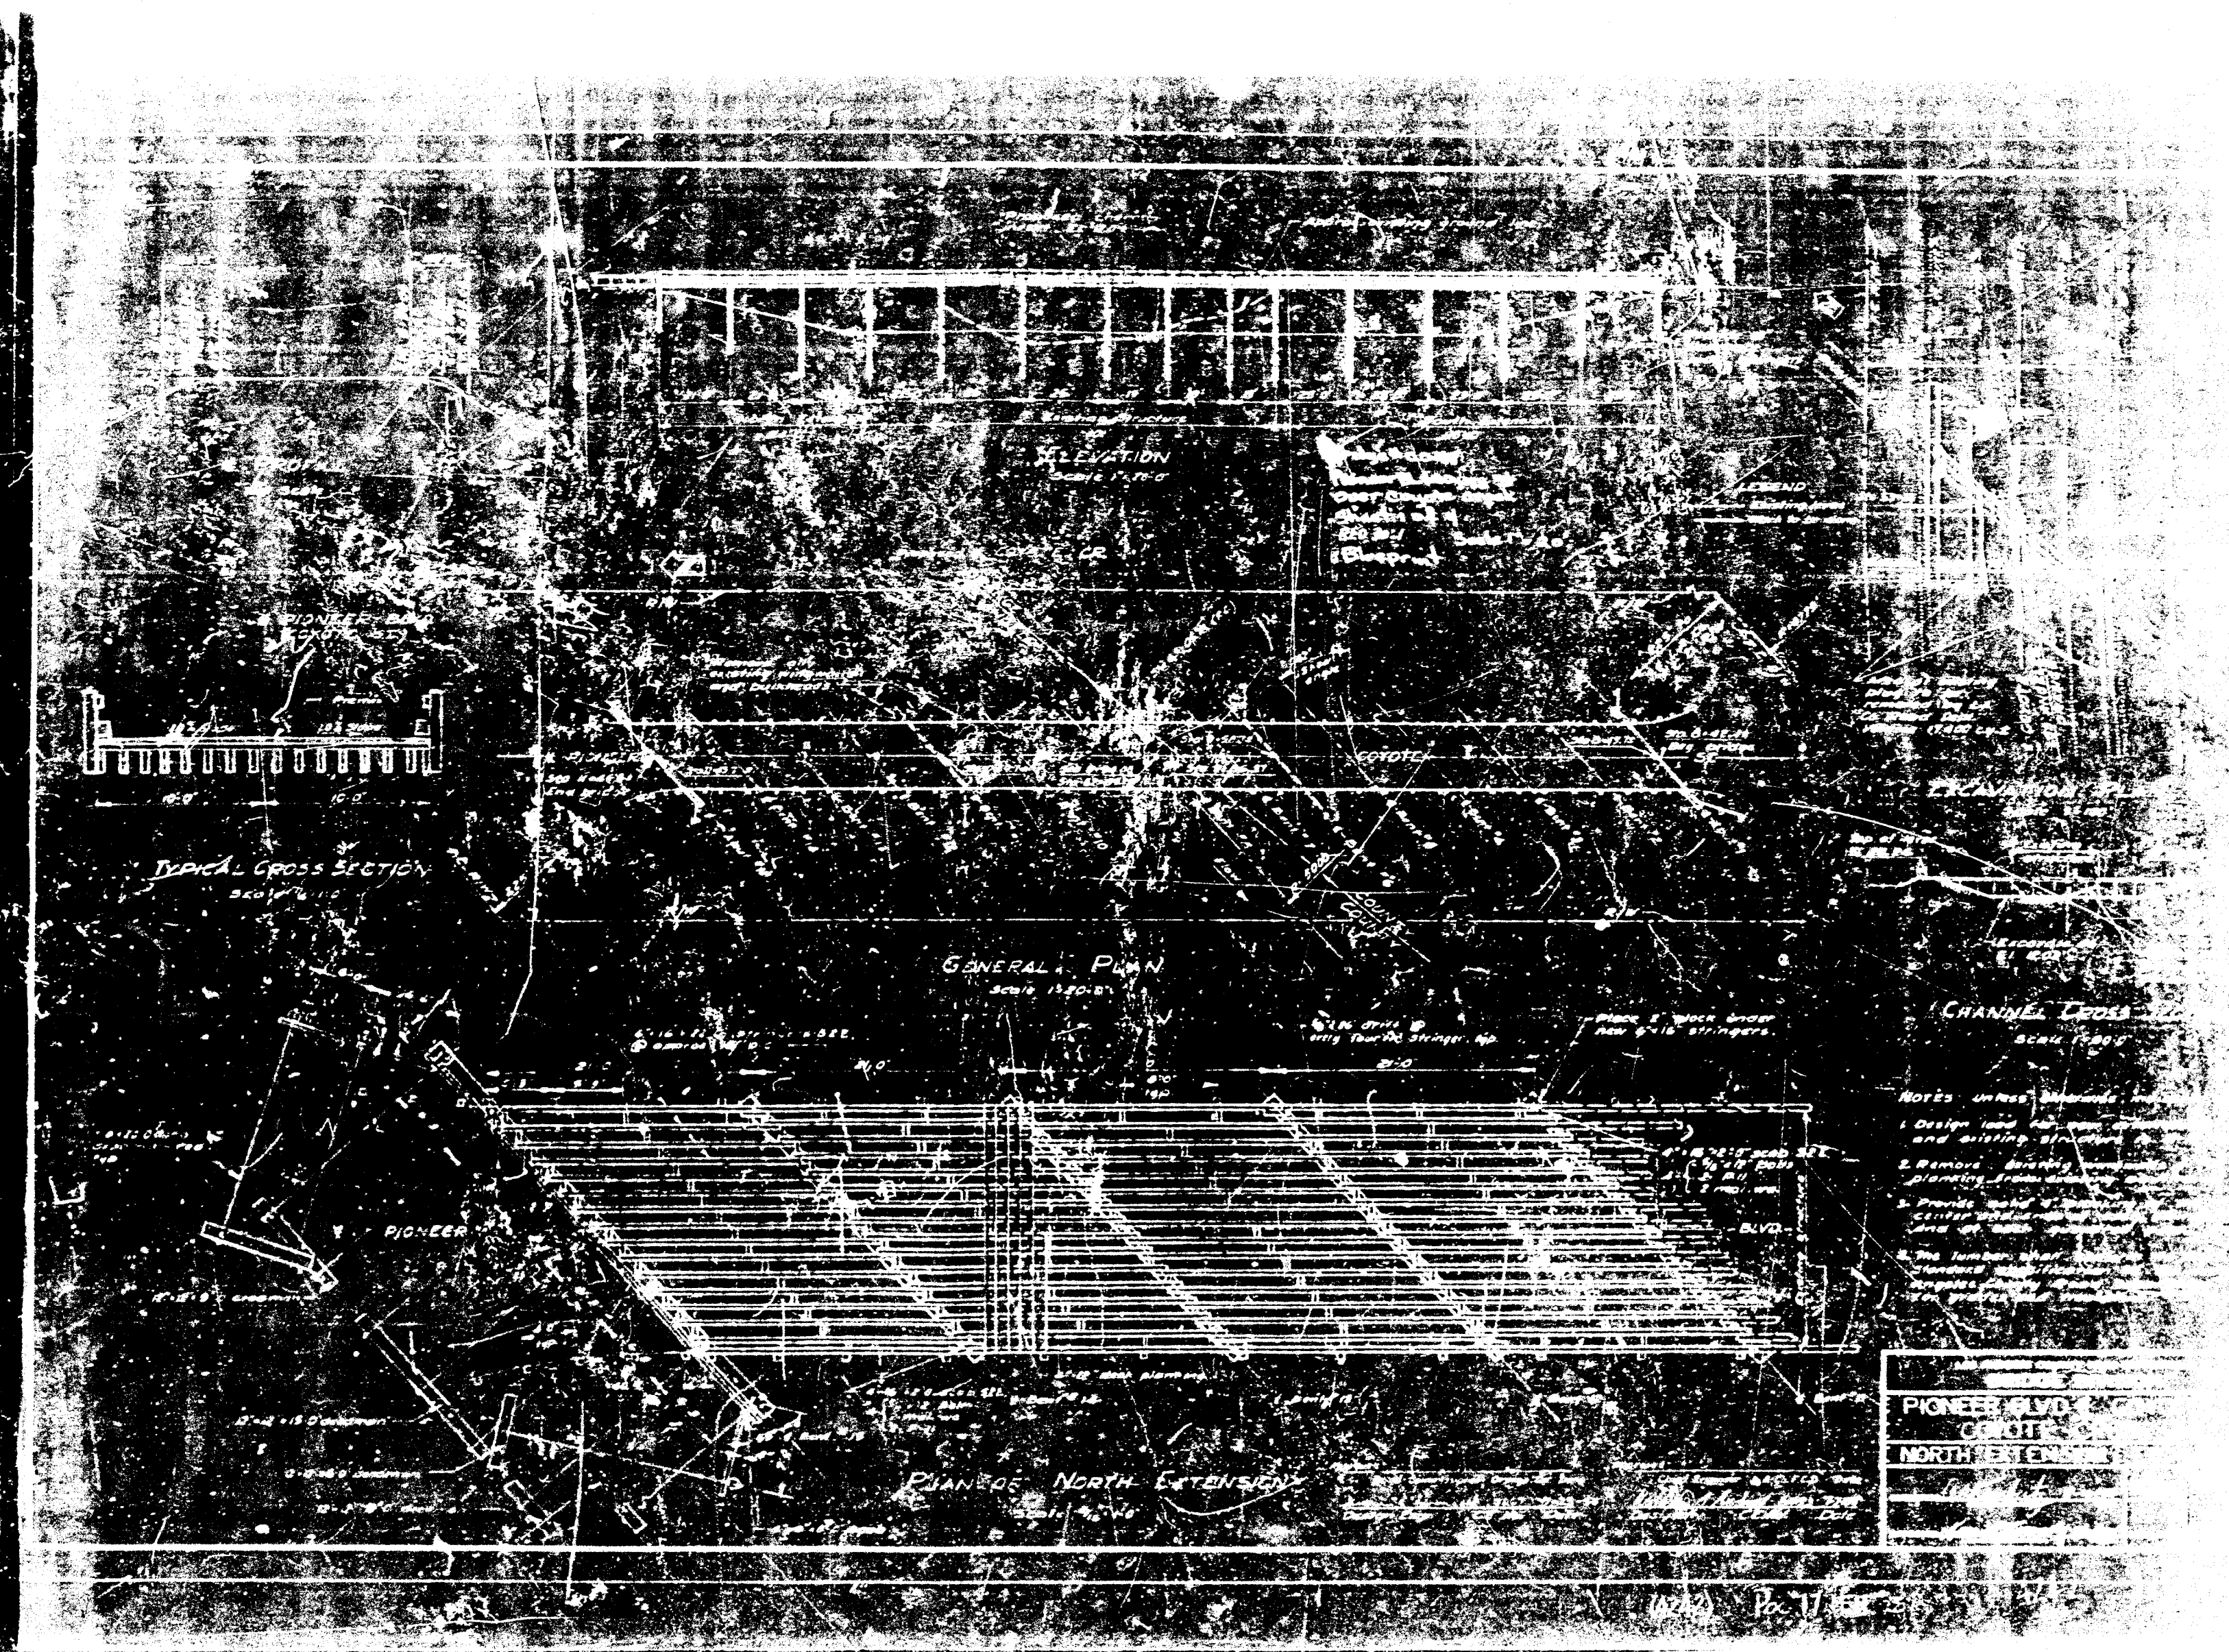

$$W = 20'$$

$$L = (21 \times 4) + (25 \times 5) = 209'$$

Skew: 42°

Apprv. 8/1954
 PIONEER ~~BLVD & COYOTE CREEK~~
 B.R. over COYOTE Creek.
 #1451/
 CO-44
 Thw: 708-H7