



ELEVATION
SCALE 1"=4'


NOTE: Remove concrete from NW wing wall to level of existing deck and remove any concrete necessary from any wing wall to obtain proper bearing on original wing wall. Check also construction for all sloping portions of wing walls. See Section A-A. Raising of approach to new bridge level is not a part of this contract.

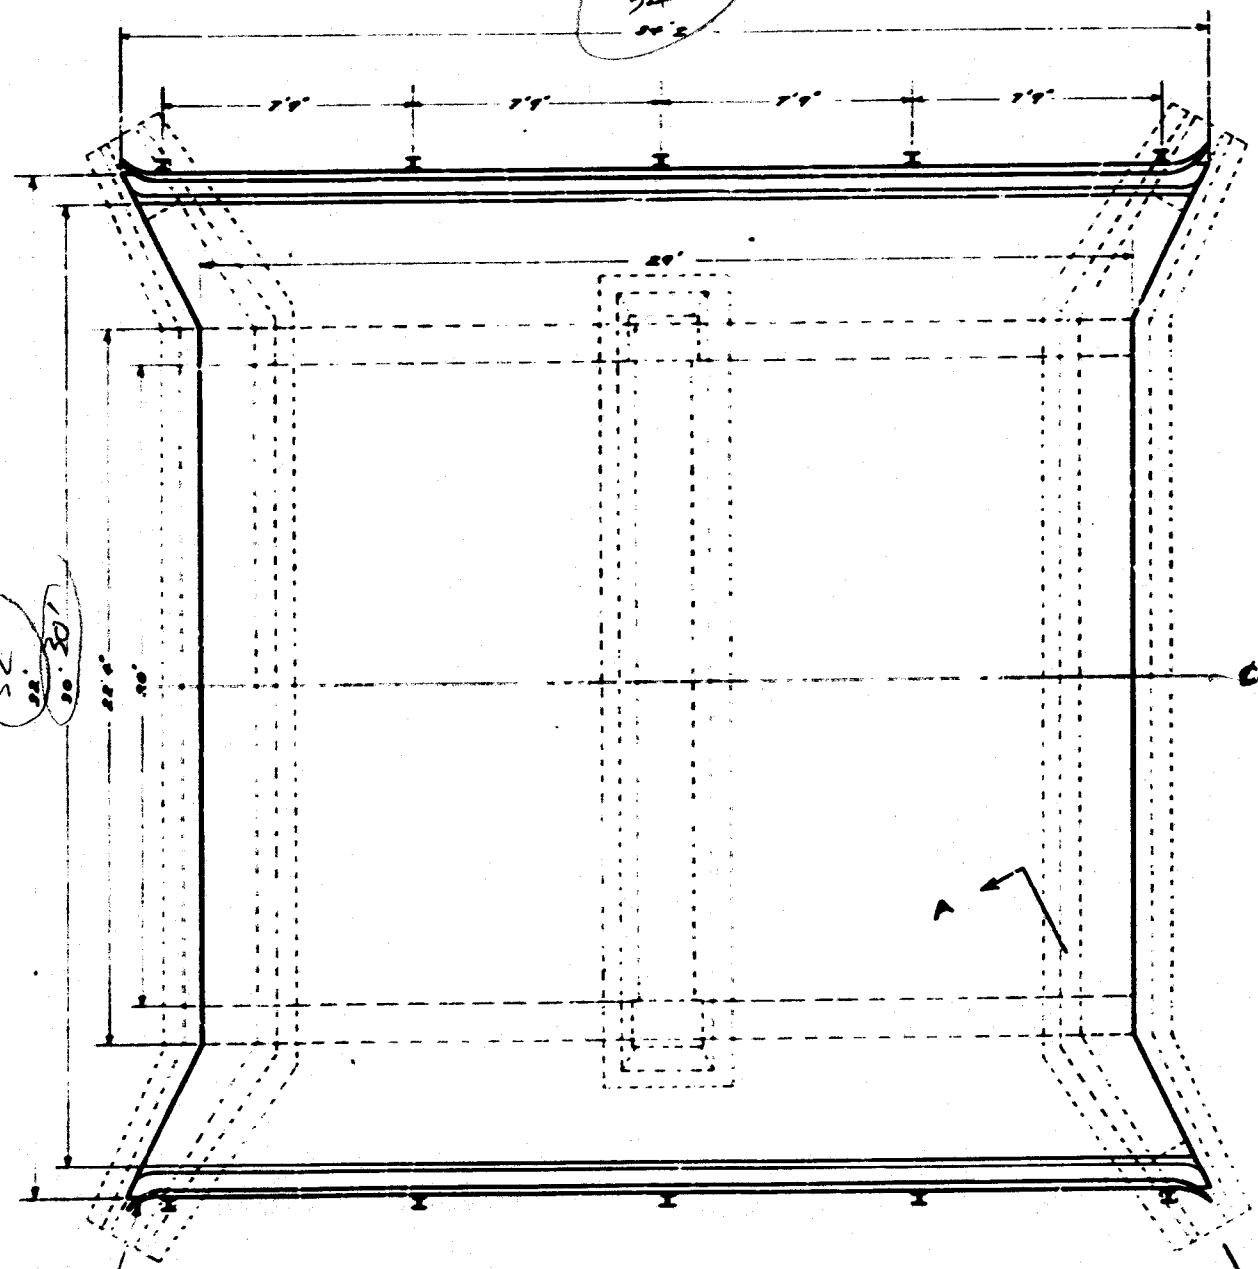


PLAN
SCALE 1"=4'

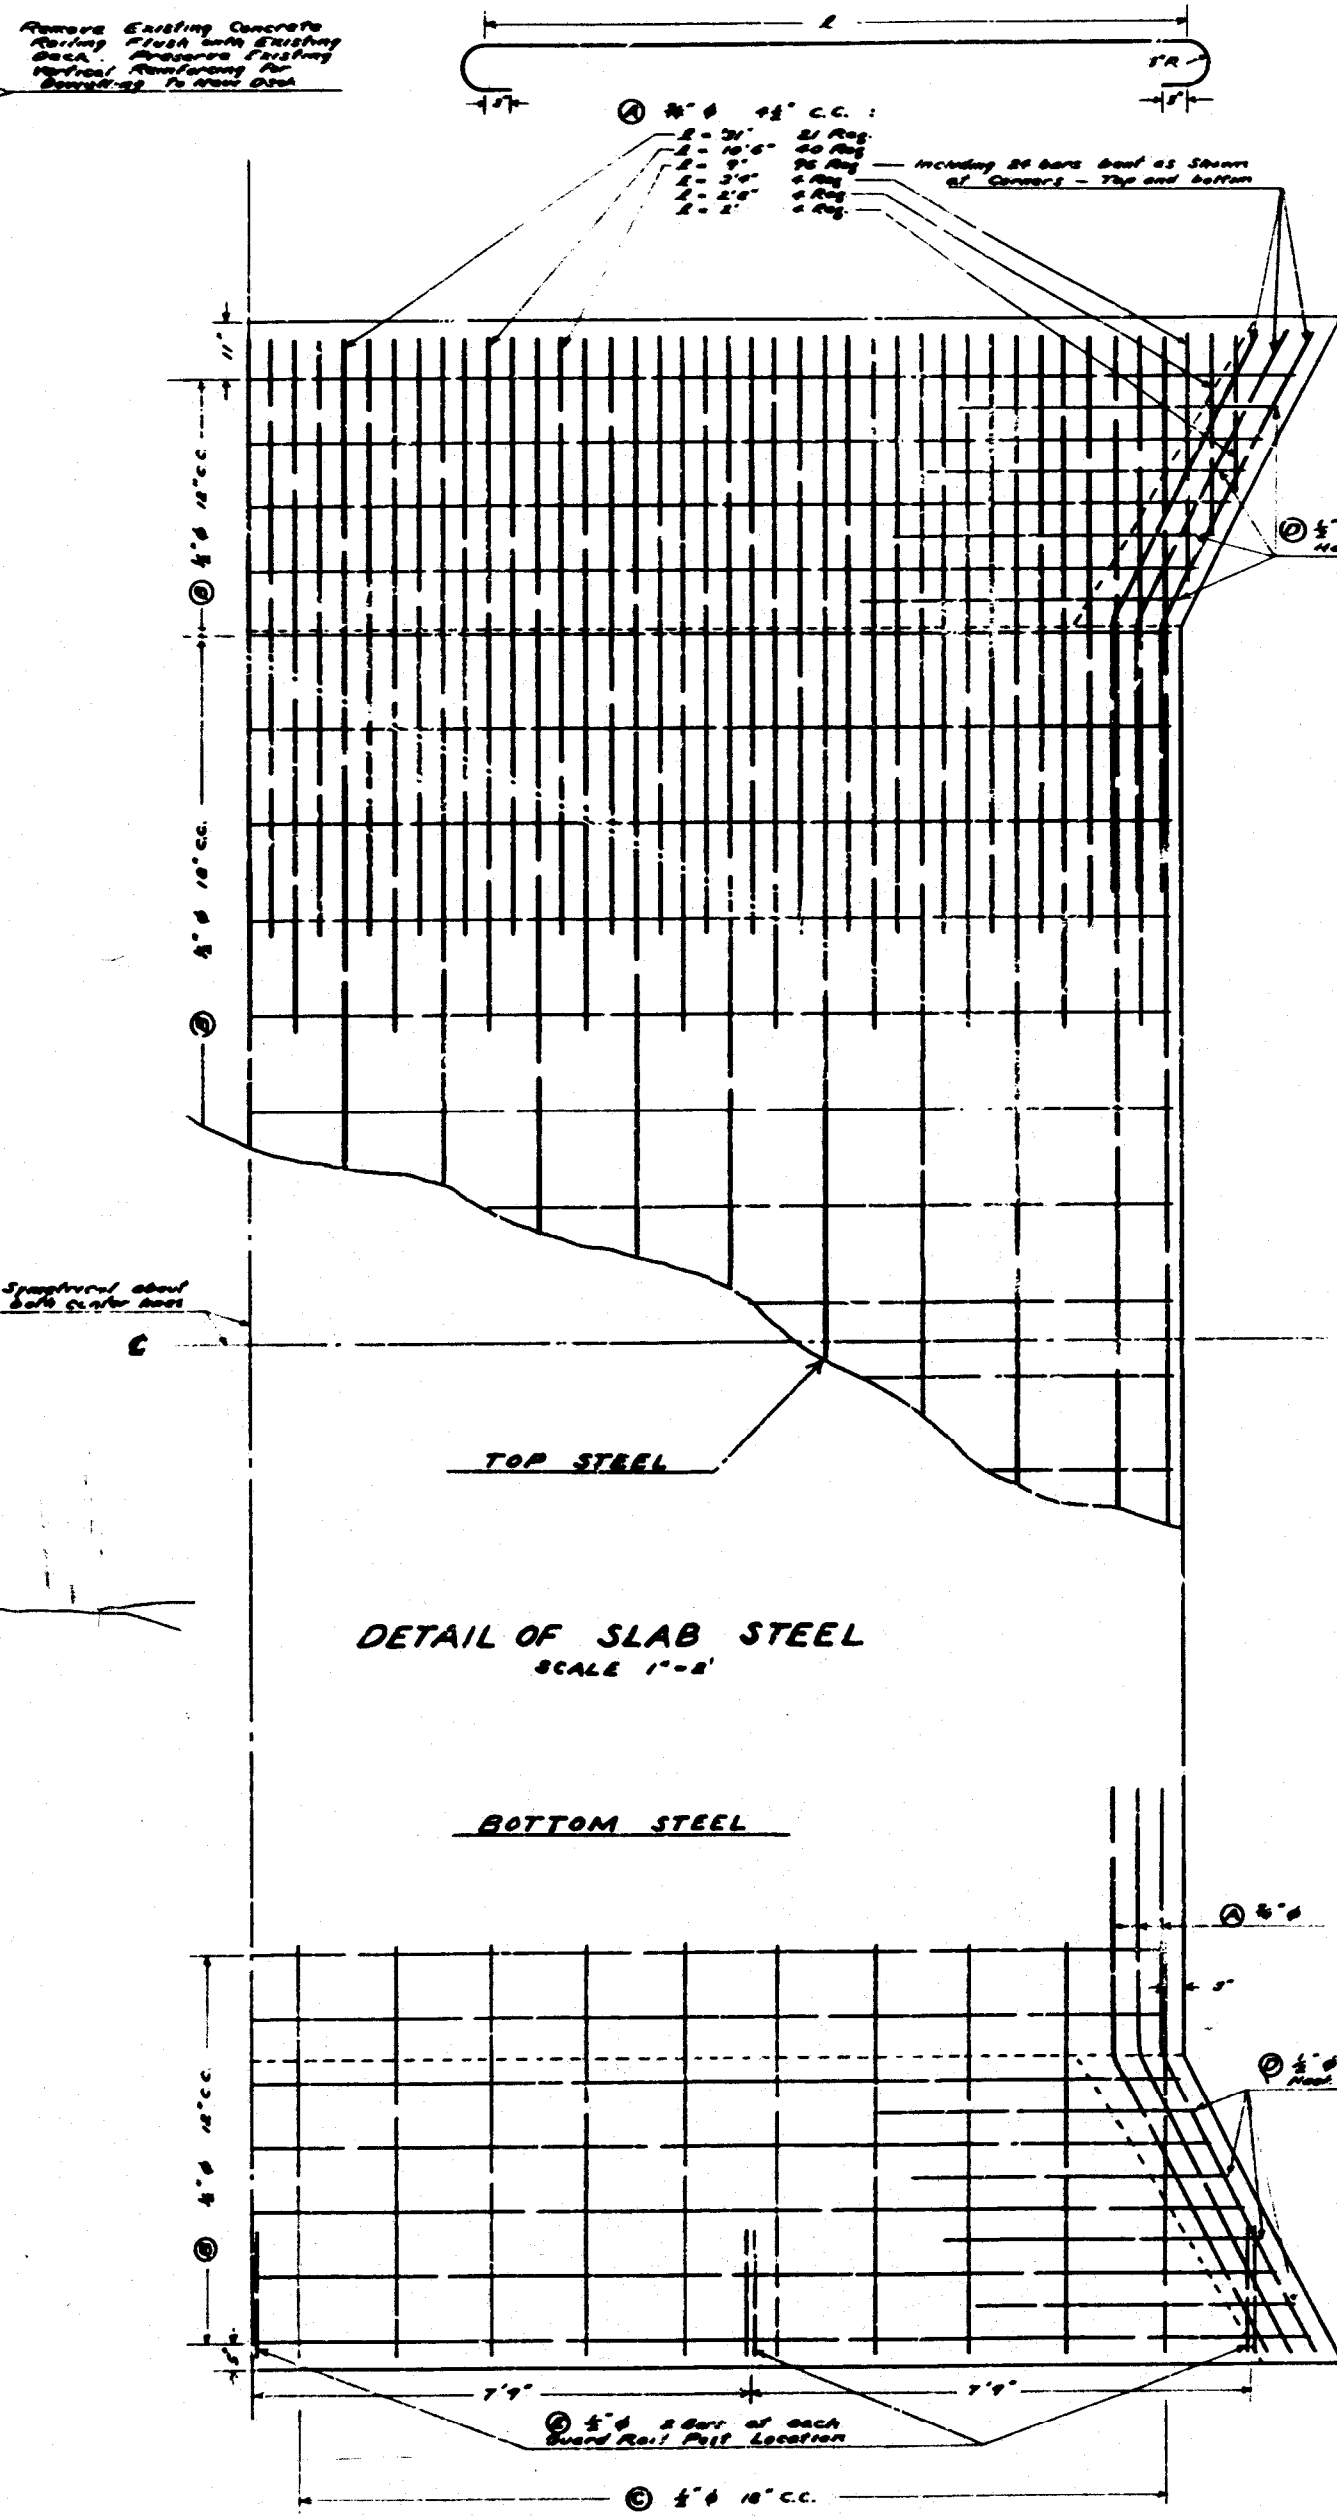


DETAIL OF SLAB STEEL
SCALE 1"=4'

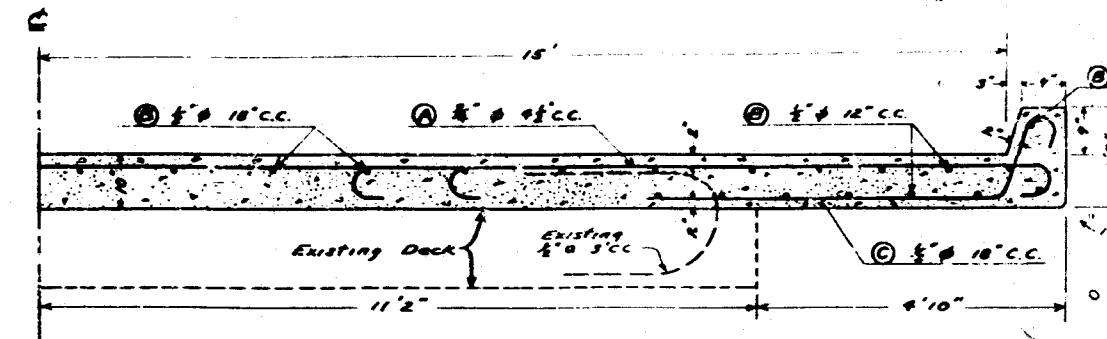


SECTION
SCALE 1"=2'

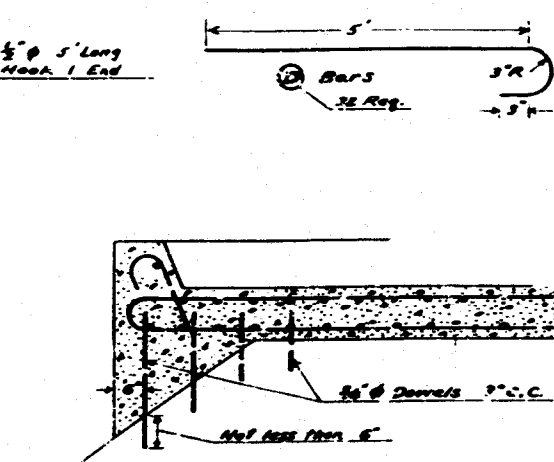

SECTION A-A
SCALE 1"=2'

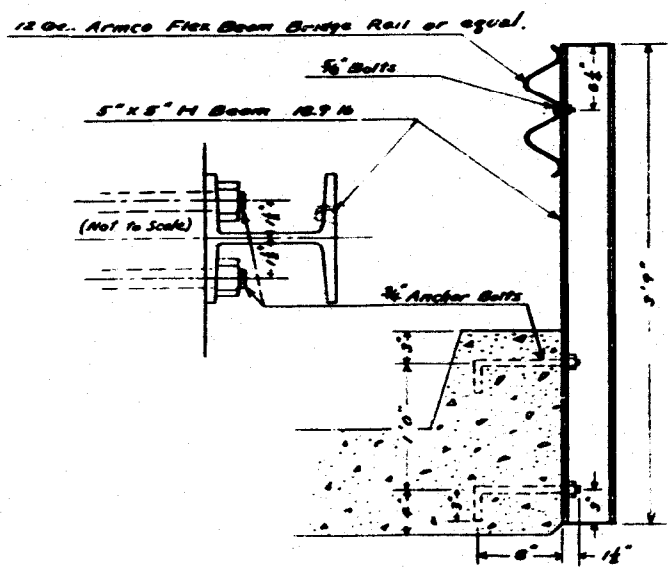

GUARD RAIL DETAIL
SCALE 1"=1'

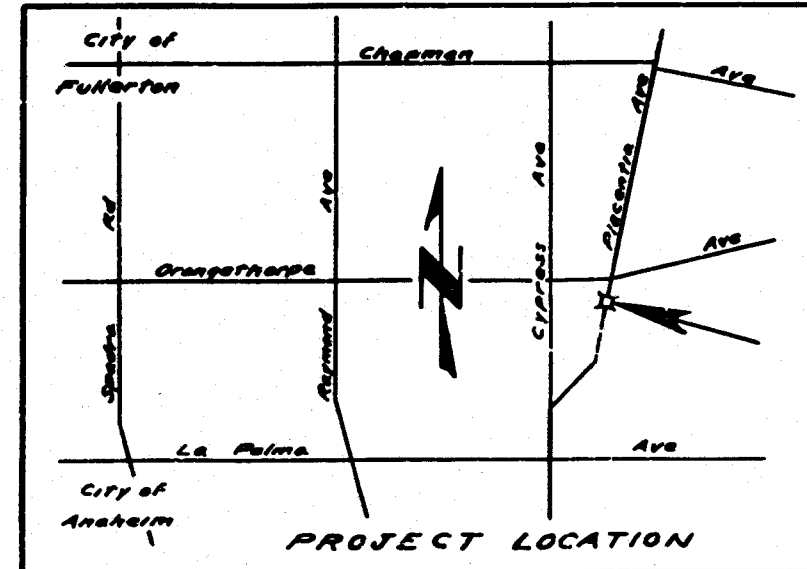

PLAN FOR
THE WIDENING OF
PLACENTIA AVENUE BRIDGE
STRUCTURE 30-30 ORANGE COUNTY ROAD DEPT.

Approved: *[Signature]*
H. Spranger, Road Commissioner

DESIGNED BY: *[Signature]*
CHECKED BY: *[Signature]*
DATE: JUL 6 1960

W = 32'
30'
L = 34'

Thomas 769-D1 #14671
(SO-30)
(SQUEL WASH)
PLACENTIA AVE BR.
ACROSS SQUEL WASH (SO-30)
(Now is Carbon Creek CB-1) in 1970
0.3 Mi N/O 91 Hwy Cal. # 55C-68