


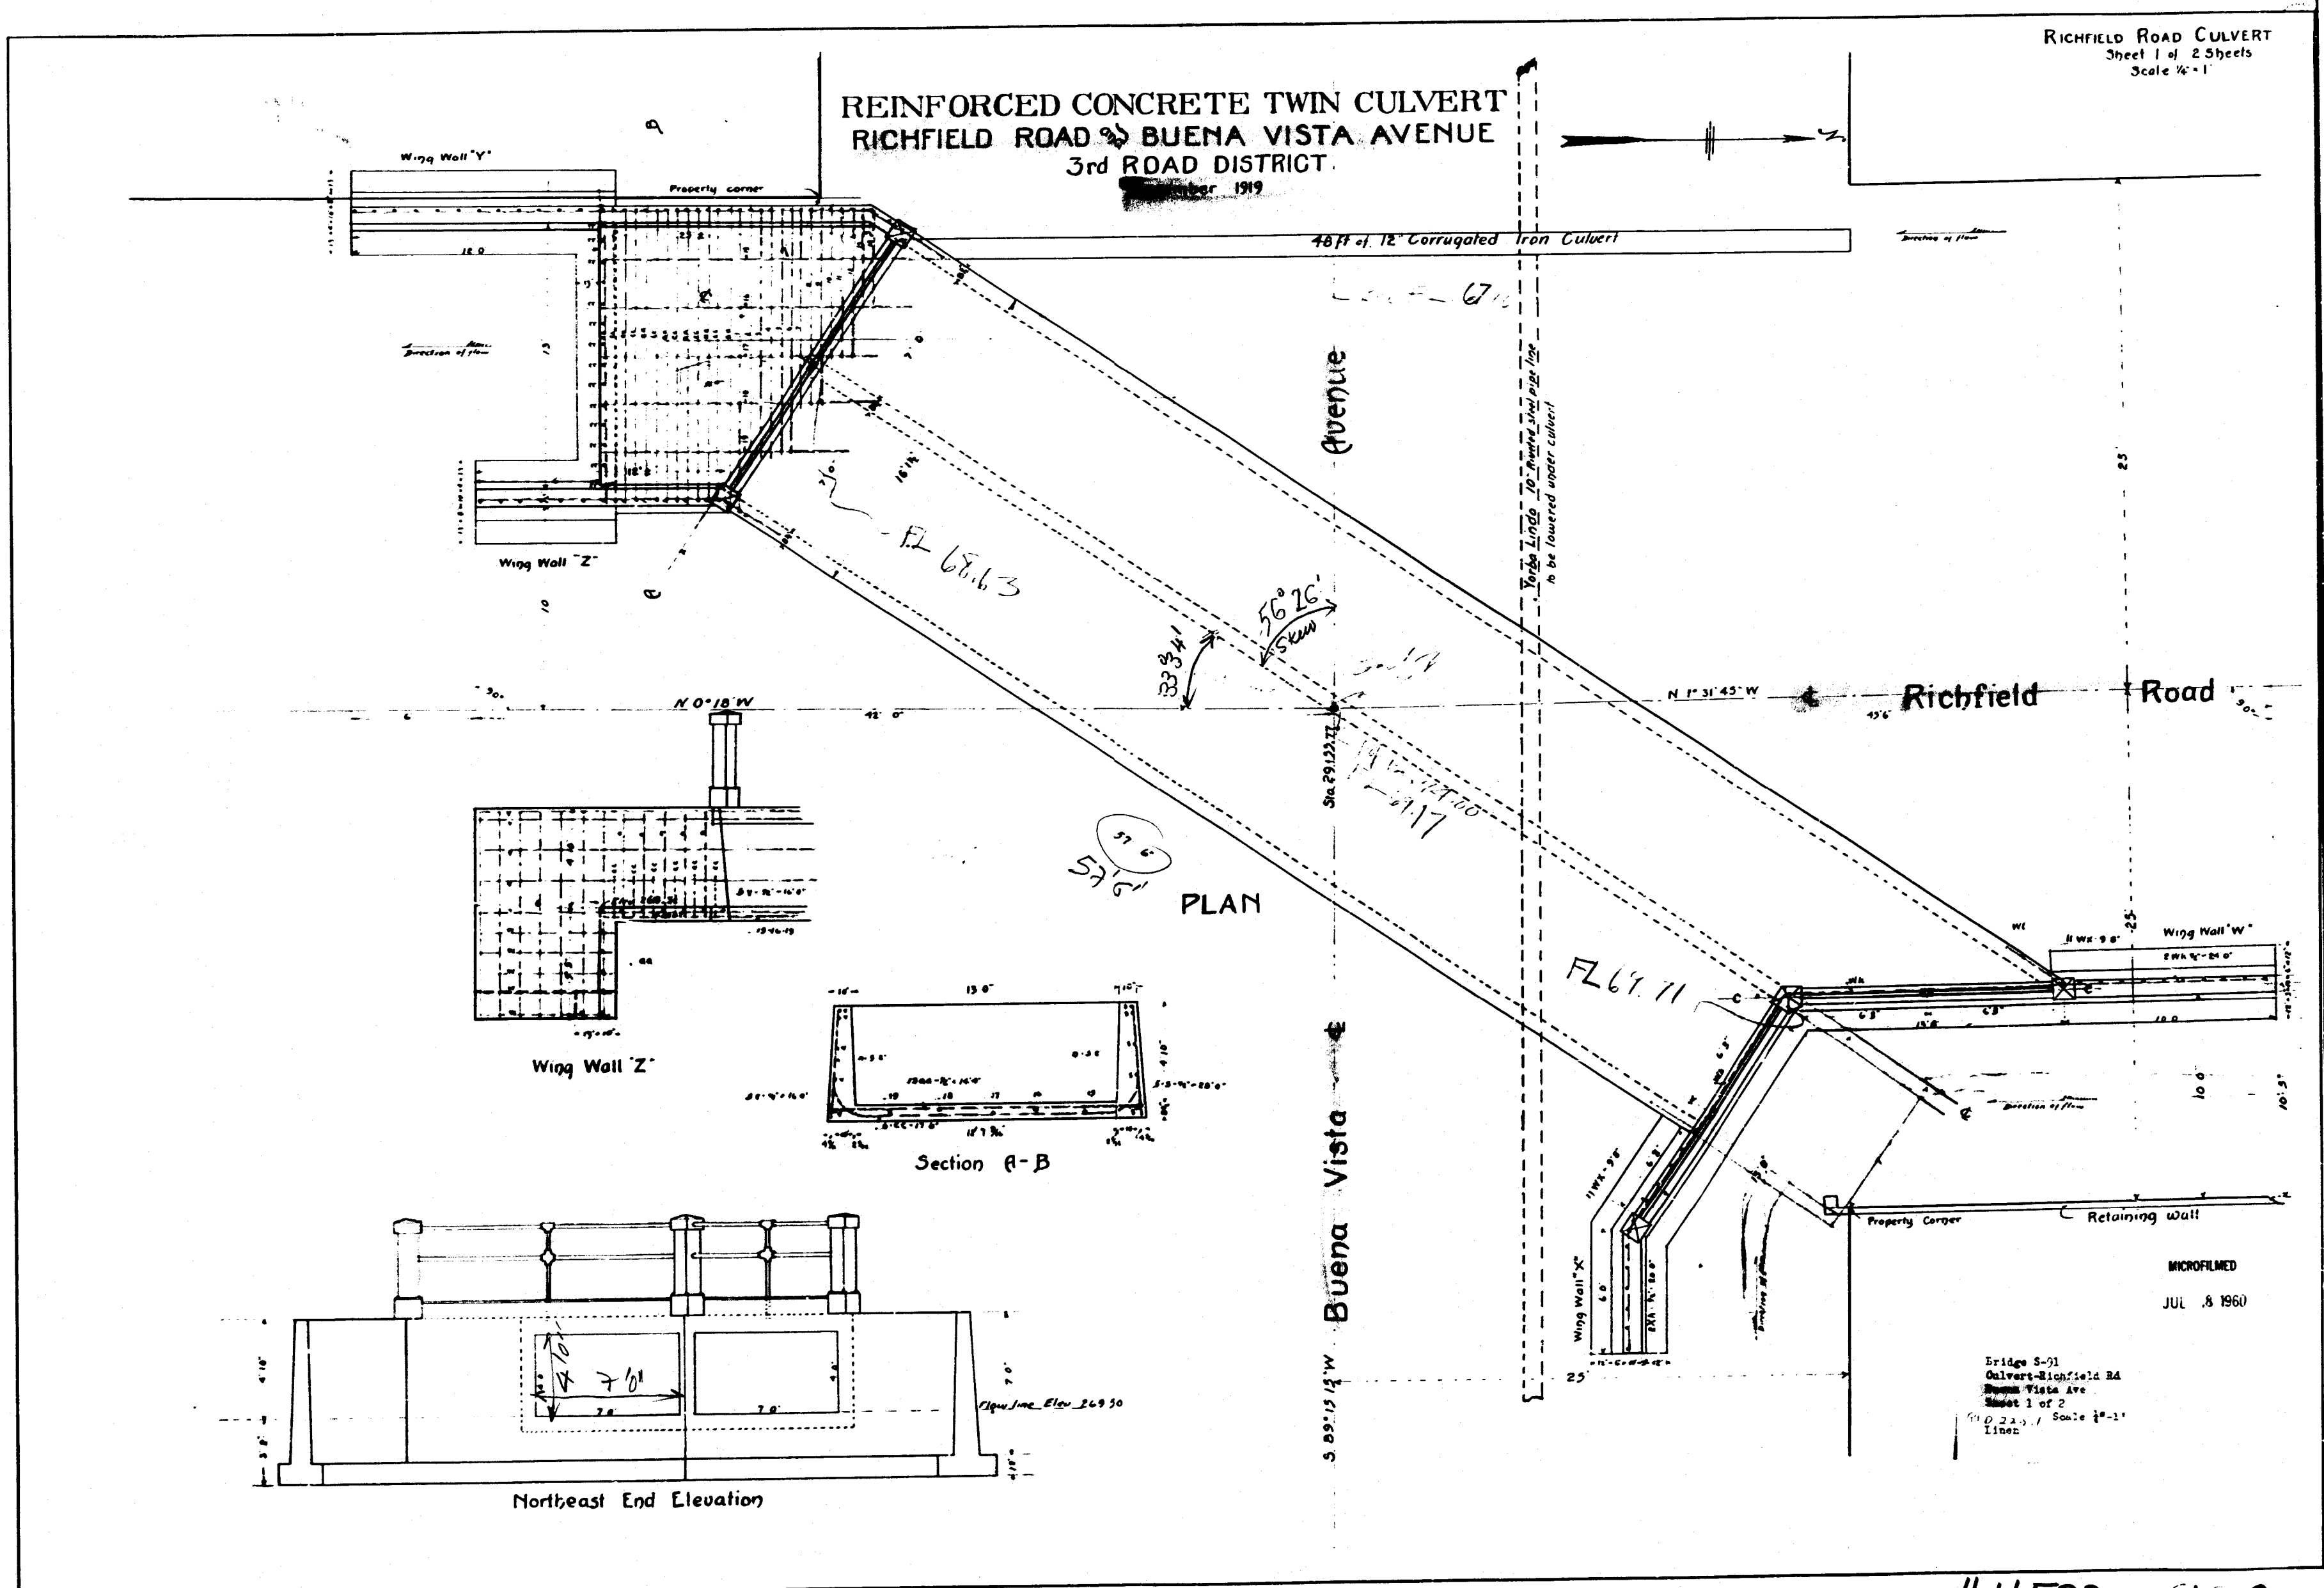

Double #4x7'
L=57.6"
Skew: 56°26'

#14579
S-91
RICHFIELD RD.
@ Buena Vista Av.
Thomas: 240: A5