




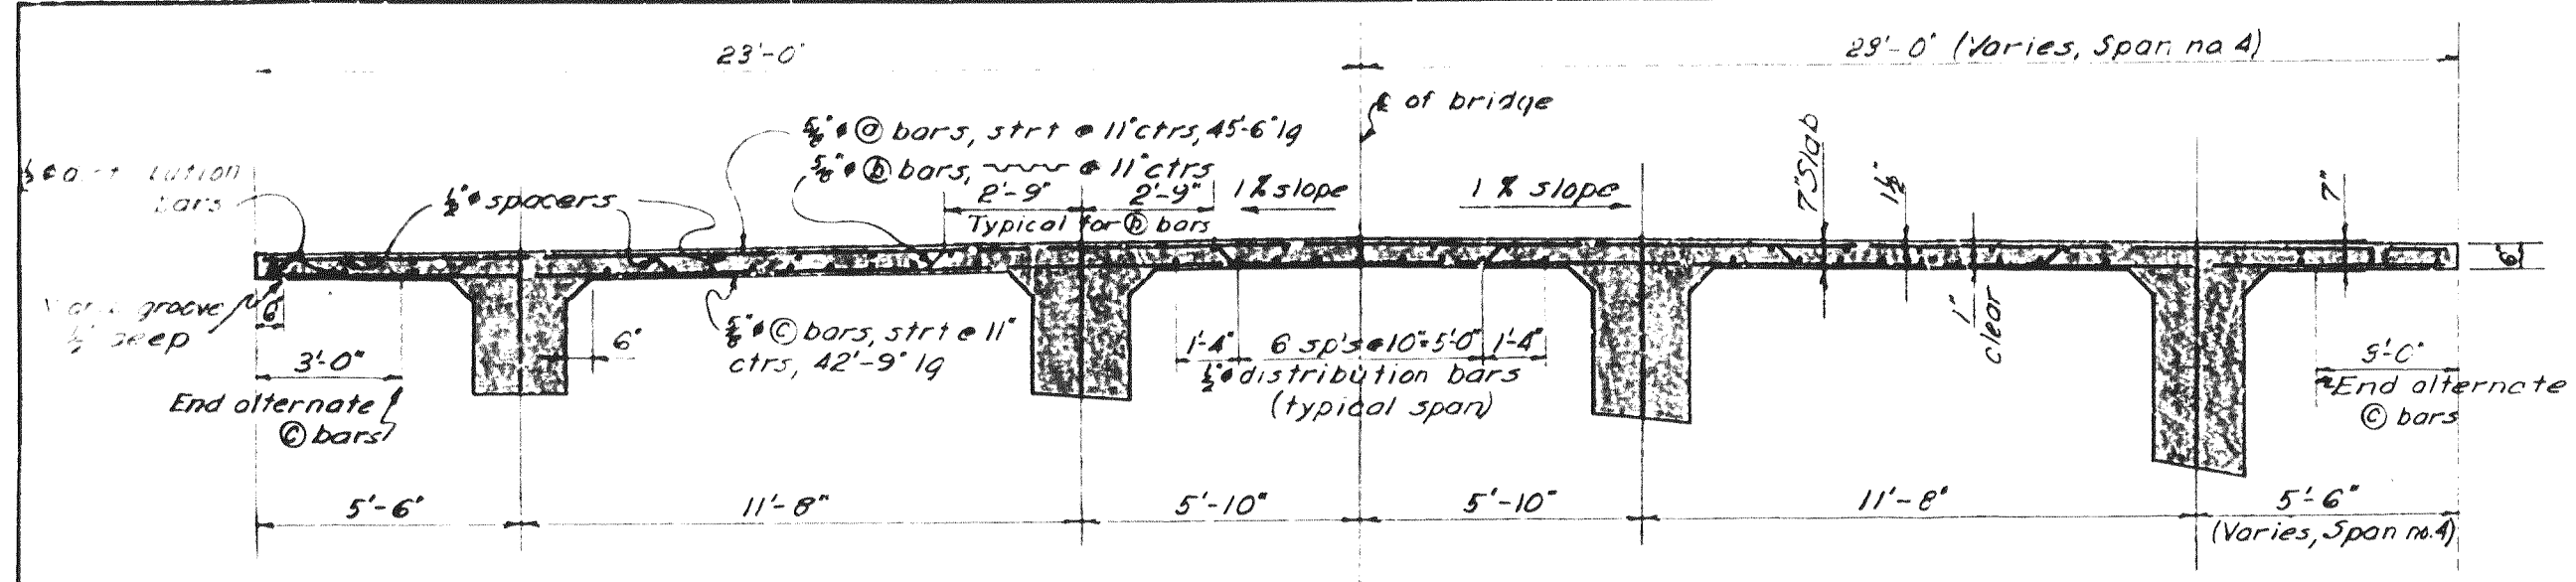

TYPICAL SECTION
Scale: 1/4" = 1'-0"

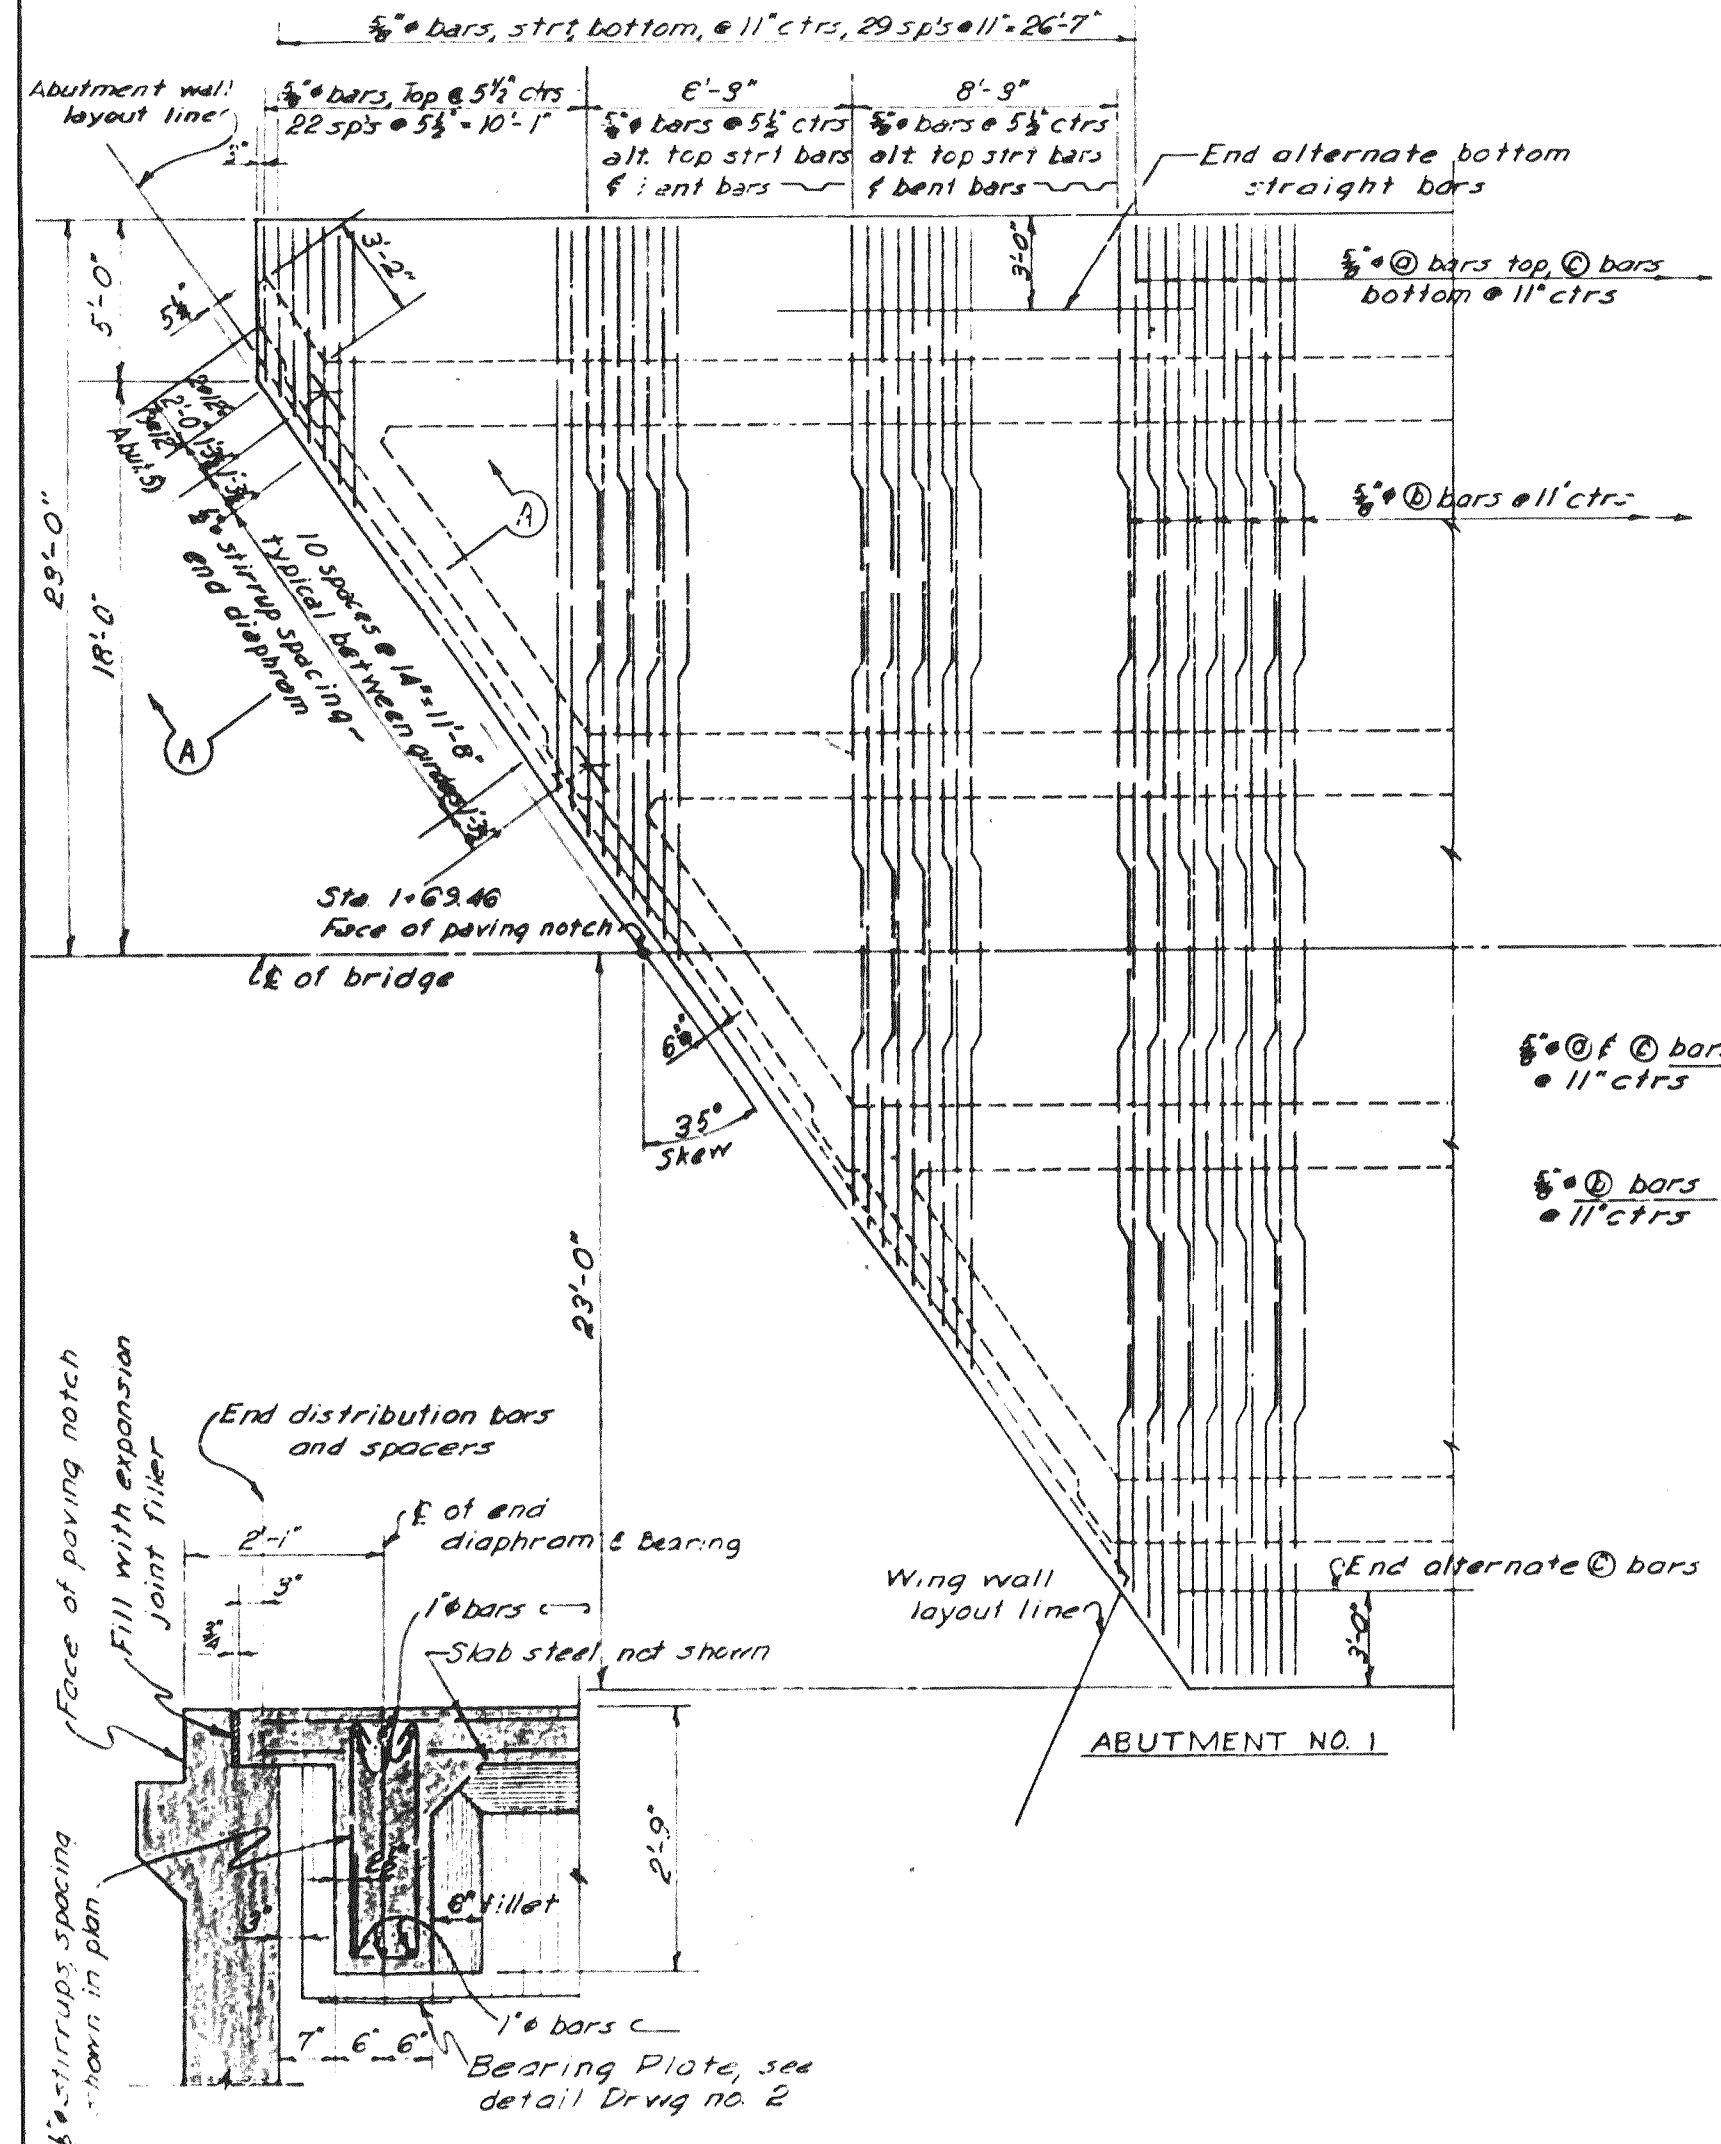

SECTION A-A
Scale: 1/4" = 1'-0"

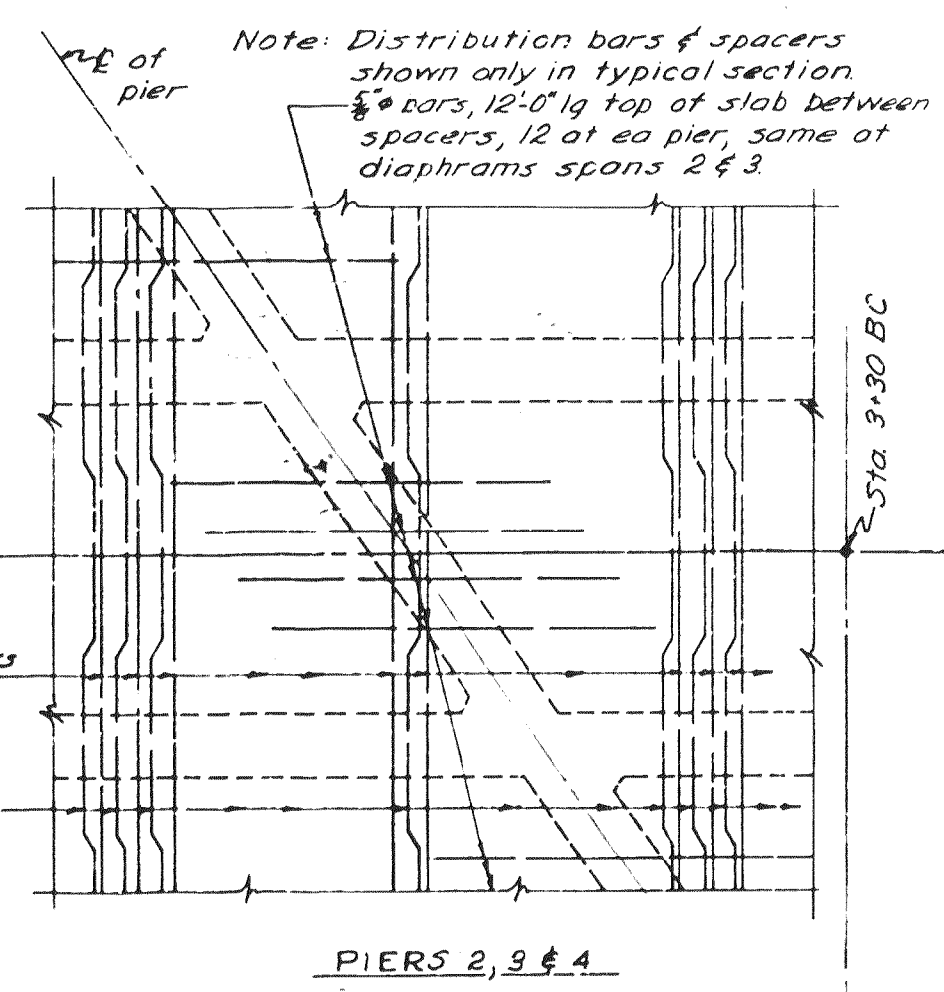

PART PLAN
Scale: 1/4" = 1'-0"

