
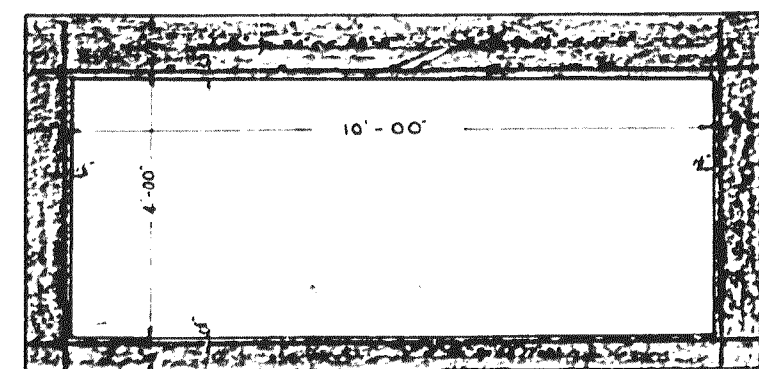
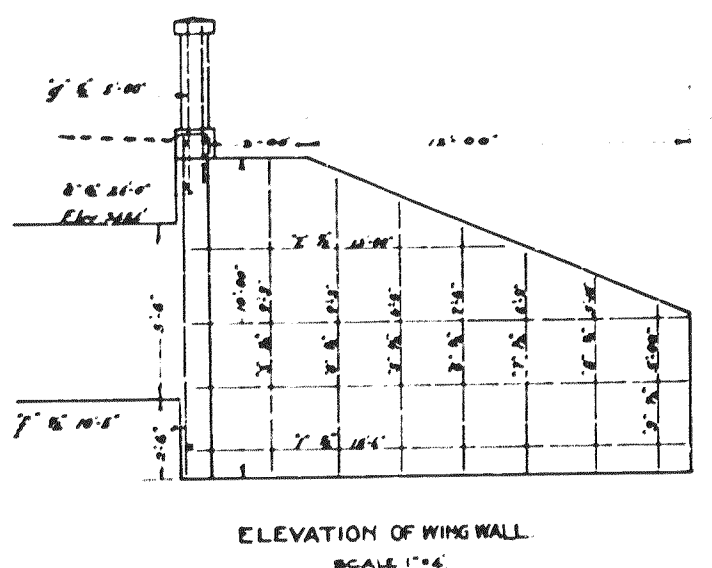
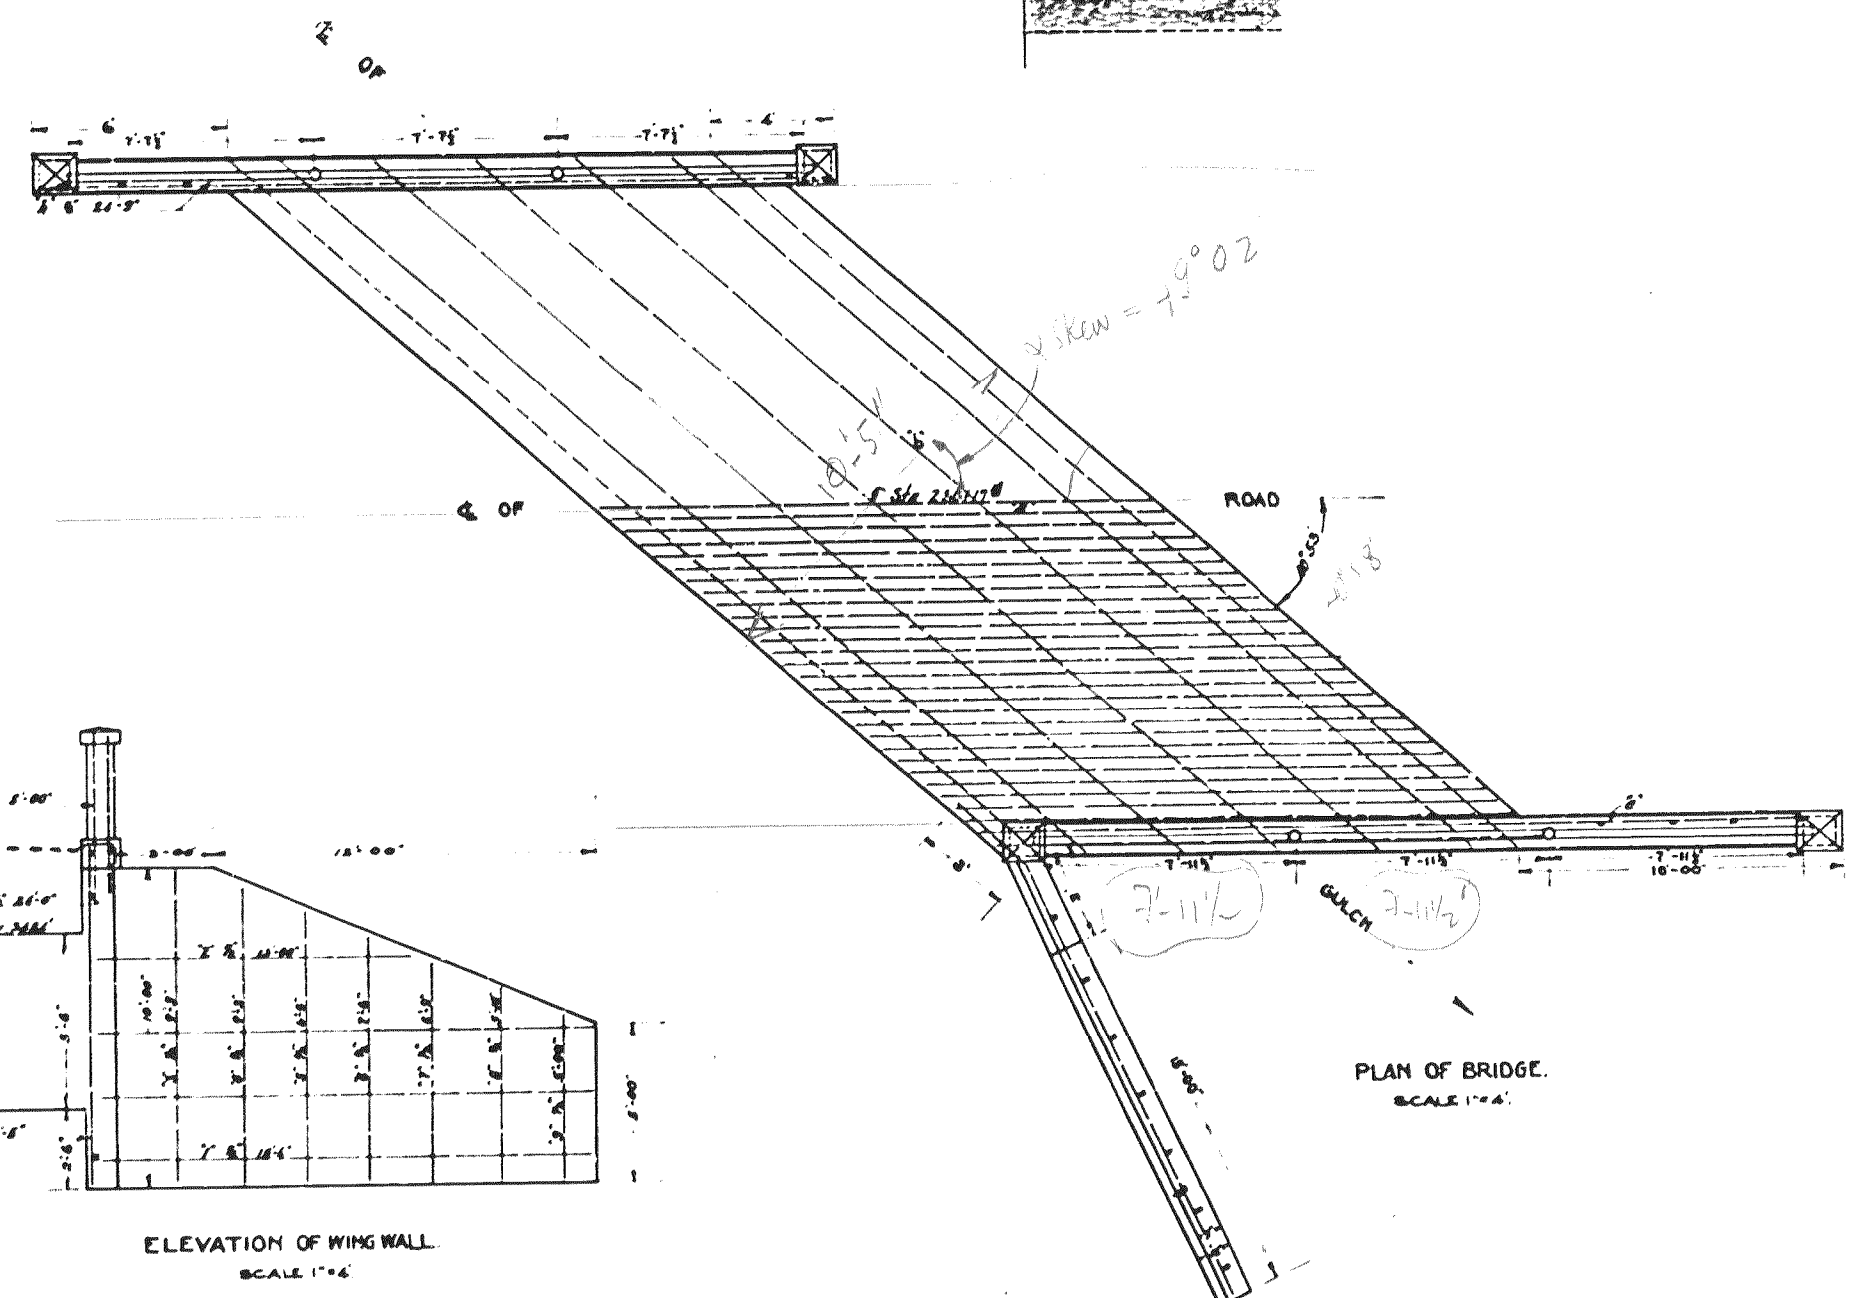


SANTIAGO BOULEVARD
CONCRETE BOX AT STA. 230+17.18
SCALE INDICATED JUNE 23, 1915.

Approved July 3, 1915
John F. Fisher
Chief Engineer

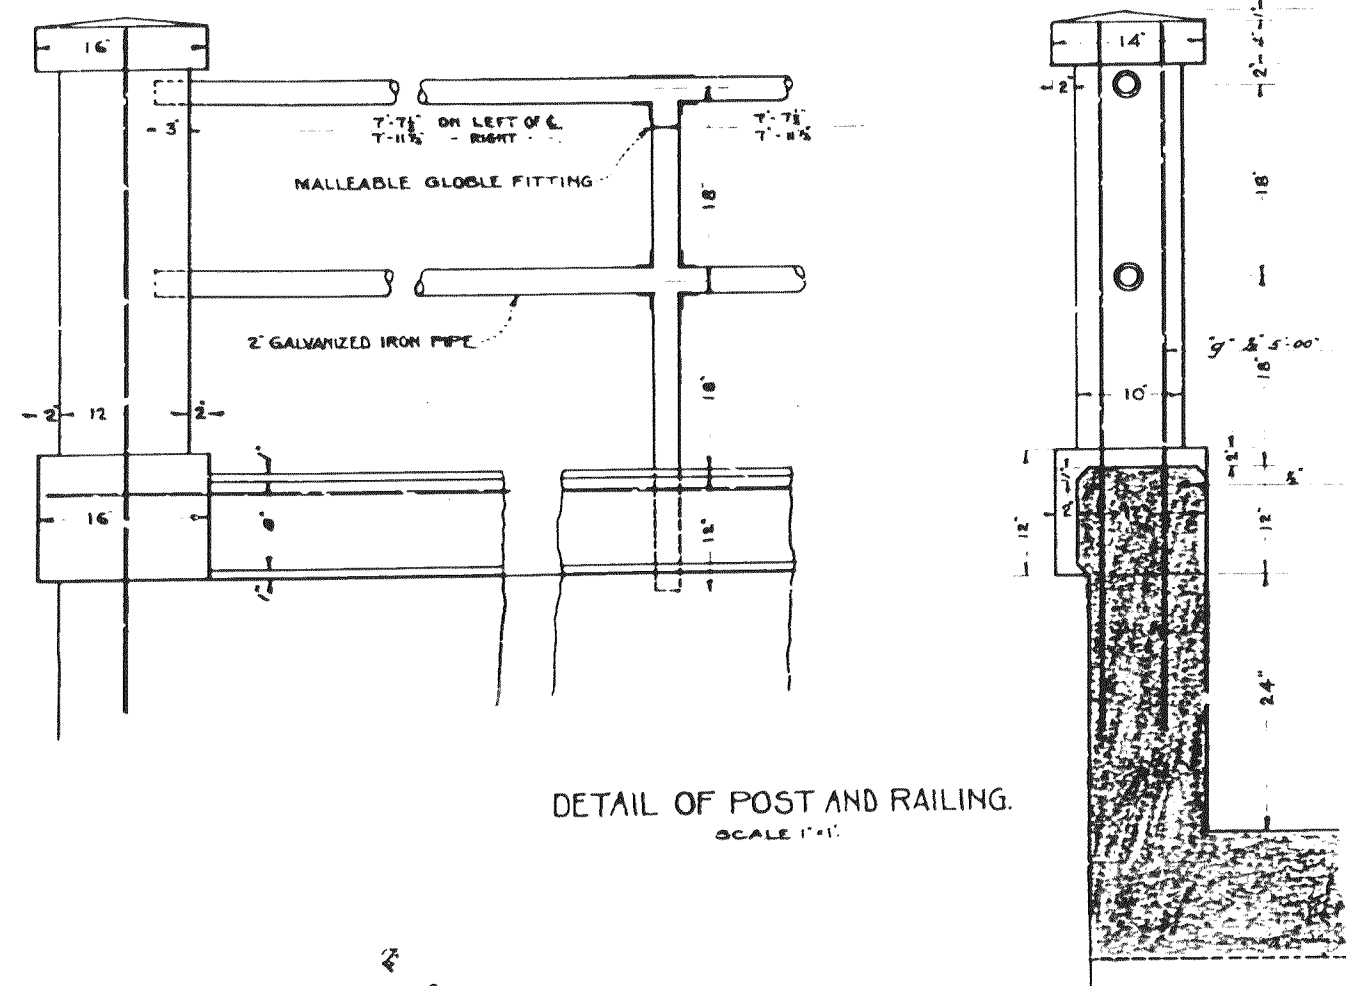

NAME	NO.	SIZE	LENGTH	LOCATION
A	50	3/8"	17'-5"	TOP SLAB TRANS.
B	14	1/2"	33'-6"	LONGITUDINAL
C	116	3/16"	5'-3"	SIDE WALLS VERTICAL
D	38	-	17'-3"	BOTTOM SLAB TRANS.
E	6	1/2"	24'-0"	END WALL HORIZ.
F	8	-	10'-5"	VERT.
G	8	-	5'-0"	POSTS
H	4	-	24'-9"	LEFT END WALL HORIZ.
I	3	-	18'-6"	WING WALL
J	9	-	65'-6"	-

ALL CONCRETE TO BE CLASS 'A'.
ALL STEEL BARS TO BE SQUARE TWISTED
REINFORCING STEEL 2643 POUNDS
CLASS 'A' CONCRETE 468 CU. YDS.
PIPE RAILING 47 1/2 LIN. FT.

Culvert S-185
Santiago Blvd
Concrete Box at Sta 230+17.18
Sheet 1 of 1
Red: 22, F: 11 Scale: As Shown
Linet

MICROFILMED
JUL 6 1960

#14617
S-185
SANTIA GO BLVD
1915