
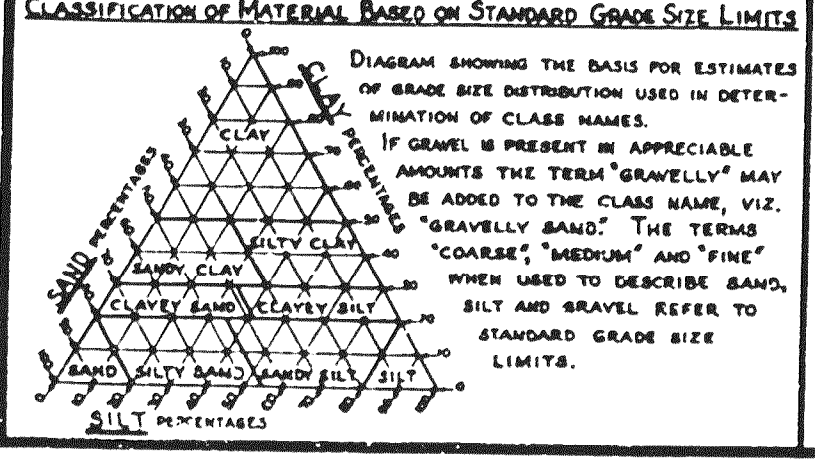



BRIDGE DEPARTMENT

FIELD STUDY	DATE	BY
DRAWN		
CHECKED		
APPROVED		

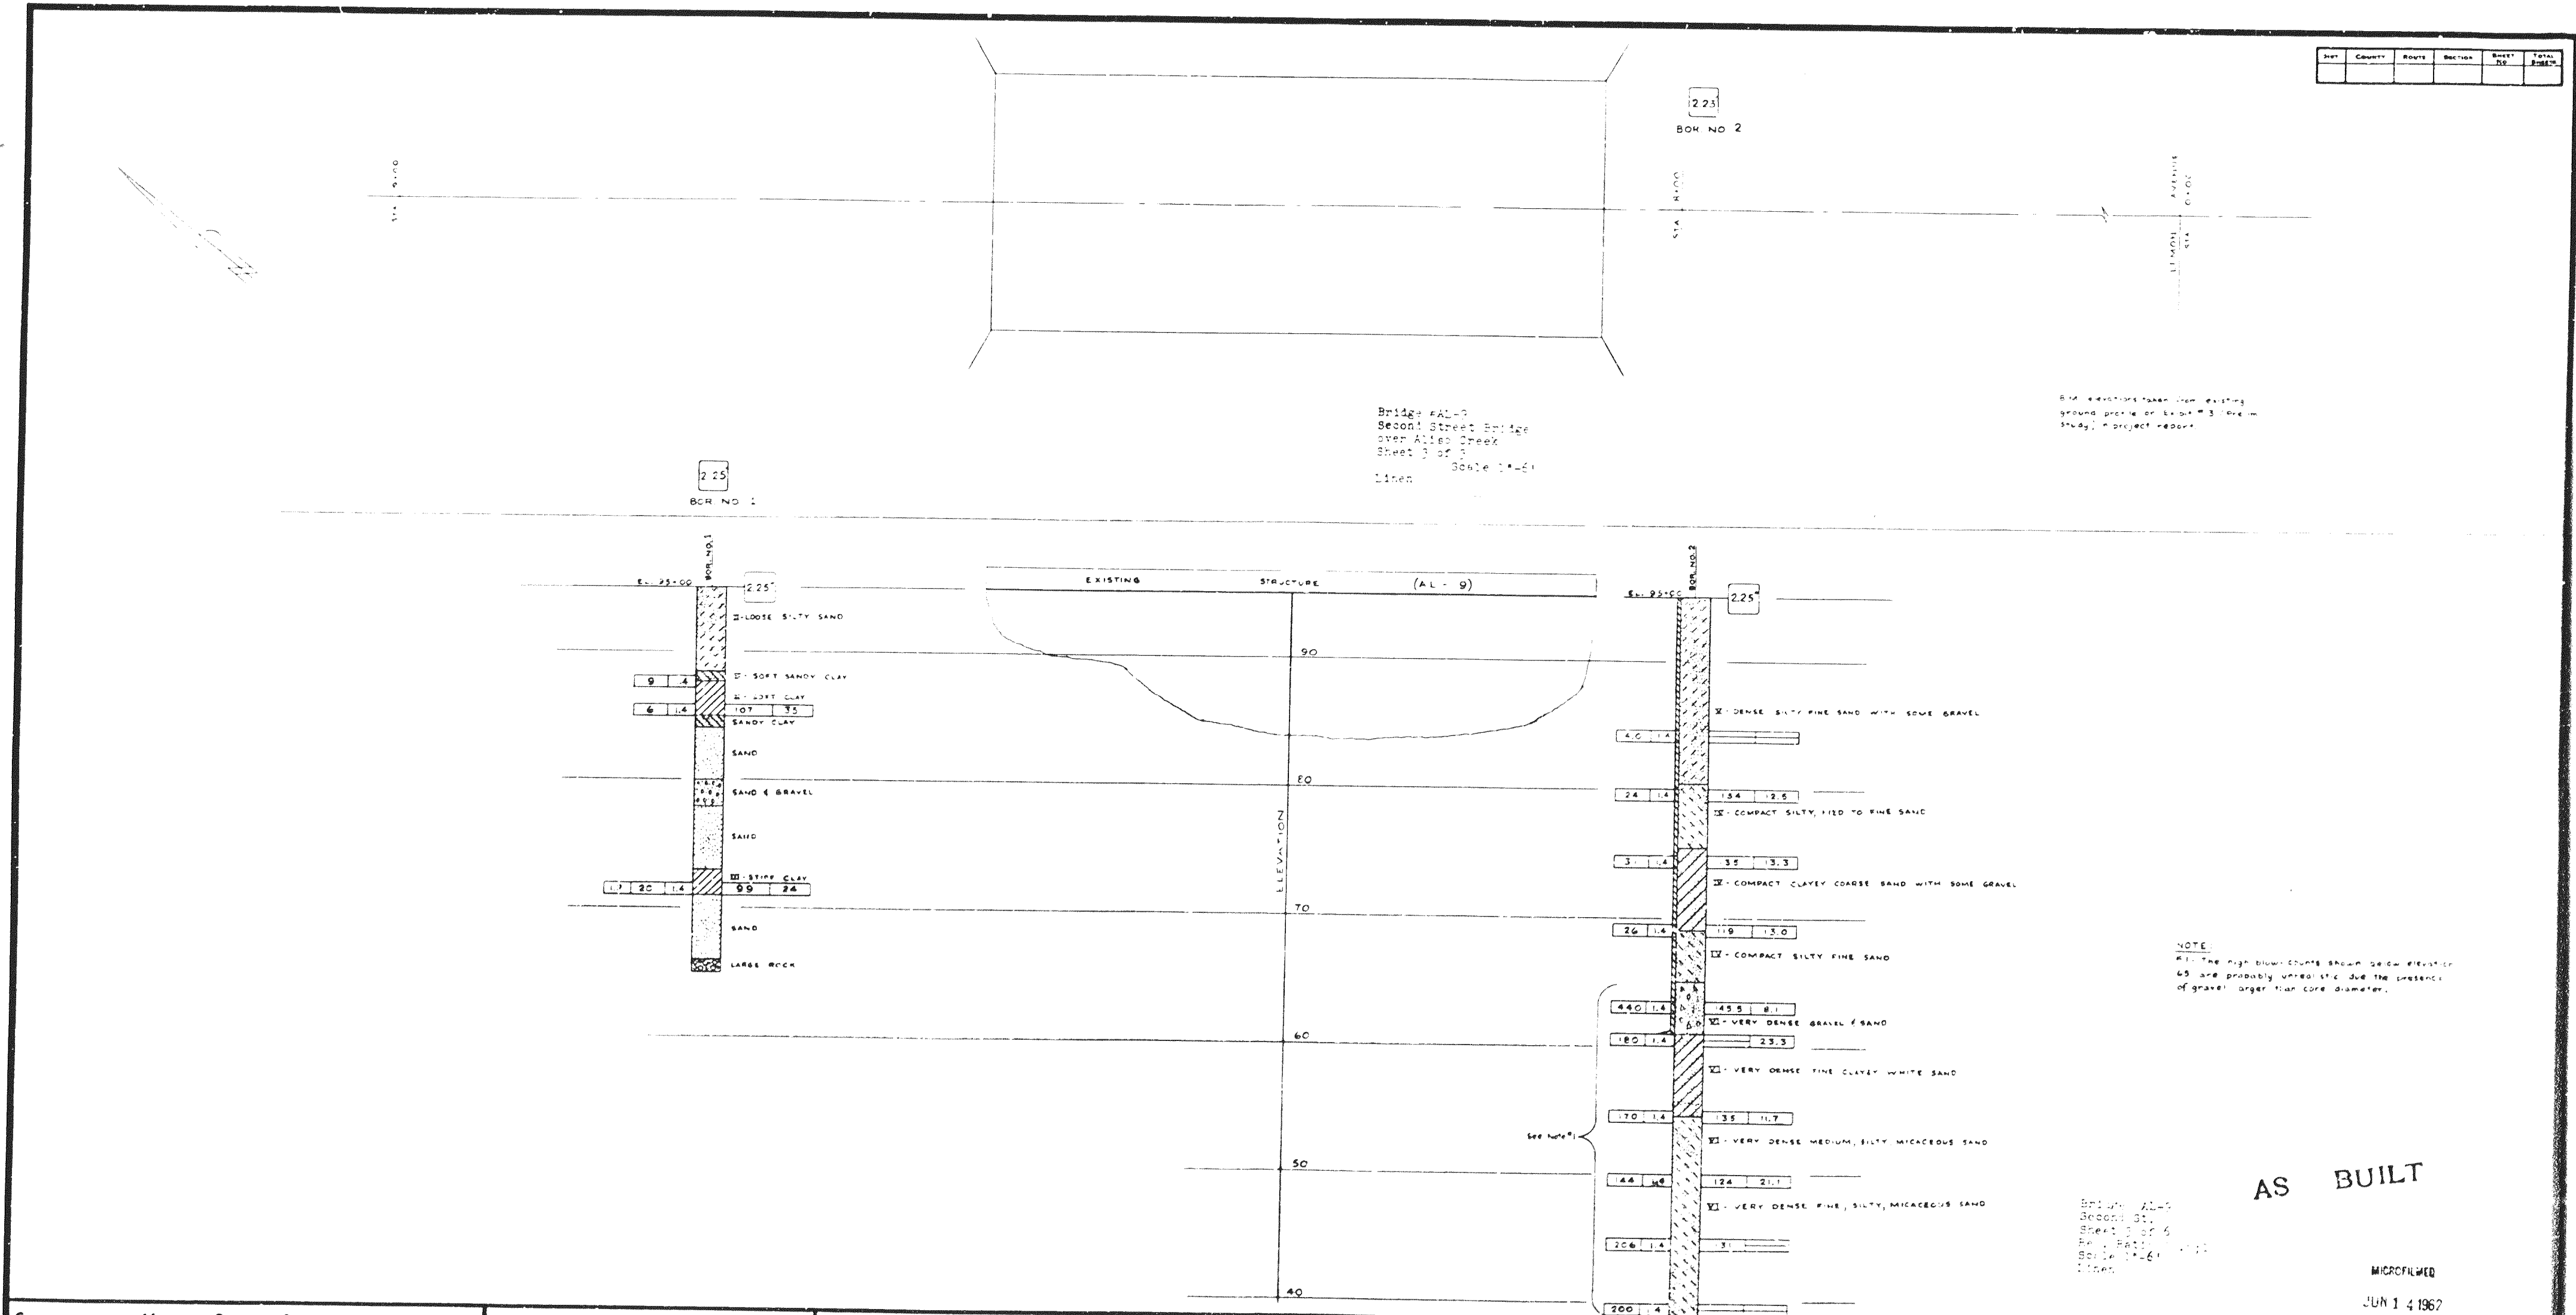

LEGEND OF EARTH MATERIALS

GRAVEL	SILTY CLAY OR CLAYEY SILT
SAND	PEAT AND/OR ORGANIC MATTER
SILT	FILL MATERIAL
CLAY	IGNEOUS ROCK
SANDY CLAY OR CLAYEY SAND	SEDIMENTARY ROCK
SANDY SILT OR SILTY SAND	METAMORPHIC ROCK

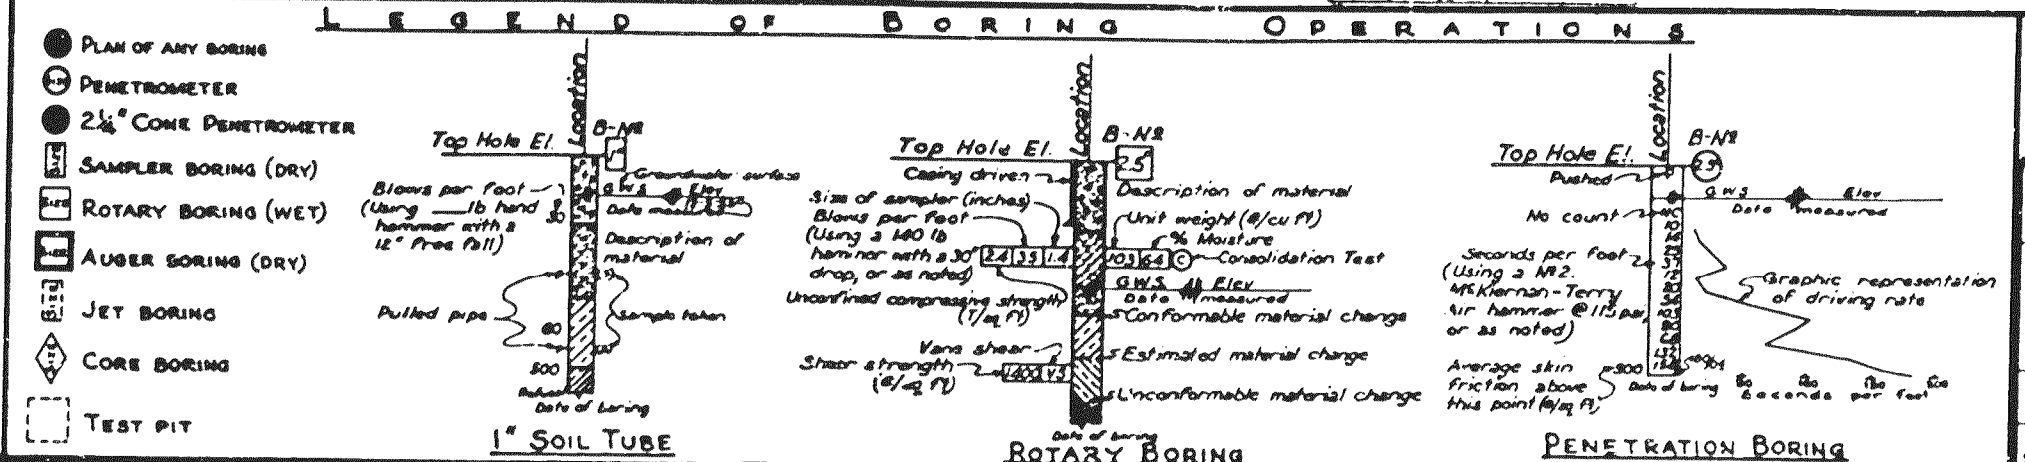

NOTES

The contractor's attention is directed to Section 2, Article (c) of the Standard Specifications and to the Special Provisions accompanying this set of plans.

Classification of earth material as shown on this sheet is based upon field inspection and is not to be construed to imply mechanical analysis.

(AL-9)

2ND ST BRIDGE
OVER ALISO CREEK

LOG OF TEST BORINGS

SCALE: 1"=40'

BRIDGE

FILE

DRAWING

2nd Street Bridge

AL-9 Sheet 3 of 3