


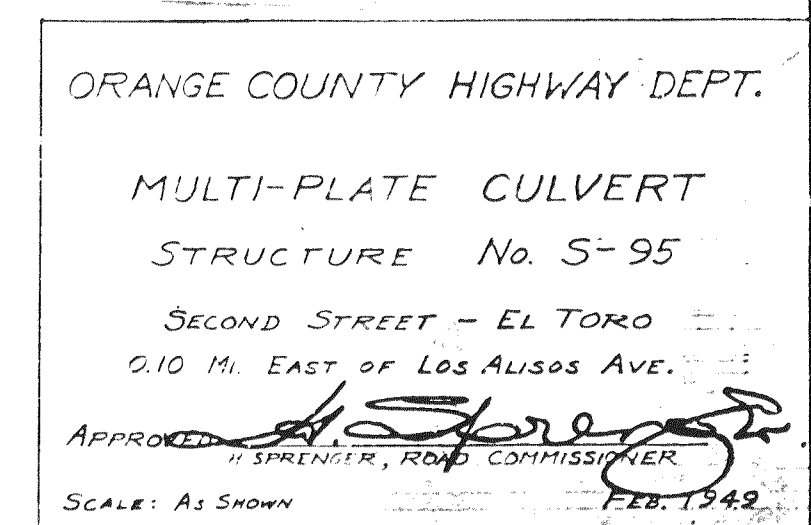

Thomas 891-J5