


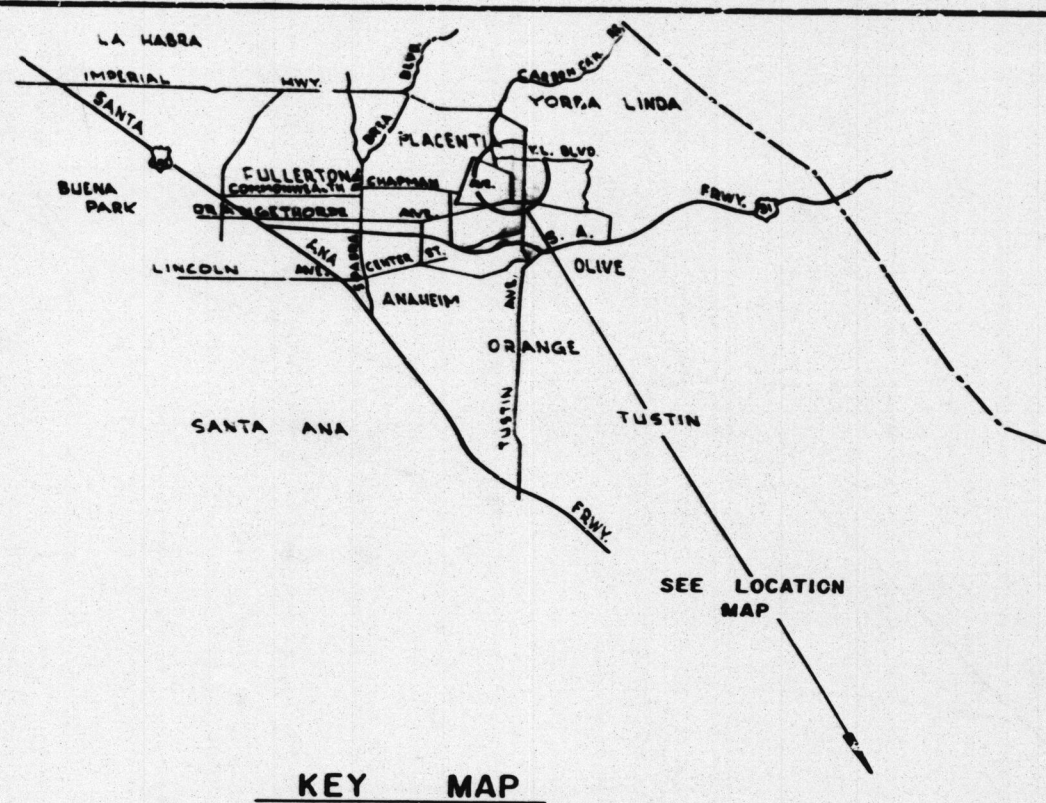


ORANGE COUNTY HIGHWAY DEPARTMENT STATE OF CALIFORNIA

PLAN AND PROFILE RECONSTRUCTION OF SEVEN BRIDGES IN YORBA LINDA AREA OVER ANAHEIM UNION WATER COMPANY CANAL

INDEX OF SHEETS

SHEET	NO	TITLE	SHEET
"	1	SITE PLANS	"
"	2	SITE PLANS	"
"	3	SITE PLANS	"
"	4	DETAIL SHEET	"

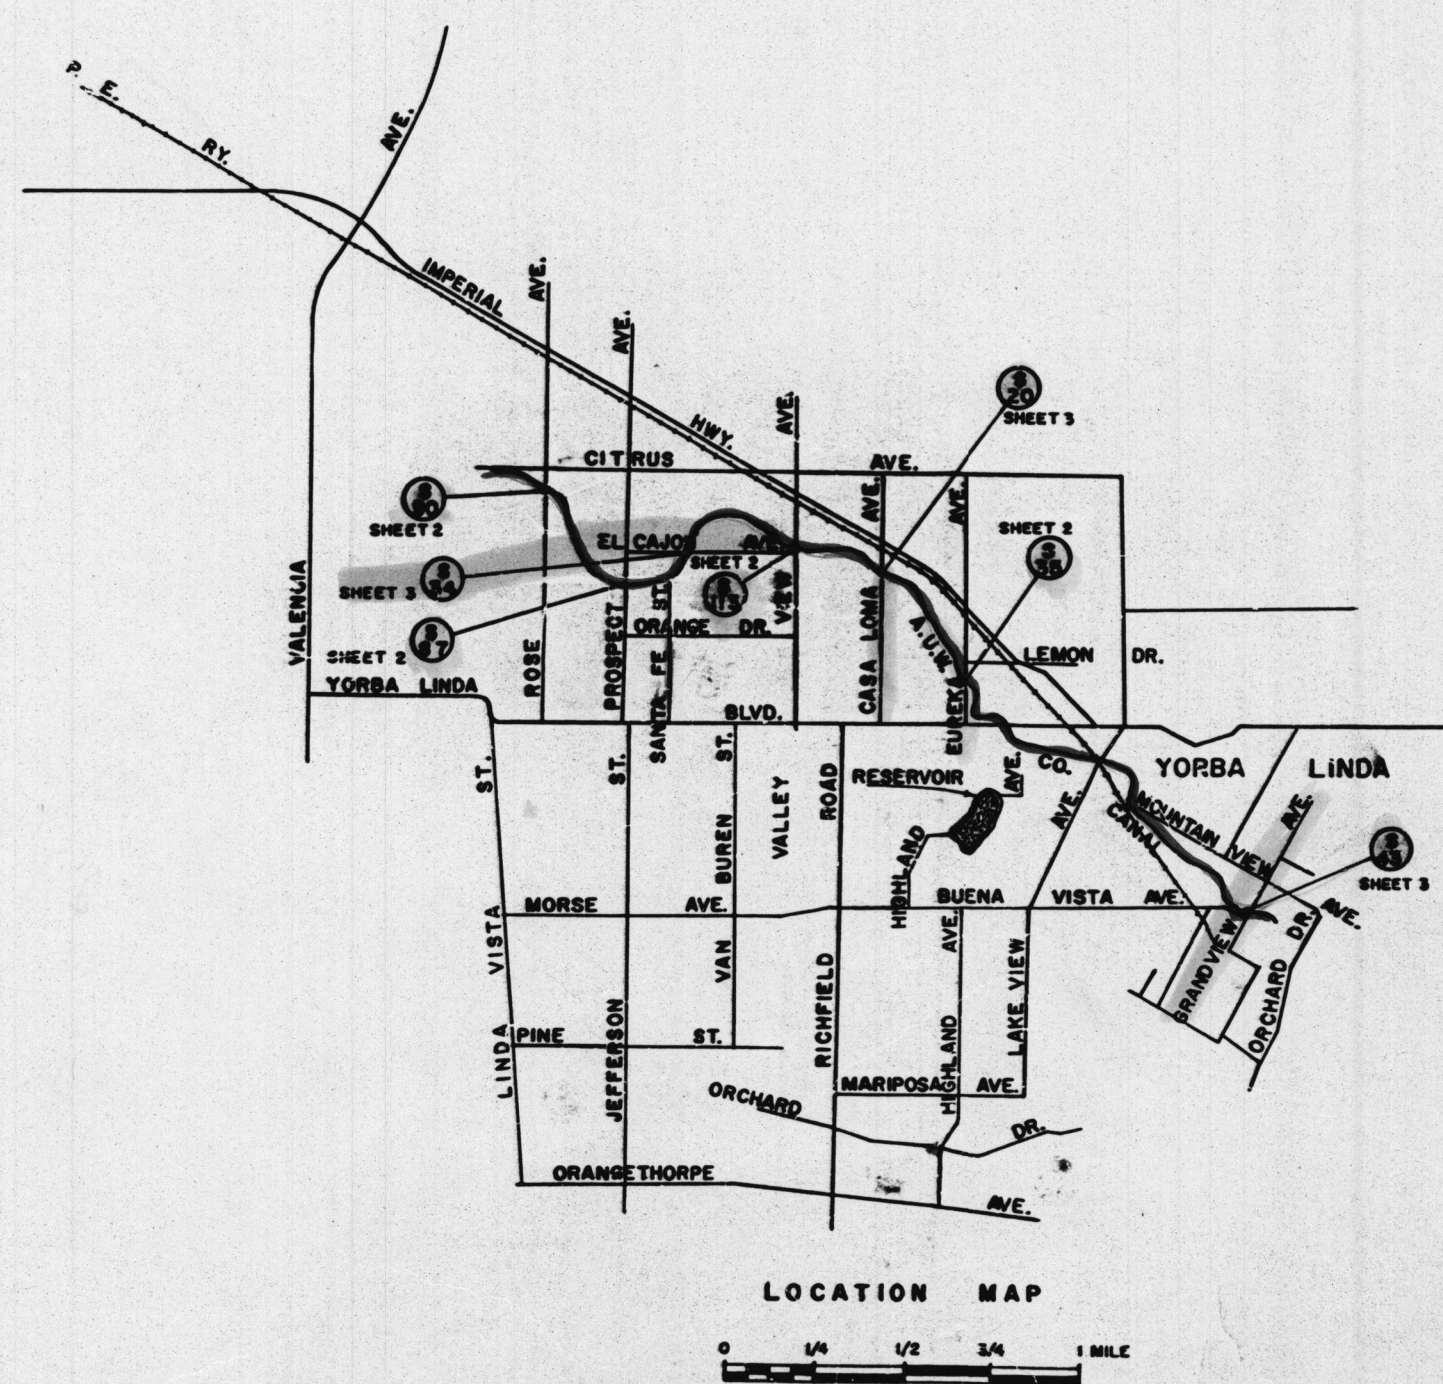

COUNTY OF ORANGE
Allen S. Loh
ROAD COMMISSIONER ORANGE COUNTY
CIVIL ENGINEER LICENSE NO. 7872
11-17-61
DATE

W. G. Gustafson
ANAHEIM UNION WATER COMPANY
11-17-61
DATE

AS BUILT

W. G. GUSTAFSON
RESIDENT ENG. NOV. 1961

Bridge 8-20, 8-34, 8-35,
8-43, 8-87, 8-90, 8-113
Seven Bridges in Yorba Linda
Area
Sheet 1 of 4
Red. Ratio 22.5:1
Scale - Graphical
Autopositive

MICROFILMED
JUN 14 1963

S 20 - S 34 - S 35 - S 43 - S 87 - S 90 - S 113 - Seven Bridges in Yorba Linda Area

Thomas: S-20 → 740-A3 S-87 → 739-J3
S-34 → 739-J3 S-90 → 739-H3
S-35 → 740-B4 S-113 → 740-A3
S-H3 → 740-D5

#14550 1961
SEVEN BRIDGES IN YORBA LINDA AREA OVER Anaheim Union Water Co. Canal (A.U.W. CO. CANAL)

FILED @ CASA LOMA AVE.