
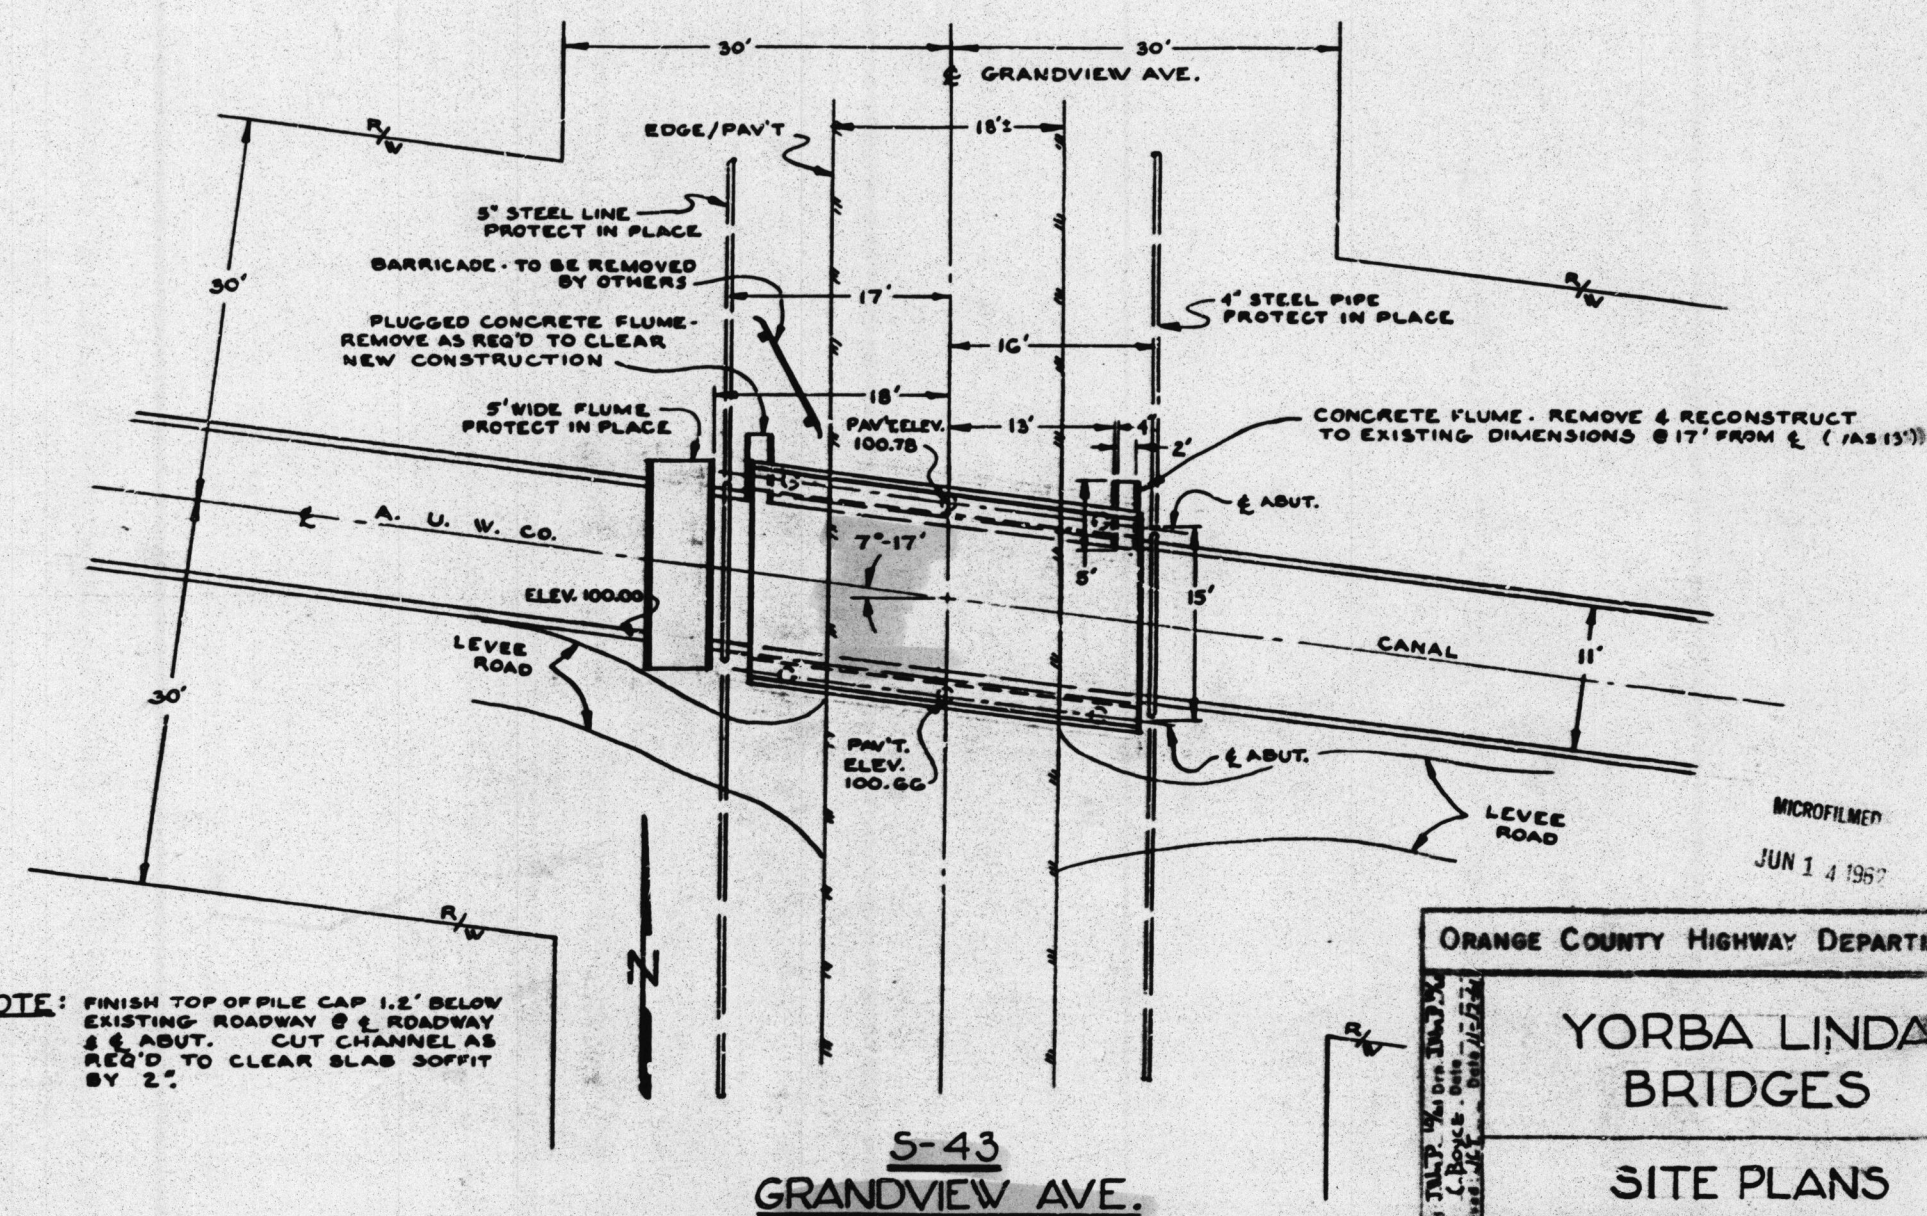
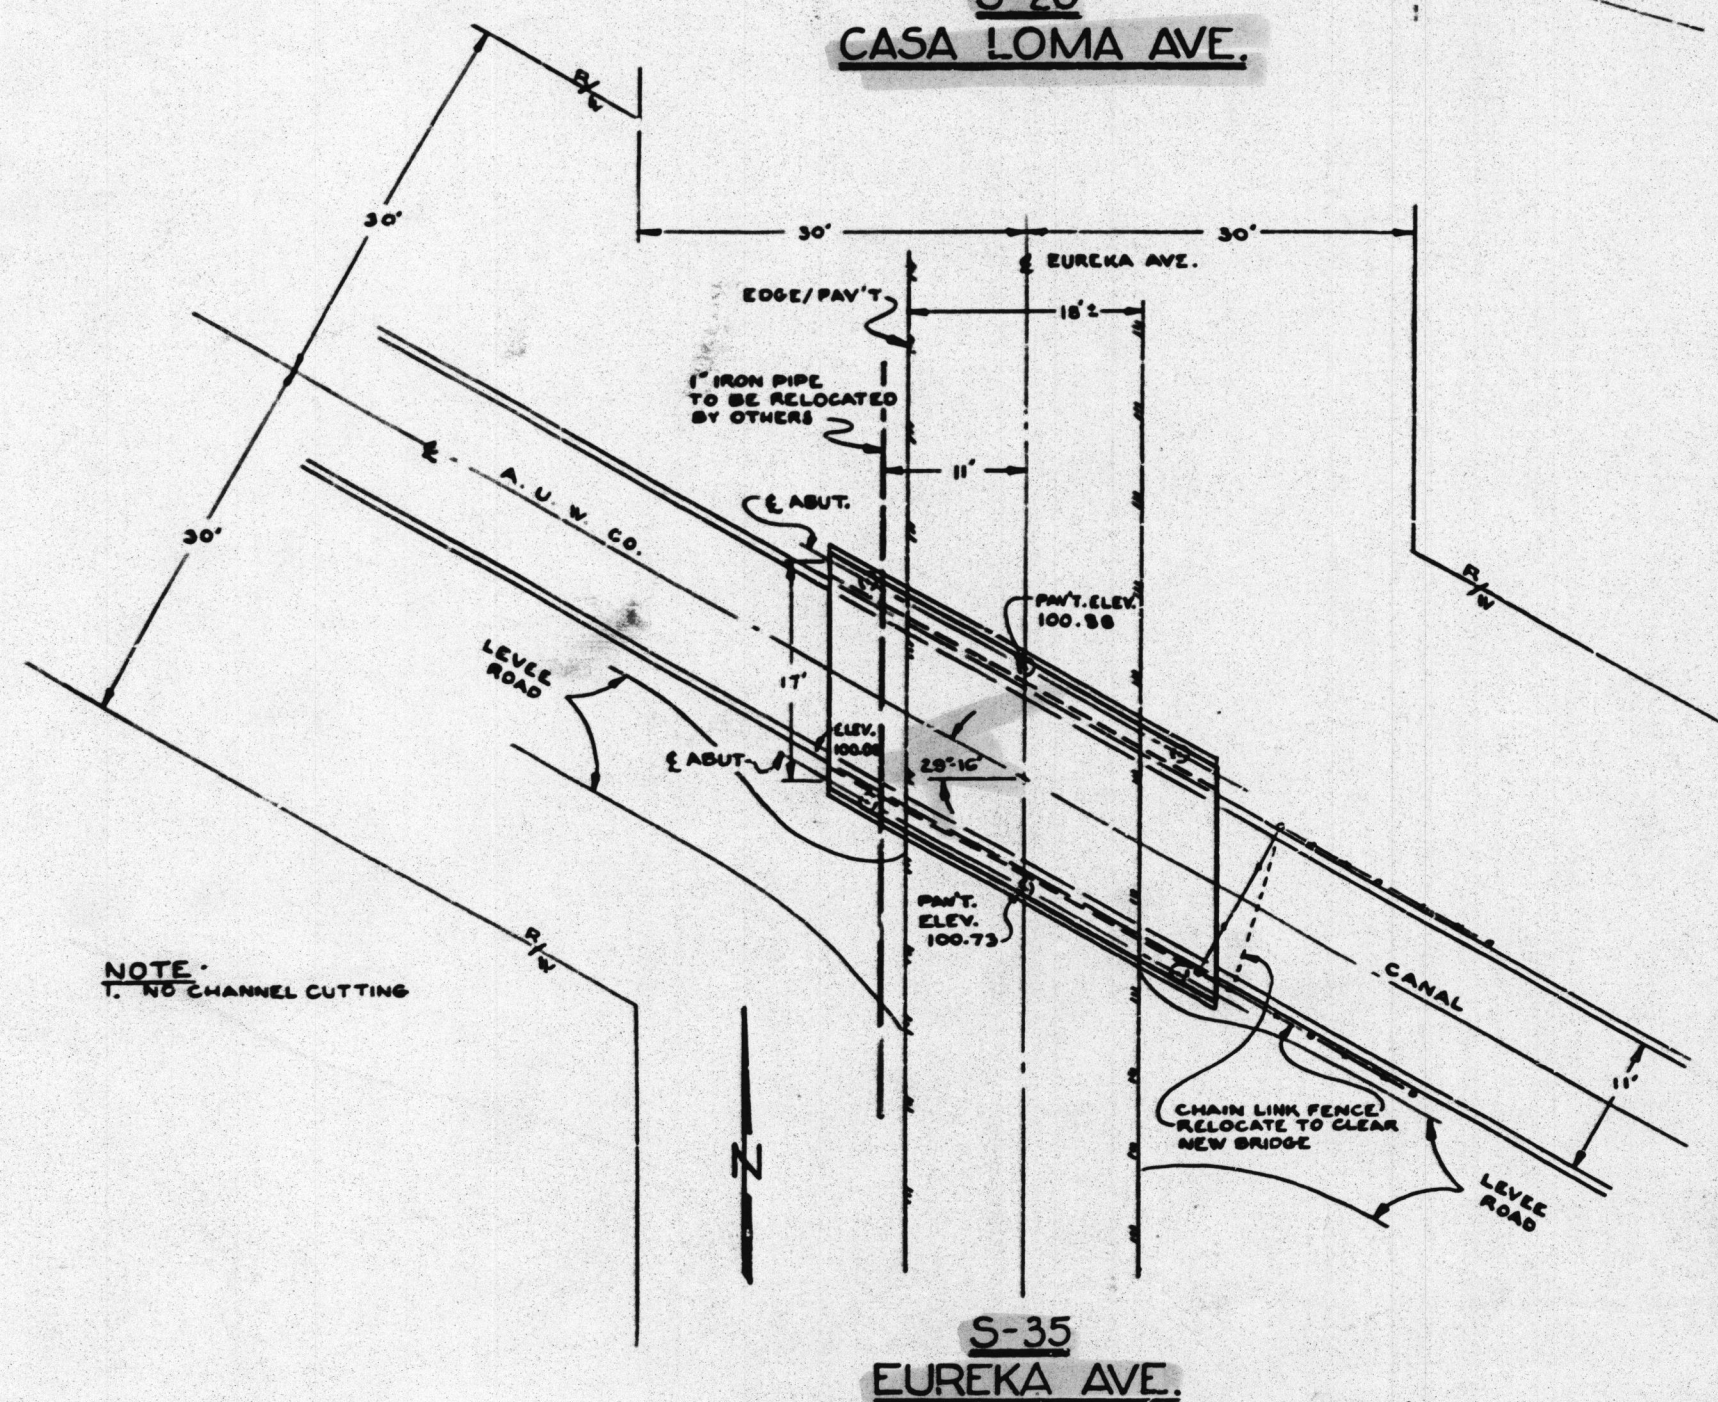
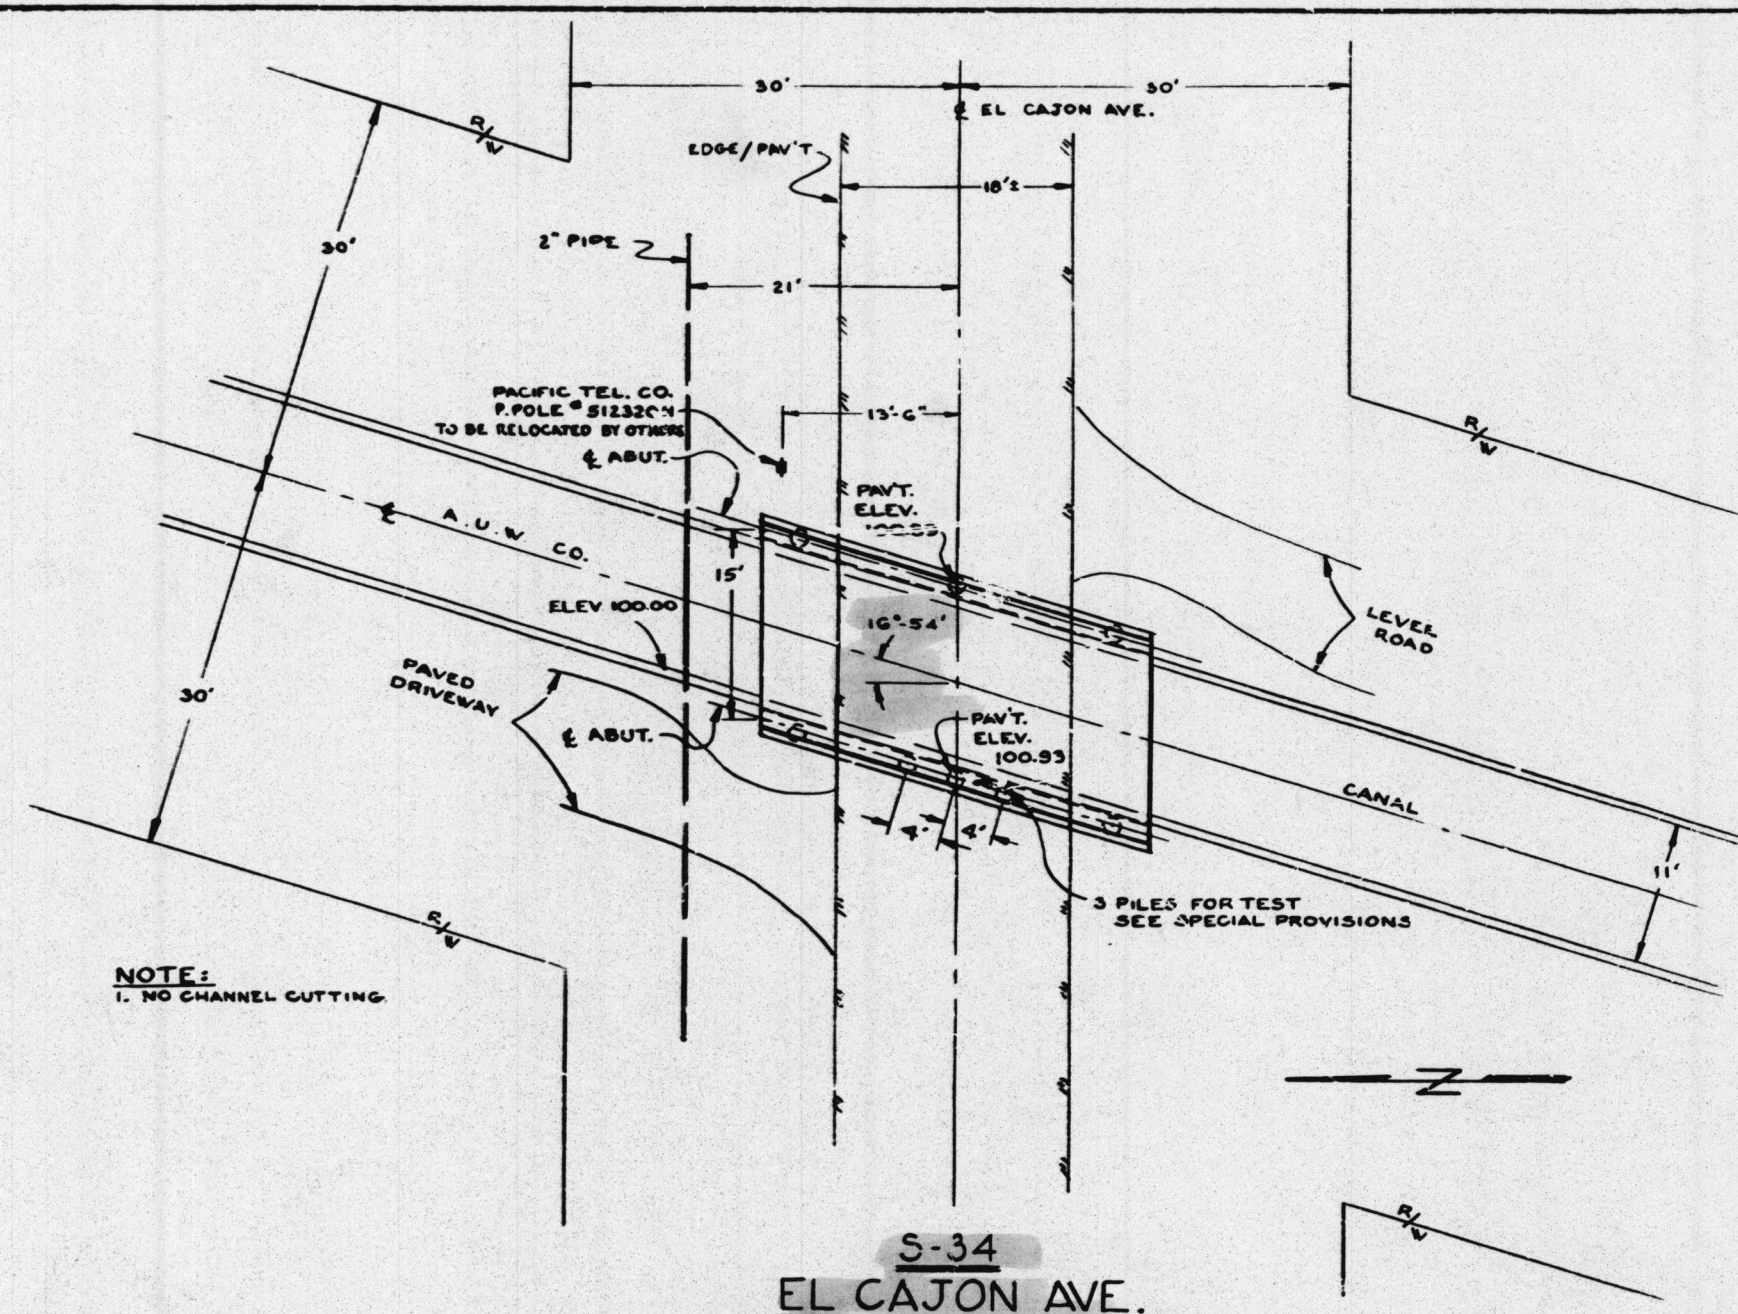


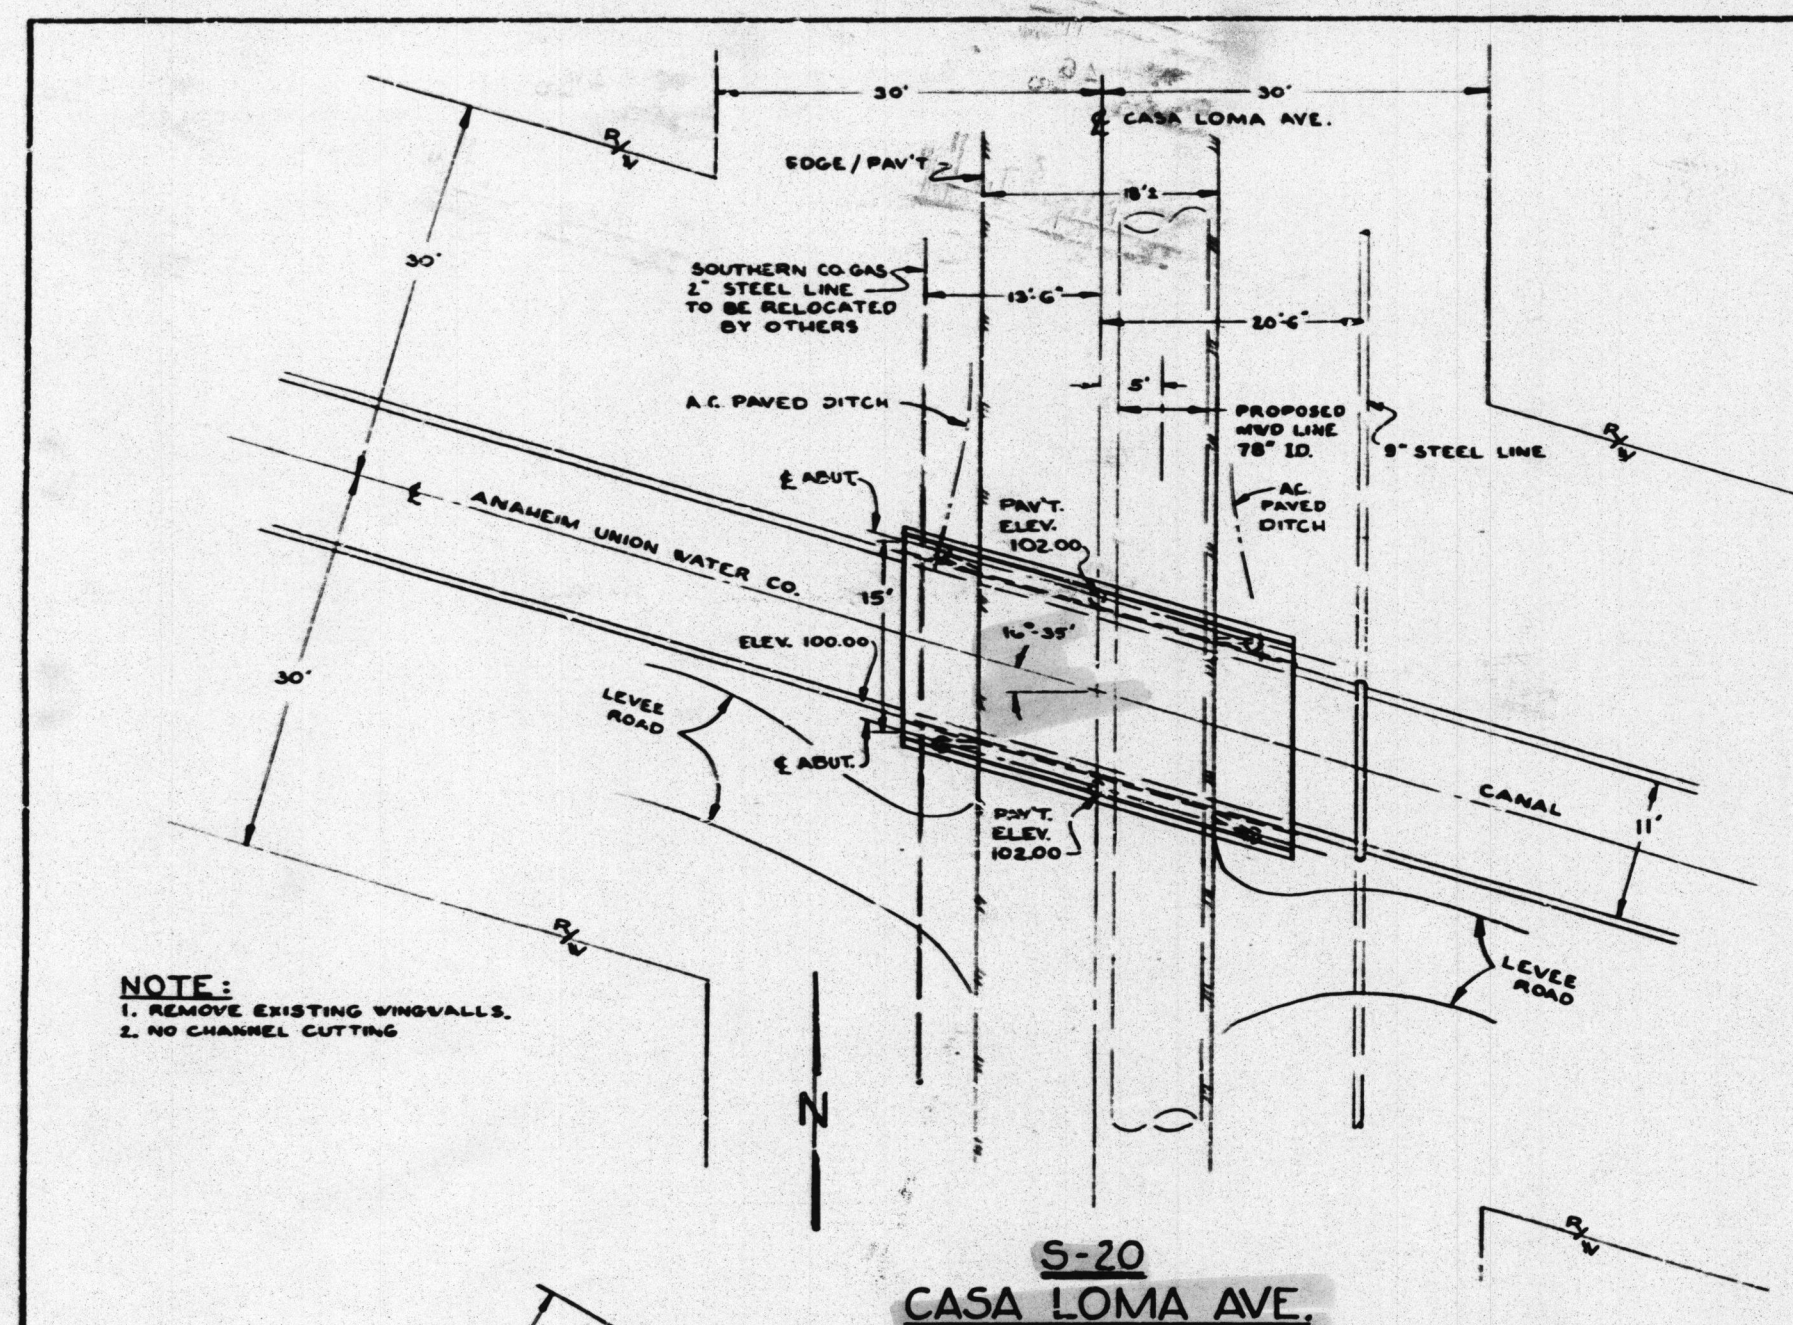

SEE NOTES SHEET 3

AS BUILT

Bridge S-20, S-34, S-35,
S-43, S-E7, S-90, S-113
Seven Bridges in Yorba Linda
Sheet 2 of 4 Area a
Red. Ratio 22.5:1
Scale 1"=10'
Pencil Sketch

1. NOTE: FINISH TOP OF PILE CAP 1.2' BELOW
EXISTING ROADWAY @ ROADWAY
& ABUT. CUT CHANNEL AS
REQ'D TO CLEAR SLAB SOFFIT
BY 2".

ORANGE COUNTY HIGHWAY DEPARTMENT

YORBA LINDA
BRIDGES

SITE PLANS

SCALE 1" = 10'

SHEET 23

Sheet 2 of 4

#14550 1961