


8 9 10-

11 12 13 14 15 16 17 18 19 20 21 22 23 24 25 26 27 28 29 30 31 32 33 34 35 36 37 38 39 40 41 42 43 44 45 46 47 48 49 50 51 52

53 54 55

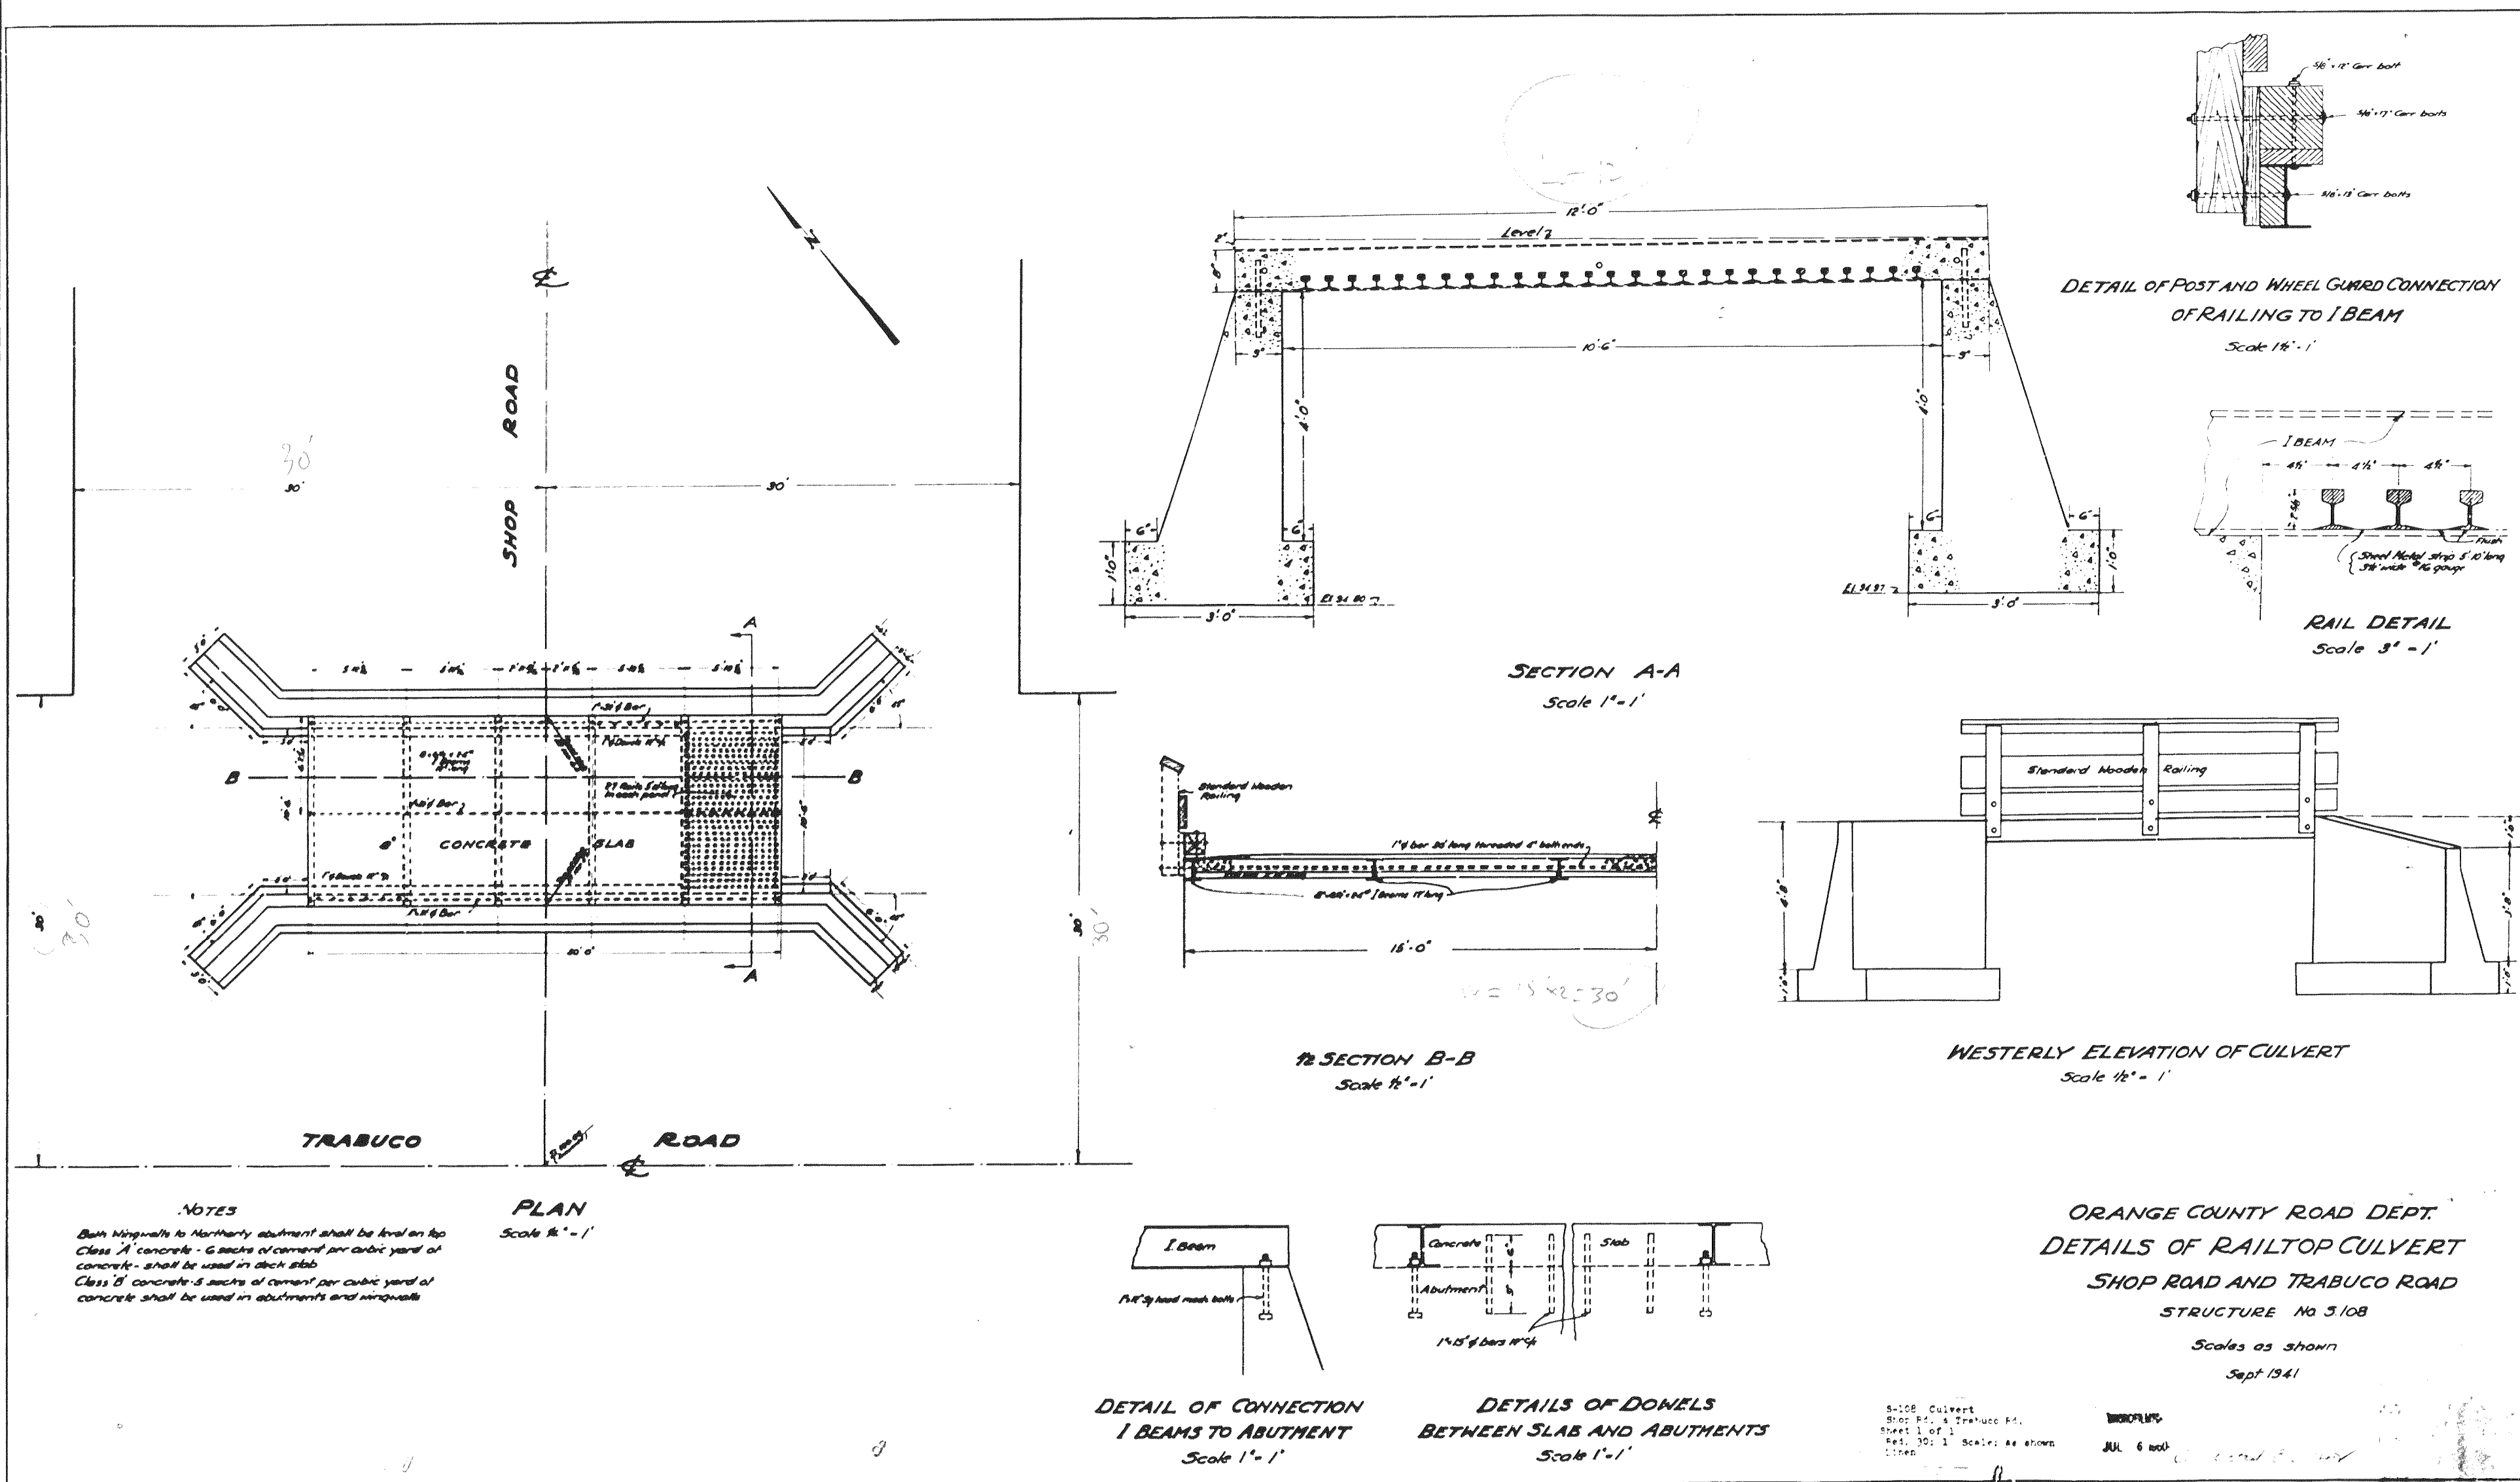

#14588
S-108

1941

SHOP RD & TRABUCO RD
Thruway : 860-H1