


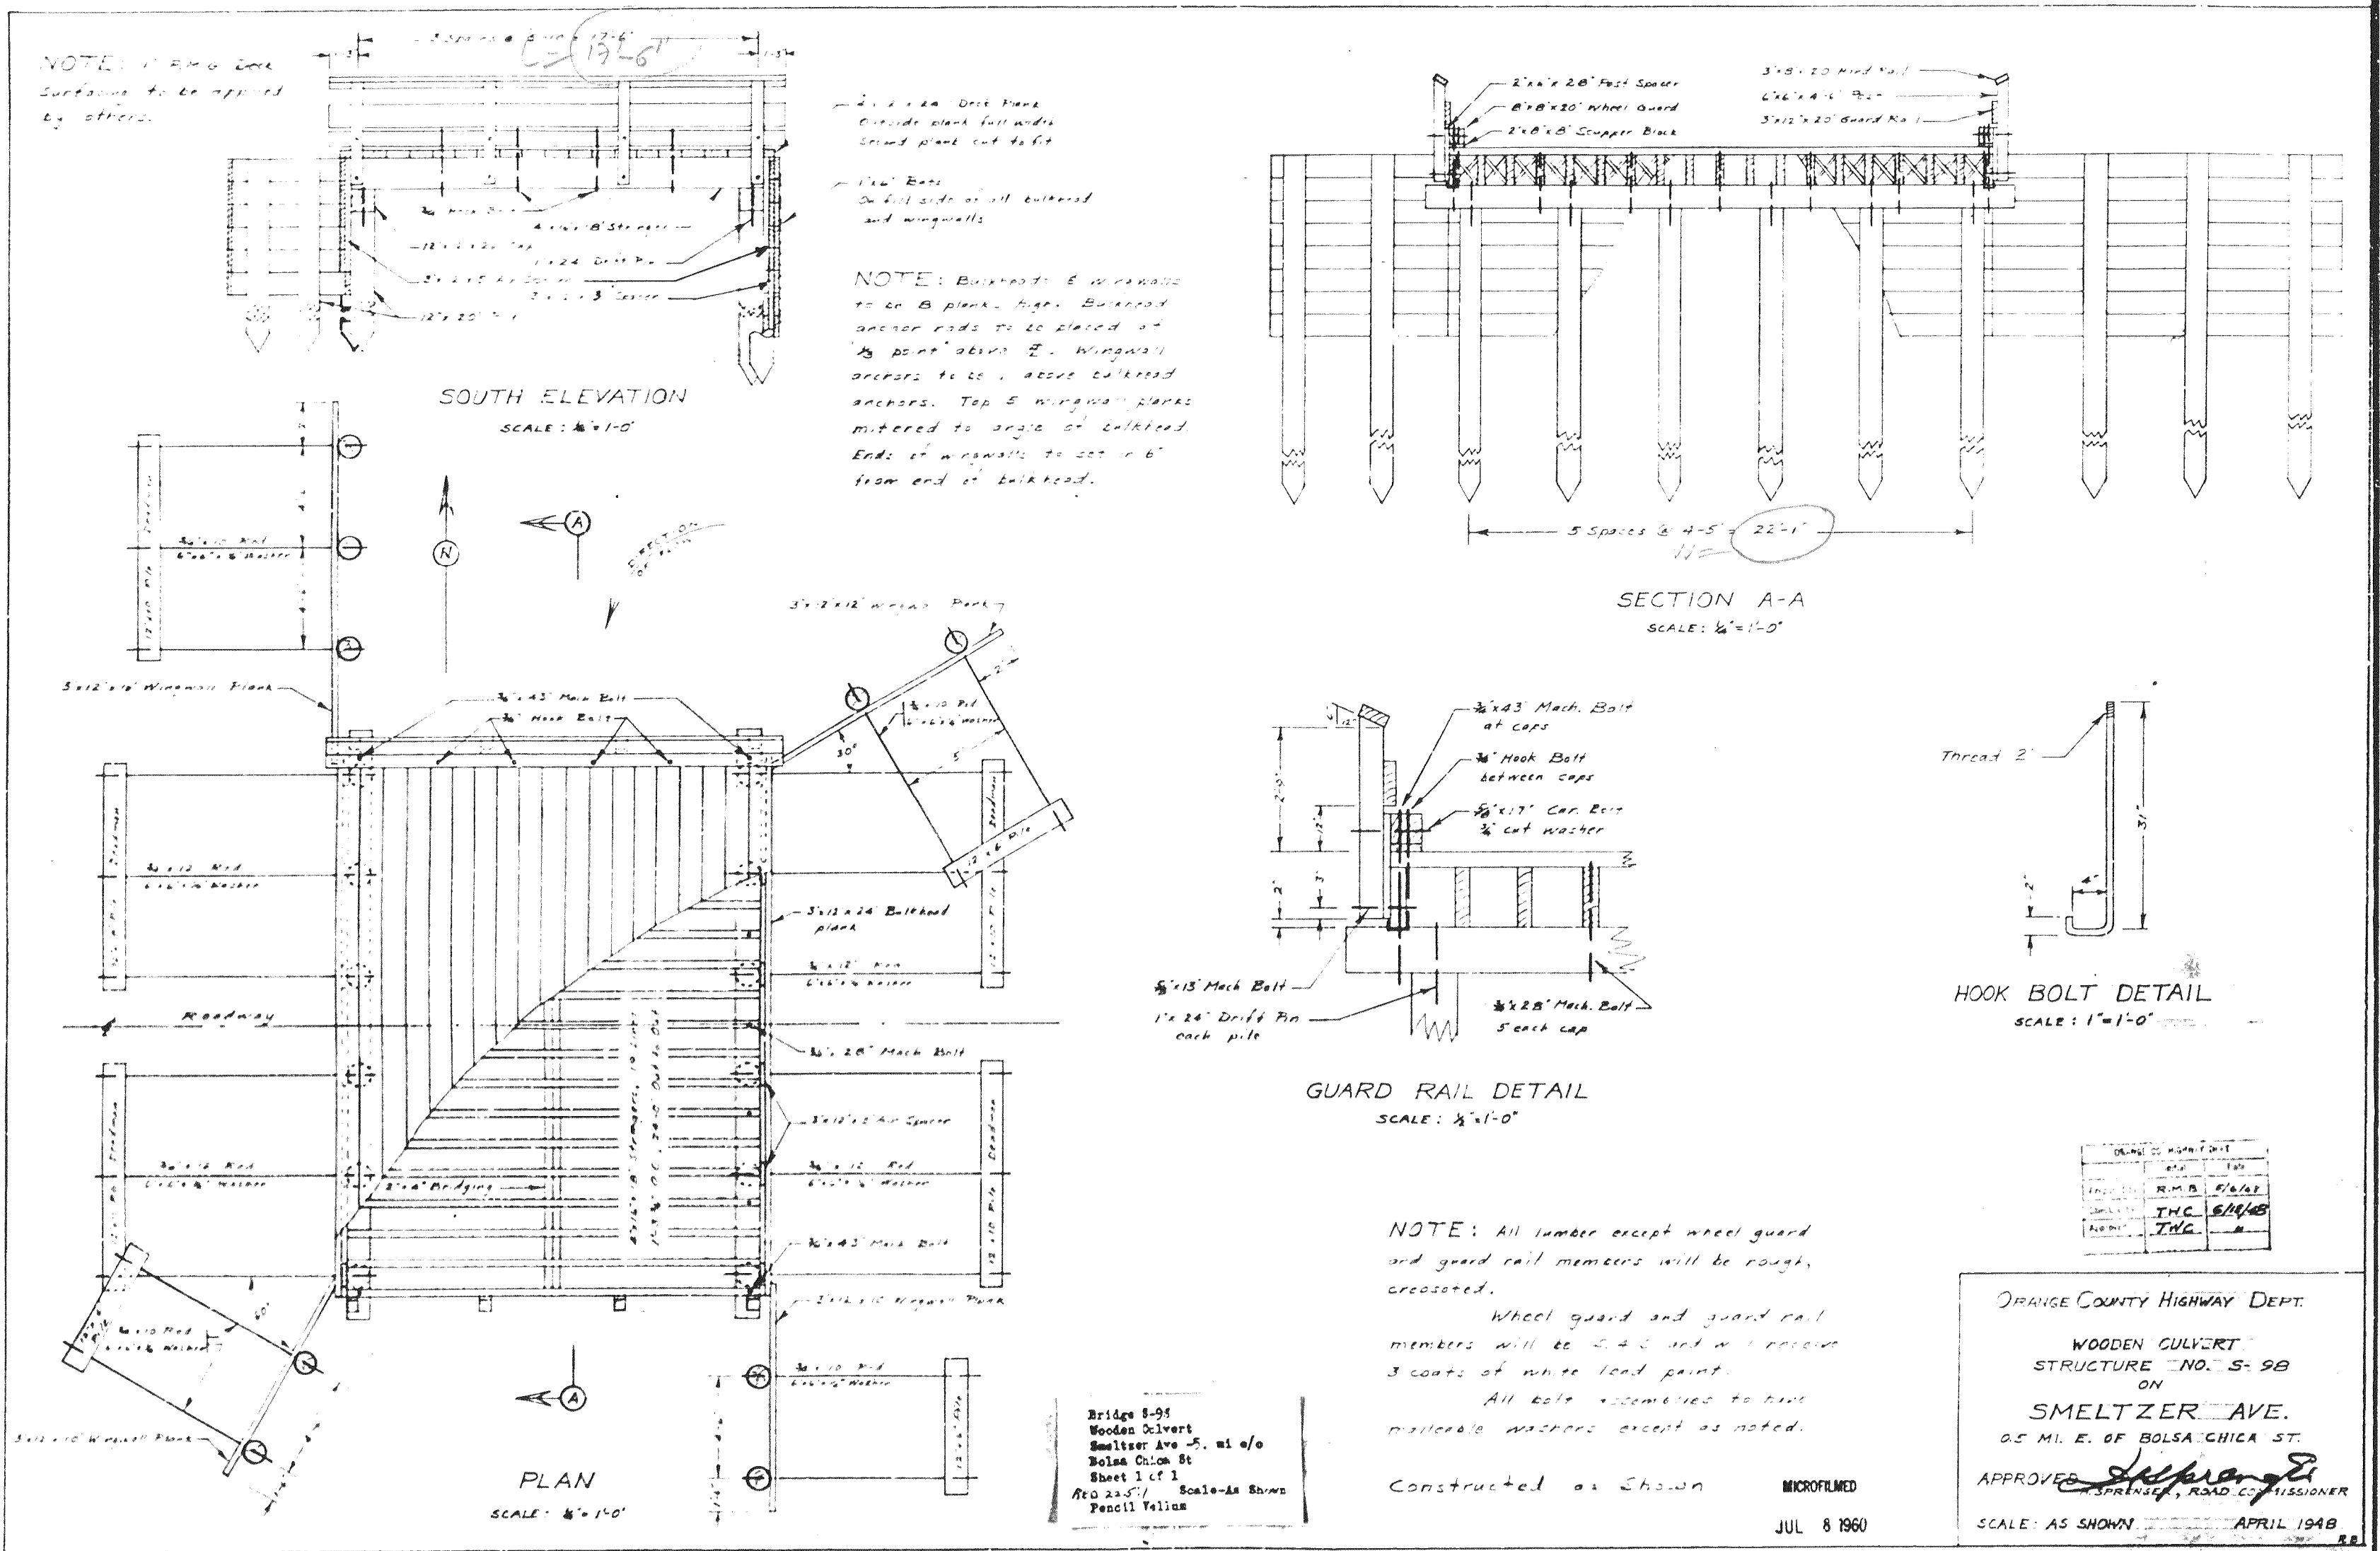

#14583
 S-98
 1948

SMELTZER AVE.