


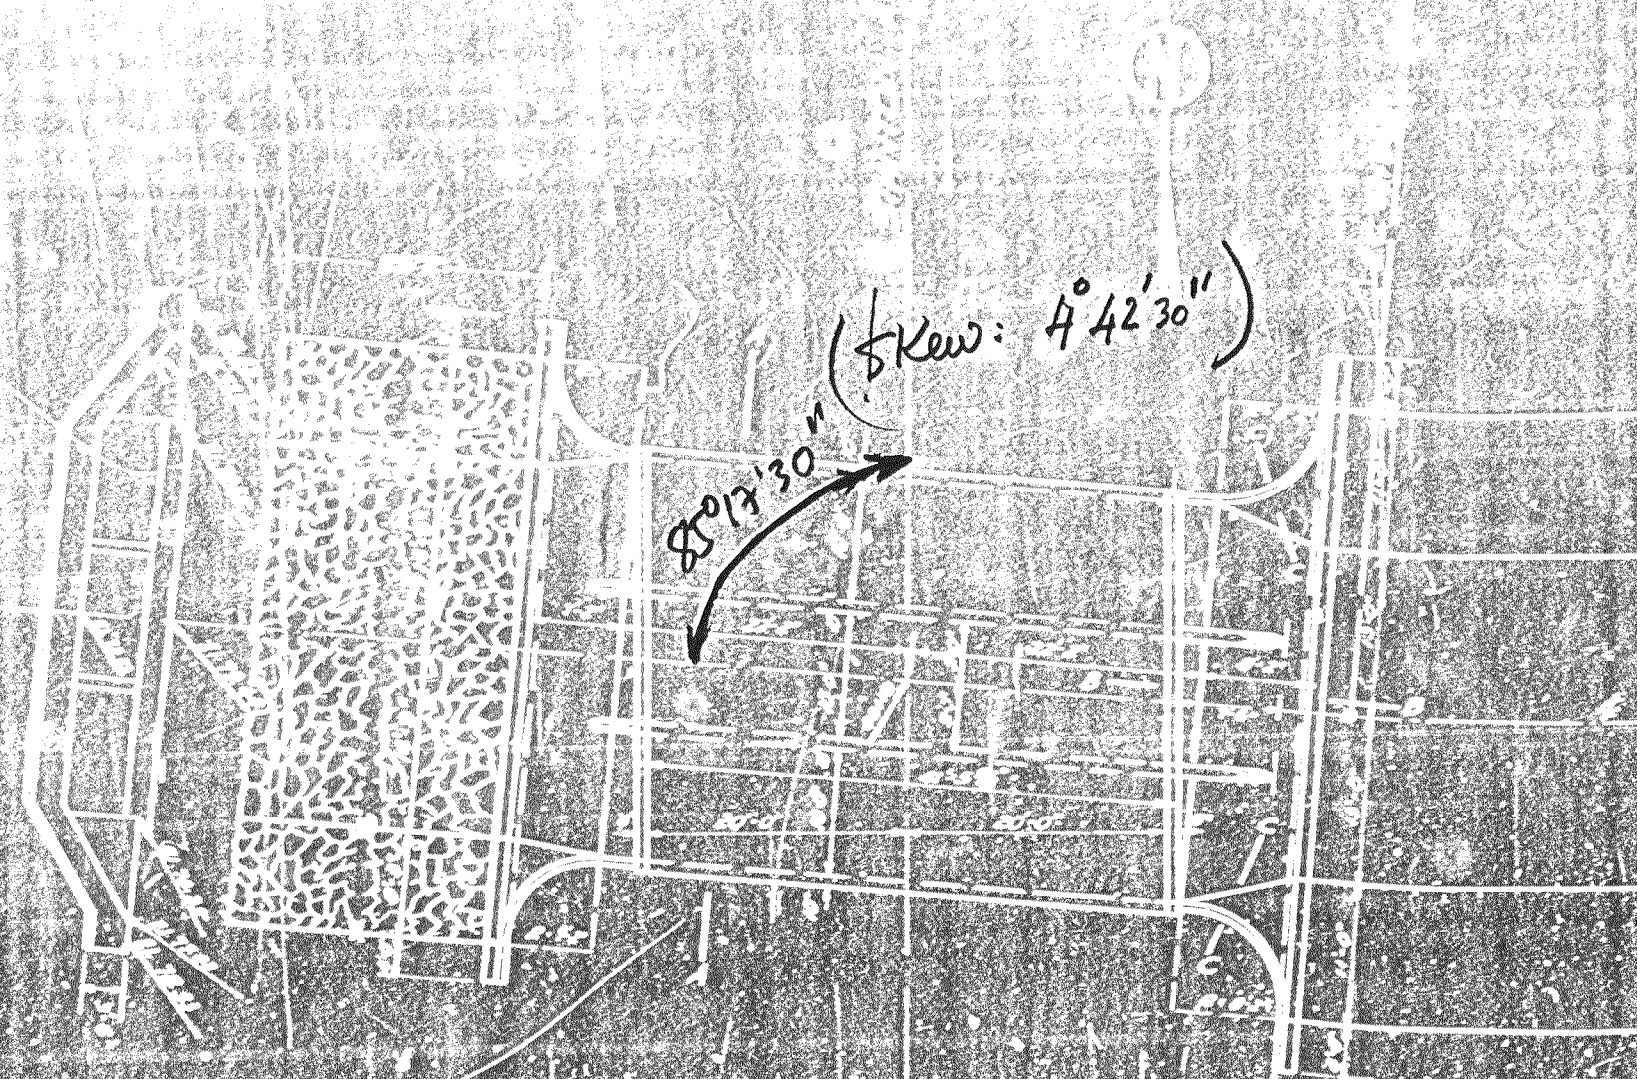


Notes:  
Hard placed field stone  
on inside concrete on  
side and bottom.

Notes:  
For Pipe Rolling detail  
See Sheet 14

Notes:  
a, g & h bars which extend  
into headwall & footing shall  
be terminated to provide  
stairing floor.

Symmetrical about C-C

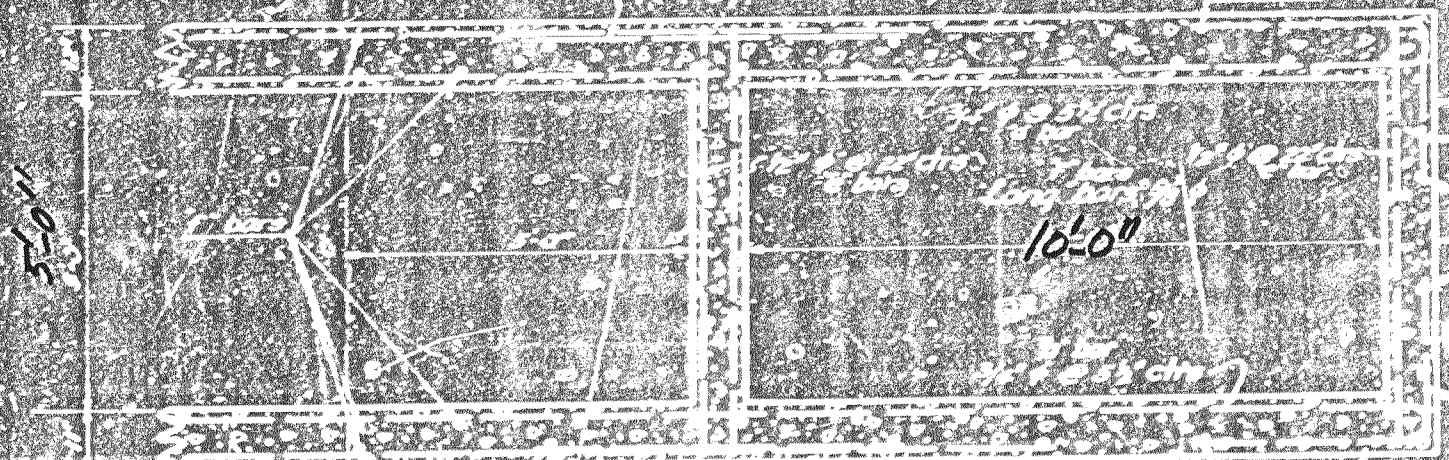

SECTION A-A  
Scale 1" = 10"

Sheet 14-153  
Stanton Ave.  
Box No. 10000  
Sheet 14-1  
Revised 5/11 Scale 1" = 10"  
Blumstein

H-4-5"  
+ 8  
- 2  
59-3 = 60 1/2

Thom L = 60 ft of 5' x 10" RCB CURT

#14605 1940  
S-153  
STANTON AVE.  
800 ft N/O Orange thorpe Av.  
Thomas: 767-JL