
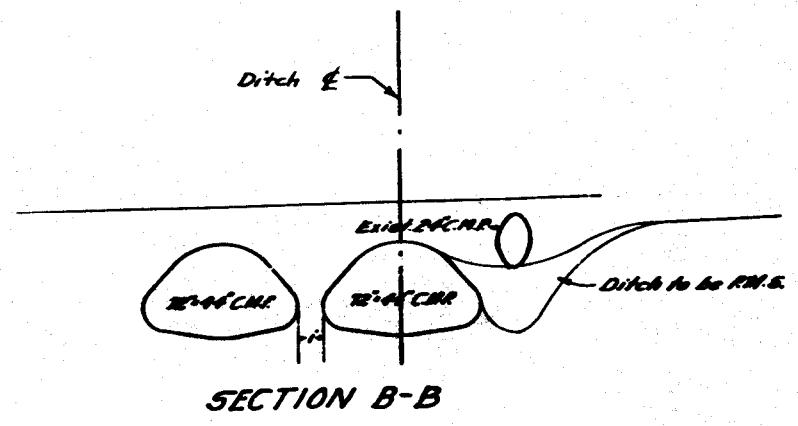


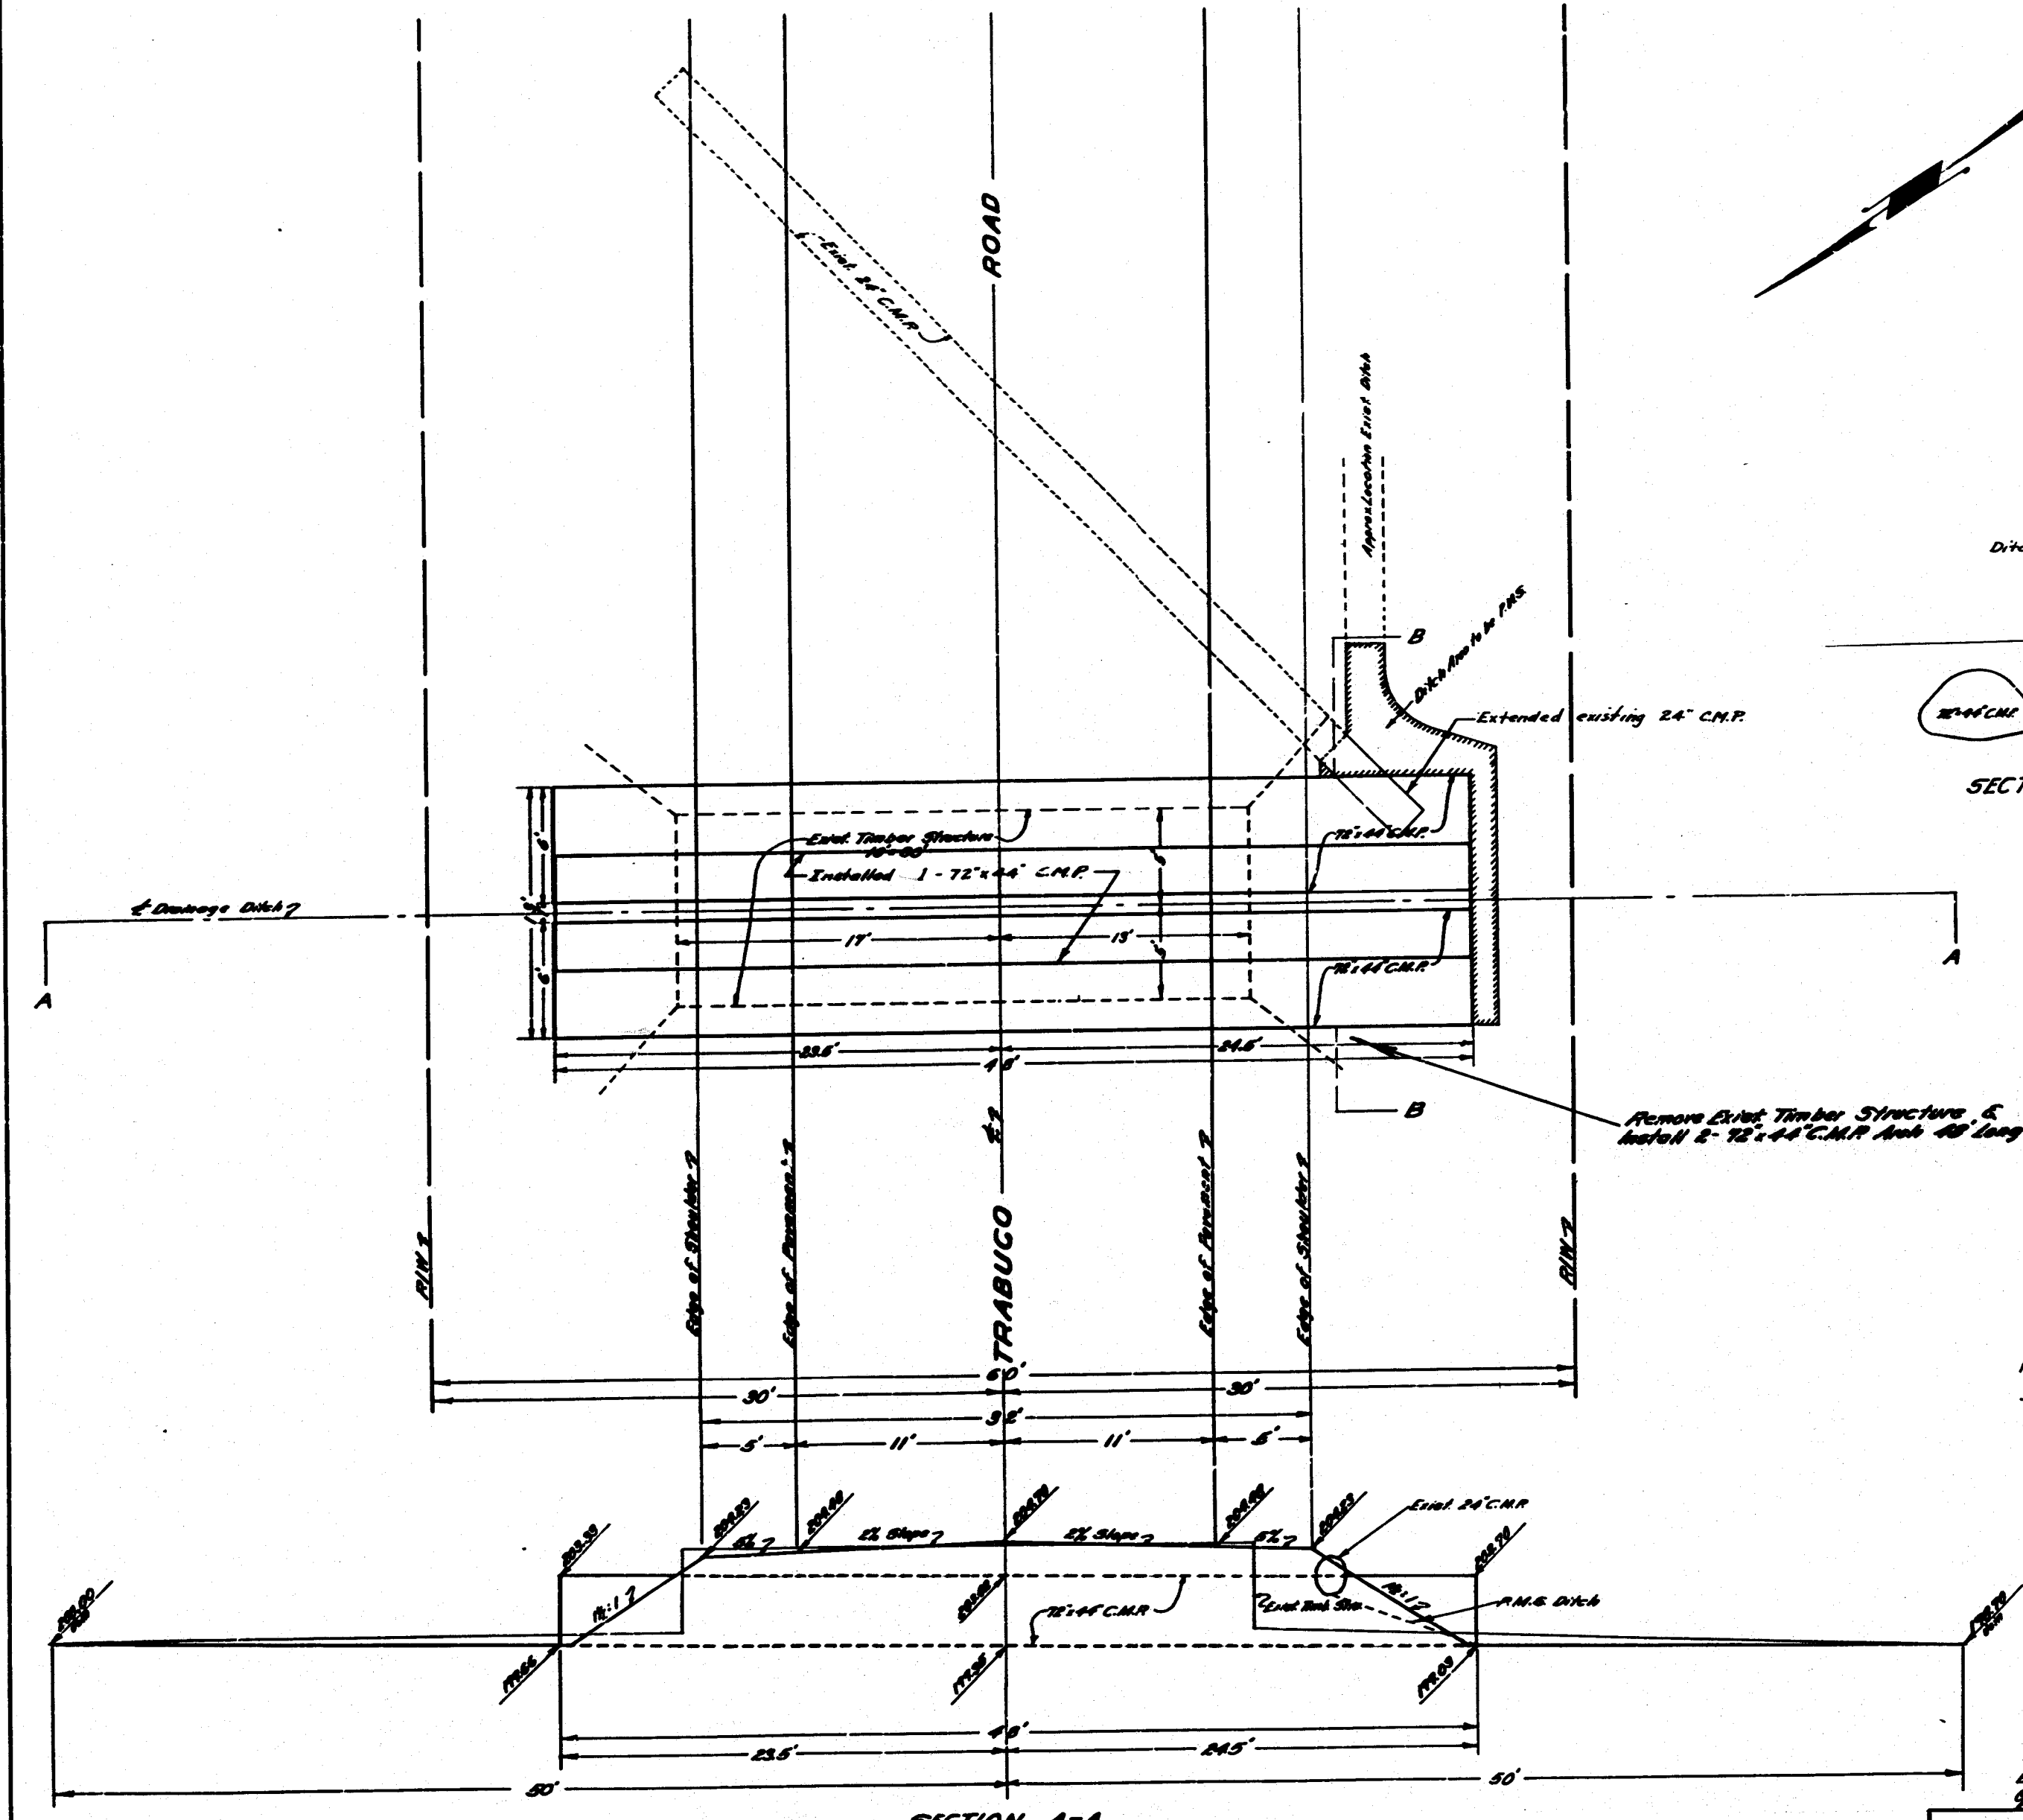

NOTE: Construction changes shown in red. Constructed berms and paved slopes with R.M.S.

Structure #S-106
on Trabuco Rd. 0.25
mi. E/O Jeffrey Rd.
Sheet 1 of 1
Red: 12.5' / Scale 1"=5'
Vellum

S.M. Chisel Knob on South Outlet of Irrig.
Gate 36.5 ft. of Slo. 102.4% Elev. 206.87
Elev. Structure 20.00 ft. 20.00 ft. 20.00 ft.

DATE	BY	REVISION
12-1-50	W.M.	1-12-50
1-1-51	W.M.	1-1-51
1-1-51	W.M.	1-1-51

ORANGE COUNTY HIGHWAY DEPARTMENT

STRUCTURE S-106

on Trabuco Rd. 0.25 mi. East of Jeffrey Rd.

Approved: *[Signature]*
H. Sprague, Road Commissioner

Scale: 1"=5'

Sept. 18, 1950

MICROFILMED
JUL 1 1960

Thomas: 860-J3 #14587 1950
S-106 TRABUCO Rd.
0.25mi E/O Jeffrey Rd.