
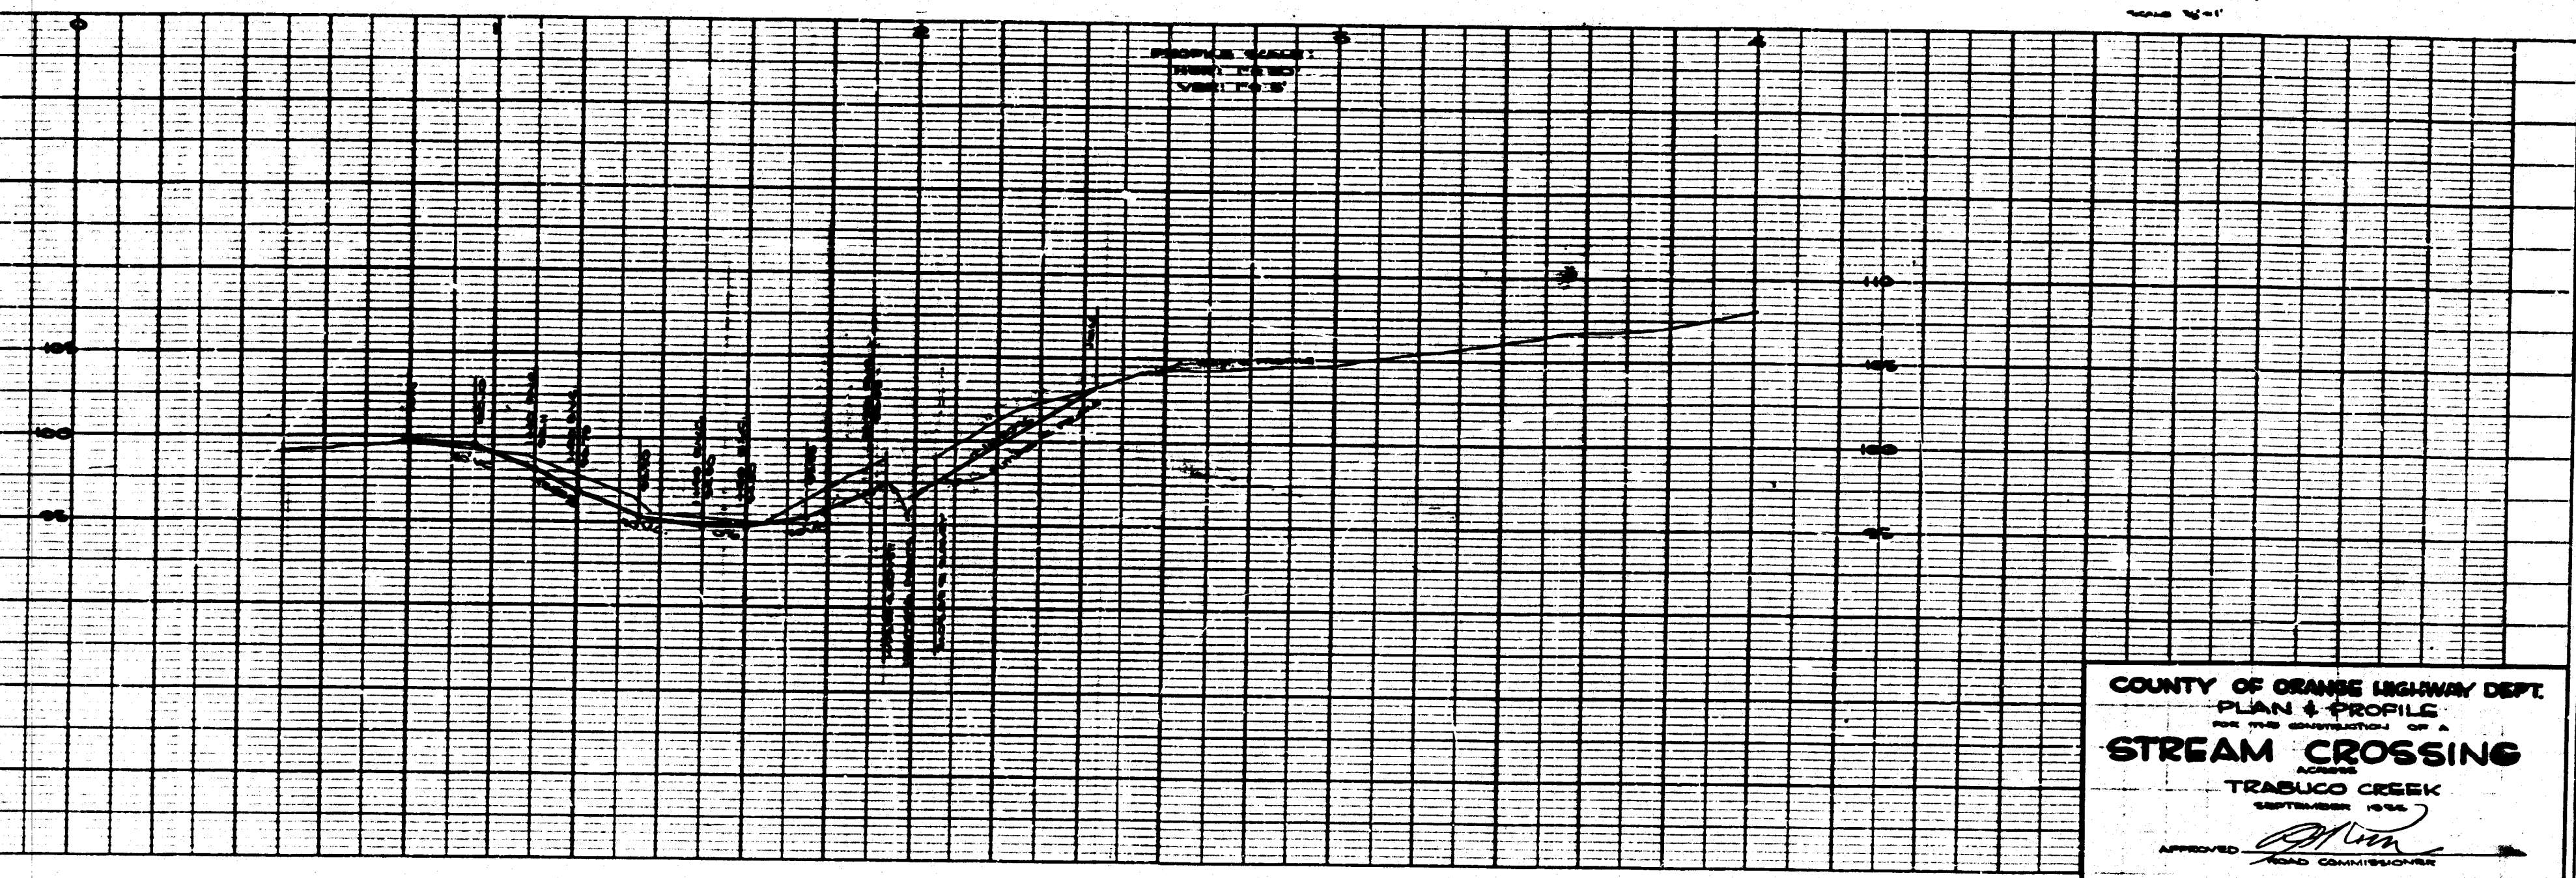
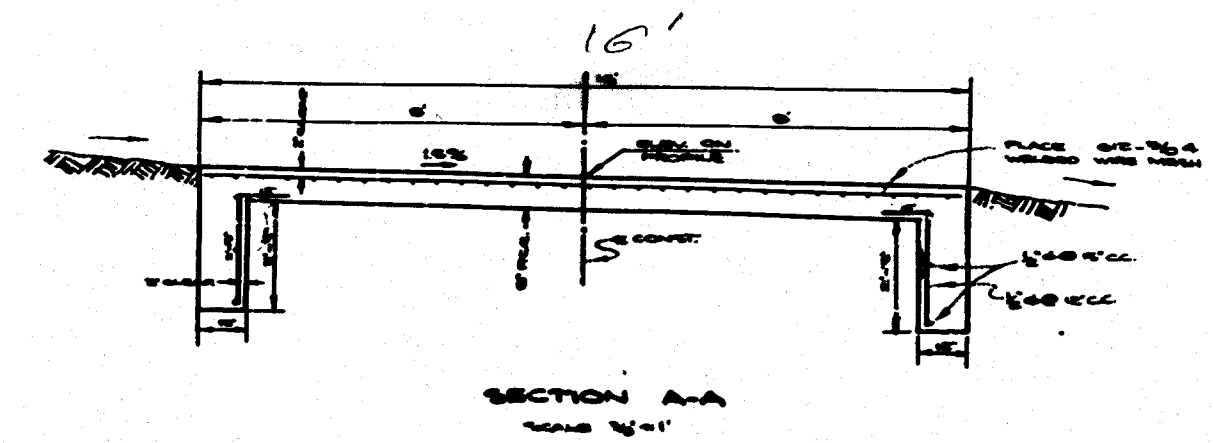


4 15 16 17 18 19 20 21 22 23 24 25 26 27 28 29 30 31 32 33 34 35 36 37 38 39 40 41 42 43 44 45 46 47 48 49

PLAN	DATE	BY
DATE	BY	BY
DATE	BY	BY
DATE	BY	BY

PROFILE	DATE	BY
DATE	BY	BY
DATE	BY	BY
DATE	BY	BY

FILE	DATE	BY
DATE	BY	BY
DATE	BY	BY
DATE	BY	BY

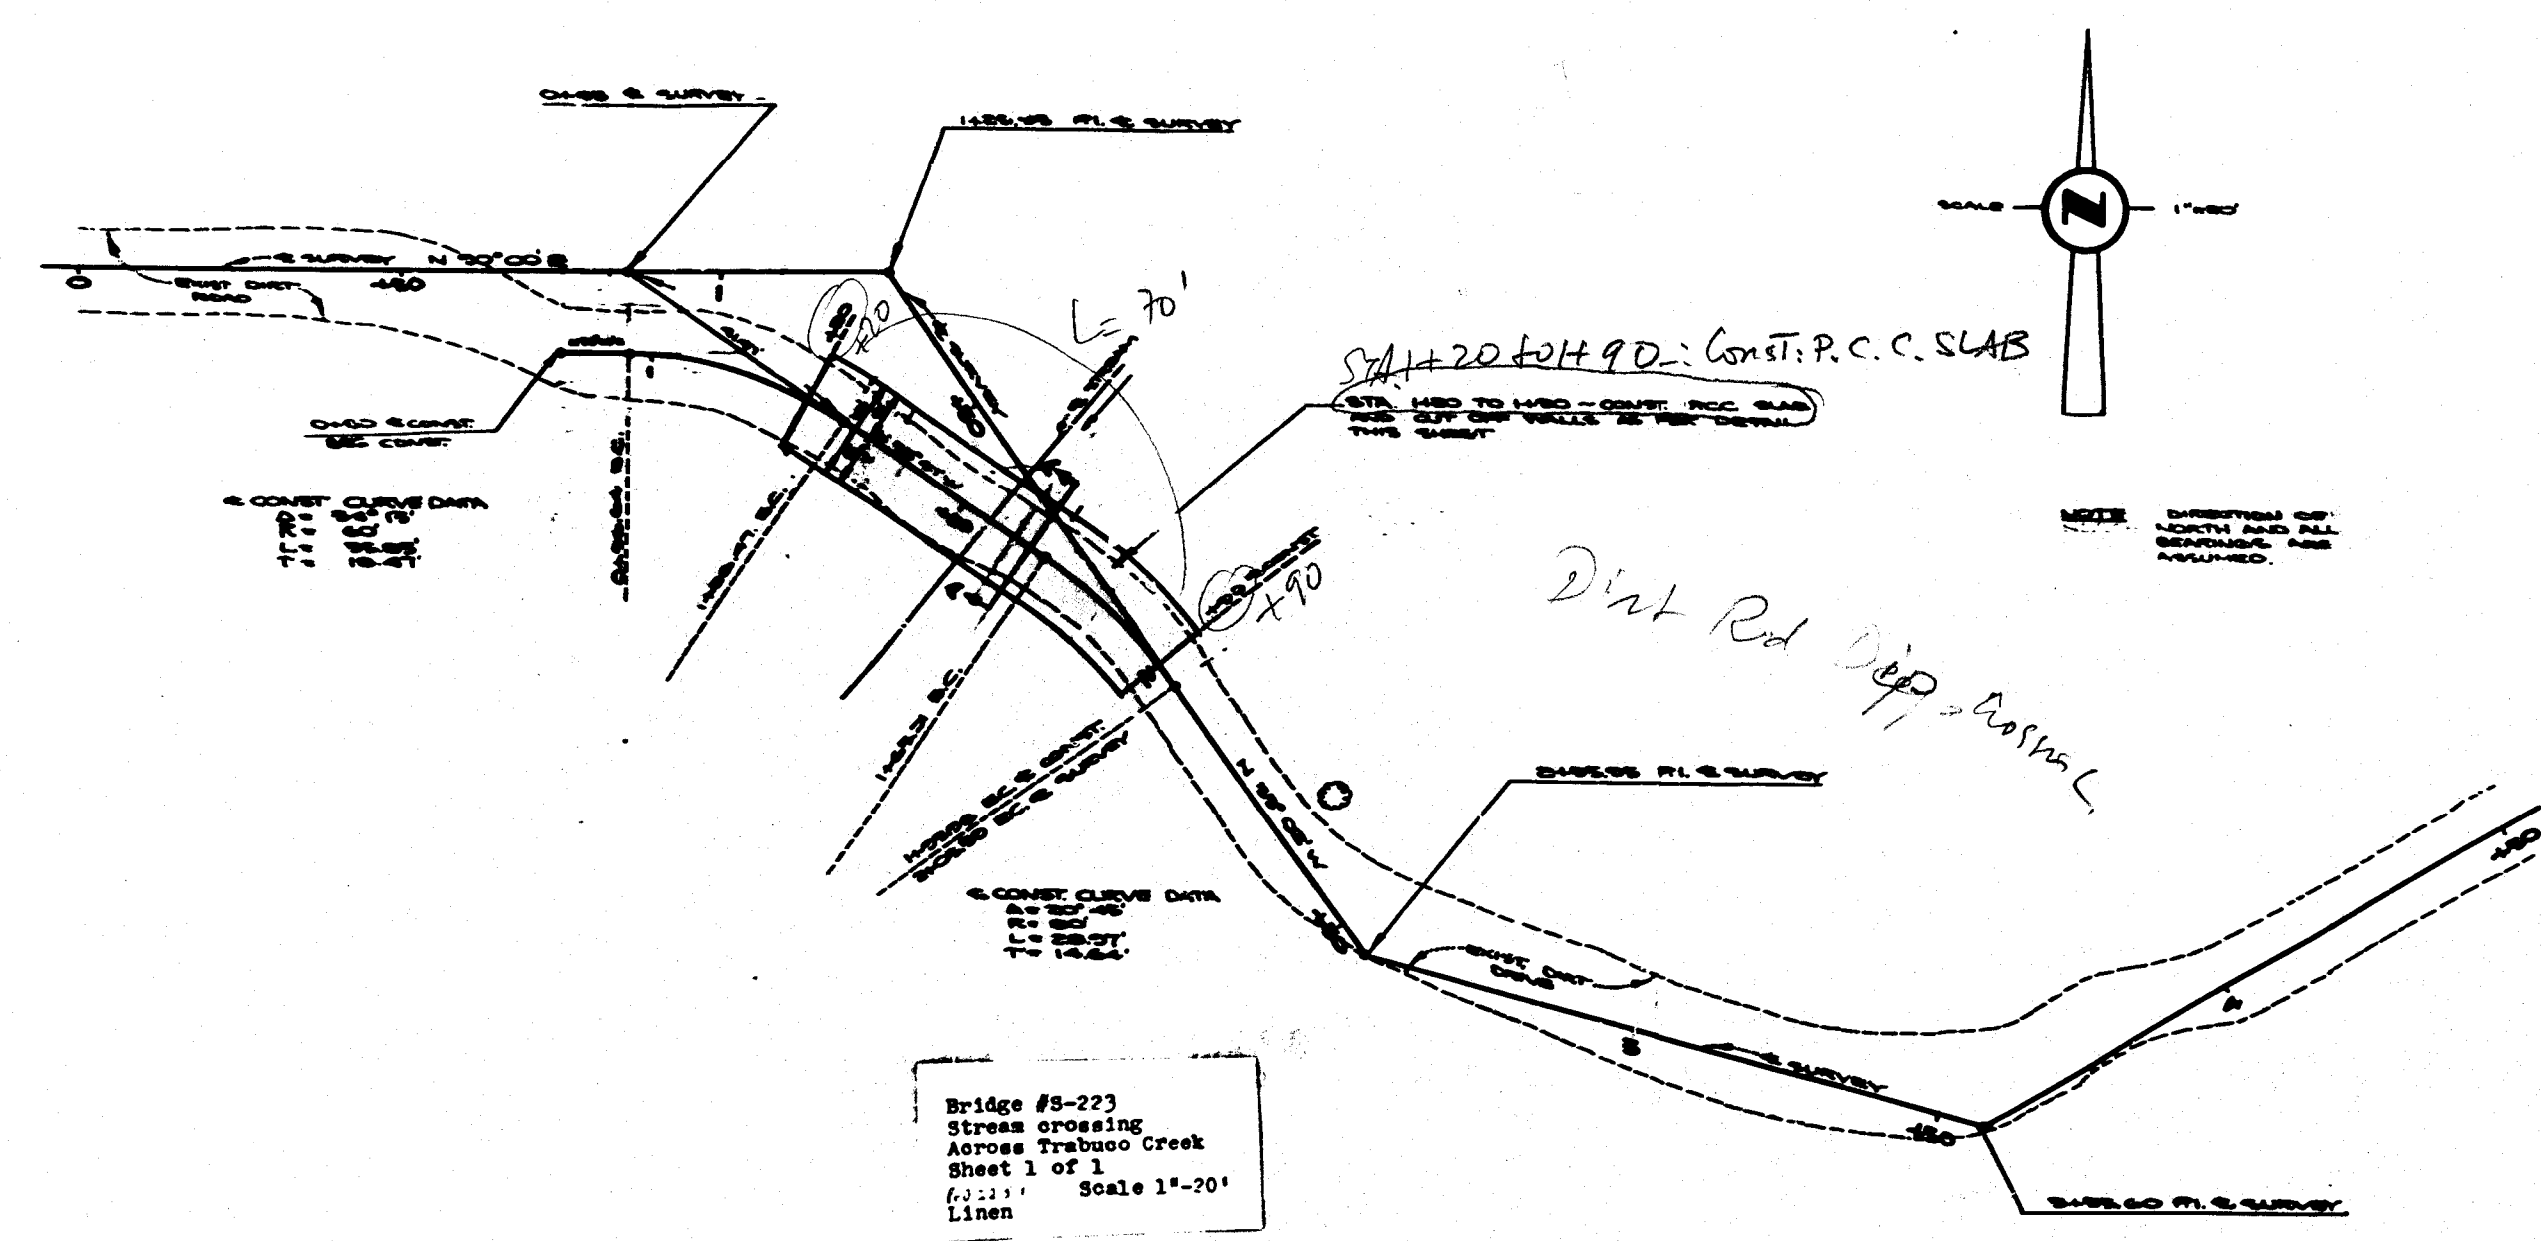

COUNTY OF ORANGE HIGHWAY DEPT.
PLAN & PROFILE
FOR THE CONSTRUCTION OF A
STREAM CROSSING
ACROSS
TRABUCO CREEK
SEPTEMBER 1955
APPROVED *[Signature]*
ROAD COMMISSIONER
BRIDGE - 145

Misc. Structure - Trabuco Creek

UNIDENTIFIED
DIRT ROAD CROSSING #14627 1955
ACROSS TRABUCO CREEK
S-223
(AD: STREAM CROSSING)
ACROSS TRABUCO CREEK