


NO SCALE

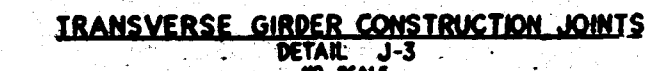

GIRDER REINFORCEMENT

[illegible]