


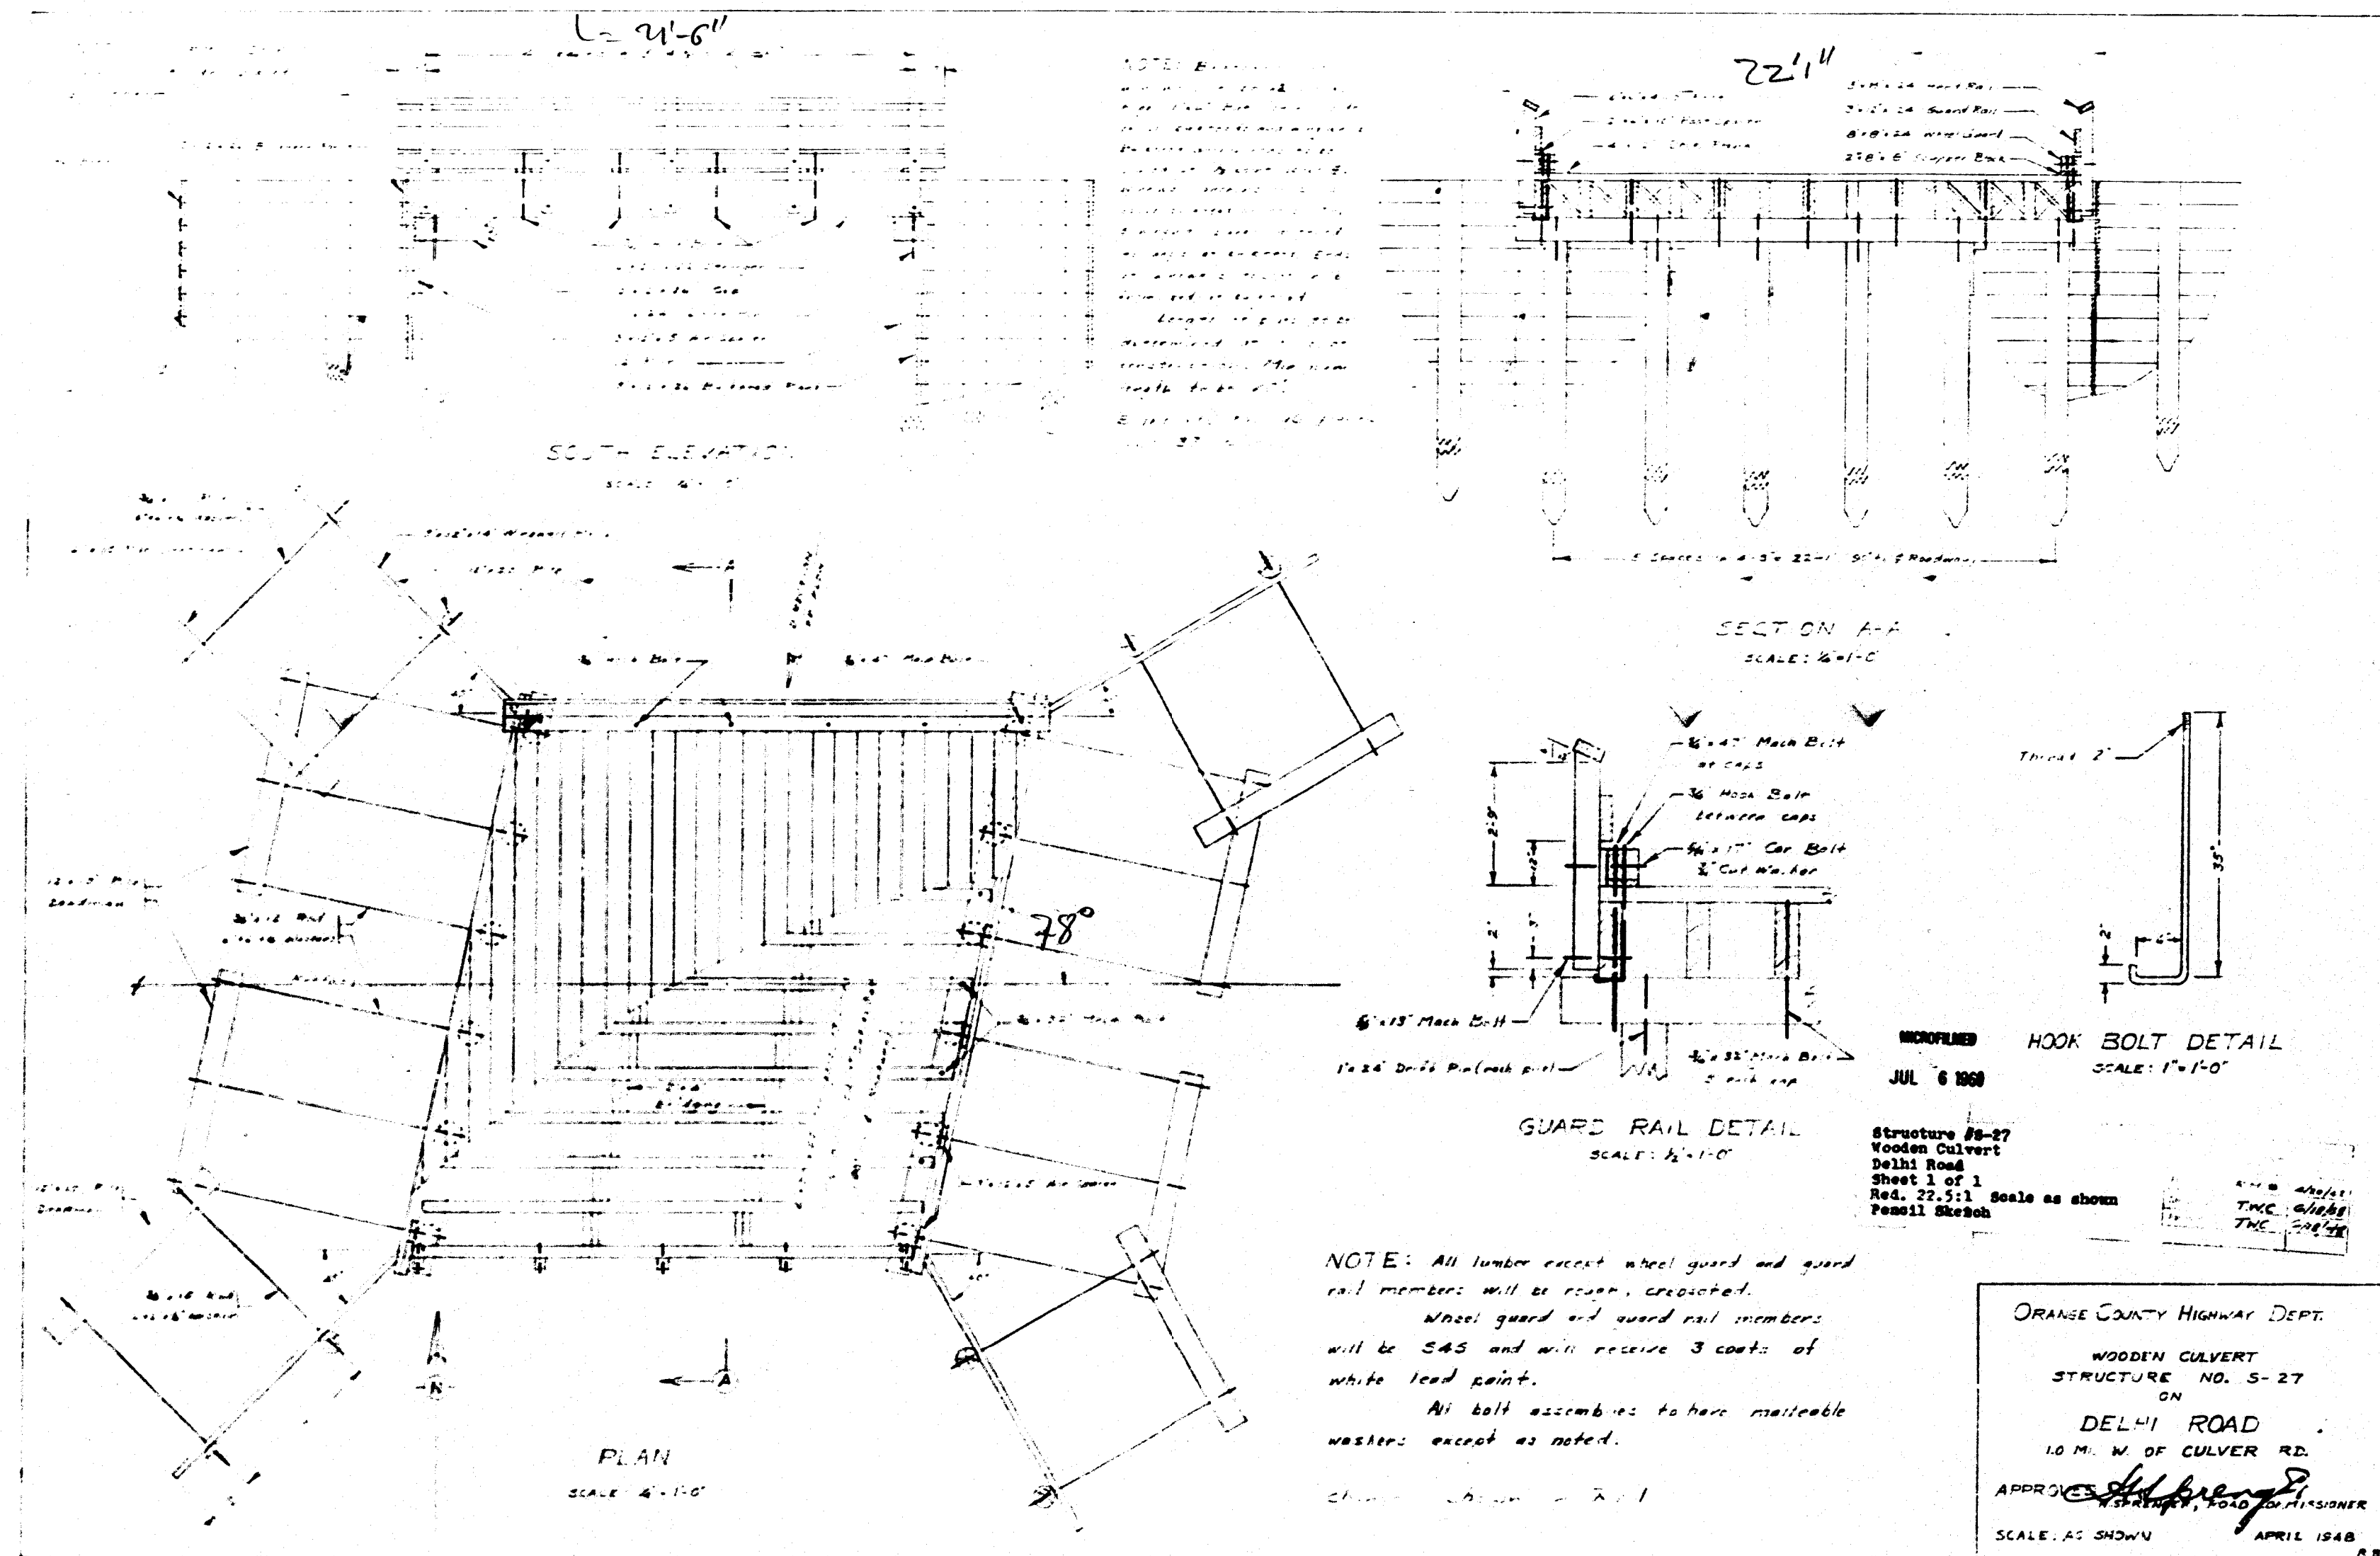

W = 22'1"
L = 21'6"
Skew = 12°

#14539 1948
55C-341 PC-6 (old S-27).
(old: DELHI ROAD)
Now: ~~WADSWORTH~~ (Timber)
1.0 MI. W/O Culver Rd.
Thoms 860-C3