


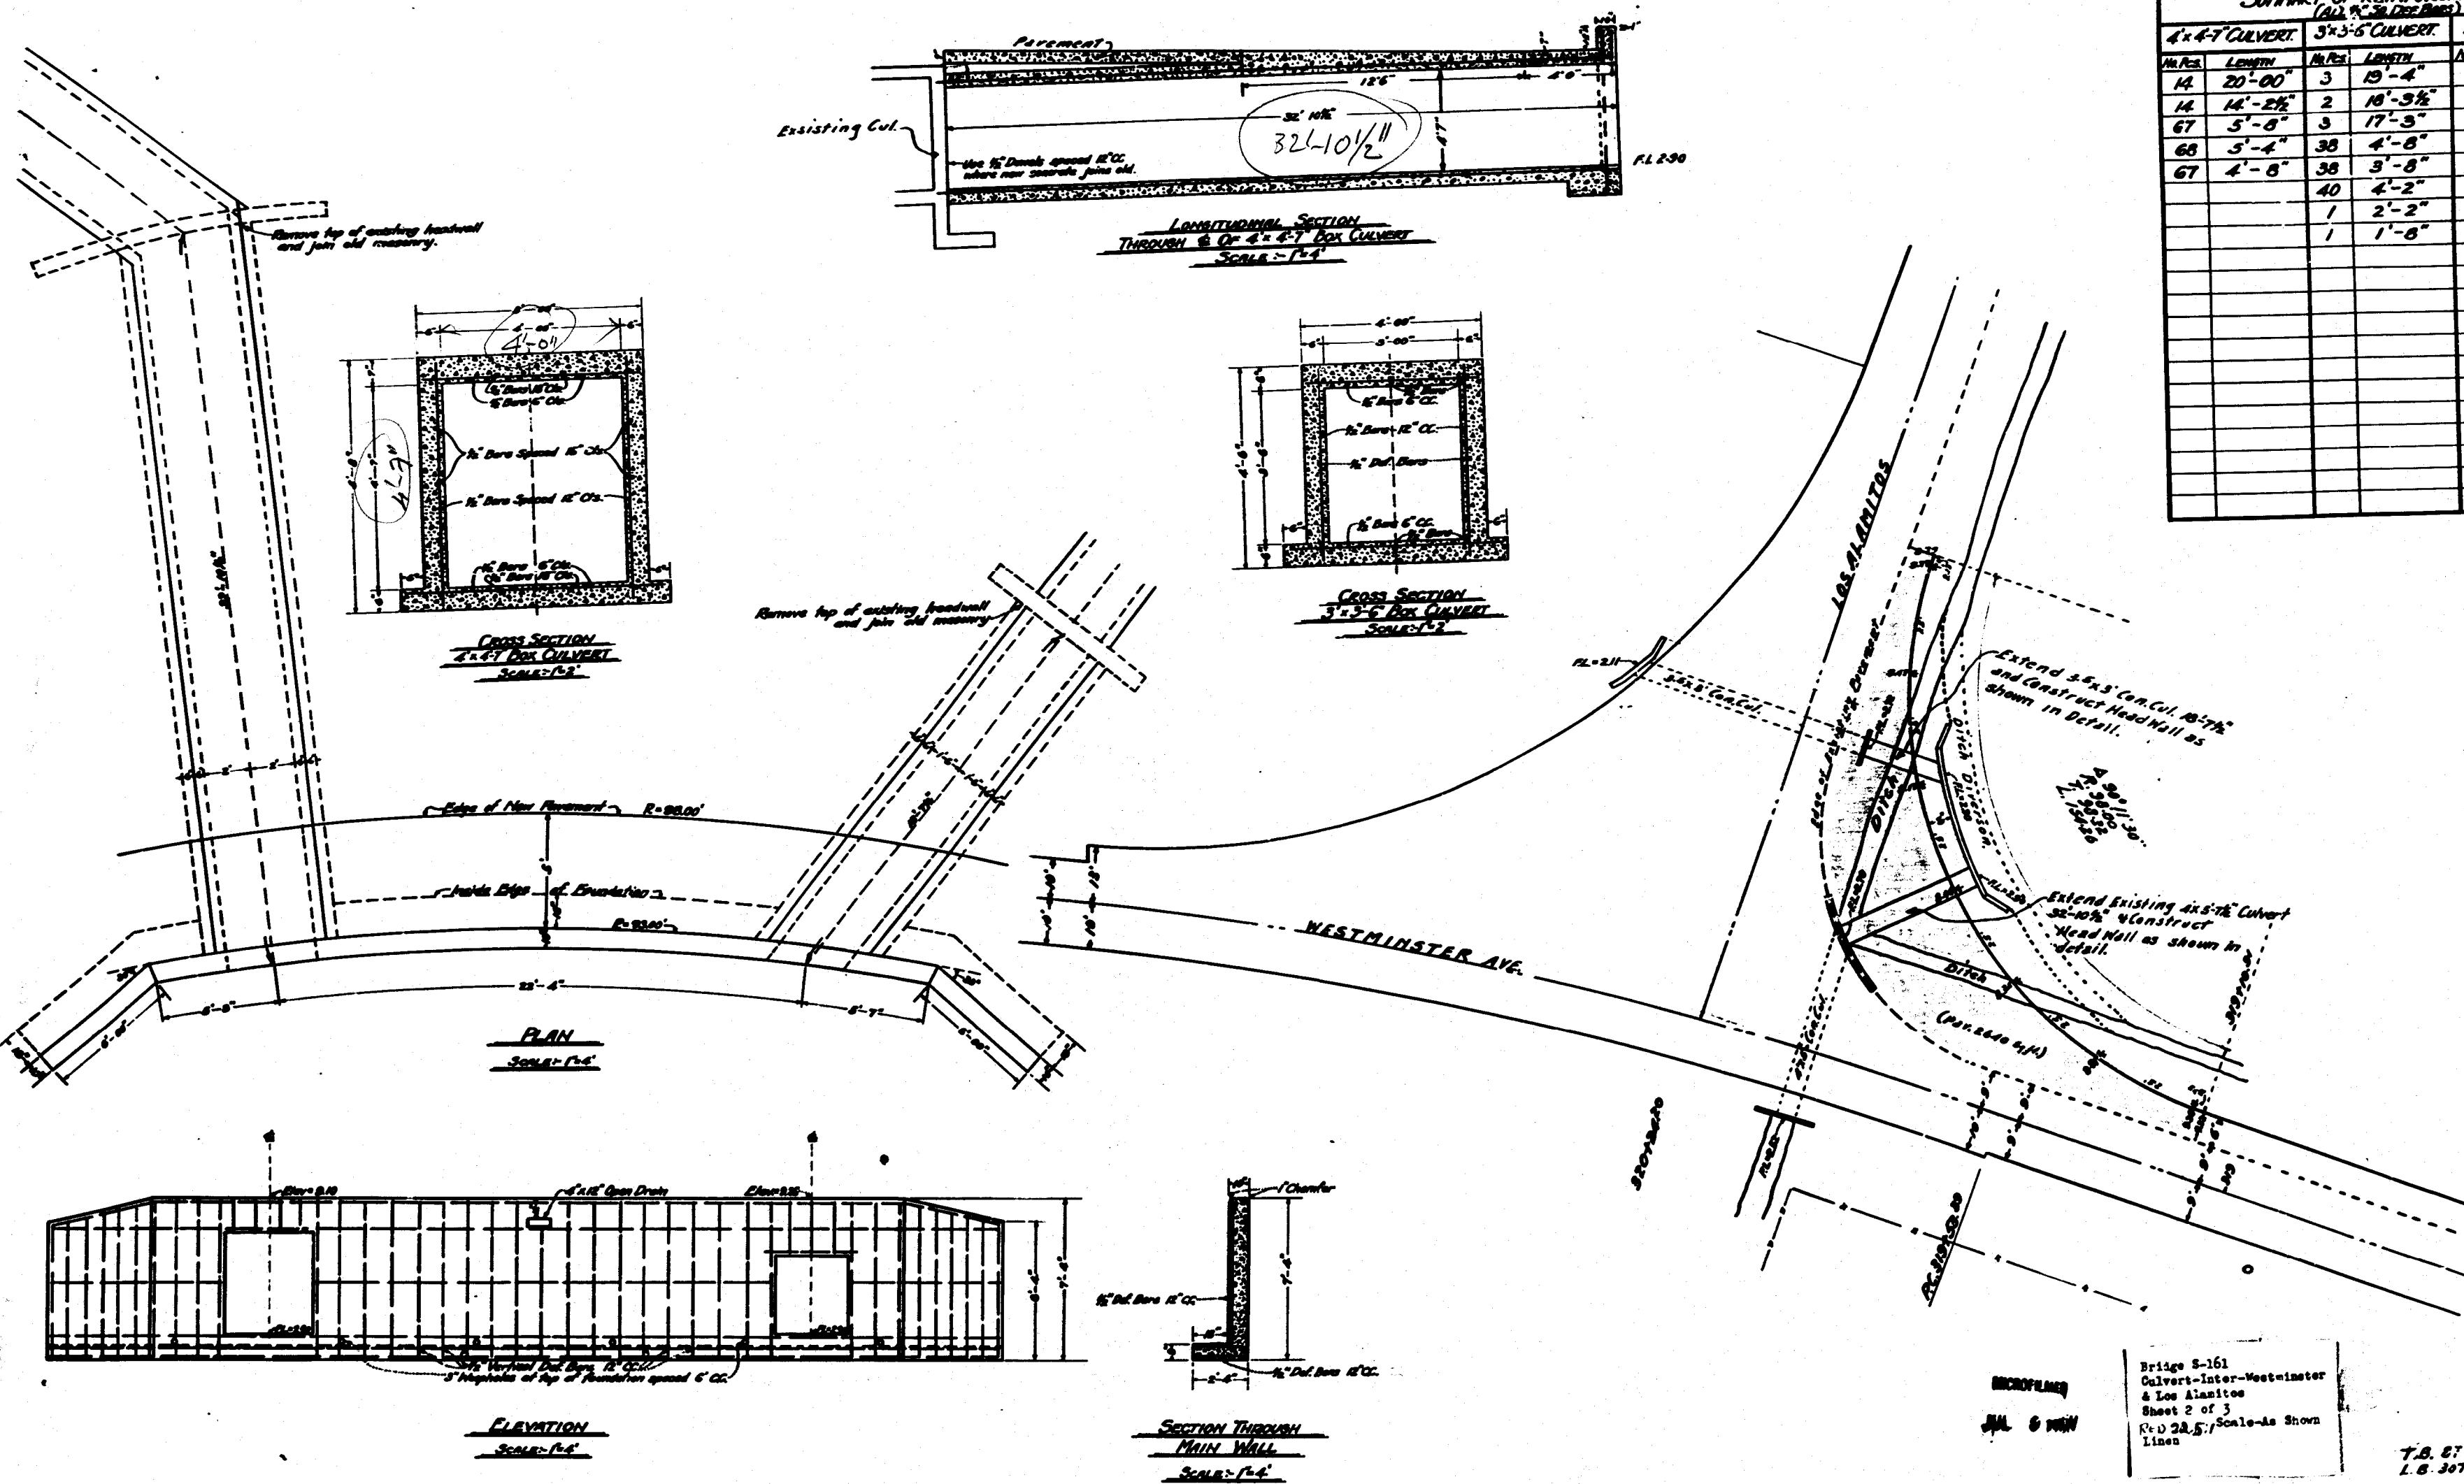

Sheet 2 of 3

4'-6" BOX CULVERT		3'-5" BOX CULVERT		RETAINING WALL	
NO.	LENGTH	NO.	LENGTH	NO.	LENGTH
14	20'-00"	3	19'-4"	10	16'-00"
14	14'-2 1/2"	2	18'-3 1/2"	5	16'-6"
67	5'-8"	3	17'-3"	2	9'-00"
68	5'-4"	38	4'-8"	1	18'-4"
67	4'-8"	38	3'-8"	26	7'-00"
		40	4'-2"	2	6'-00"
		1	2'-2"	2	6'-2"
		1	1'-8"	2	6'-4"
				2	6'-6"
				2	6'-8"
				2	6'-10"
				4	9'-6"
				2	10'-6"
				76	2'-00"
				2	4'-8"
				8	1'-8"
				2	3'-8"
				6	2'-8"

Bridge 2-161
Culvert-Inter-Westminster
& Los Alamitos
Sheet 2 of 3
Rev. 2-5-57, Scale as Shown
Lines

T.B. 67
L.B. 307