
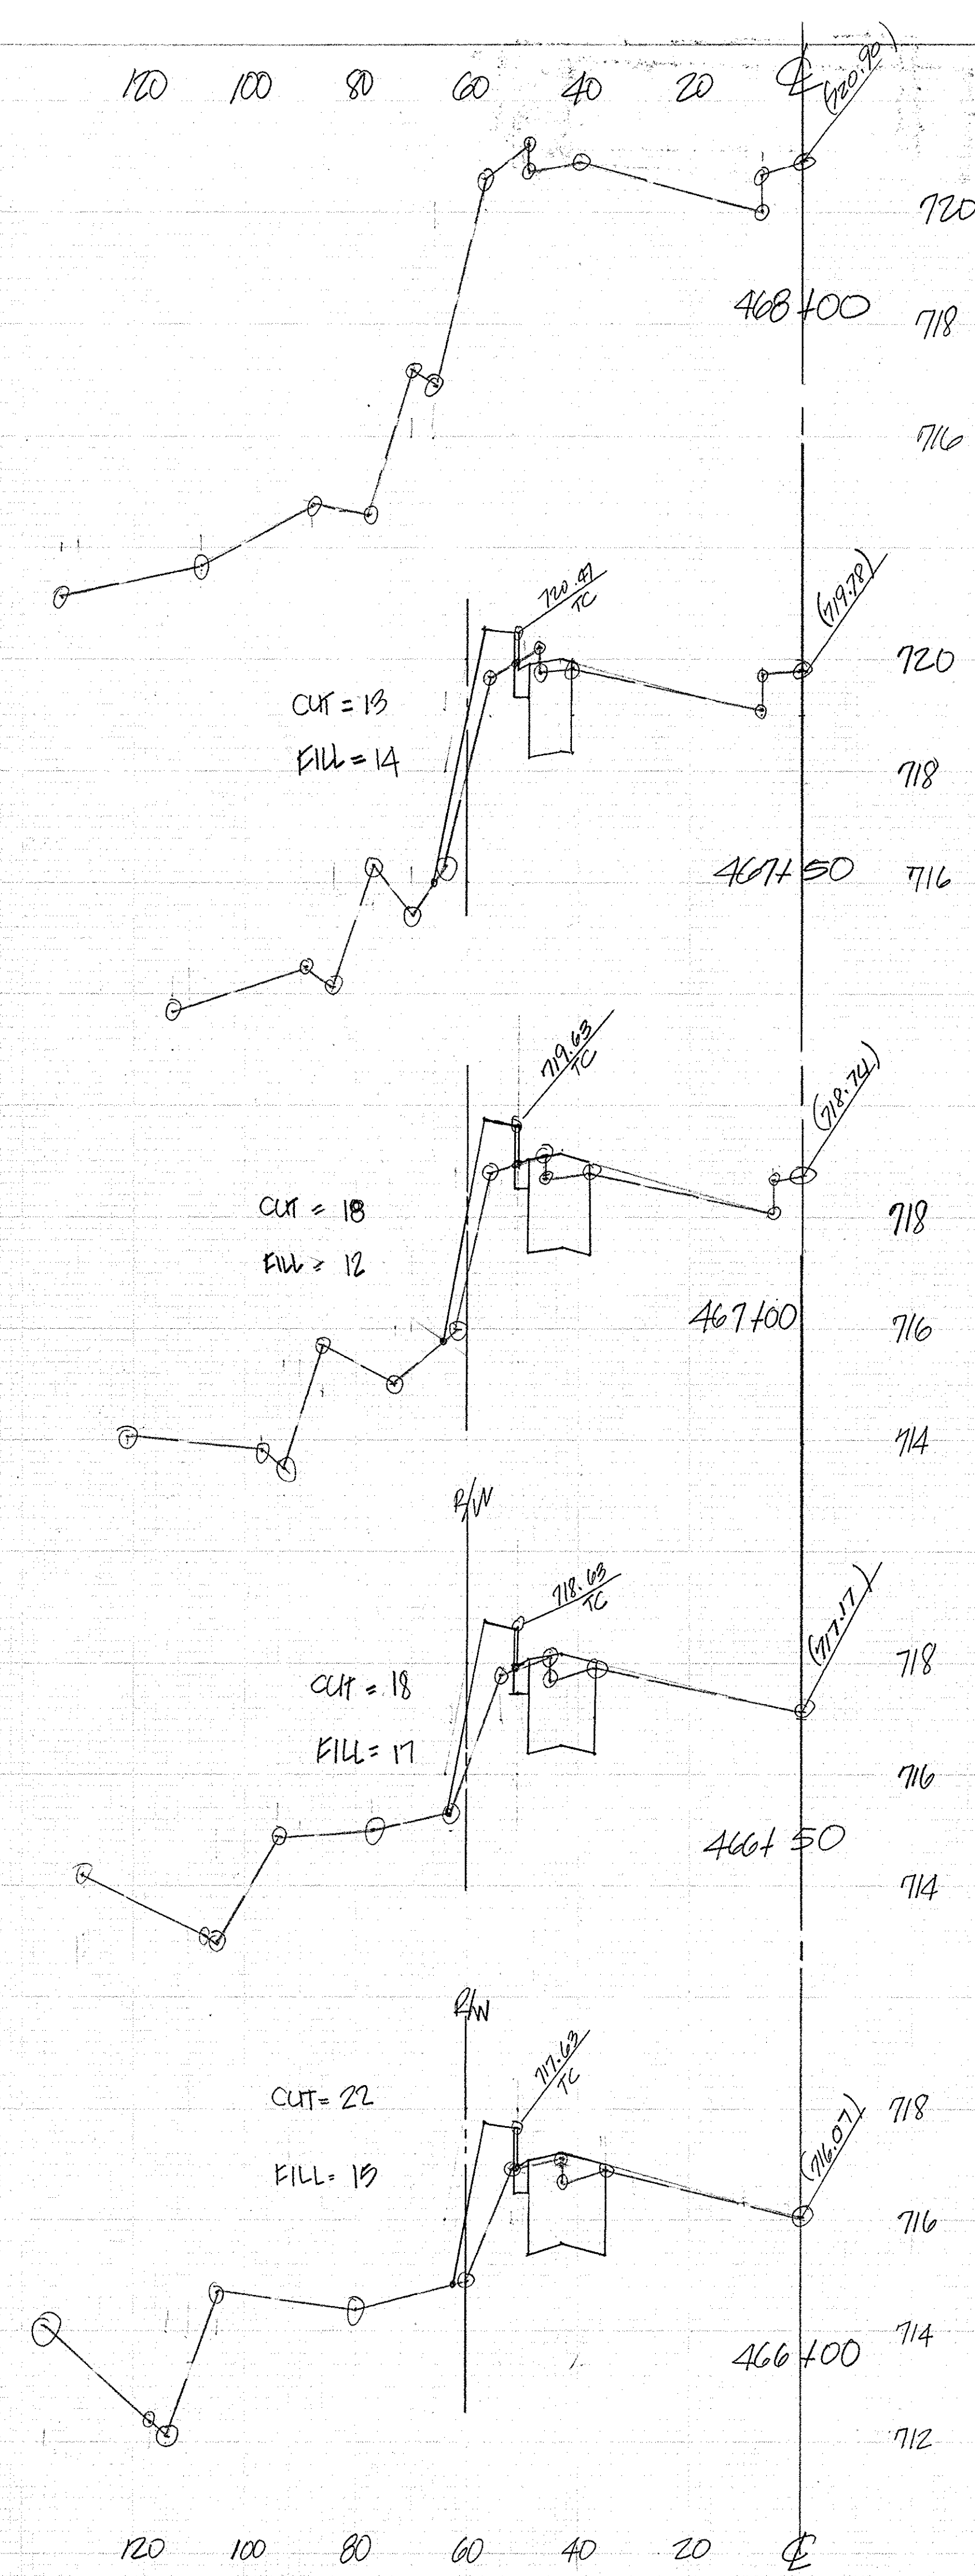
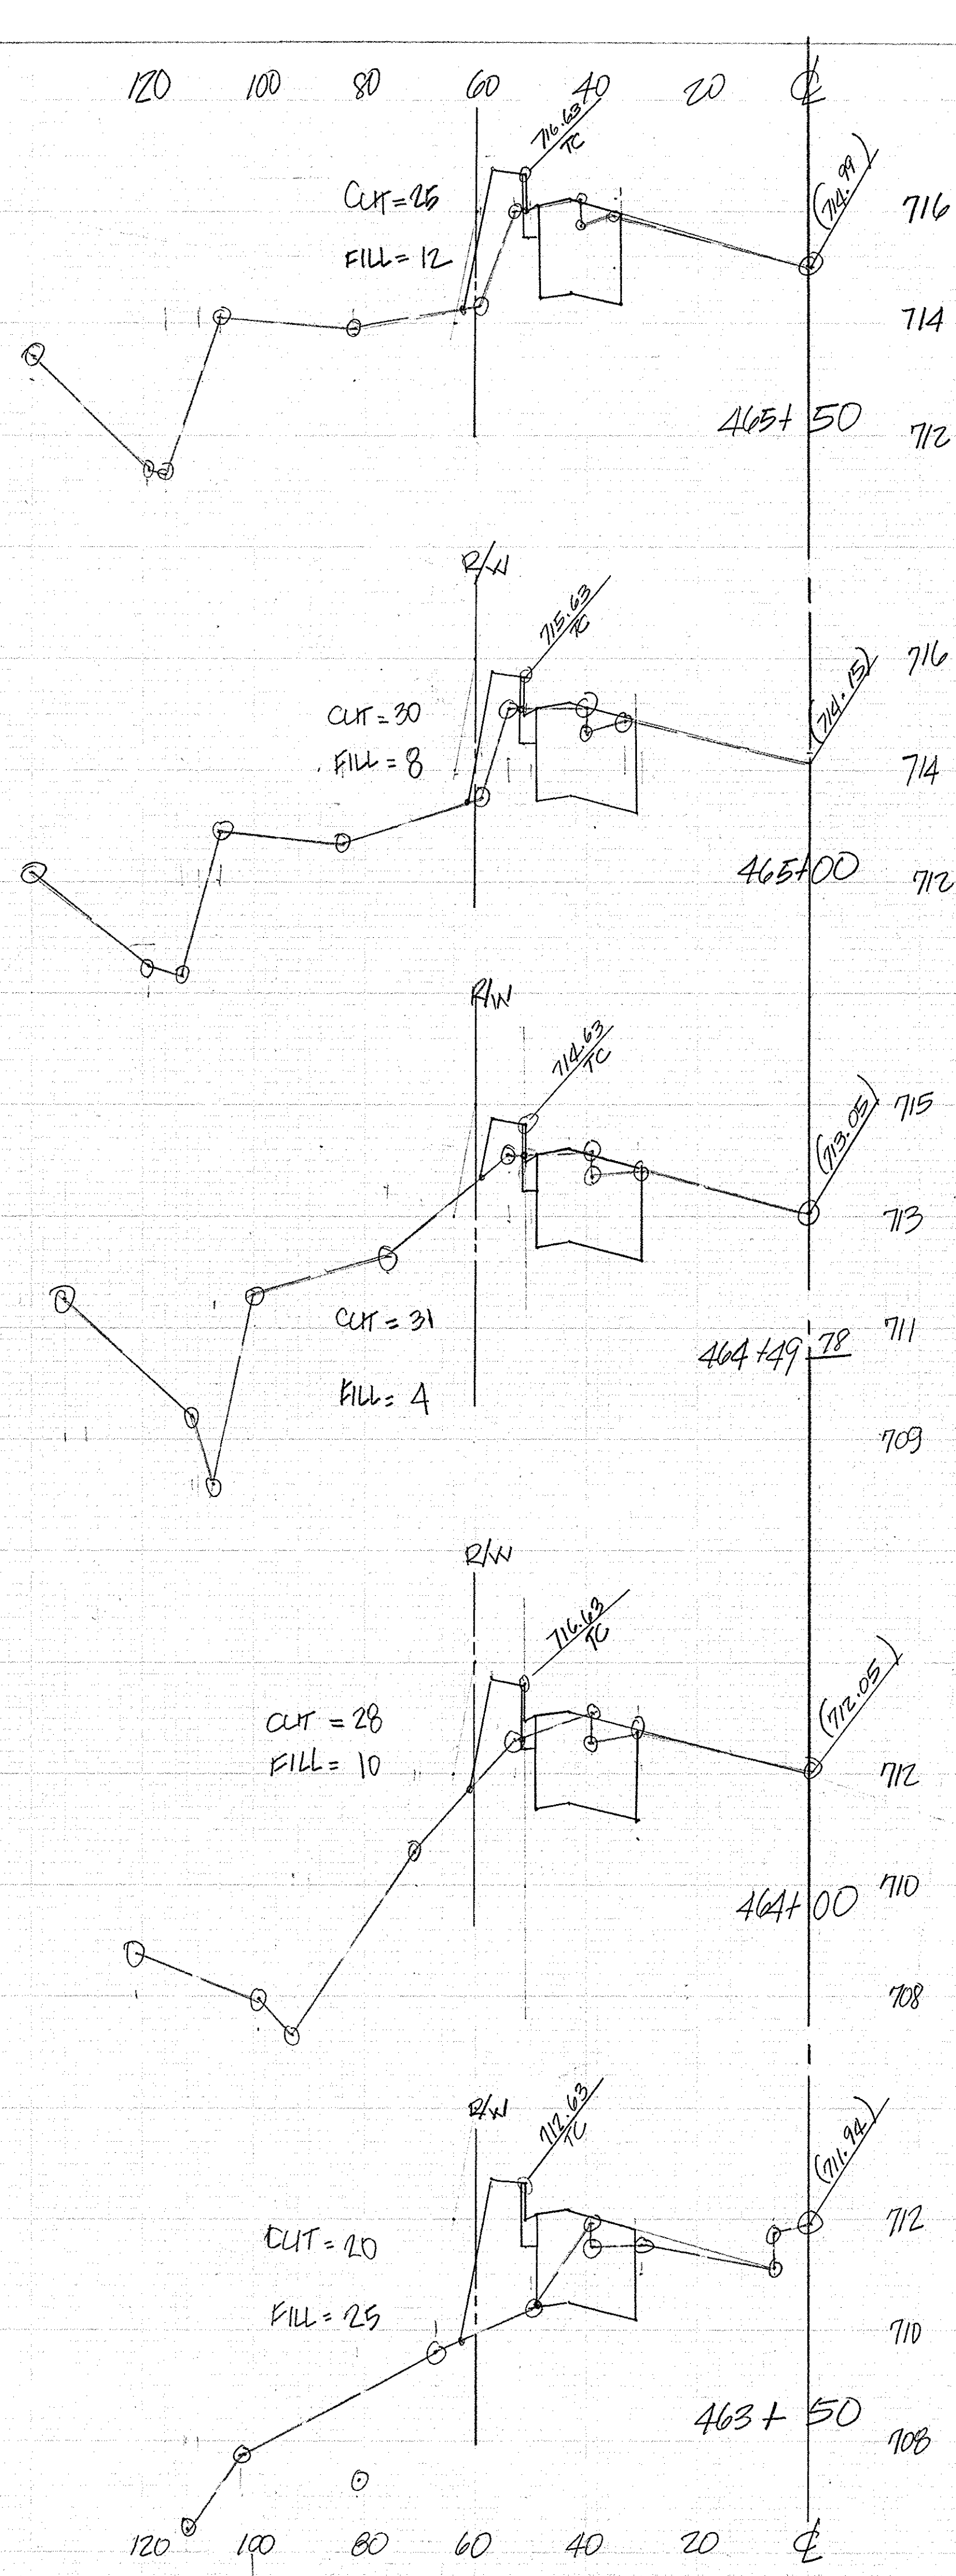


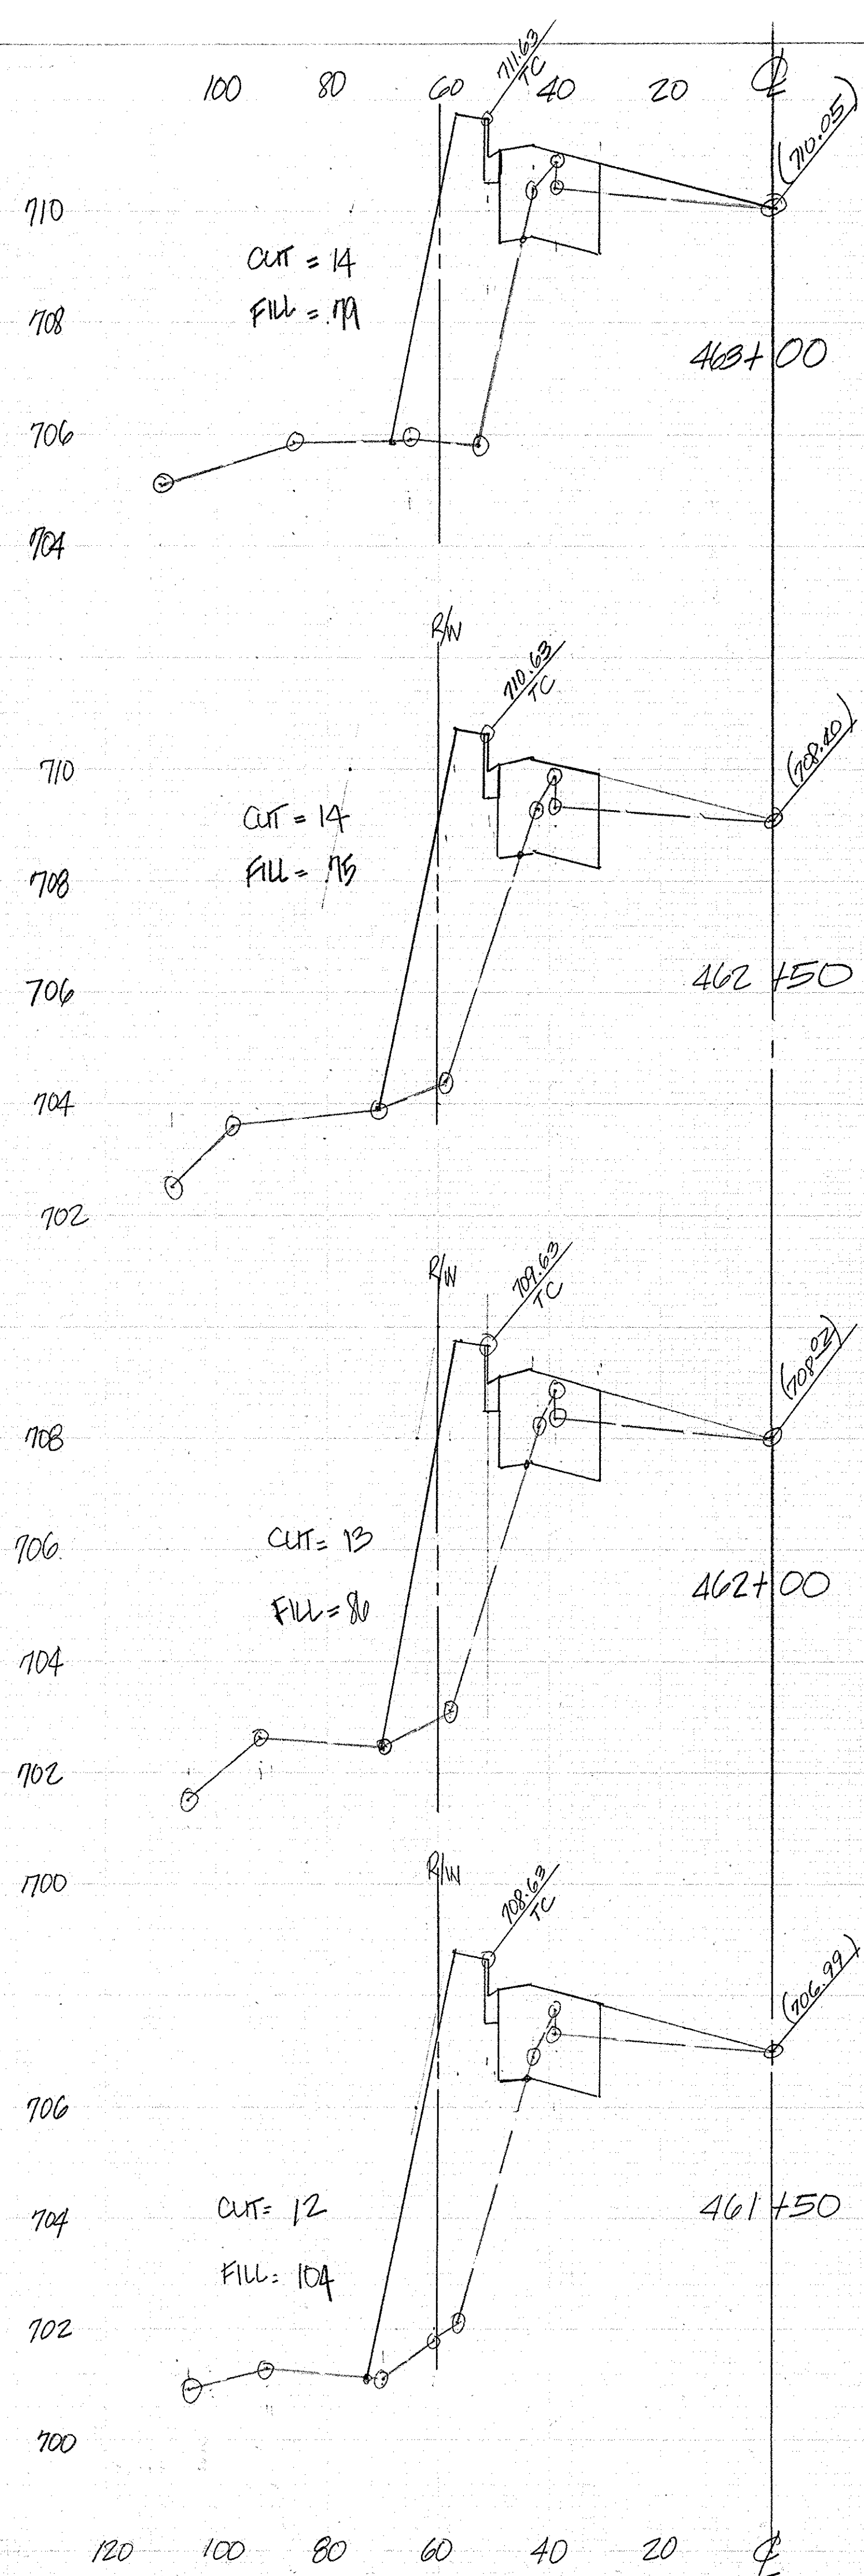

EL TORO ROAD
449+79.84 TO 468+00

SCALE: HORIZ. 1" = 20'
VERT. 1" = 2'

SHT. 6 OF 6