

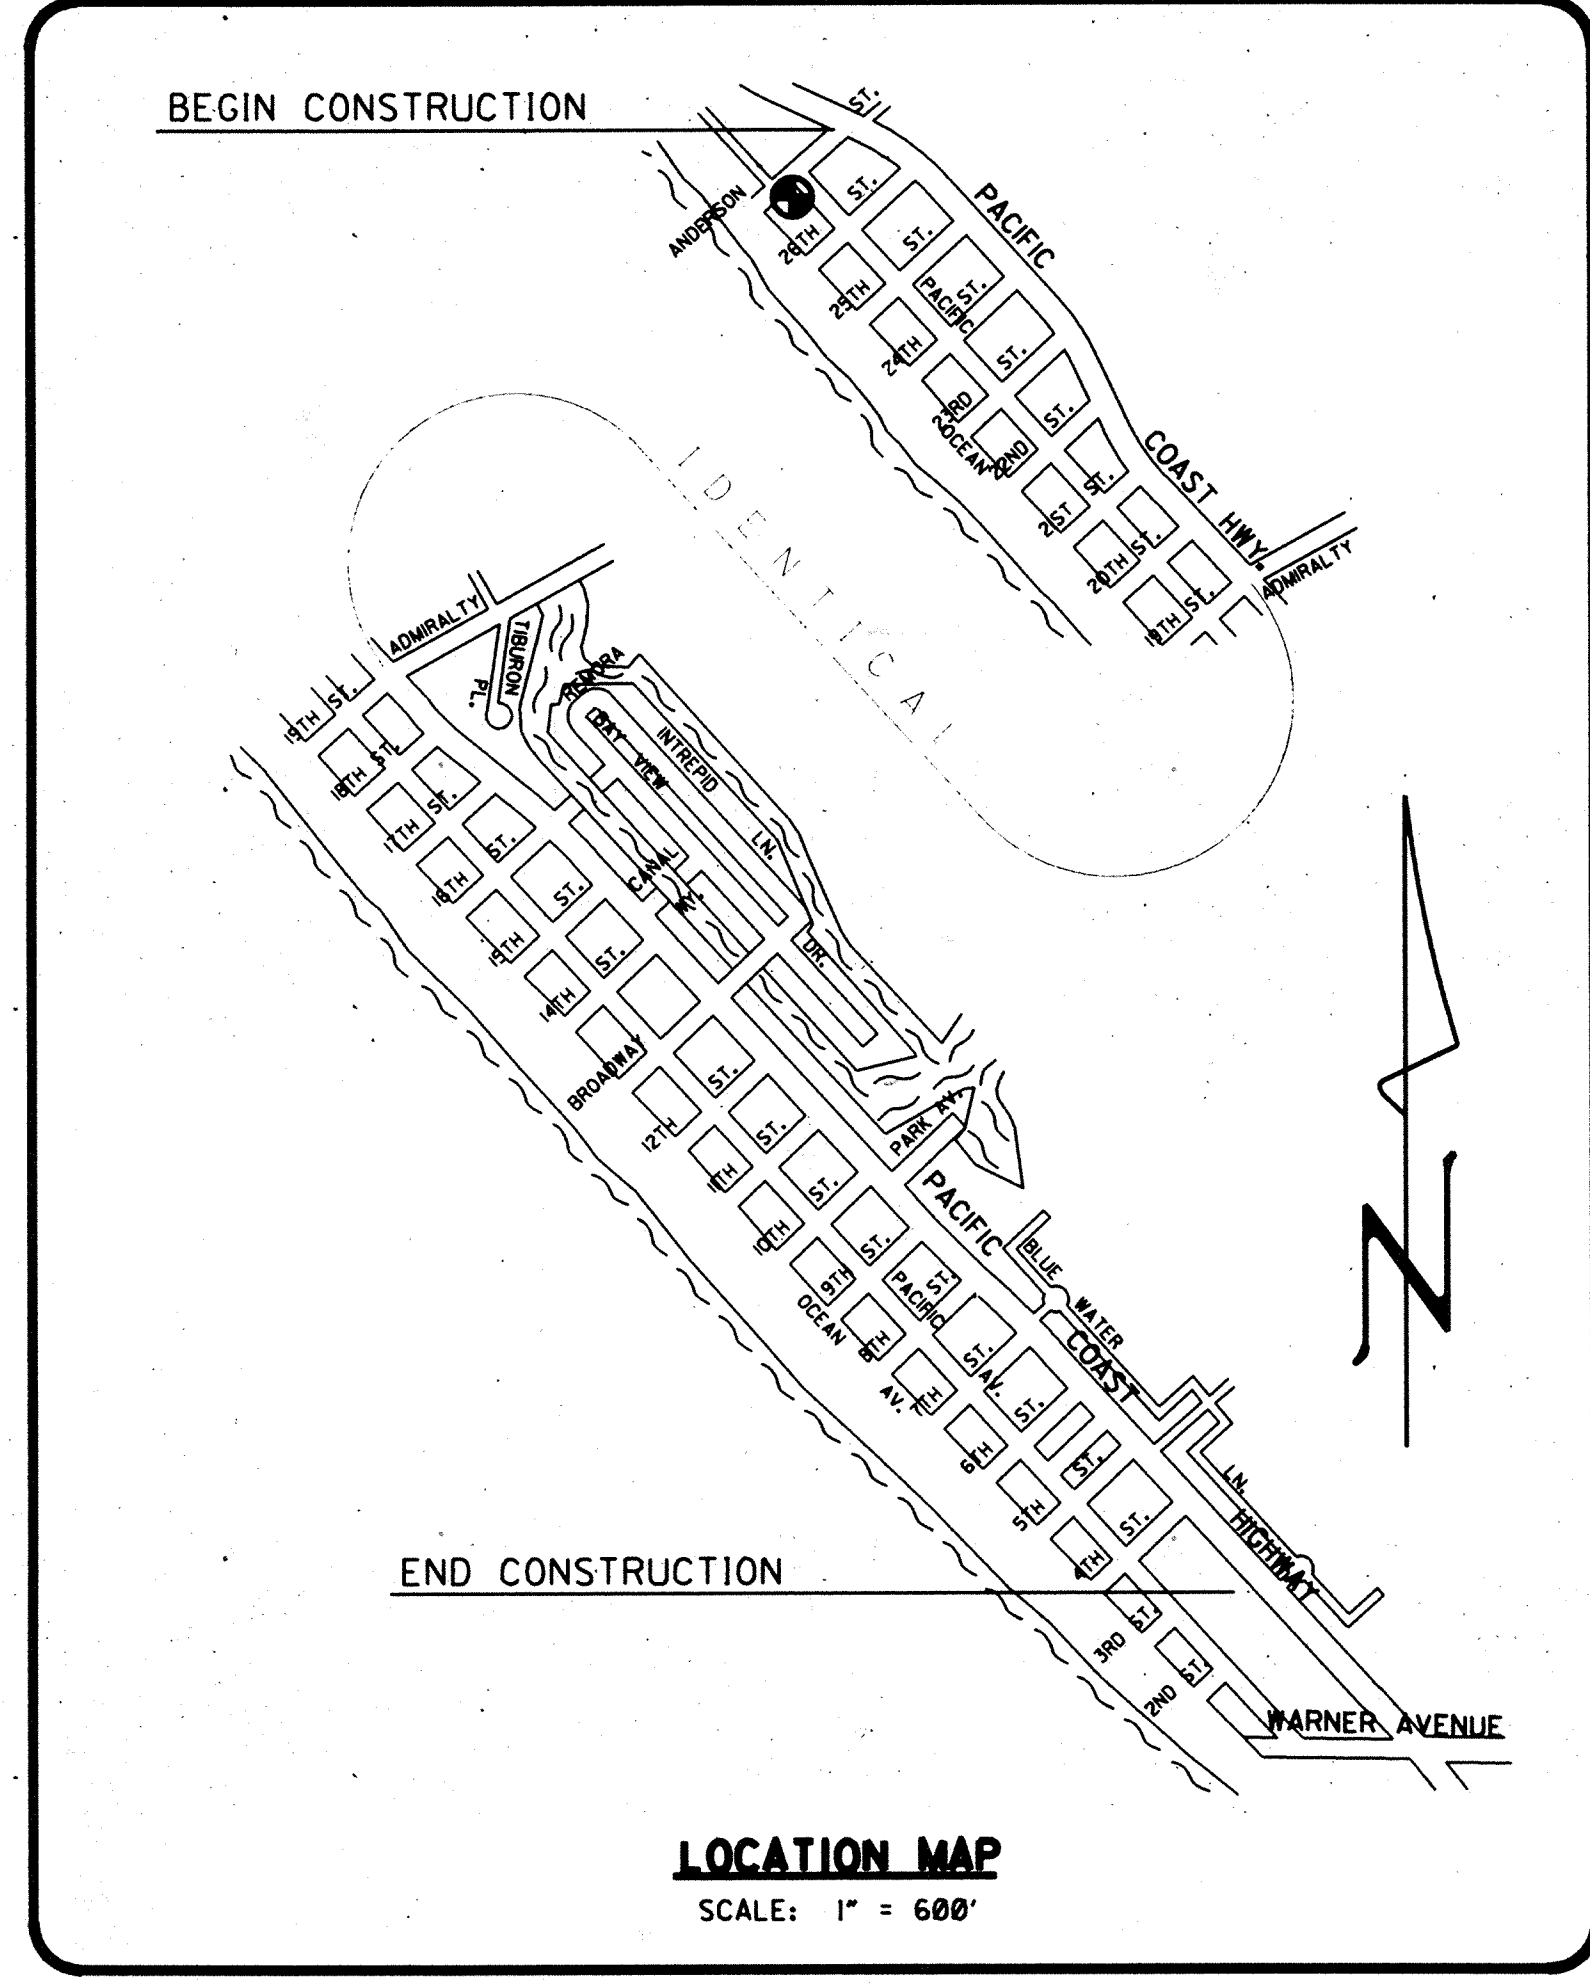


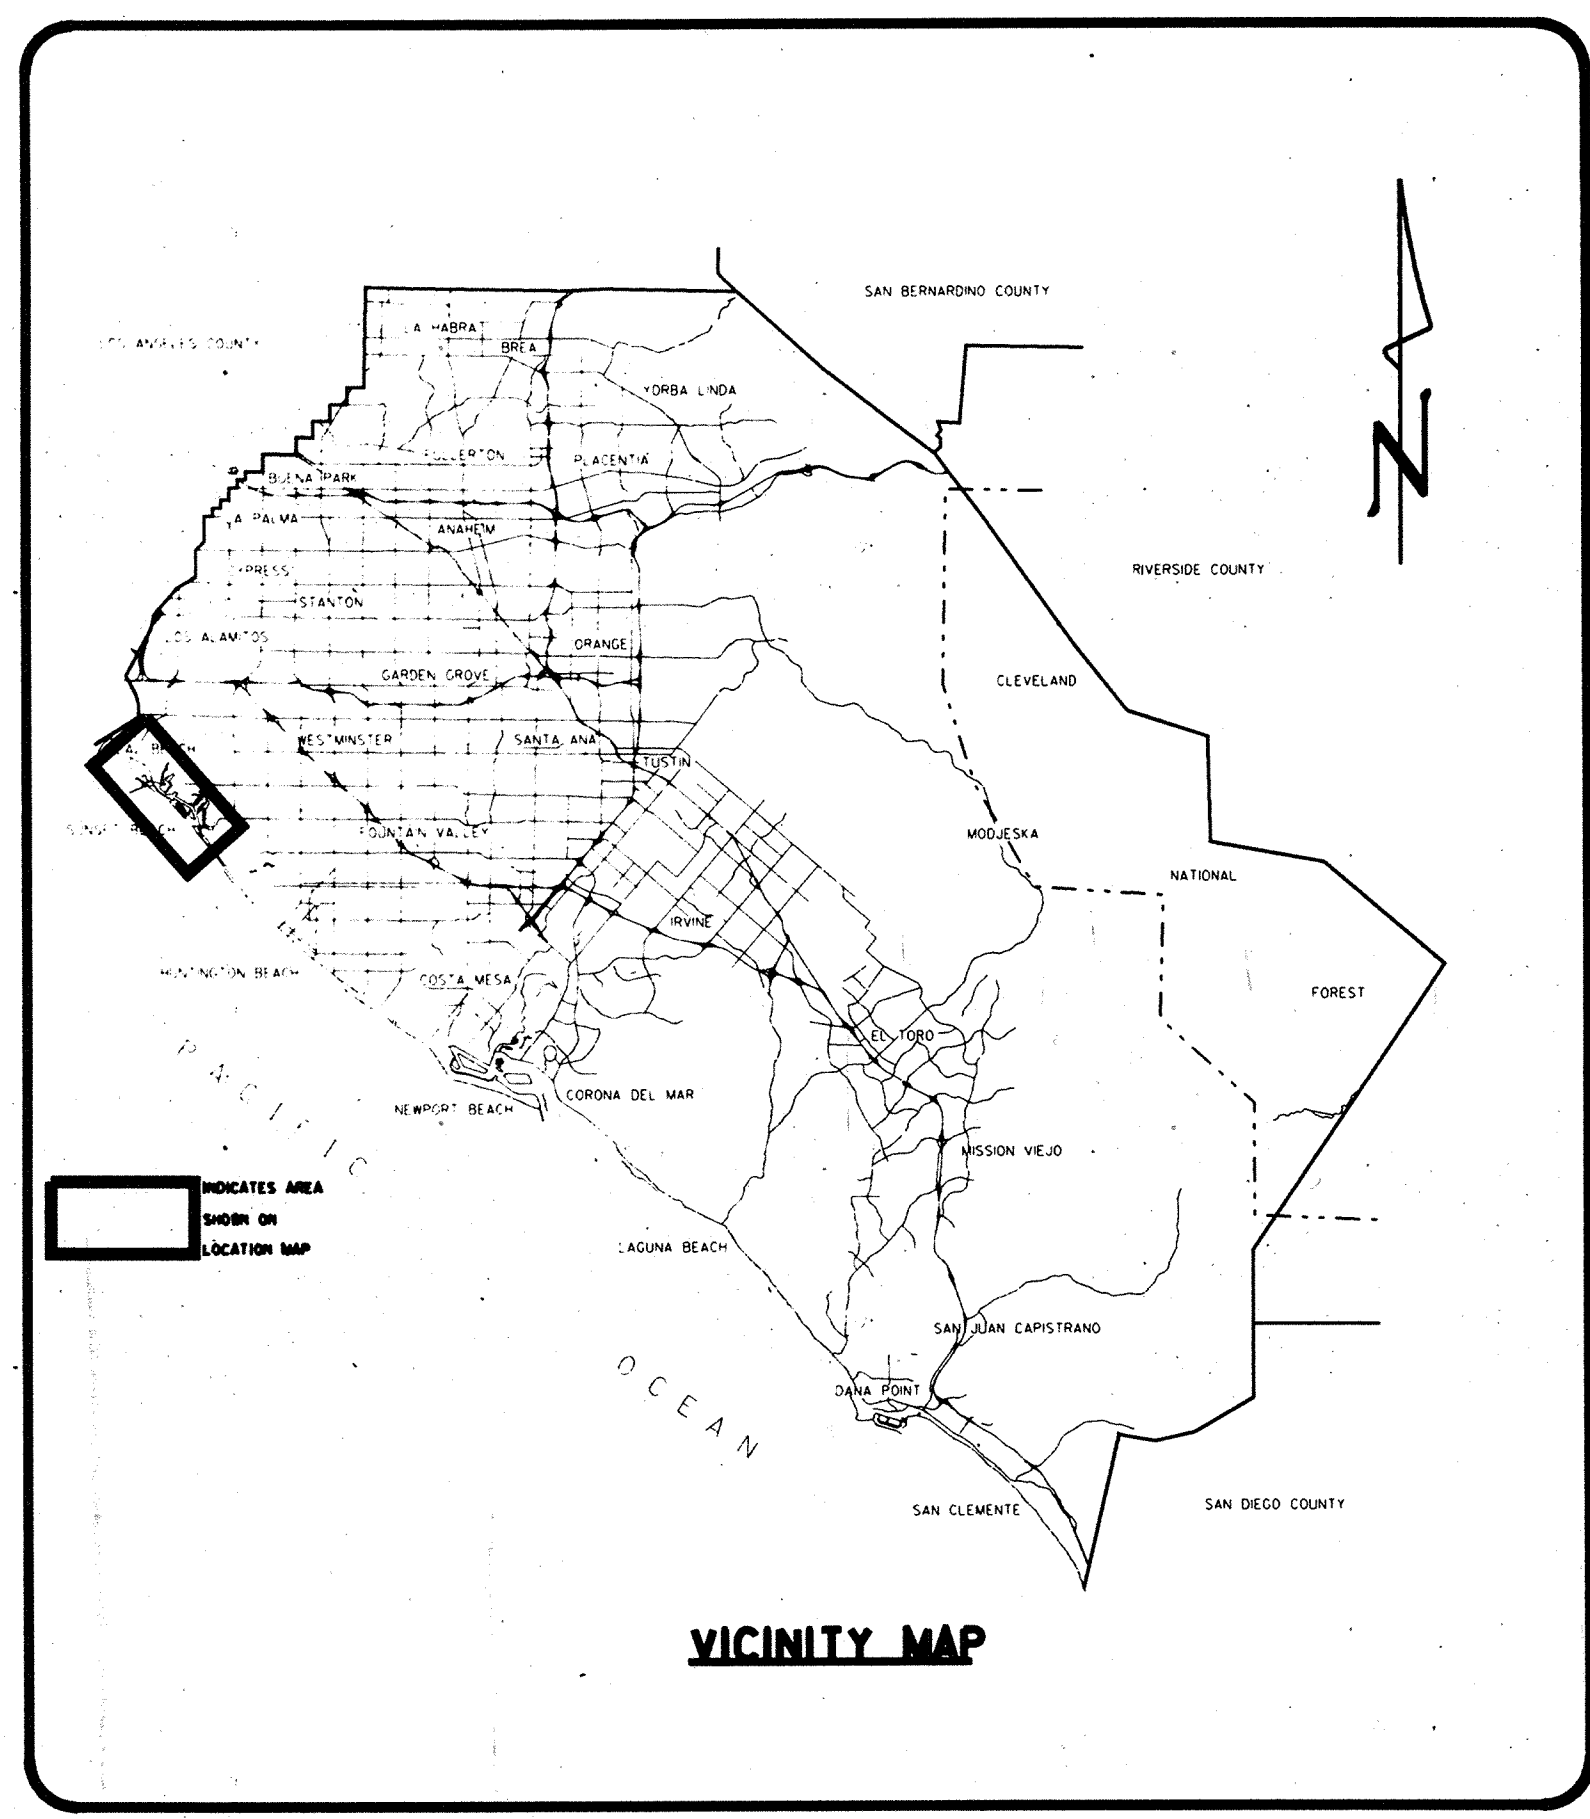

ORANGE COUNTY
ENVIRONMENTAL MANAGEMENT AGENCY
SANTA ANA, CALIFORNIA
MICHAEL M. RUANE, DIRECTOR
PLANS FOR CONSTRUCTION OF
DRAINAGE IMPROVEMENTS ON
PACIFIC COAST HIGHWAY
FROM
ANDERSON STREET
TO
WARNER AVENUE
APRIL 1994

FUNDED BY: COUNTY ROAD FUNDS

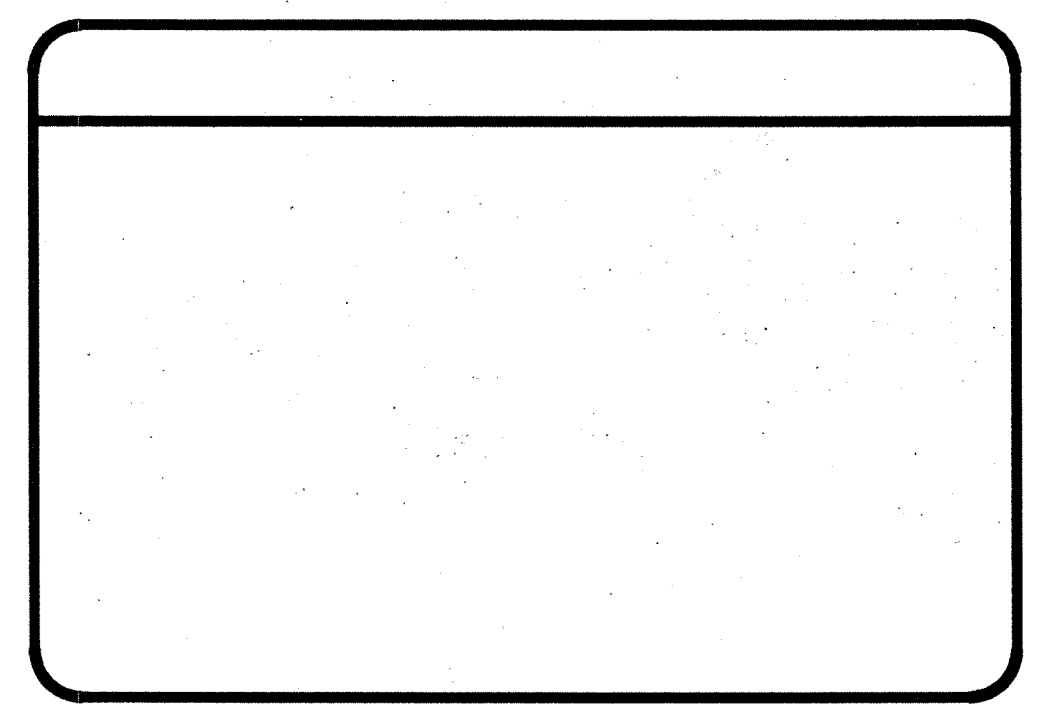

EMA - PUBLIC WORKS

SUBMITTED: *Edward K. [Signature]* ROAD DESIGN CHIEF DATE 3-28-94

RECOMMENDED: *James W. Williams* DESIGN DIVISION MAN DATE 3-28-94

APPROVED: *William L. Loun* DIRECTOR OF PUBLIC WORKS DATE 3-28-94

RECORD DRAWINGS

CONTRACTOR : ACCURATE CONSTRUCTION, INC.

INSPECTOR : MIKE FISHER

R.E. : STAN VANDER MEY

COMPLETION DATE : JULY 22, 1994

INDEX OF SHEETS	
SHEET	DESCRIPTION
1	TITLE SHEET
2	PLAN - Sta. 0+66.34 to Sta. 5+80
3	PLAN - Sta. 5+80 to Sta. 12+00
4	PLAN - Sta. 12+00 to Sta. 18+20
5	PLAN - Sta. 18+20 to Sta. 24+00
6	PLAN - Sta. 24+00 to Sta. 30+00
7	PLAN - Sta. 30+00 to Sta. 36+00
8	PLAN - Sta. 36+00 to Sta. 42+00
9	PLAN - Sta. 42+00 to Sta. 47+50
10	PLAN - Sta. 47+50 to Sta. 54+00
11	PLAN - Sta. 54+00 to Sta. 60+00
12	PLAN - Sta. 60+00 to Sta. 62+34.80

UTILITY OWNER	PHONE NO.	CONTACT
Southern Calif. Edison Co.	(714) 939-4736	Mark Melzner
The Gas Company	(714) 634-3114	Joe Moreno
General Telephone	(714) 373-2605	Daryl Bowden
Paragon Cable	(714) 895-6886x216	Mike Bogner
City of Huntington Beach/W	(714) 536-5527	Jeff Renno
City of Huntington Beach/S	(714) 536-5500	John VanHolle
Atlantic Richfield	(310) 499-2325	Rob Streed
Texaco Oil Co.	(805) 763-8261	Felipe Valenzuela
Underground Service Alert	1-800-422-4133	

BENCH MARK: IJ 59 83

Set in the So. part of the intersection of Anderson St. and N. Pacific Ave.; 10' S/W'y. of the centerline of Pacific Ave.; 53' S/E'y. of the centerline of Anderson St.; 0.5' N/W'y. of the S/E'y. BCR; set in the top of a conc. post, and level with the top of the curb.

Elev. 8.91 Adj. 1976

BASIS OF BEARINGS:

The bearing of the C of Pacific Coast Highway being S42°25'59"E at the intersection with Broadway Ave.

NO.	DESCRIPTION	SHT.	APPROVED	DATE
1	R/S sta. 33+01.62 to sta. 33+93.5			
2	30+95.29 to sta. 34+10.26 and Add add'l. improvements 1/3 sta. 6+04.87 to station 6+92.33	7		
3	Add add'l. improvements station 6+92.33	3		
4	Add new construction note	2		