


MATCHLINE 47+50

MATCHLINE 54+00


Pacific Coast Highway

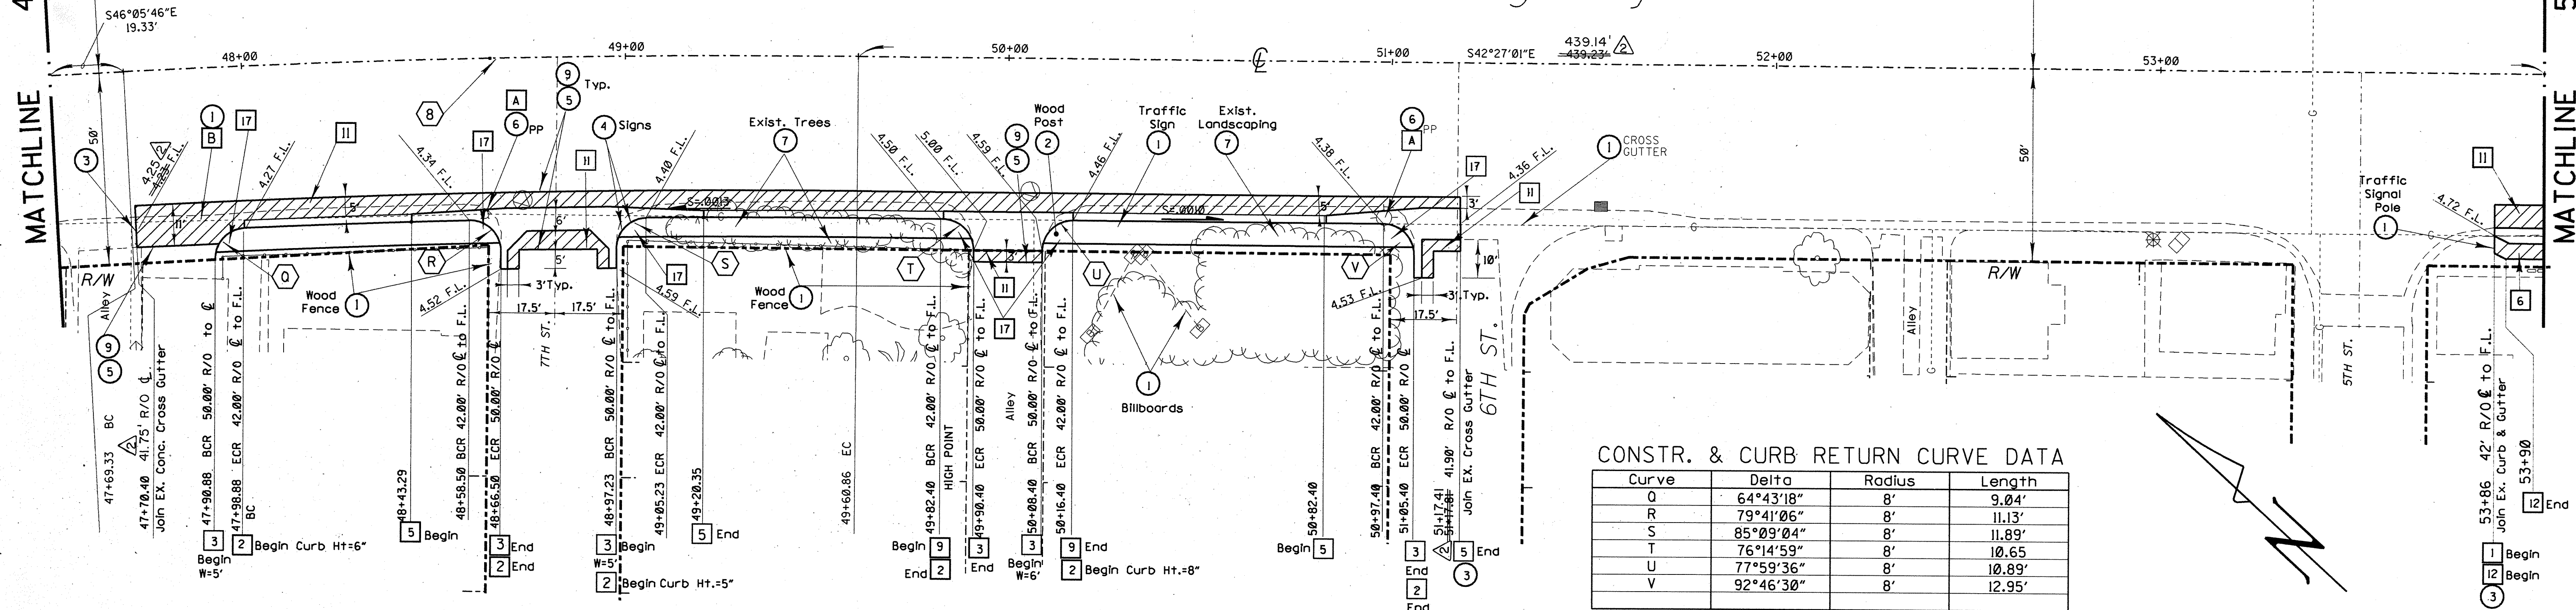

CONSTRUCTION NOTES

- 1 Construct concrete longitudinal gutter over 6" Class 2 A.B. per APWA Std. Plan No. 106-0 and typical section sheet 3.
- 2 Construct modified concrete curb and gutter (Type A2-8) over 6" Class 2 A.B. and per CalTrans Std. Plan No. A87 and typical section sheet 3.
- 3 Construct 4" thick P.C.C. sidewalk over 4" Class 4 (Sand) and per EMA Std. Plan No. 1205 and typical section sheet 3.
- 5 Construct P.C.C. cross gutter over 6" Class 2 A.B. and per APWA Std. Plan 106-0.
- 6 Furnish and place 0.3' AC/NS; compact native soil to 95% RC.
- 9 Construct concrete alley intersection over 6" Class 2 A.B. and per APWA Std. Plan No. 100-0.
- 11 Remove existing AC/AB to a depth of 0.8'; recompact AB to 95% R.C. and furnish and place 0.8' AC over recompact AB or 95% R.C. Native Soil.
- 12 Construct P.C.C. longitudinal gutter transition over 6" Class 2 A.B. and per detail sheet 7.
- 17 Construct modified P.C.C. curb ramp per CalTrans Std. Plan No. NSP A88 and Detail B sheet 8.

A.C. PLACEMENT LIMITS

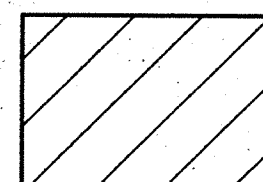

CONSTR. & CURB RETURN CURVE DATA

Curve	Delta	Radius	Length
O	64°43'18"	8'	9.04'
R	79°41'06"	8'	11.13'
S	85°09'04"	8'	11.89'
T	76°14'59"	8'	10.65'
U	77°59'36"	8'	10.89'
V	92°46'30"	8'	12.95'

CURVE DATA

Δ=3°38'45"
R=3010.00'
L=191.53'

LEGEND

- 1 Protect in place
- 2 Remove
- 3 Join and match exist. flowline
- 4 Relocate per plan
- 5 Sawcut
- 6 To be relocated by others
- 7 Remove interfering portions
- 8 Match existing to drain to street
- 9 Match existing
- 10 Adjust to grade
- 11 Adjust height of prop. curbface as required to match elevation of existing sidewalk/access ramp or driveway.
- 12 Feather A.C. to match T.C.
- 13 Place concrete to fill gap per sidewalk standards.
- 14 Adjust to grade by others
- 15 Match curve of exist. curb return

UTILITIES

- A Power Poles/Lines
- B Gas Line
- C Telephone Line
- D Cable TV Line
- E Water Line
- F Sewer Line

OWNER

- Southern Calif. Edison Co.
- The Gas Company
- General Telephone
- Paragon Cable
- City of Huntington Beach
- City of Huntington Beach

RECORD DRAWING

1/2 0 2
3 inches on original drawing

BENCH MARK: IJ 59 83

Set in the So. part of the intersection of Anderson St. and N. Pacific Ave., 10' S/Wly. of the centerline of Pacific Ave., 53' S/Ely. of the centerline of Anderson St., 0.5' N/Wly. of the S/Ely. BCR, set in the top of a conc. post, and level with the top of the curb.

Elev. 8.91

Adj. 1976

5-02 RECORD DRAWINGS.		ORANGE COUNTY ENVIRONMENTAL MANAGEMENT AGENCY	
MARK	DATE	DESCRIPTION	
REVIEWED BY: A. BRINE			
DESIGNED: A. BRINE			
DRAWN: SC			
CHECKED: TM			
SCALE: AS SHOWN			
DATE: APR 1994			
DRAWING NO. 10			
SHEET OF 12			