
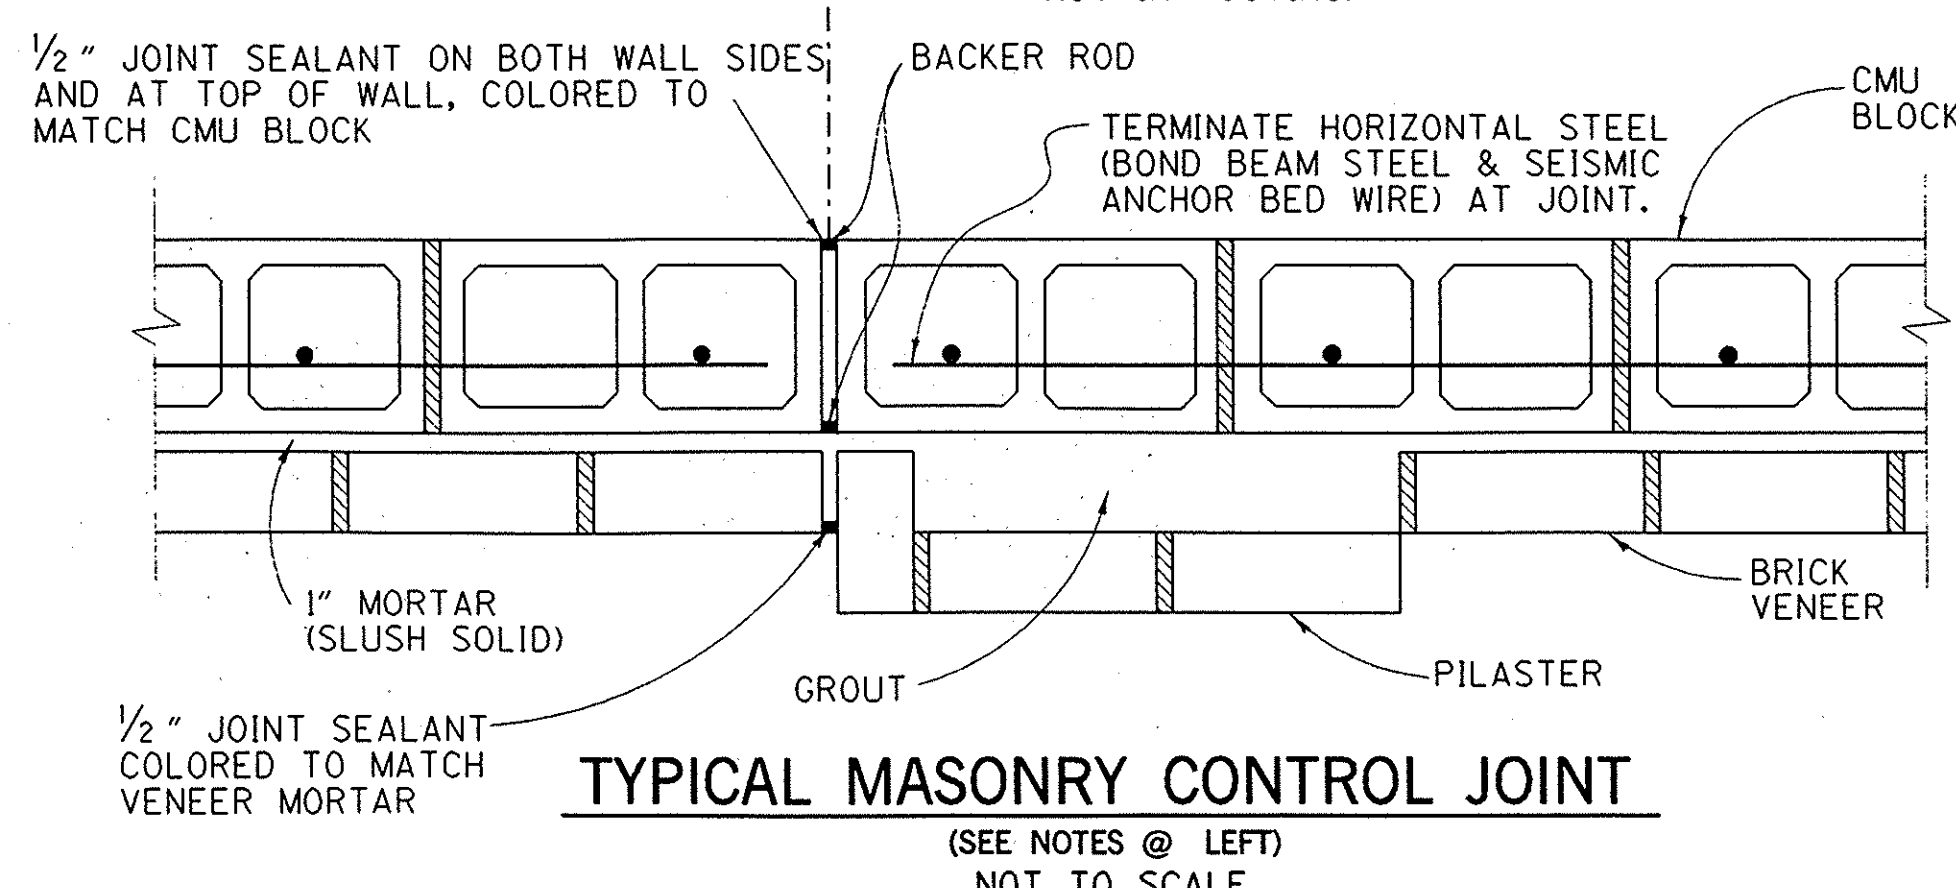
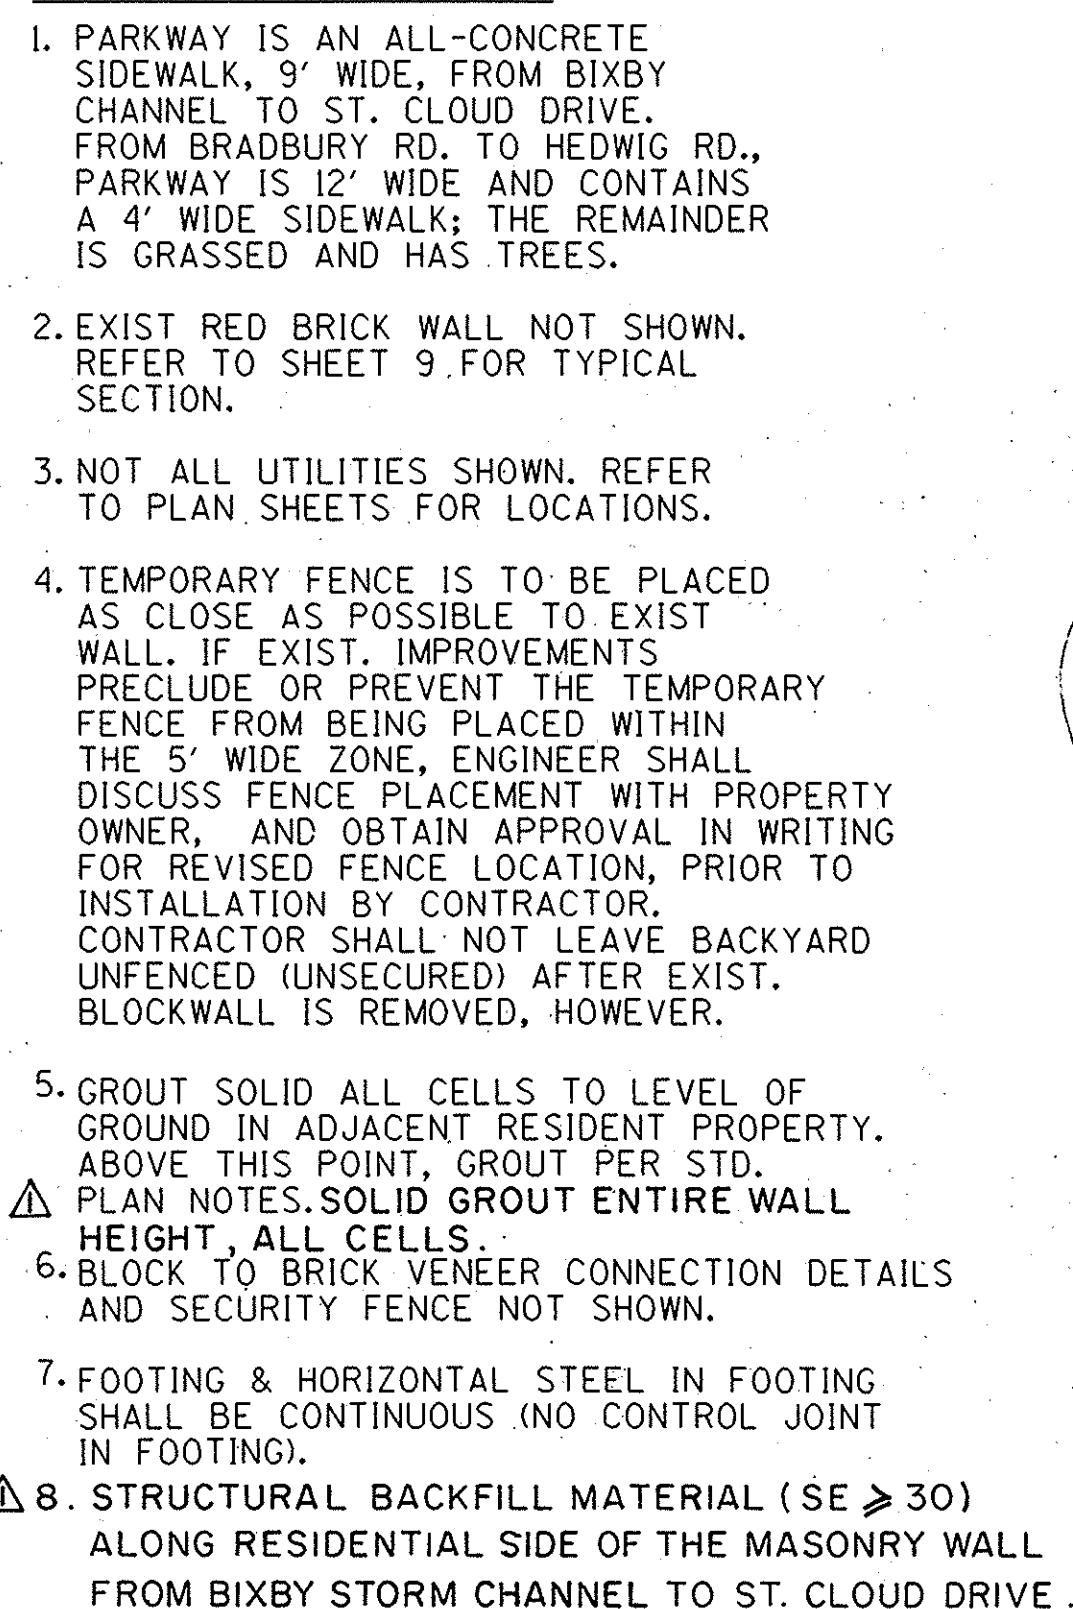


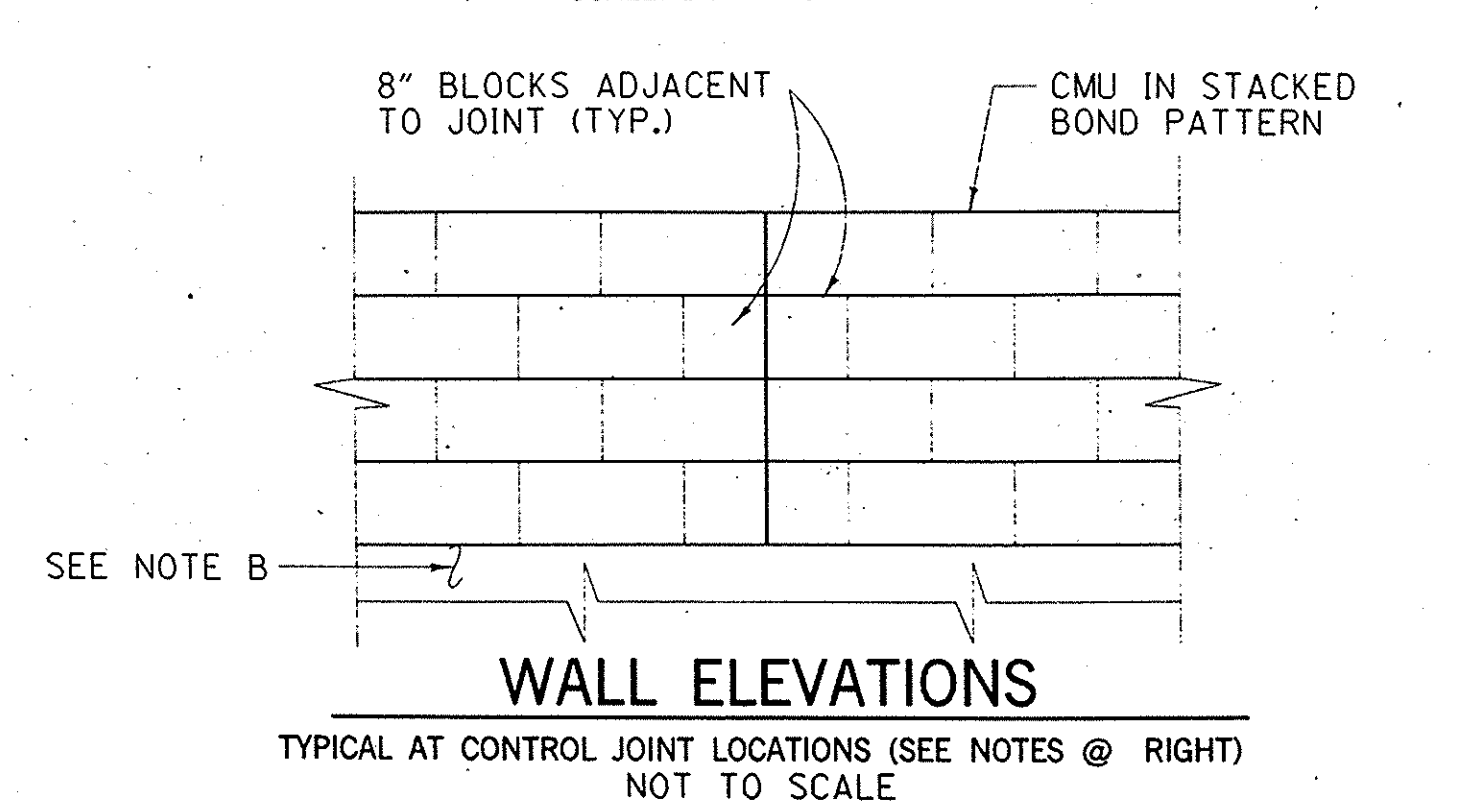

- ① PROTECT IN PLACE
- ② REMOVE
- ④ SAWCUT/JOIN
- ⑦ REMOVE INTERFERING PORTIONS
- ⑪ REMOVE AND SALVAGE

	4-00	RECORD DRAWINGS .
MARK	DATE	DESCRIPTION
REVISIONS		
PREPARED UNDER SUPERVISION OF <i>T. Rignon</i> TED RIGNON		

ROSSMOOR
SIGNATURE
WALL

TYPICAL SECTION
AND
GENERAL DETAILS

DESIGNED T. RIGNON	
DRAWN AHP/M.D.	CHECKED E. KWAN
SCALE	DATE
AS SHOWN	DRAWING NO. ER02792

2

OF 1