


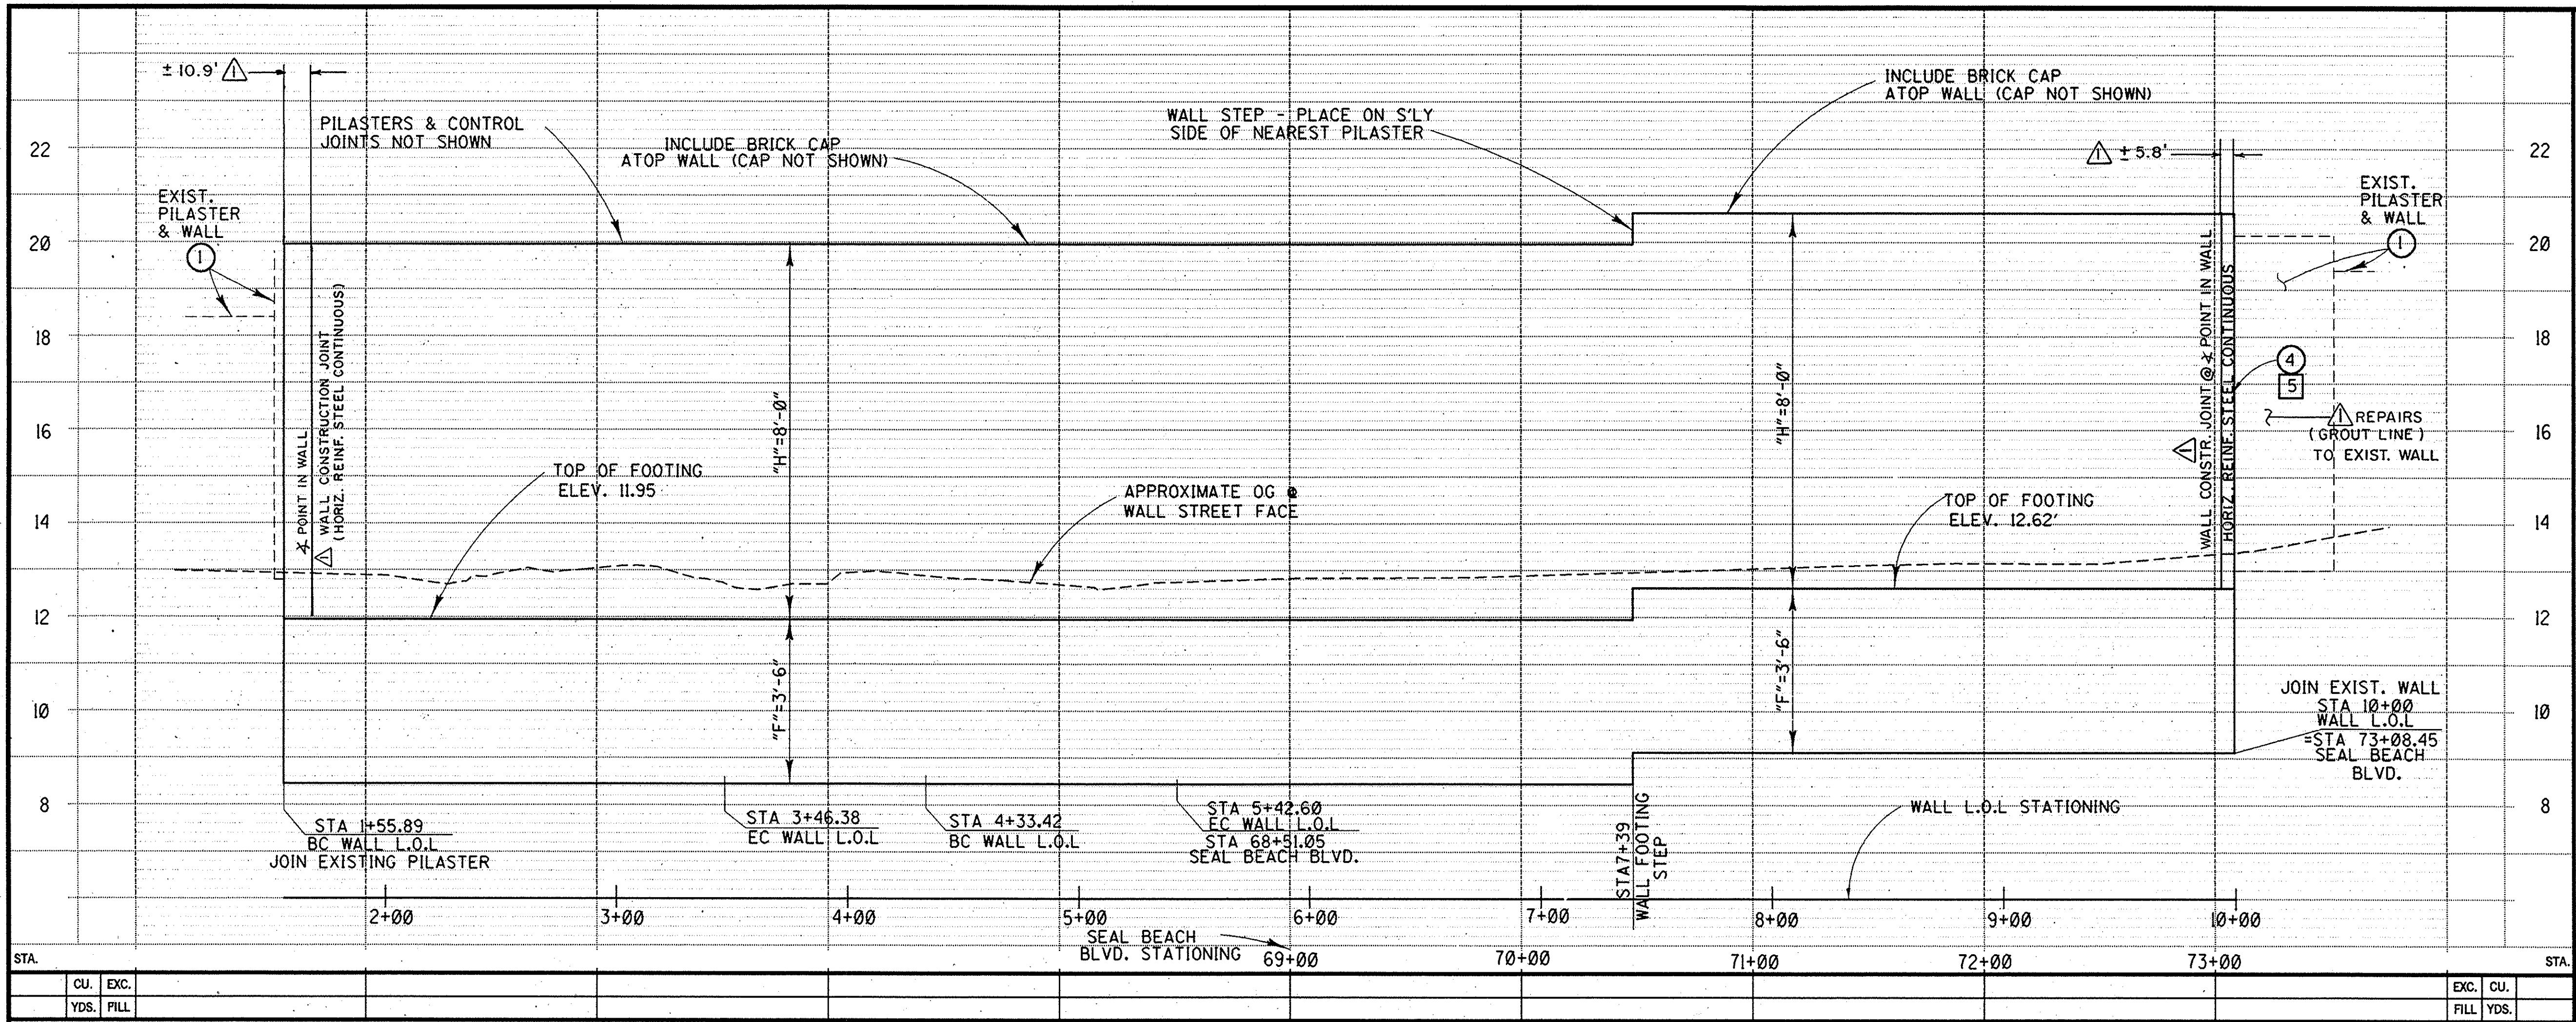

- CONSTRUCTION NOTES**
- CONSTRUCT CONCRETE MASONRY BLOCK/RED BRICK VENEER WALL PER MODIFIED APWA STD. PLAN 601-0, TYPE 3, AND PLANS, DETAILS AND SPECIAL PROVISIONS.
 - INSTALL TEMPORARY SECURITY FENCE PER PLAN, DETAILS AND SPECIAL PROVISIONS.
 - CONSTRUCT PCC SIDEWALK, WIDTH AND LIMITS PER PLAN & PFRD STANDARD PLAN 1205 AND DETAILS SHEET 9.
 - INSTALL PROJECT INFORMATION SIGN PER PFRD STANDARD PLAN 1418, PLAN AND SPECIAL PROVISIONS.
 - DRILL AND BOND DOWELS PER DETAILS AND SPECIAL PROVISIONS.
 - BACKFILL WITH PERMEABLE SOIL (SE ≥ 30)

NOTE:

CONTRACTOR SHALL LIMIT HIS WORK ACTIVITIES TO THE GREATEST EXTENT POSSIBLE WITHIN THE RIGHT OF ENTRY AREA DELINEATED BY THE TEMPORARY SECURITY FENCE. CONTRACTOR IS TO REPLACE OR REPAIR ANY RESIDENT IMPROVEMENTS DAMAGED BY HIS OPERATIONS, AT HIS SOLE COST, TO THE SATISFACTION OF THE ENGINEER.


UTILITIES

- A SOUTHERN CALIFORNIA EDISON
- B TIME WARNER COMMUNICATIONS
- C SOUTHERN CALIFORNIA WATER COMPANY
- D SOUTHERN CALIFORNIA GAS
- E ORANGE COUNTY SANITATION DISTRICT
- F CITY OF LOS ALAMITOS
- G CITY OF SEAL BEACH
- H COMCAST CABLEVISION
- I GTE CALIFORNIA
- J NEXTLINK

LEGEND

- ① PROTECT IN PLACE
- ② REMOVE
- ④ SAWCUT/ JOIN
- ⑥ TO BE RELOCATED BY OTHERS
- ⑦ REMOVE INTERFERING PORTIONS
- ⑨ GRADE TO DRAIN
- ⑪ REMOVE AND SALVAGE

NOTE: NOT ALL STREET UTILITIES PLOTTED.

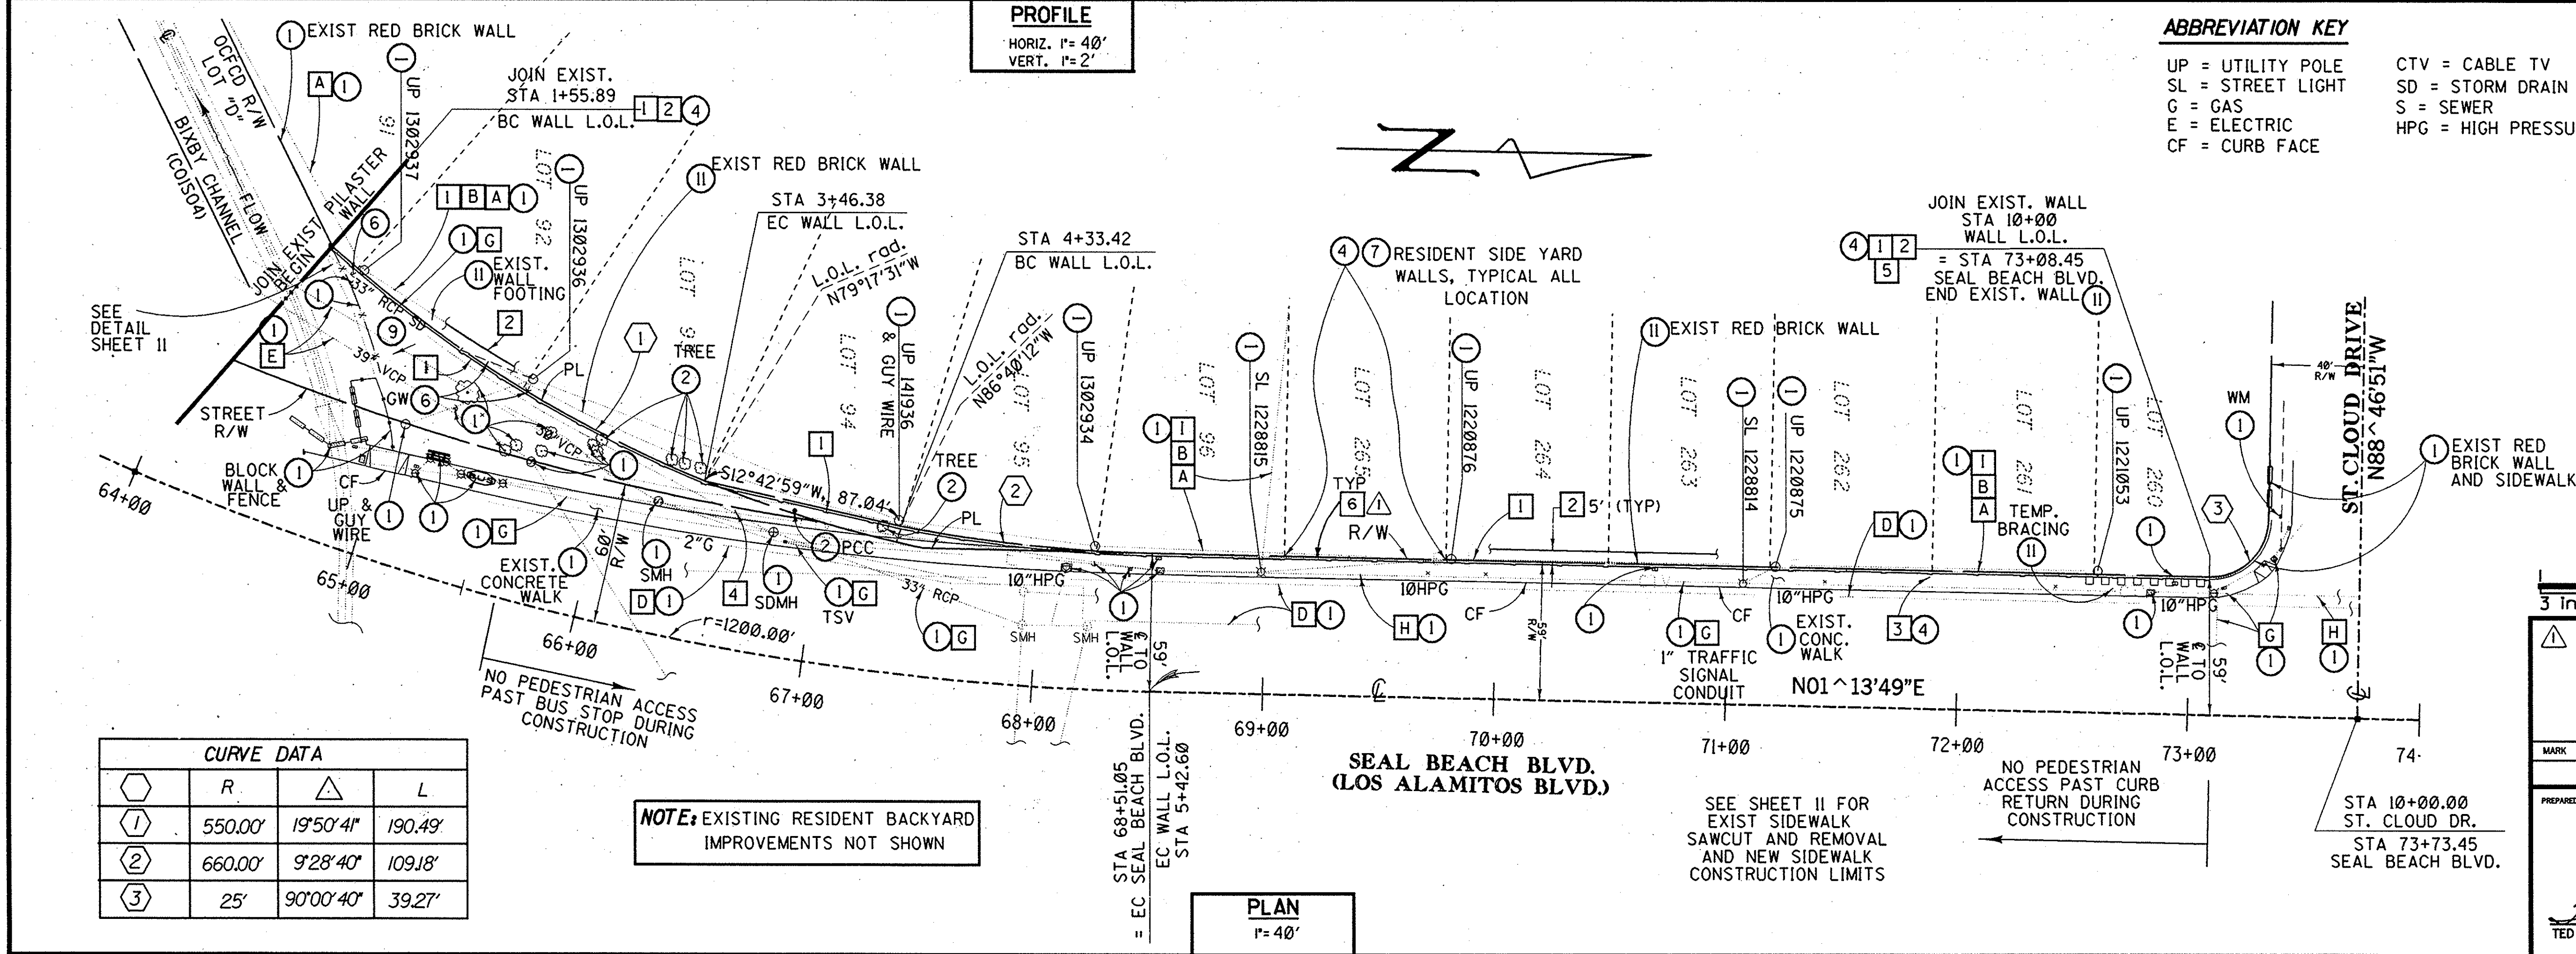

CURVE DATA			
R	Δ	L	
① 550.00'	19°50'41"	190.49'	
② 660.00'	9°28'40"	109.18'	
③ 25'	90°00'40"	39.27'	

NOTE: EXISTING RESIDENT BACKYARD IMPROVEMENTS NOT SHOWN

PLAN

1" = 40'

ABBREVIATION KEY

- UP = UTILITY POLE
- SL = STREET LIGHT
- G = GAS
- E = ELECTRIC
- CF = CURB FACE
- CTV = CABLE TV
- SD = STORM DRAIN
- S = SEWER
- HPG = HIGH PRESSURE GAS

ORANGE COUNTY
PUBLIC FACILITIES & RESOURCES DEPARTMENT

ROSSMOOR SIGNATURE WALL

PLAN AND PROFILE

DESIGNED: T. RIGONI
DRAWN: ANISA POPAL
CHECKED: E. KWAN

SCALE: AS SHOWN
DATE: 3/16/98
DRAWING NO.: ER02792

SHEET 3 OF 12