


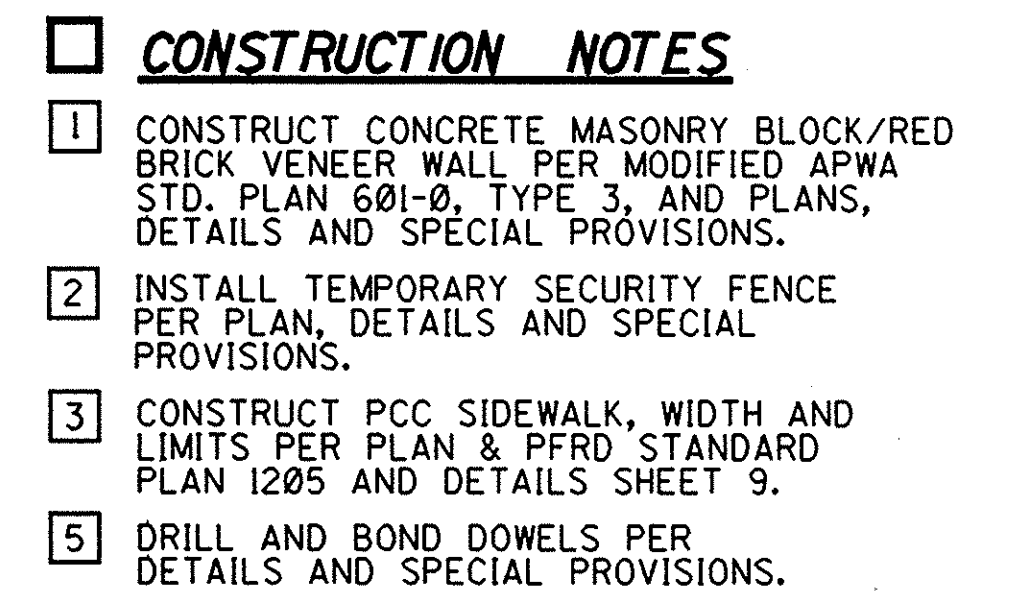


CONTRACTOR SHALL LIMIT HIS WORK ACTIVITIES TO THE GREATEST EXTENT POSSIBLE WITHIN THE RIGHT OF ENTRY AREA DELINEATED BY THE TEMPORARY SECURITY FENCE. CONTRACTOR IS TO REPLACE OR REPAIR ANY RESIDENT IMPROVEMENTS DAMAGED BY HIS OPERATIONS, AT HIS SOLE COST, TO THE SATISFACTION OF THE ENGINEER.

A	SOUTHERN CALIFORNIA EDISON
B	TIME WARNER COMMUNICATIONS
C	SOUTHERN CALIFORNIA WATER COMPANY
D	SOUTHERN CALIFORNIA GAS
E	ORANGE COUNTY SANITATION DISTRICT
F	CITY OF LOS ALAMITOS
I	GTE CALIFORNIA

- ① PROTECT IN PLACE
- ② REMOVE
- ④ SAWCUT/ JOIN
- ⑦ REMOVE INTERFERING PORTIONS
- ⑪ REMOVE AND SALVAGE

3 inches on original drawing

	4-00	RECORD DRAWINGS
MARK	DATE	DESCRIPTION
REVISIONS		
PREPARED UNDER RESPONSIBLE CHARGE OF:		

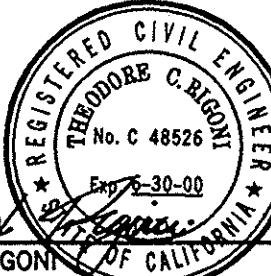

Theodore C. Gibson

TED RIGON

3/16/98

DATE

ORANGE COUNTY PUBLIC FACILITIES & RESOURCES DEPARTMENT			
ROSSMOOR SIGNATURE WALL			
PLAN AND PROFILE			
DESIGNED <u>T. RIGONI</u>		SHEET	
DRAWN <u>A. POPAL</u>		4	
CHECKED <u>F. KWAN</u>		ERO2792	
SCALE AS SHOWN	DATE	DRAWING NO. ERO2792	
		OF 12	