



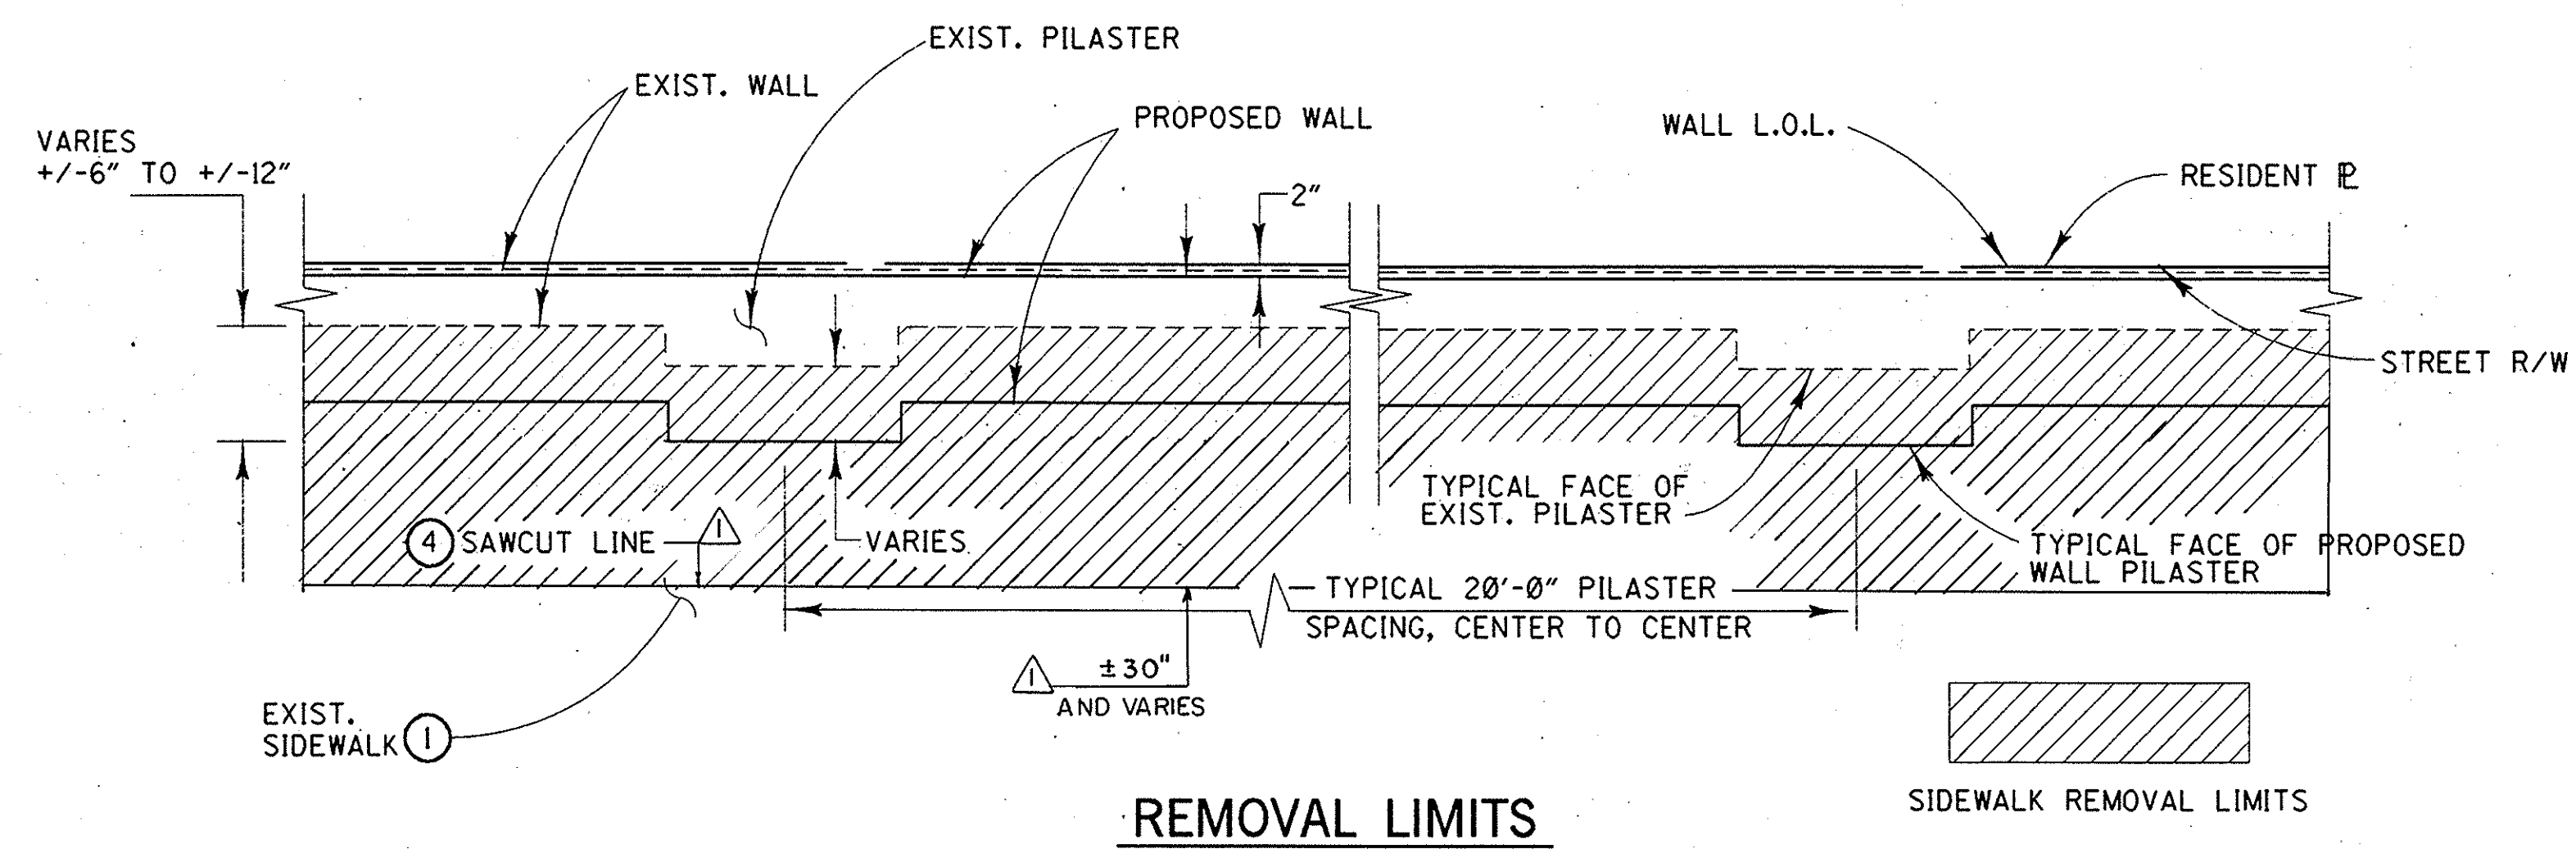


REMOVAL LIMITS

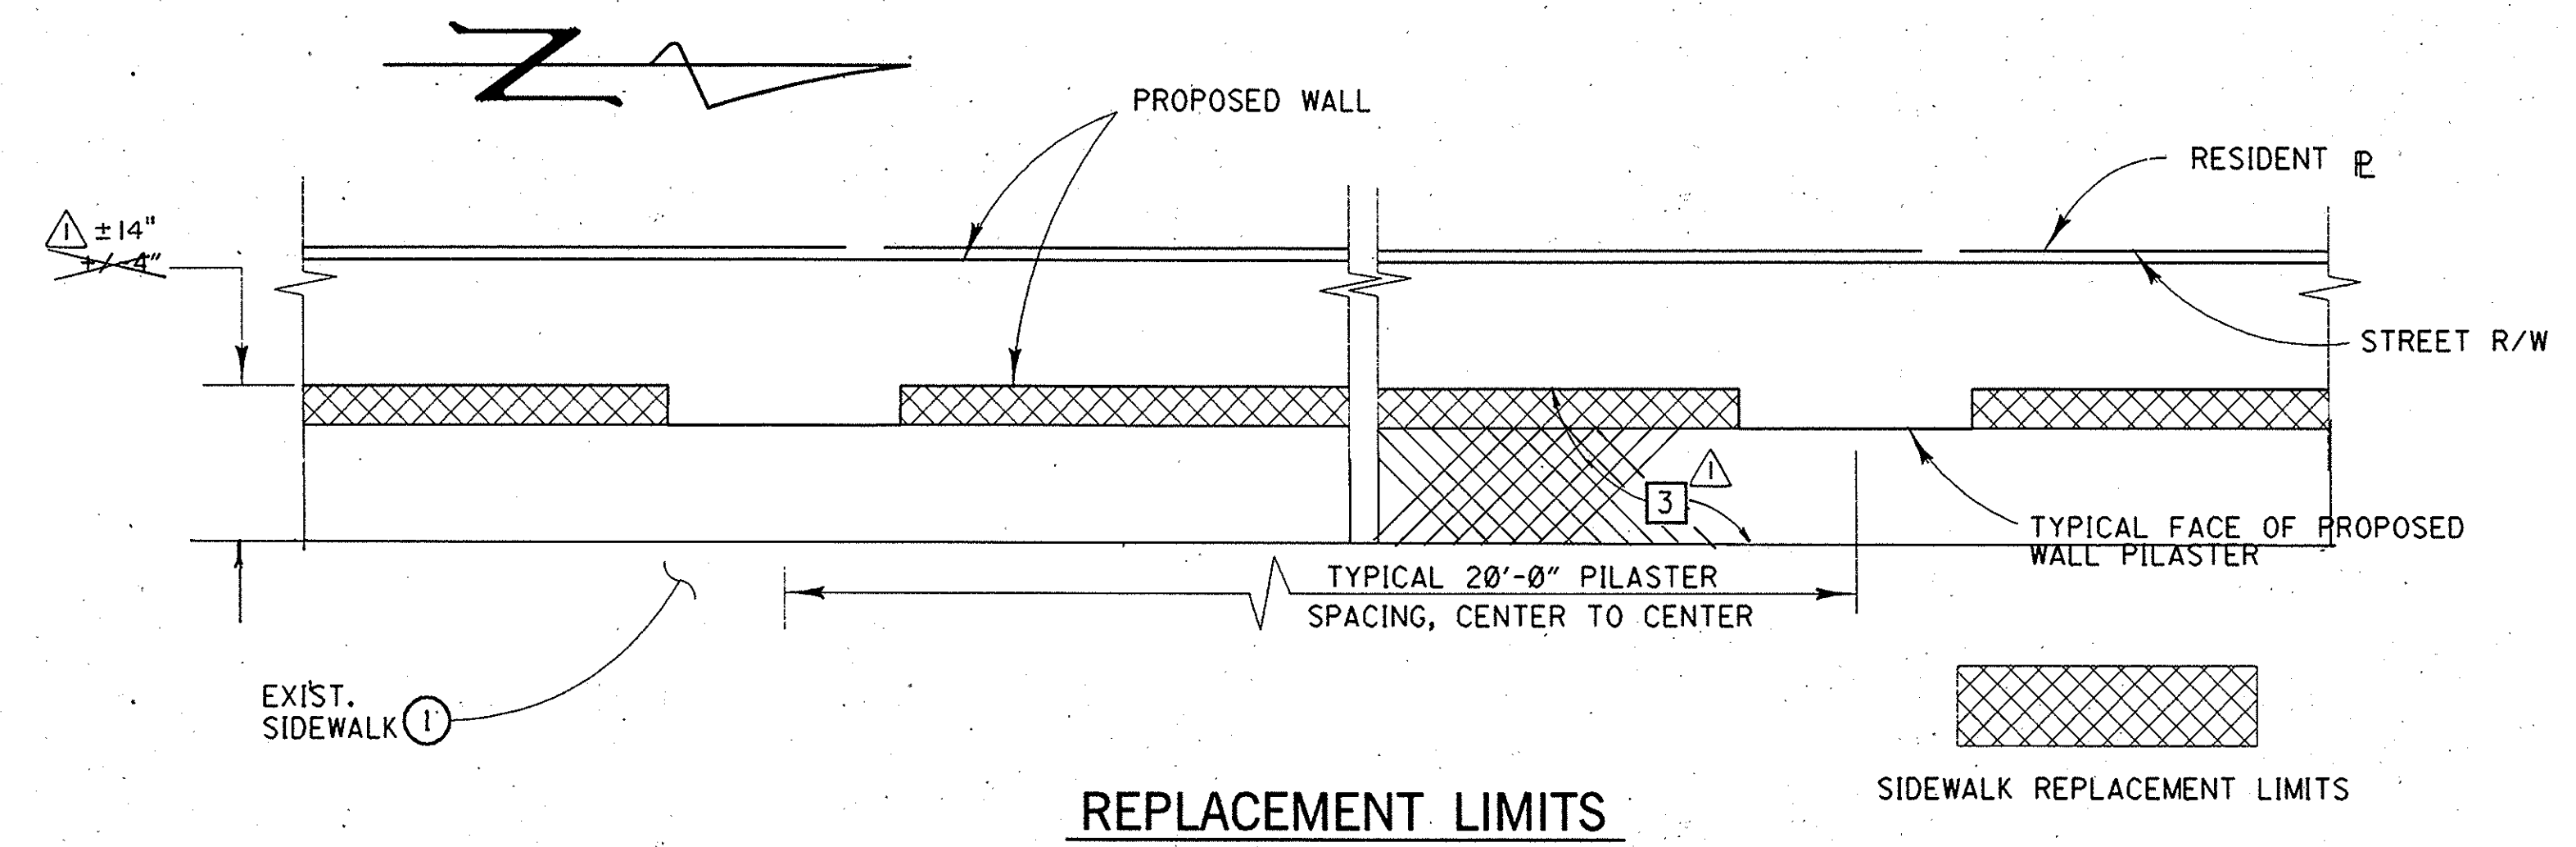

REPLACEMENT LIMITS


**PLAN - TYPICAL SIDEWALK REMOVAL & REPLACEMENT LIMITS
(BETWEEN BIXBY CHANNEL AND ST. CLOUD DRIVE)**

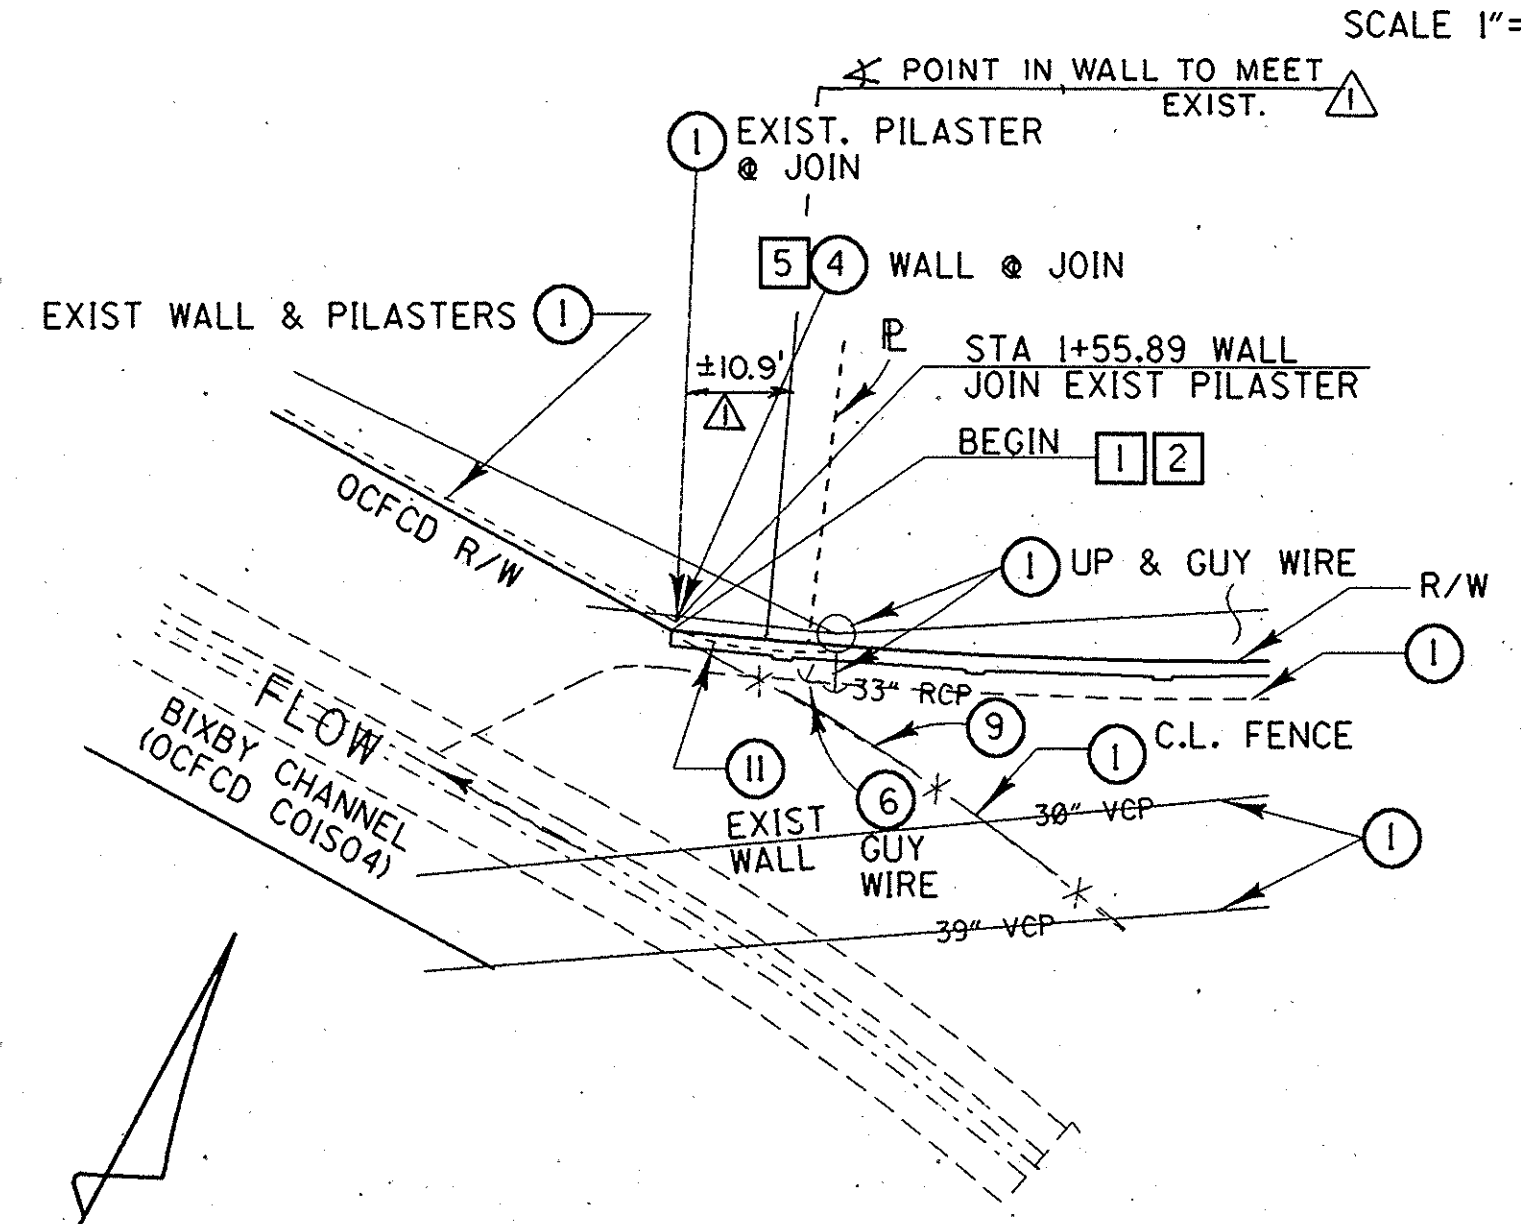

DETAIL

WALL JOIN @ BIXBY CHANNEL

SCALE 1"=20'-0"

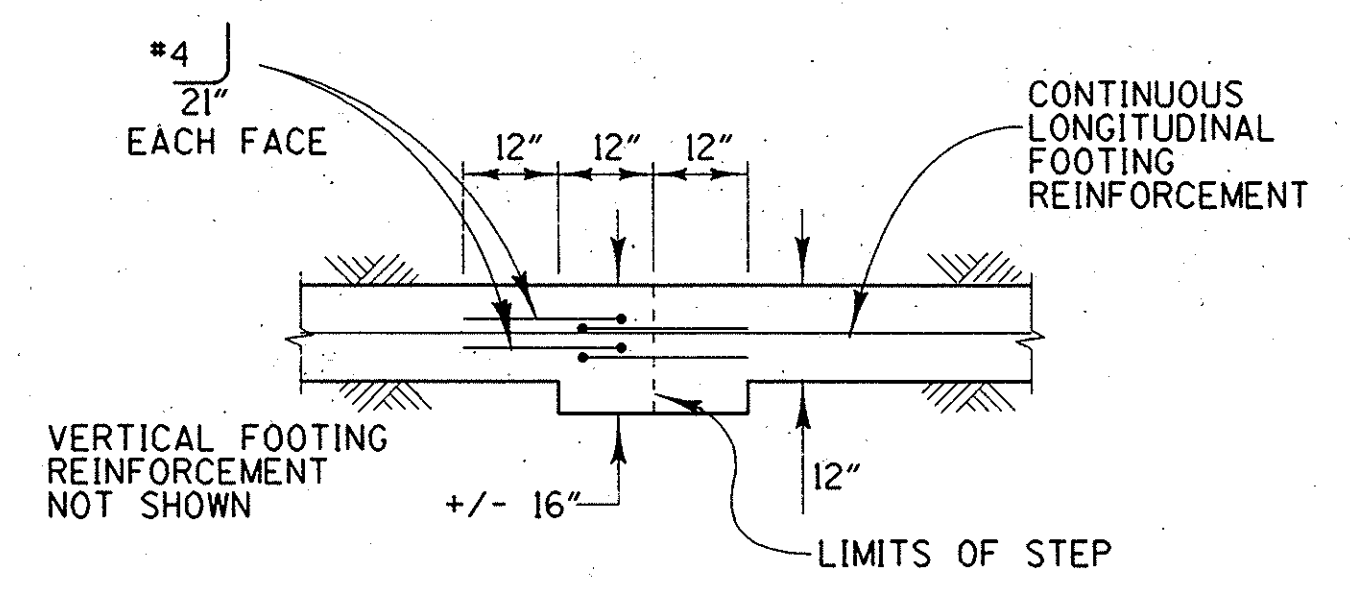

SECTION A-A

FOOTING STEP DETAIL @ PILASTER


SCALE 1"=2'-0"

NOTE:

CONTRACTOR SHALL LIMIT HIS WORK ACTIVITIES TO THE GREATEST EXTENT POSSIBLE WITHIN THE RIGHT OF ENTRY AREA DELINEATED BY THE TEMPORARY SECURITY FENCE. CONTRACTOR IS TO REPLACE OR REPAIR ANY RESIDENT IMPROVEMENTS DAMAGED BY HIS OPERATIONS, AT HIS SOLE COST, TO THE SATISFACTION OF THE ENGINEER.


NOTE:

* TYPICAL FOOTING STEP HEIGHT = 8". FOOTING STEP DETAILS OF WALL @ ROSSMOOR CHANNEL ARE ON SHEET 10.

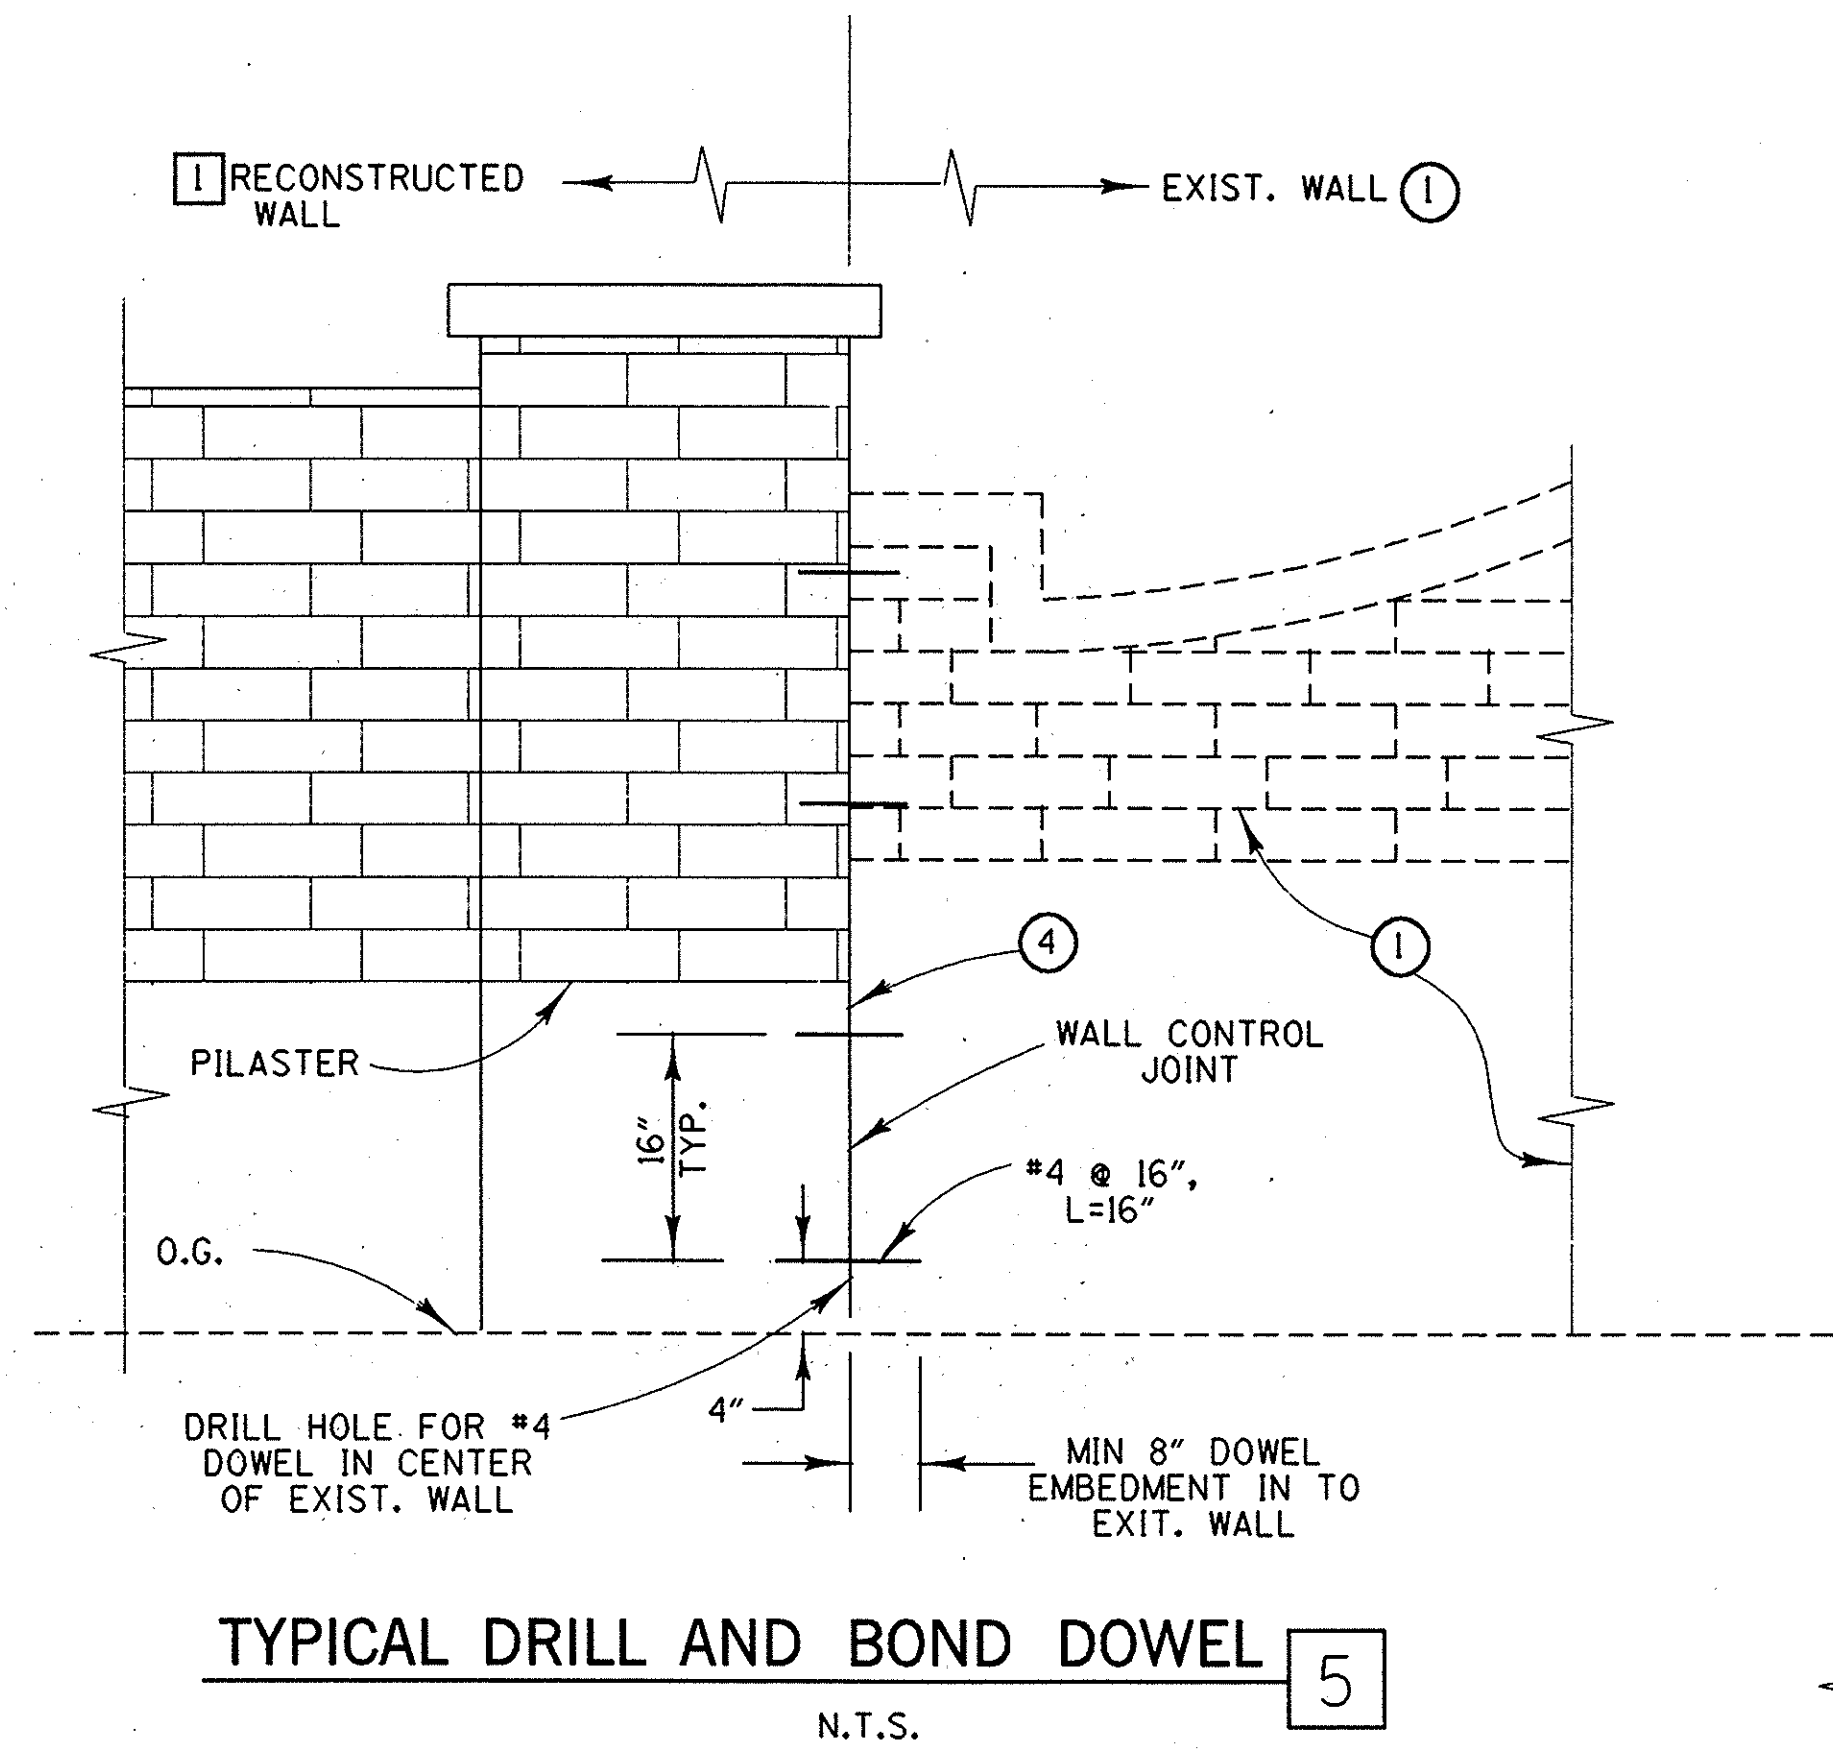

TYPICAL DRILL AND BOND DOWEL


N.T.S.

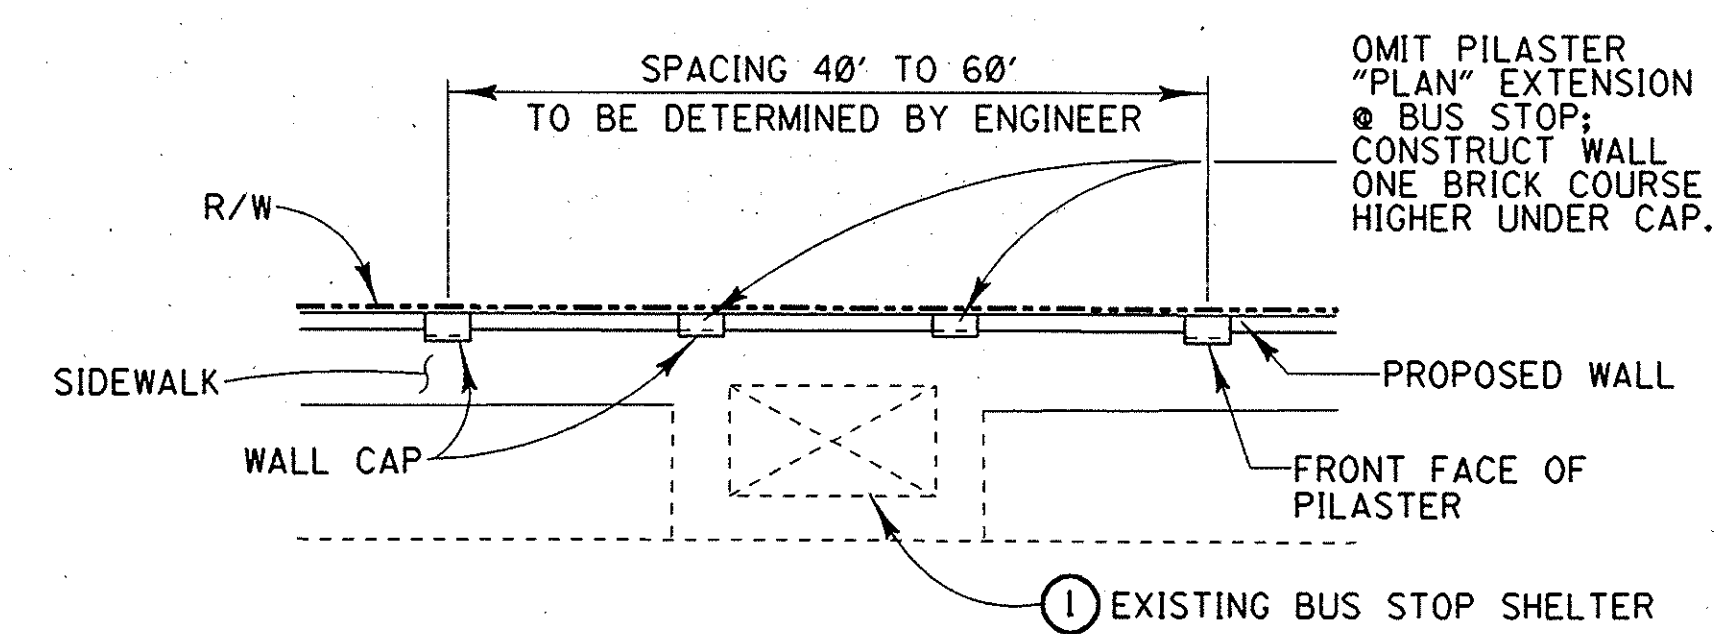

PLAN

PILASTER DETAIL @ BUS STOP

NOT TO SCALE

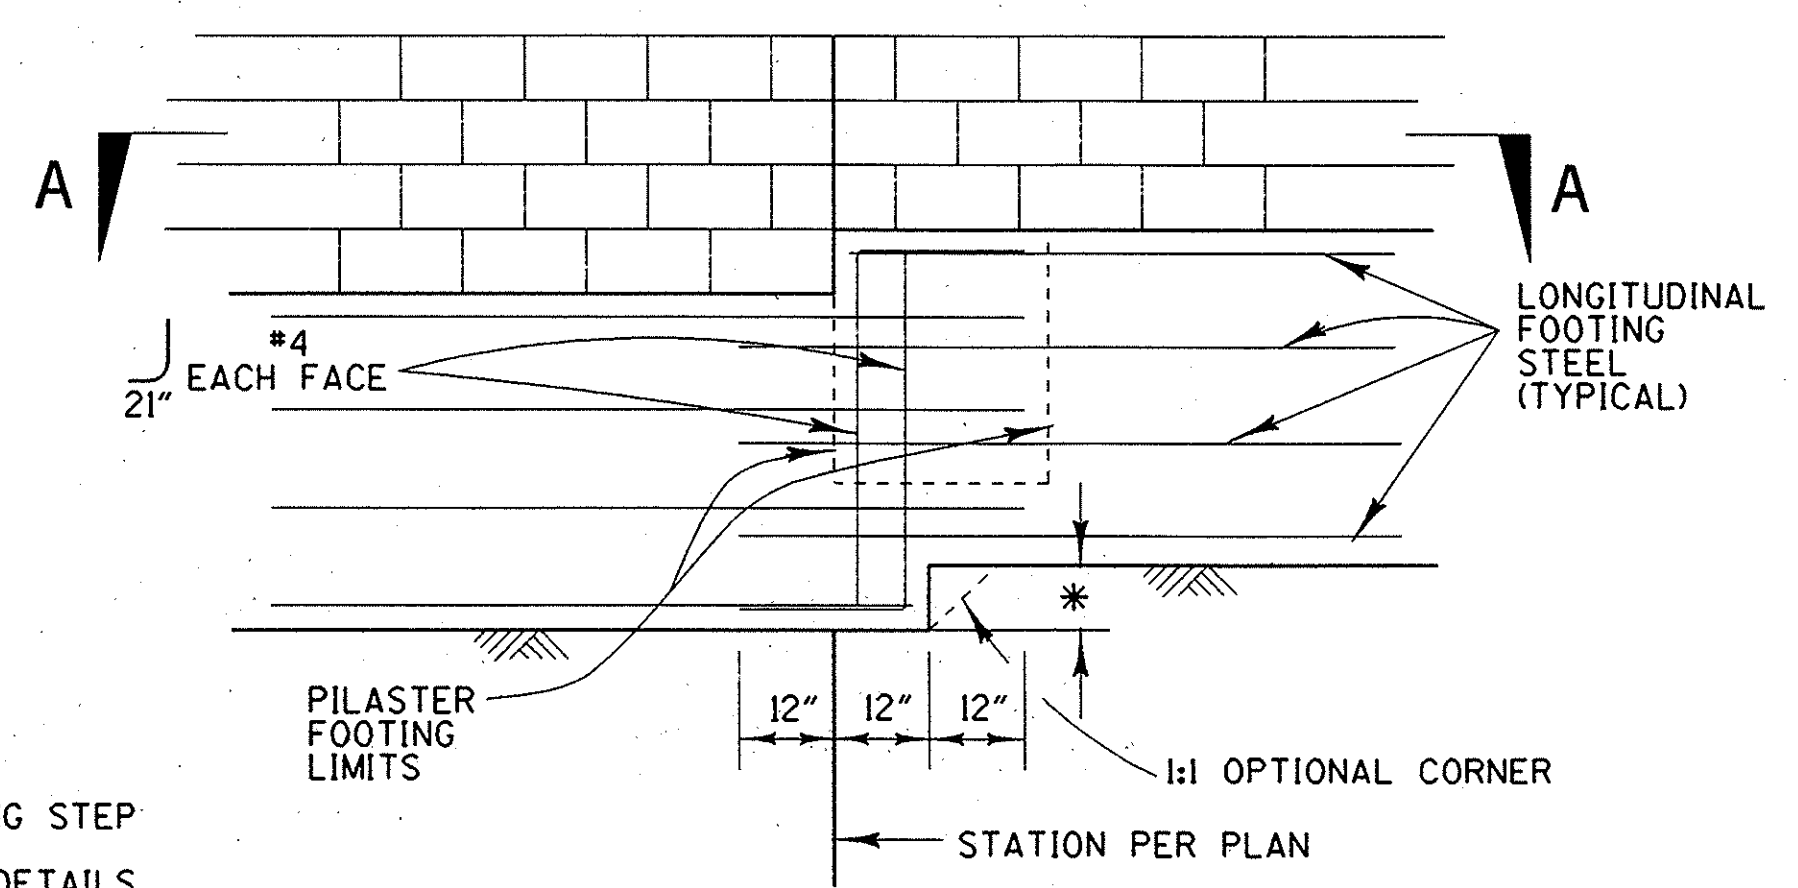

FOOTING STEP DETAIL


SCALE 1"=2'-0"

CONSTRUCTION NOTES

- 1 CONSTRUCT CONCRETE MASONRY BLOCK/RED BRICK VENEER WALL PER MODIFIED APWA STD. PLAN 601-0, TYPE 3, PLANS, DETAILS AND SPECIAL PROVISIONS.
- 2 INSTALL TEMPORARY SECURITY FENCE PER PLAN, DETAILS AND SPECIAL PROVISIONS.
- 3 CONSTRUCT PCC SIDEWALK, WIDTH AND LIMITS PER PLAN, PER PFRD STANDARD PLAN 1205, AND DETAILS SHEET9.
- 5 DRILL AND BOND DOWELS PER DETAILS AND SPECIAL PROVISIONS.


LEGEND

- 1 PROTECT IN PLACE
- 2 REMOVE
- 4 SAWCUT/ JOIN
- 6 TO BE RELOCATED BY OTHERS
- 7 REMOVE INTERFERING PORTIONS
- 9 GRADE TO DRAIN
- 11 REMOVE AND SALVAGE

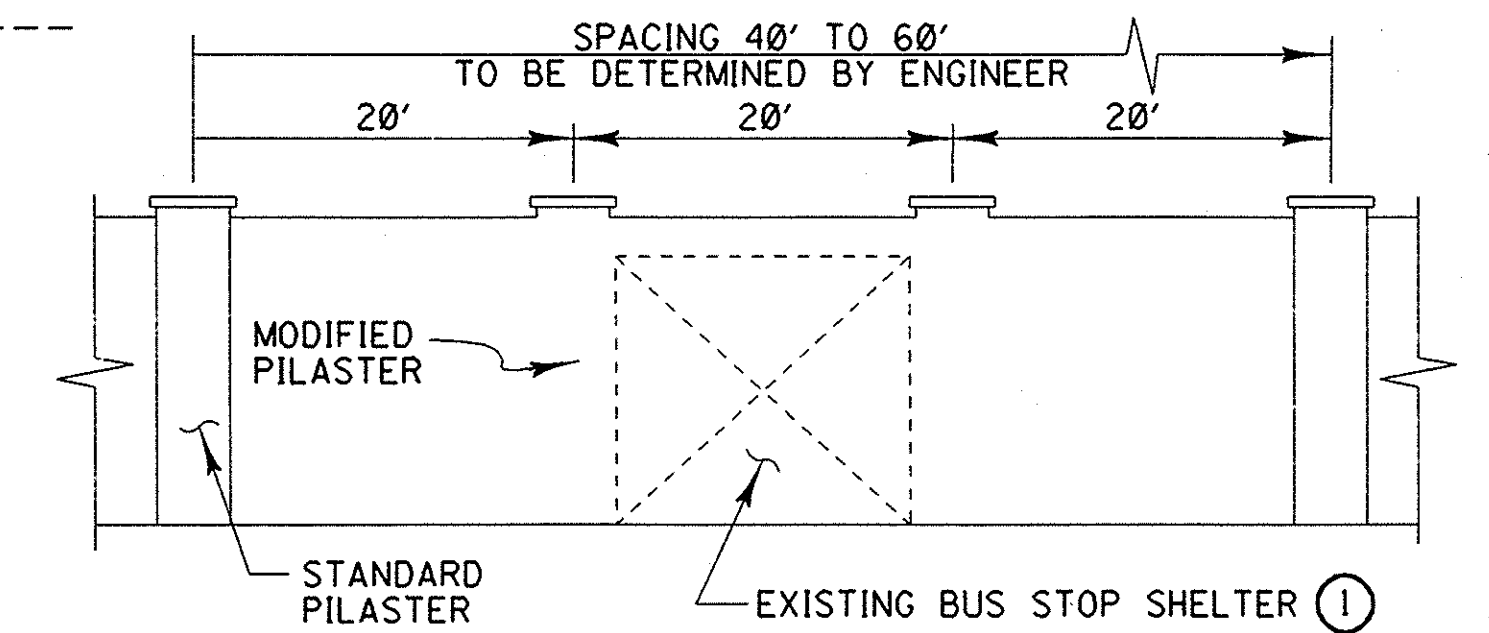

ELEVATION

*** PILASTER DETAIL @ BUS STOP**

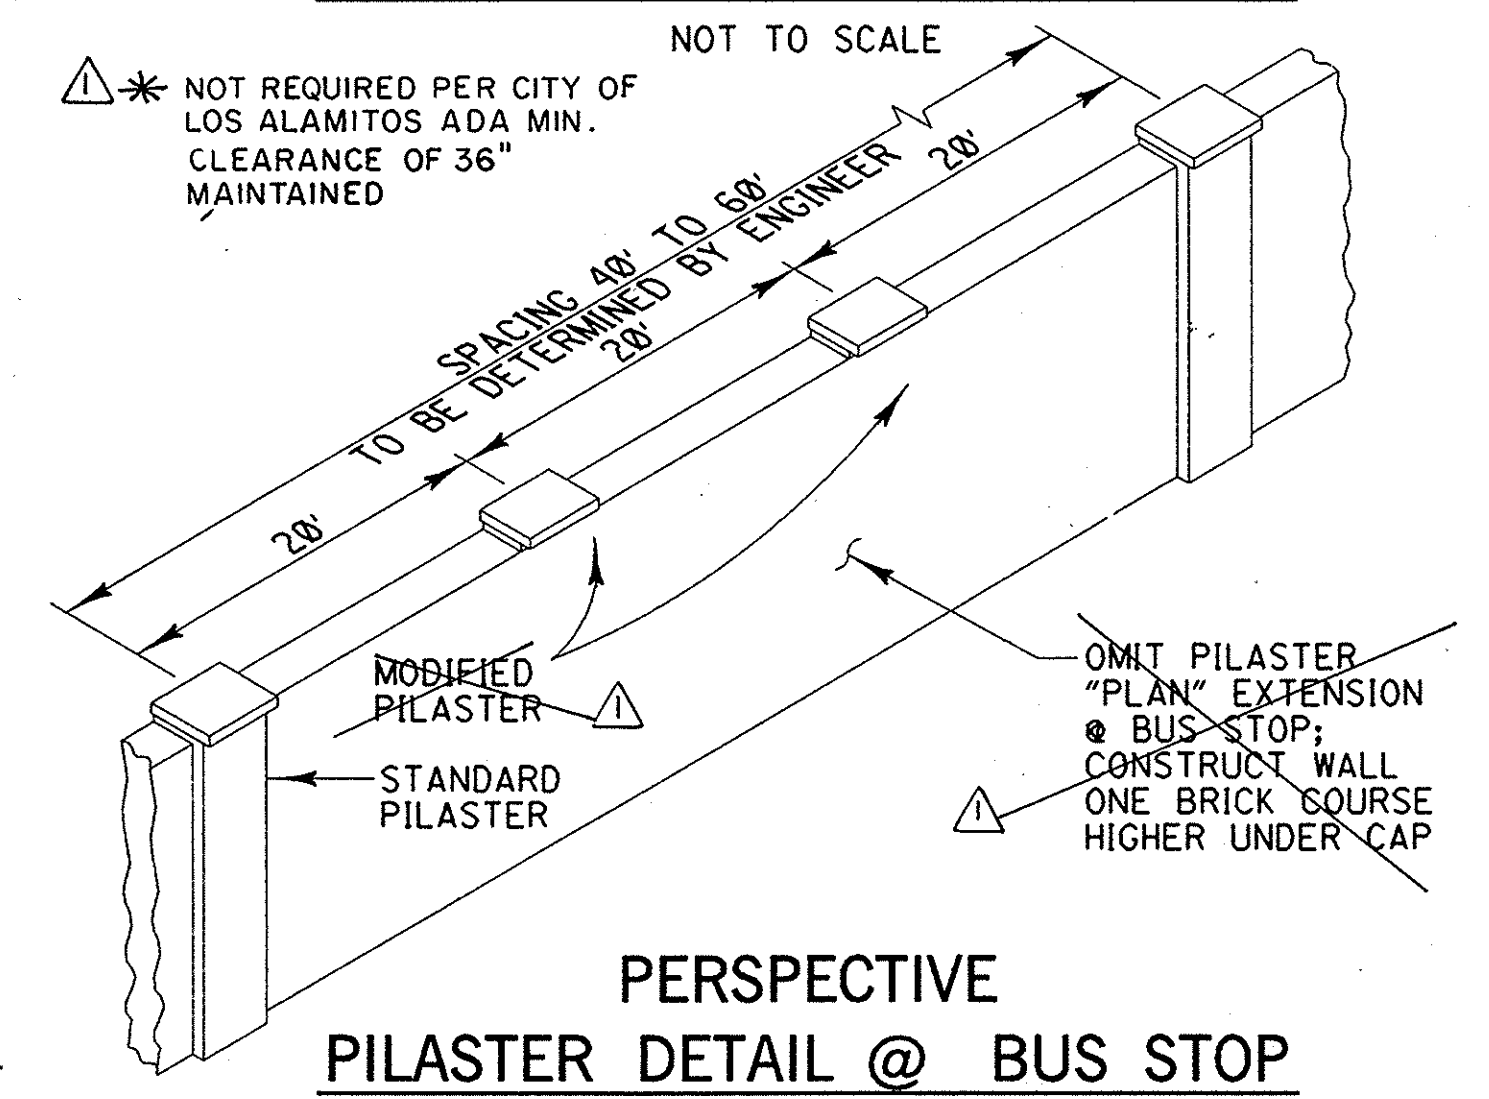

**PERSPECTIVE
PILASTER DETAIL @ BUS STOP**

NOT TO SCALE

4-00	RECORD DRAWINGS		ORANGE COUNTY PUBLIC FACILITIES AND RESOURCES DEPARTMENT	
	MARK DATE DESCRIPTION		ROSSMOOR SIGNATURE WALL MISCELLANEOUS DETAILS	
	REVISIONS			
	PREPARED UNDER SUPERVISION OF		DESIGNED: T. RIGONI DRAWN: A.P.M.D. SCALE: AS SHOWN DATE: 3/16/98 CHECKED: E. KWAN DRAWING NO.: SHEET 11 OF 12	