

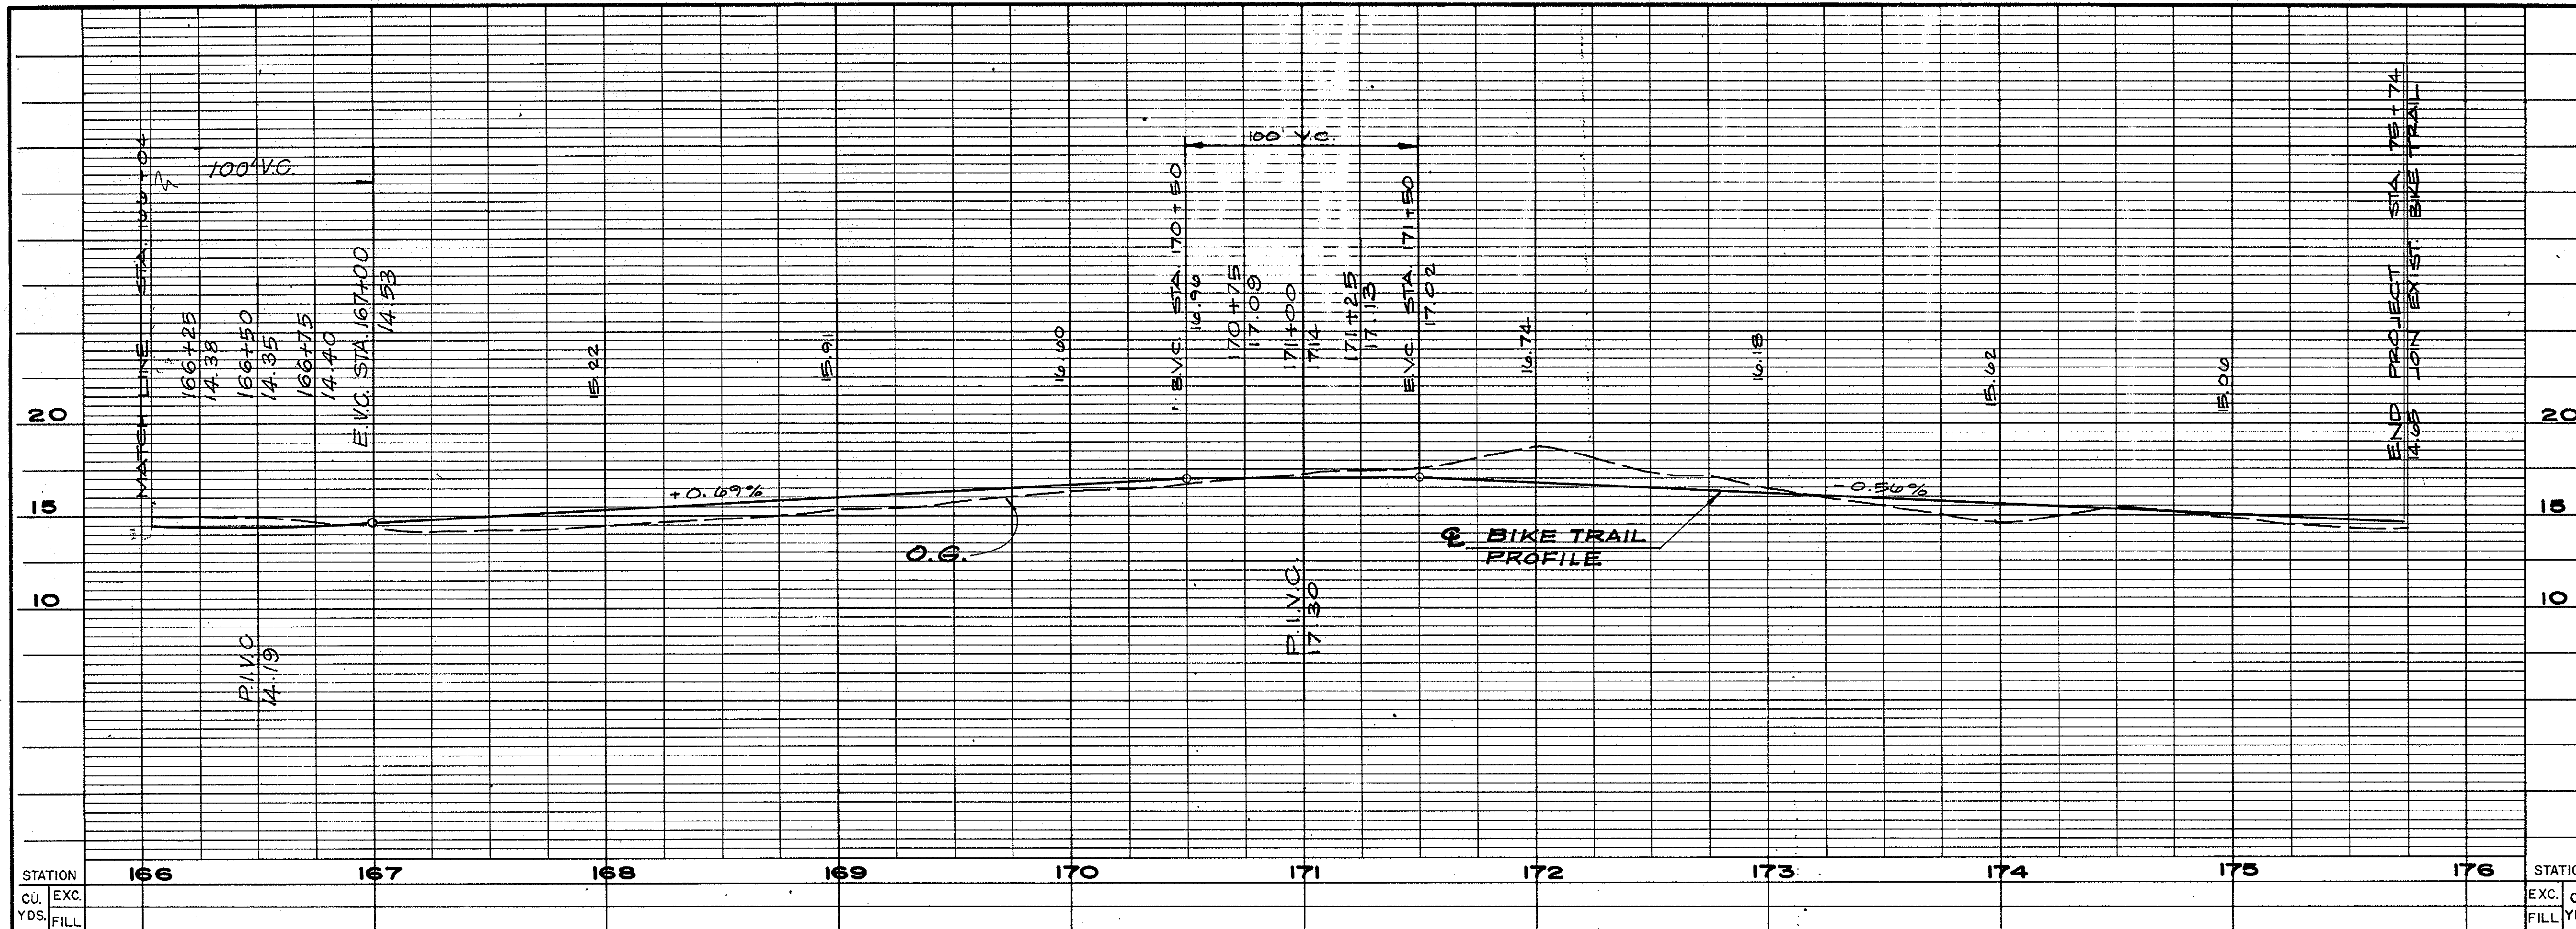
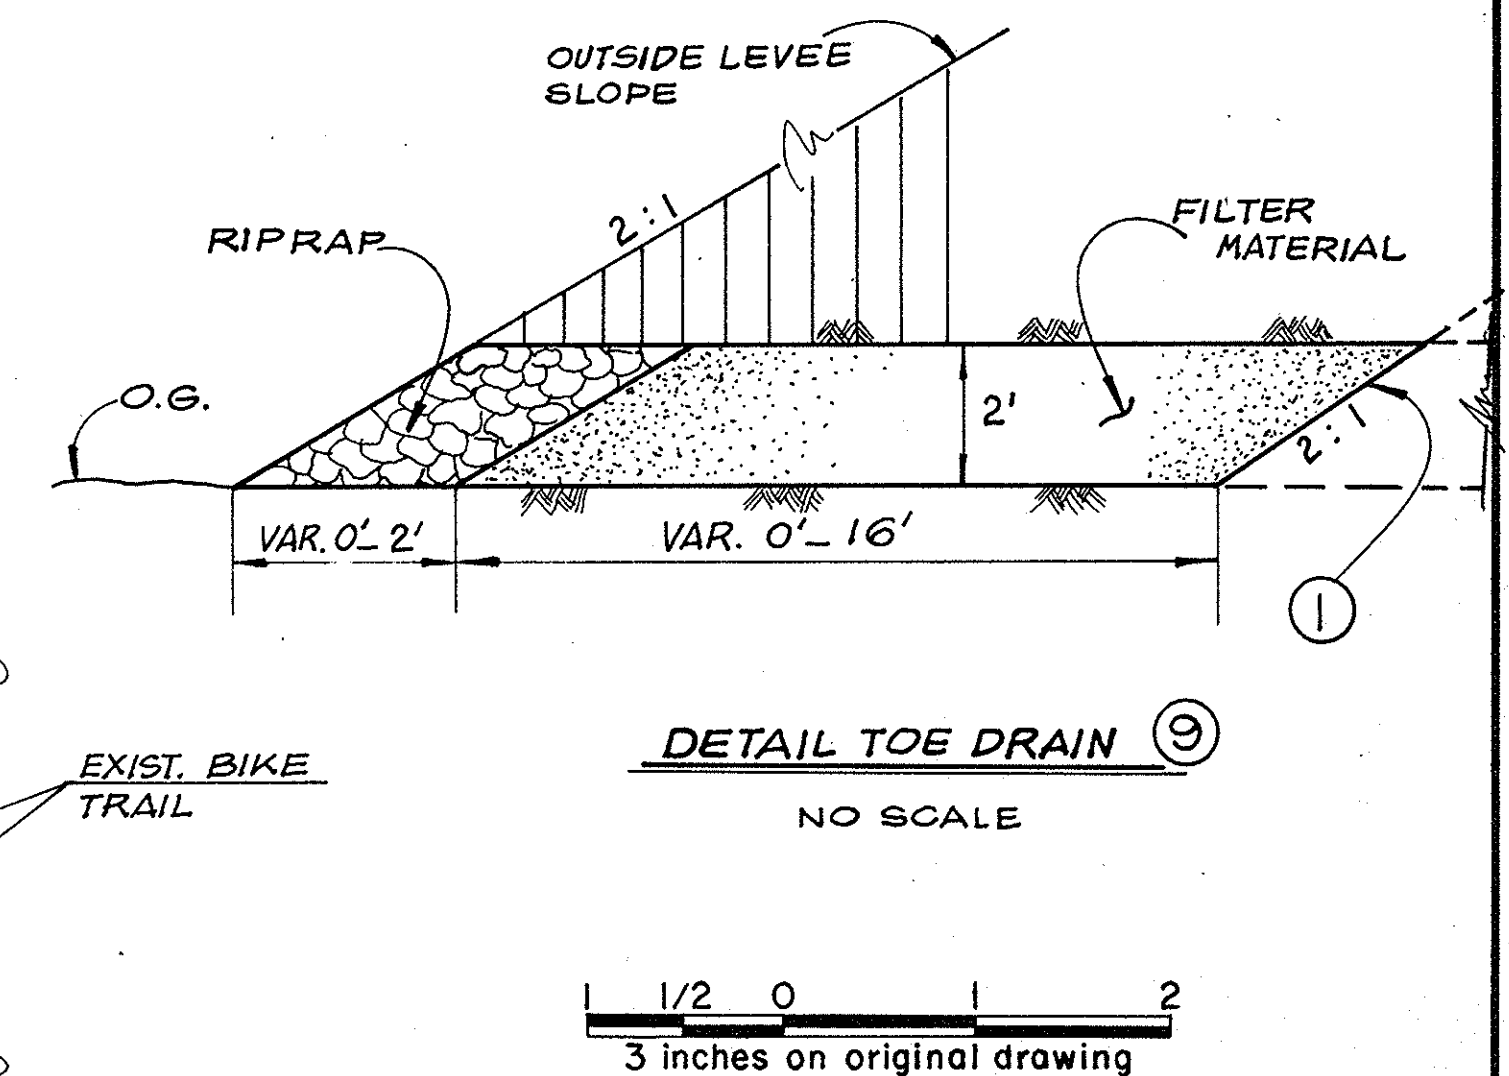


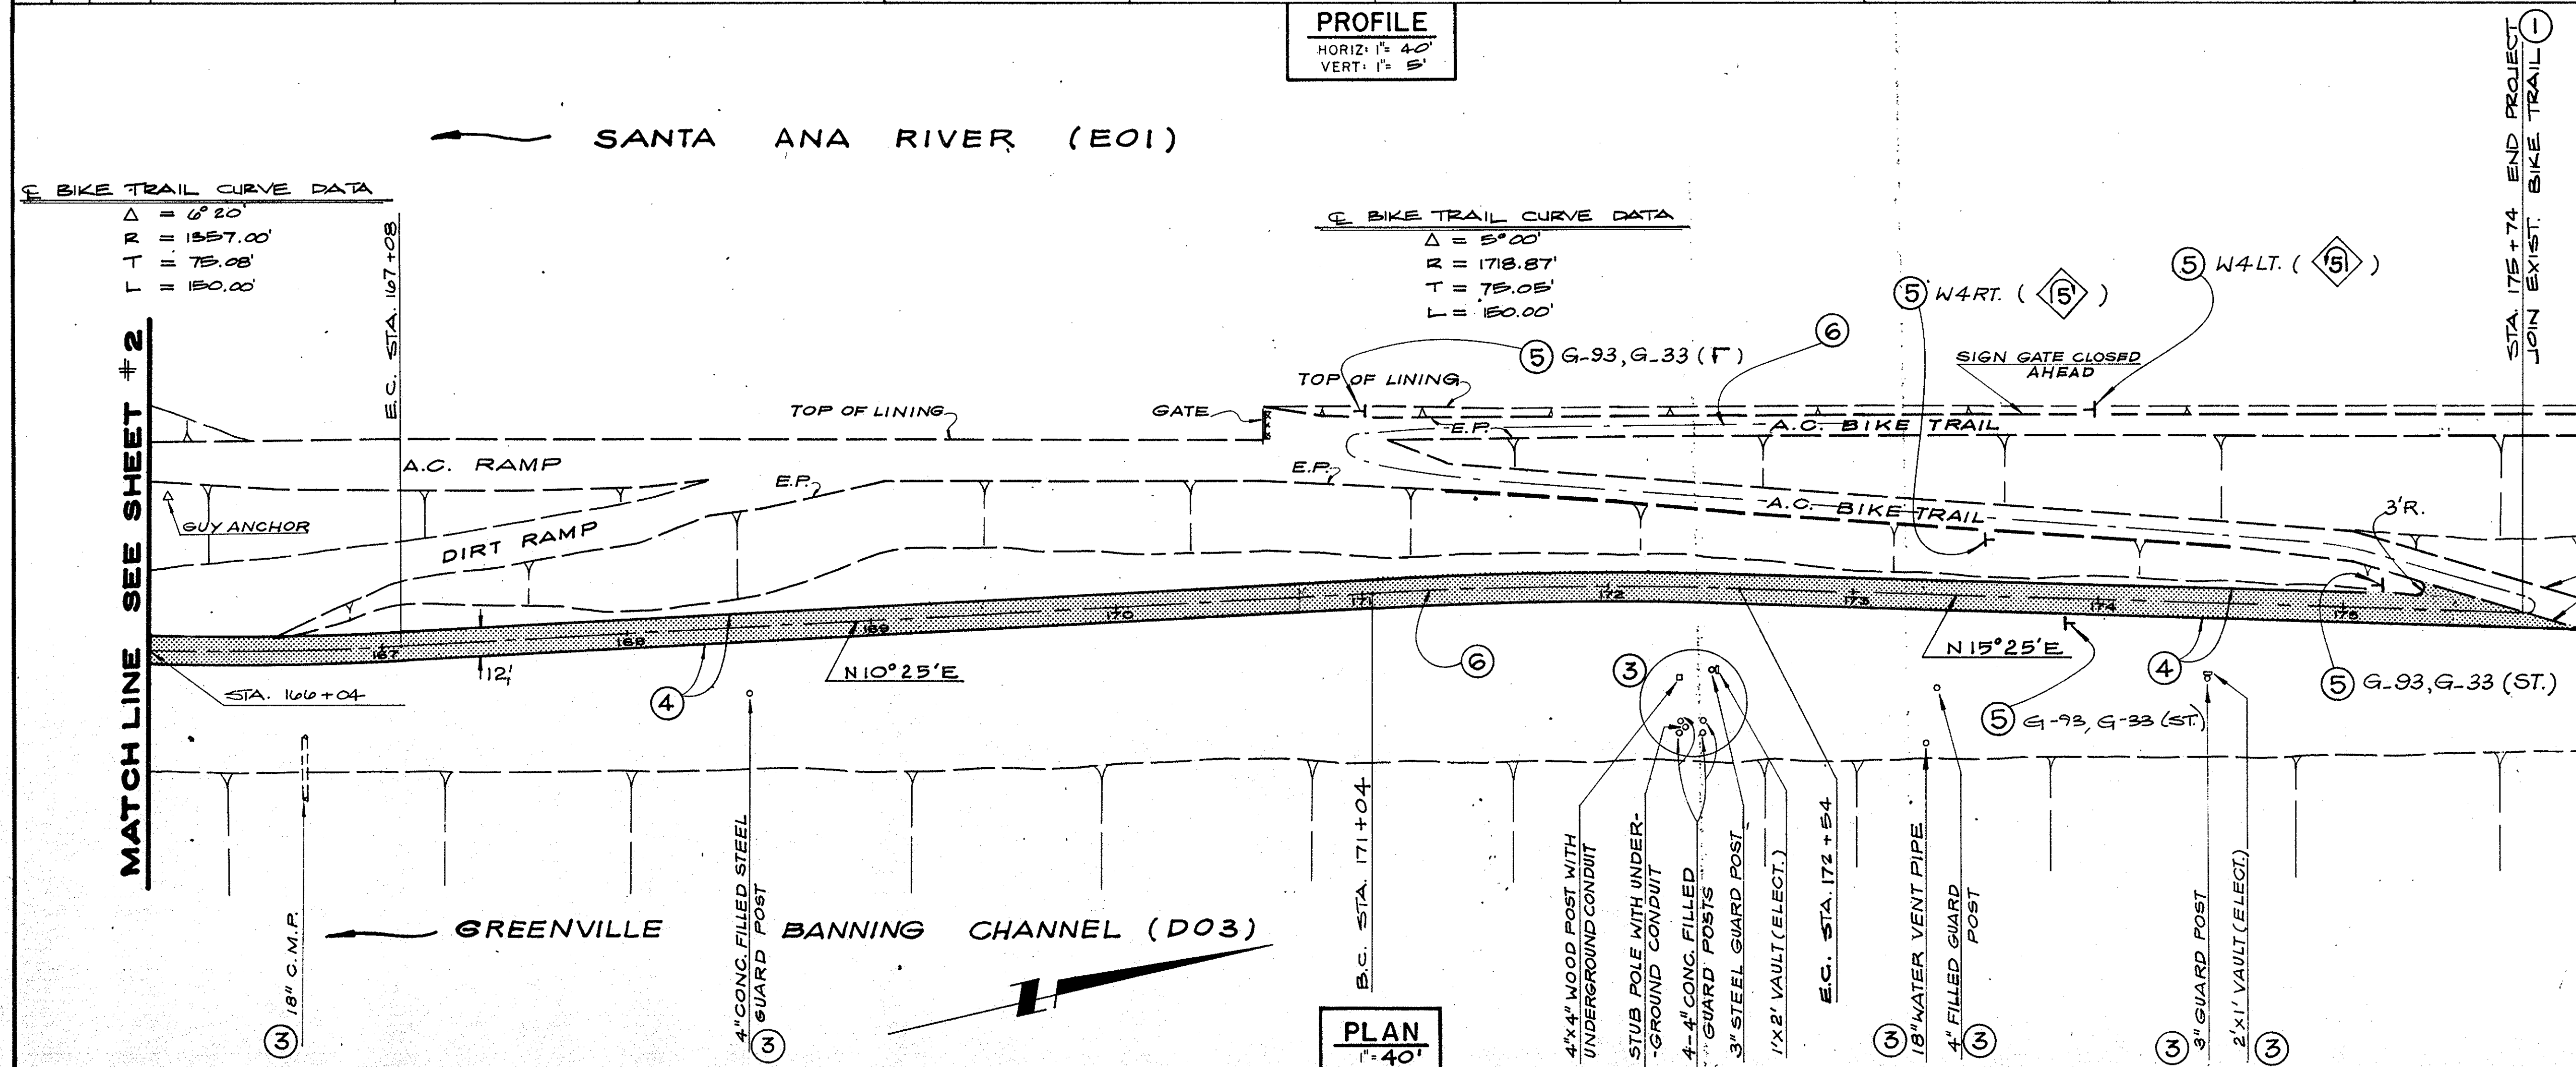

CONSTRUCTION NOTES

- ① JOIN EXISTING
- ② REMOVE
- ③ PROTECT IN PLACE
- ④ CONSTRUCT 3" A.C. OVER N.S. WITH LIQUID ASPHALT.
- ⑤ INSTALL BIKE TRAIL SIGN (SEE DETAIL A)
- ⑥ STRIPE CENTER LINE OF BIKE TRAIL WITH 4" SOLID YELLOW.
- ⑦ INSTALL 18" C.S.P. PER PROFILE ON SHT. 3.
- ⑧ INSTALL 24" C.S.P. DROP INLET PER O.C.E.M.A. STD. PLAN 305 AND PROFILE SHOWN ON SHT. 3.
- ⑨ CONSTRUCT TOE DRAIN PER DETAIL ON SHT. 3.

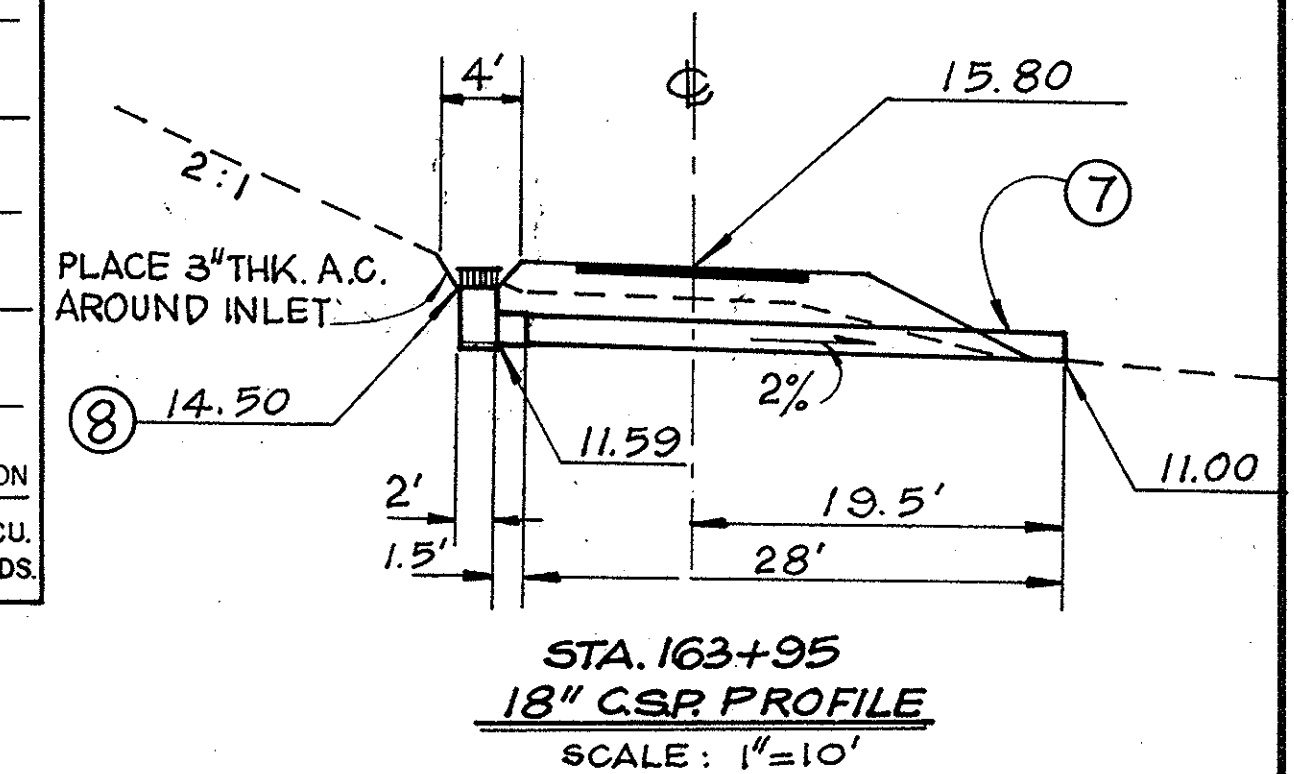

ORANGE COUNTY ENVIRONMENTAL MANAGEMENT AGENCY			
SANTA ANA RIVER BIKE TRAIL AT ADAMS AVE. BRIDGE			
PLAN & PROFILE			
MARK	DATE	DESCRIPTION	PREPARED UNDER SUPERVISION OF Vincent Rios 5/3/84
DESIGNED M. DRIS		SCALE	DATE
DRAWN H.P., P.B.		AS SHOWN	3/84
CHECKED M.L.		DWG. NO.	3