
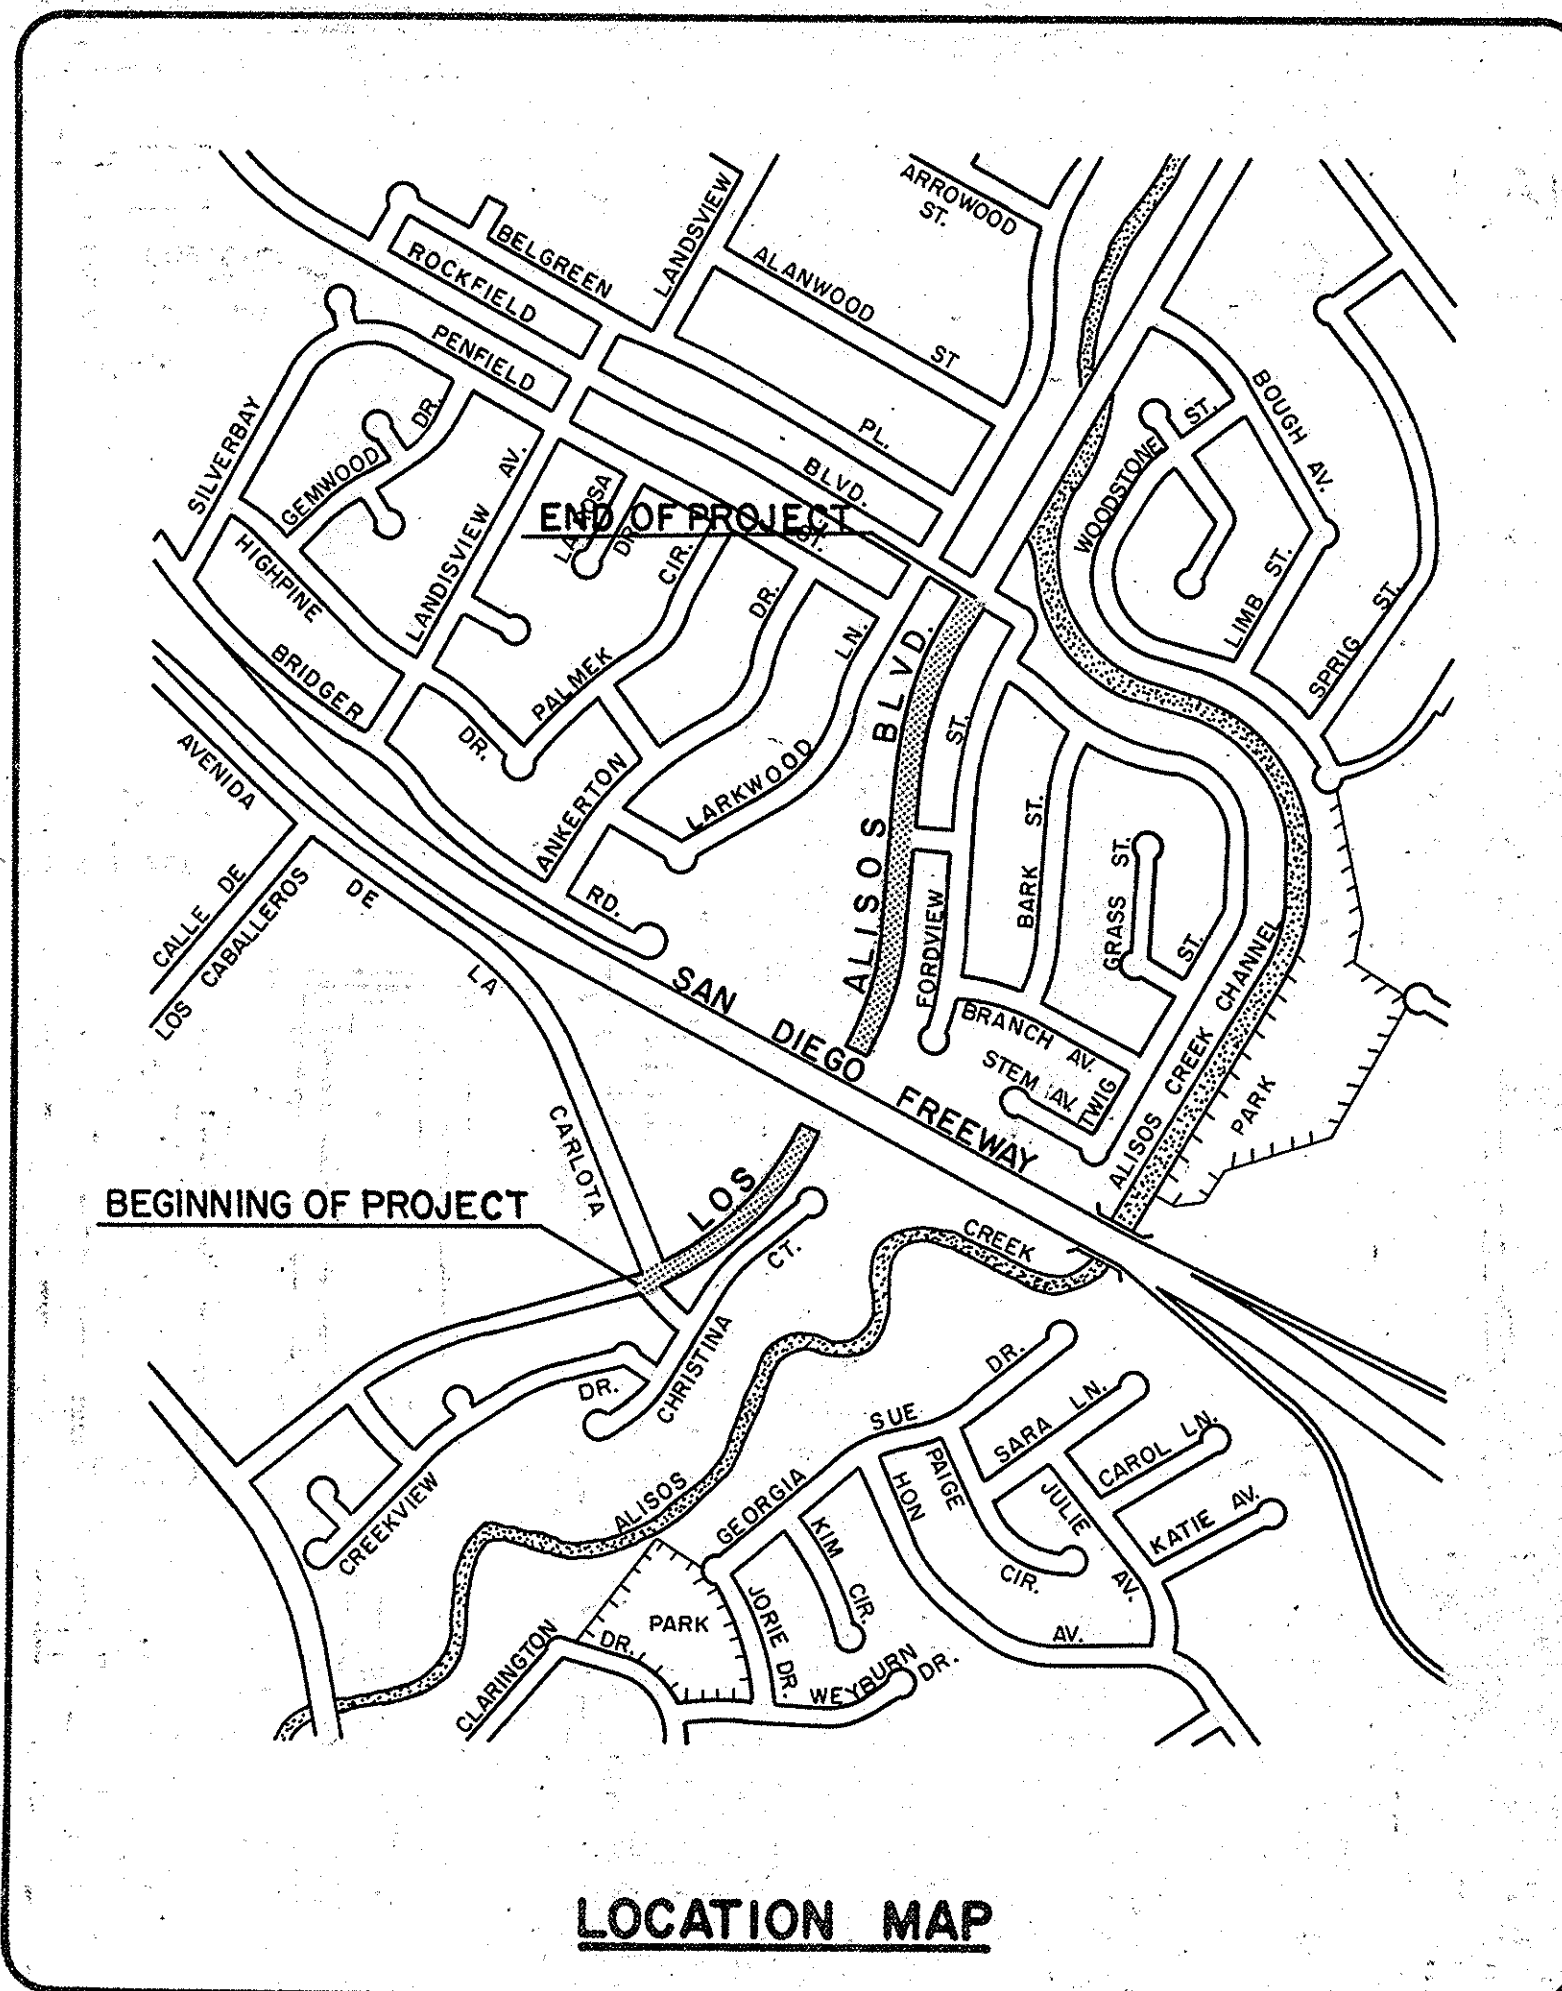


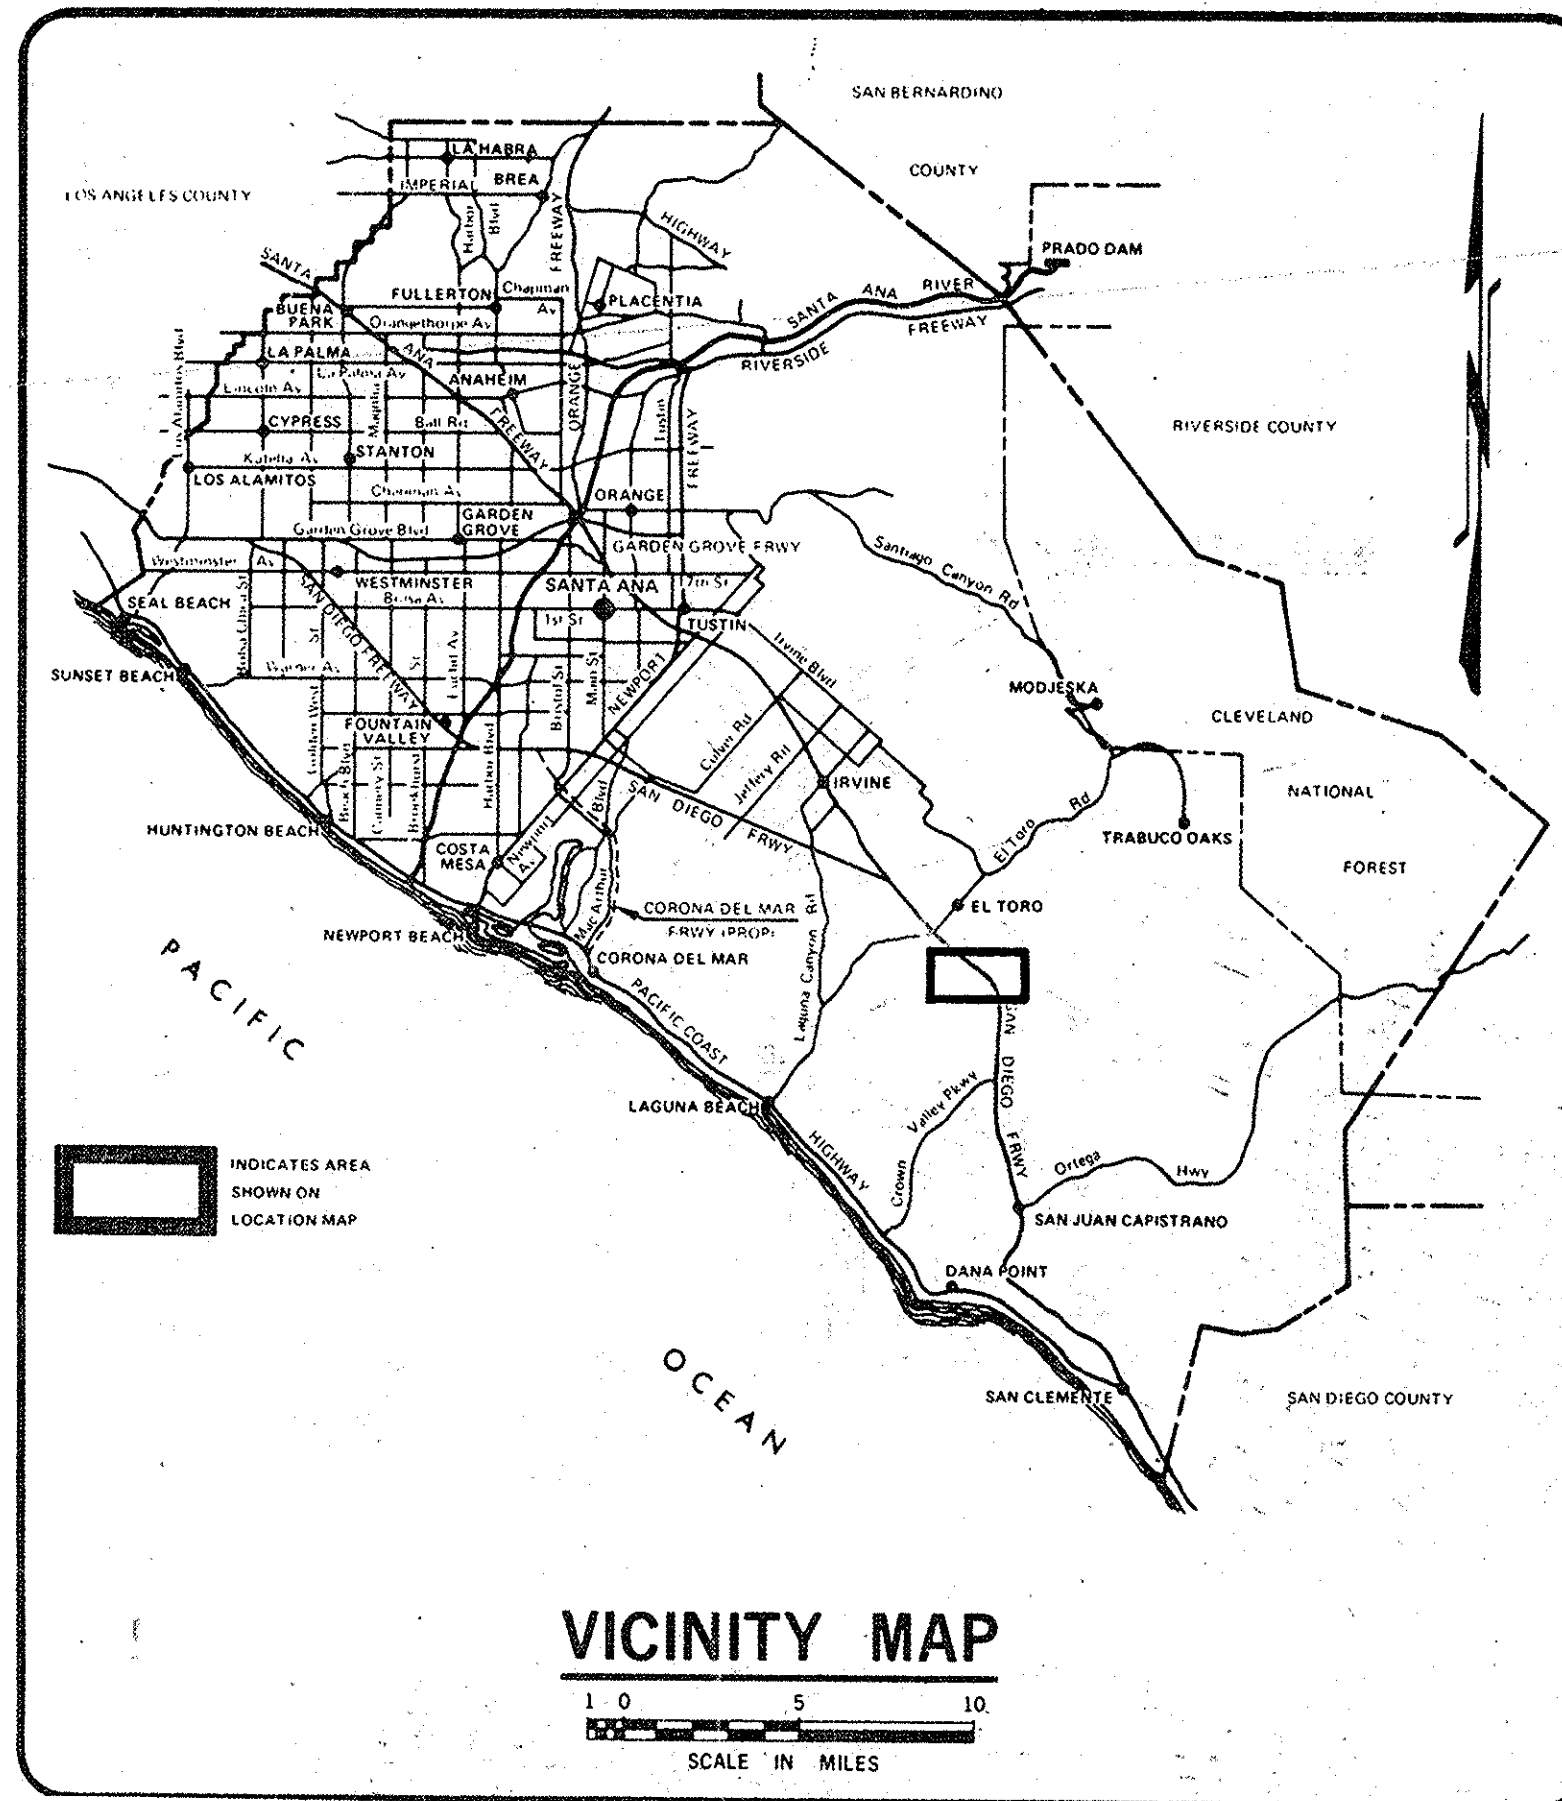

ORANGE COUNTY ENVIRONMENTAL MANAGEMENT AGENCY

SANTA ANA, CALIFORNIA
M. STORM, DIRECTOR

PLANS FOR CONSTRUCTION OF

SOUNDWALLS On LOS ALISOS BLVD. From ROCKFIELD BLVD. To AVENIDA DE LA CARLOTA

FUNDED BY: HIGHWAY USERS' TAXES

EMA - PUBLIC WORKS

SUBMITTED: *William H. Talley* 2/2/84
SECTION CHIEF RCE 16799

RECOMMENDED: *F. Williams* 2/6/84
DIVISION MANAGER RCE 13154

APPROVED: *F. Williams for CR Nelson* 2/6/84
DIRECTOR OF PUBLIC WORKS

INDEX OF SHEETS

SHEET	DESCRIPTION
1	TITLE SHEET
2	PLAN & MASONRY SOUNDWALL DETAILS
2A	SOUND WALL - MASONRY BLOCK ON BARRIER
3	MASONRY SOUNDWALL DETAILS
4	WEATHERING STEEL SOUNDWALL DETAILS

AS BUILT

CONTRACTOR: GRANSTROM CONST, GARDENA.
INSPECTOR : G. WALLEN.
R.C.E. : P. GILBERT.
COMPLETED : 8/17/1984.

UTILITY PHONE NO.

1 SANTA MARGARITA WATER DIST.	(714) 833 - 0070
JOHN BARNES	
2 SO. CAL. EDISON	(714) 859 - 5241
JAY HICKMAN	
3 SO. CAL. GAS CO.	(714) 634 - 3122
JOYCE BURGER	
4 PACIFIC BELL	(714) 999 - 5716
JO MC CARD	

BENCH MARK:

BASIS OF BEARING:

NO.	DESCRIPTION	SHT.	APPROVED	DATE
(A)	AS BUILT	ALL		12/27/85
REVISIONS				

W. O. NO. R08635
DWG. NO.

SHEET 1 OF 5