




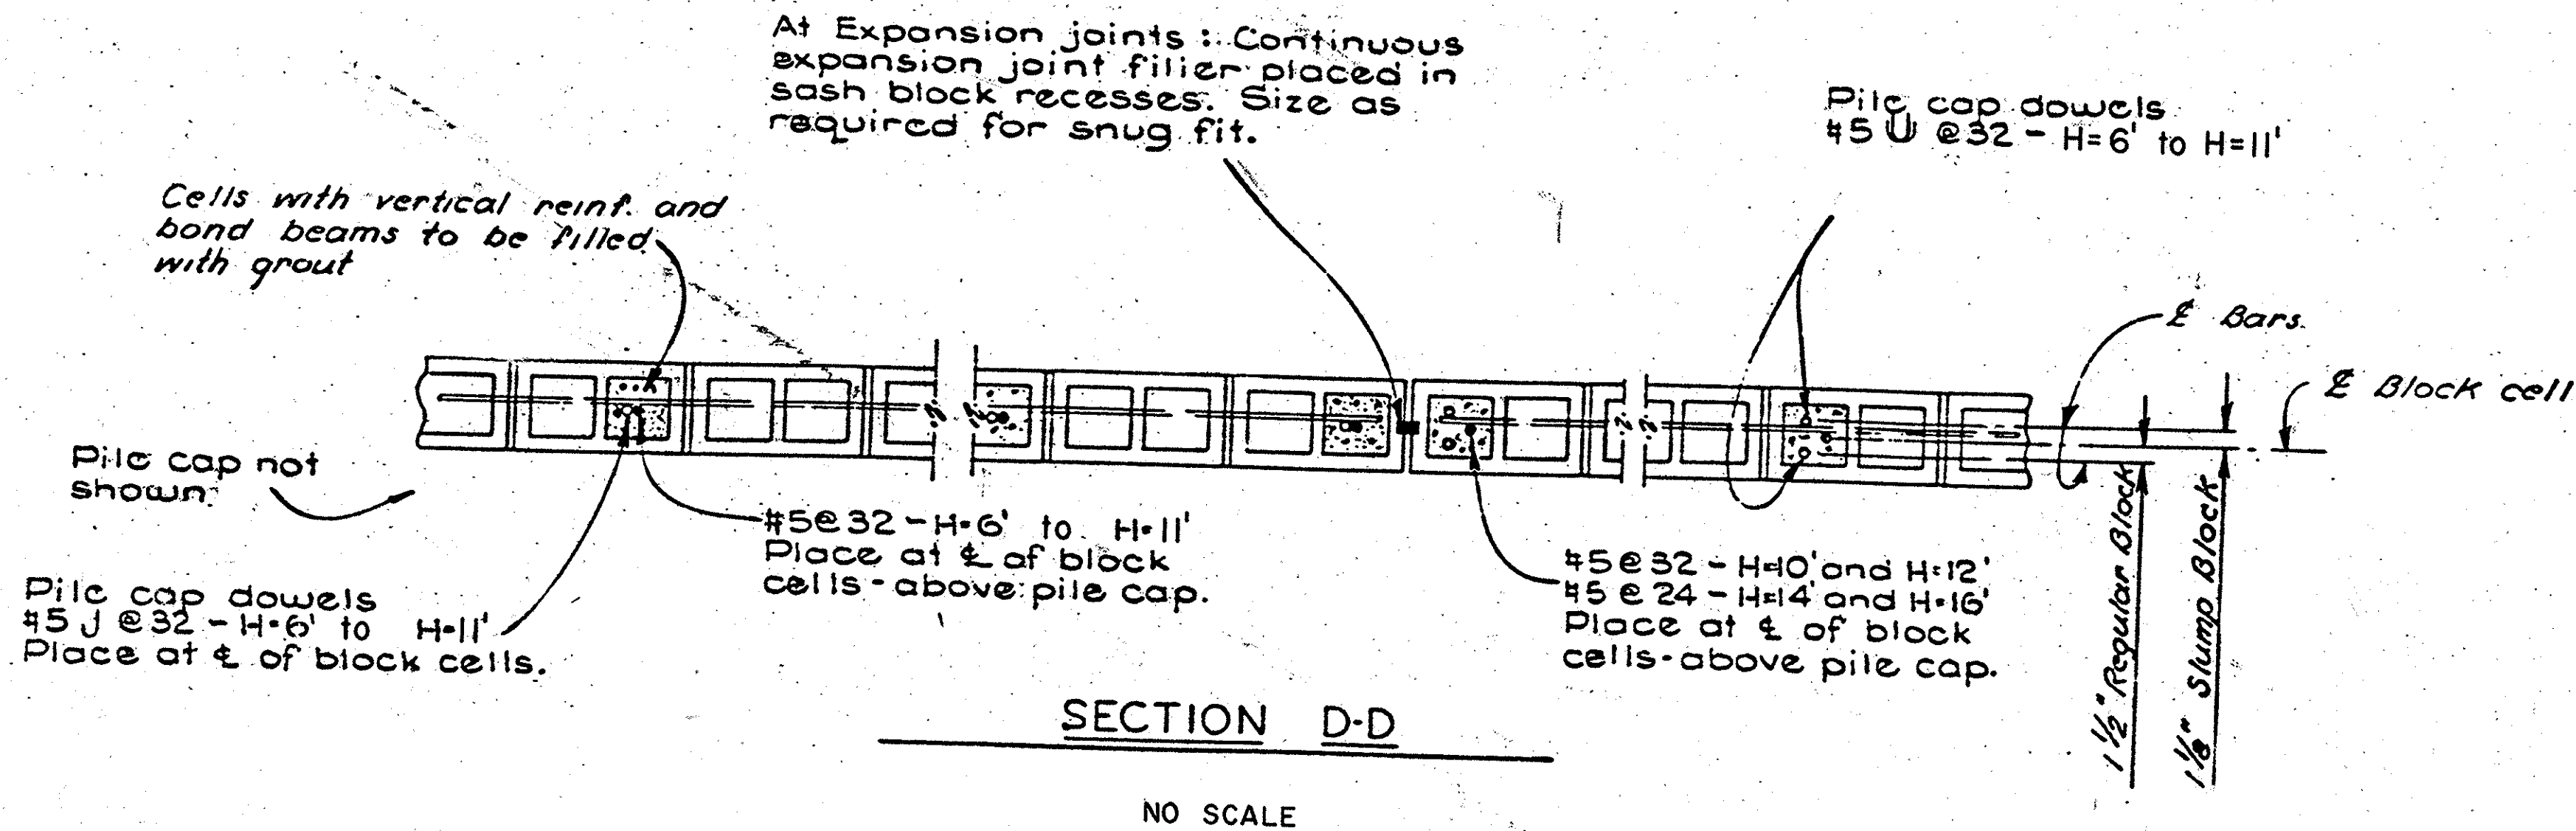

SECTION D-D
NO SCALE

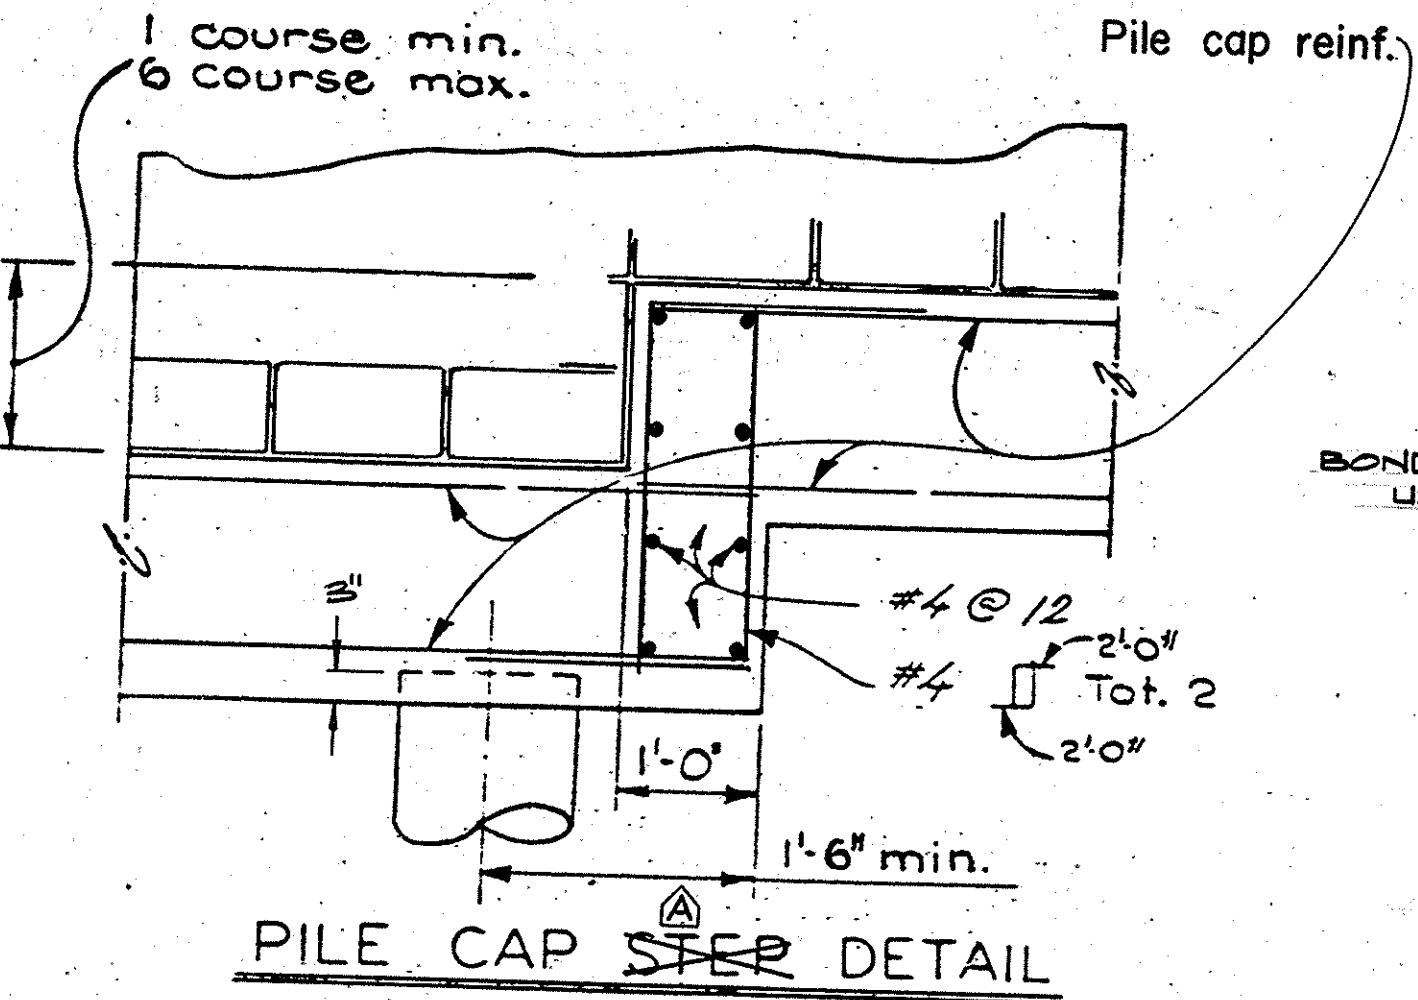

PILE CAP STEP DETAIL
NO SCALE

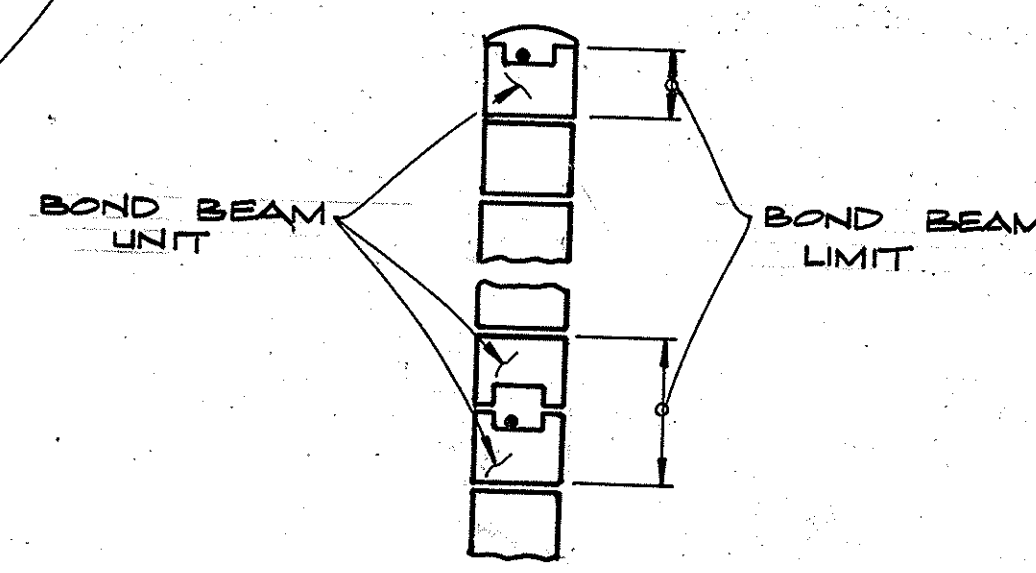


PRECISION BLOCK BOND BEAM DETAIL
NO SCALE


TABLE #2

LOT NO.	WALL HEIGHT (H)	PILE DIA. (D)	PILE BARS (P)	PILE SPACING (S)	PILE DEPTH (E)	GROUND LEVEL (G)
19	6'	14"	6-#5	12'	7'-6"	G-1
10, 15, 16, 17, 18 & 20-30	9.5'	14"	6-#6	12'	6'-6"	G-2
11, 12, 14	10'	14"	6-#6	12'	6'-6"	G-2
12	11'	14"	6-#6	12'	7'-0"	G-2


ALTERNATIVE B - MASONRY SOUNDWALL
(SEE TABLE I - SHEET #4 FOR LOCATION)

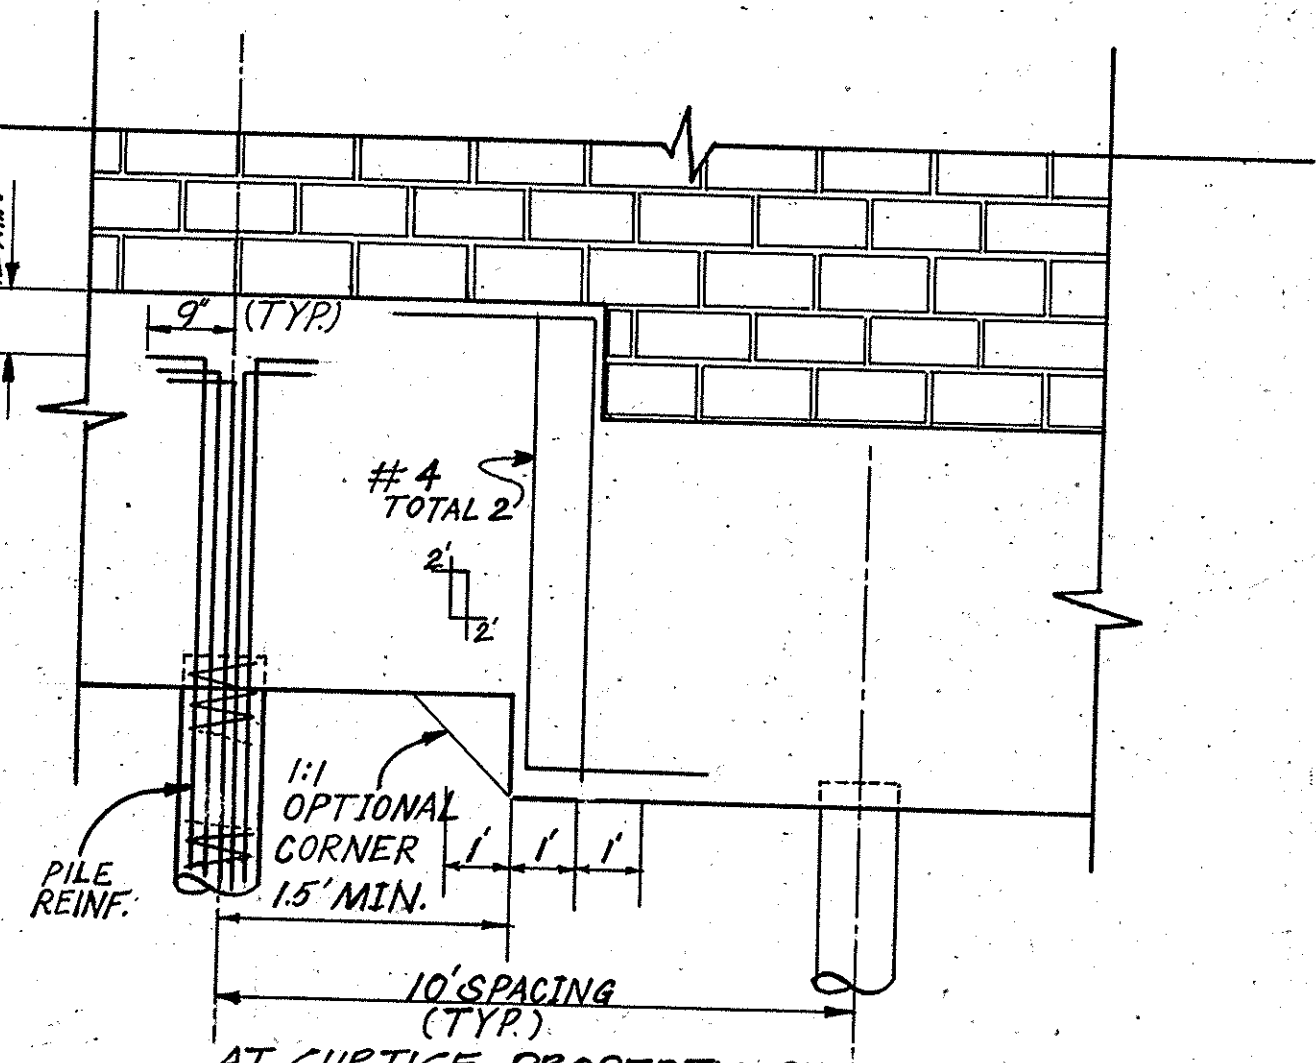


STEP DETAIL
NO SCALE

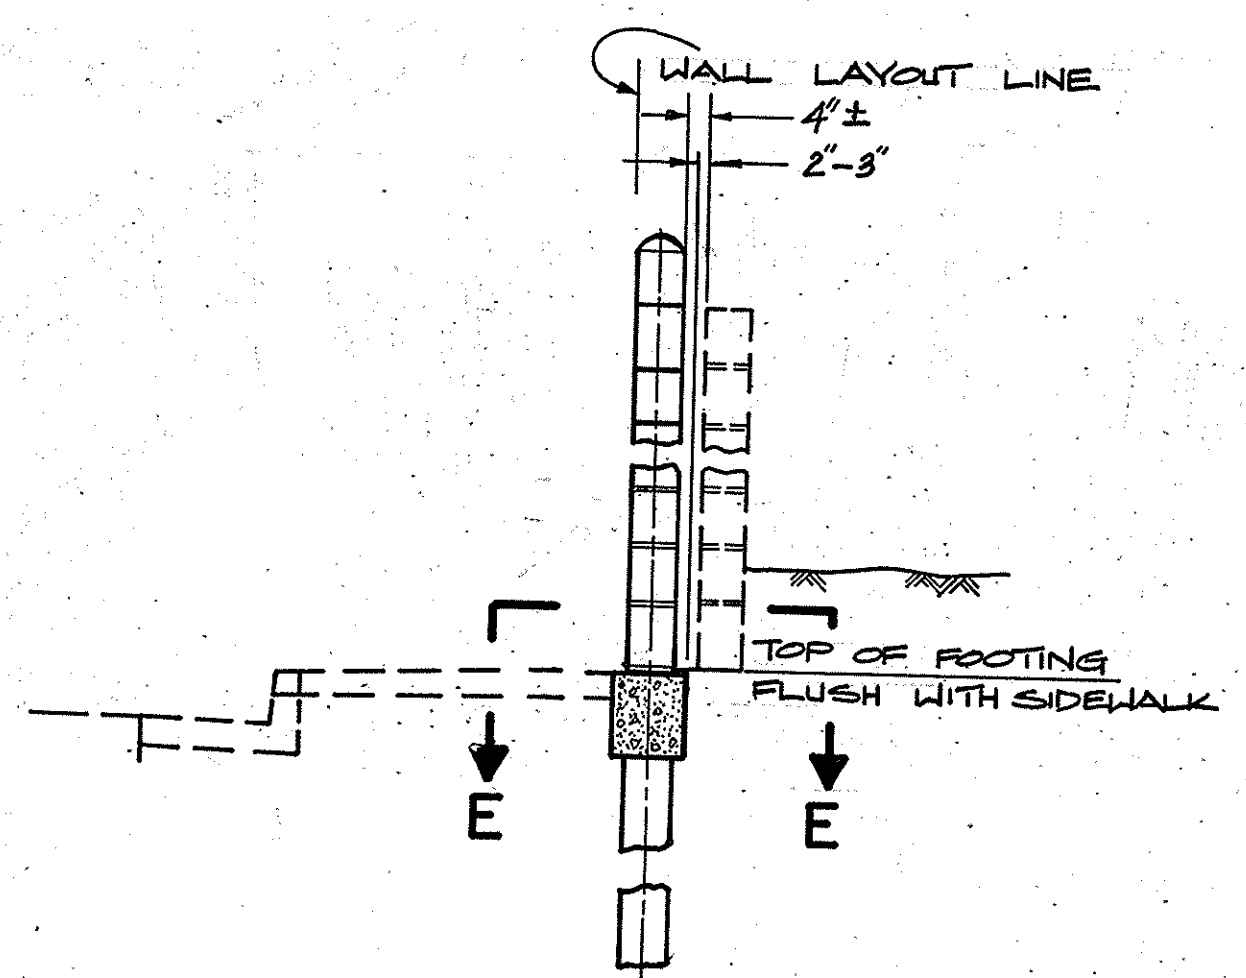


REINFORCED MASONRY WALL TYPICAL WALL ALIGNMENT
(FROM FWY. TO ROCKFIELD BLVD.)
NO SCALE

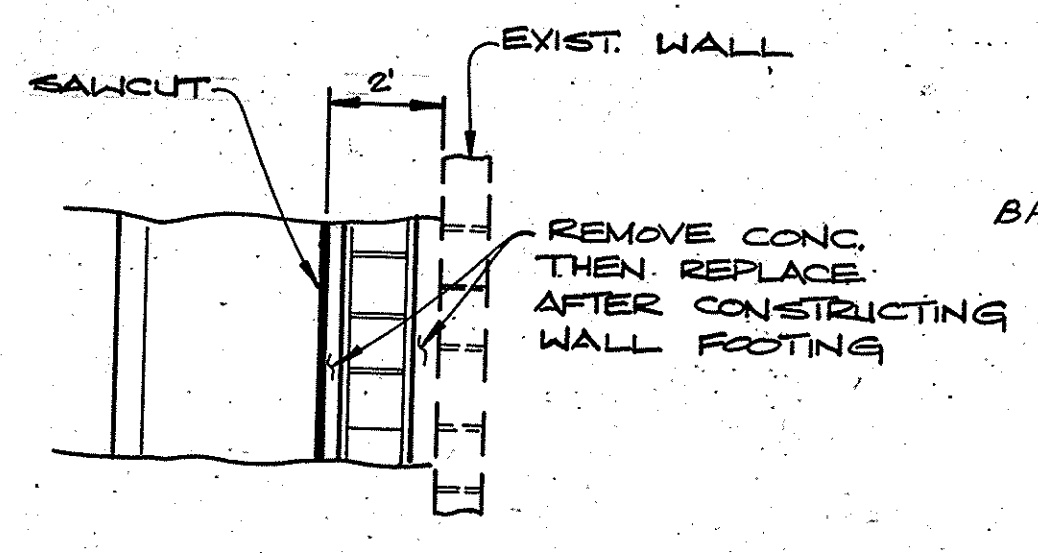

SECTION E-E
NO SCALE

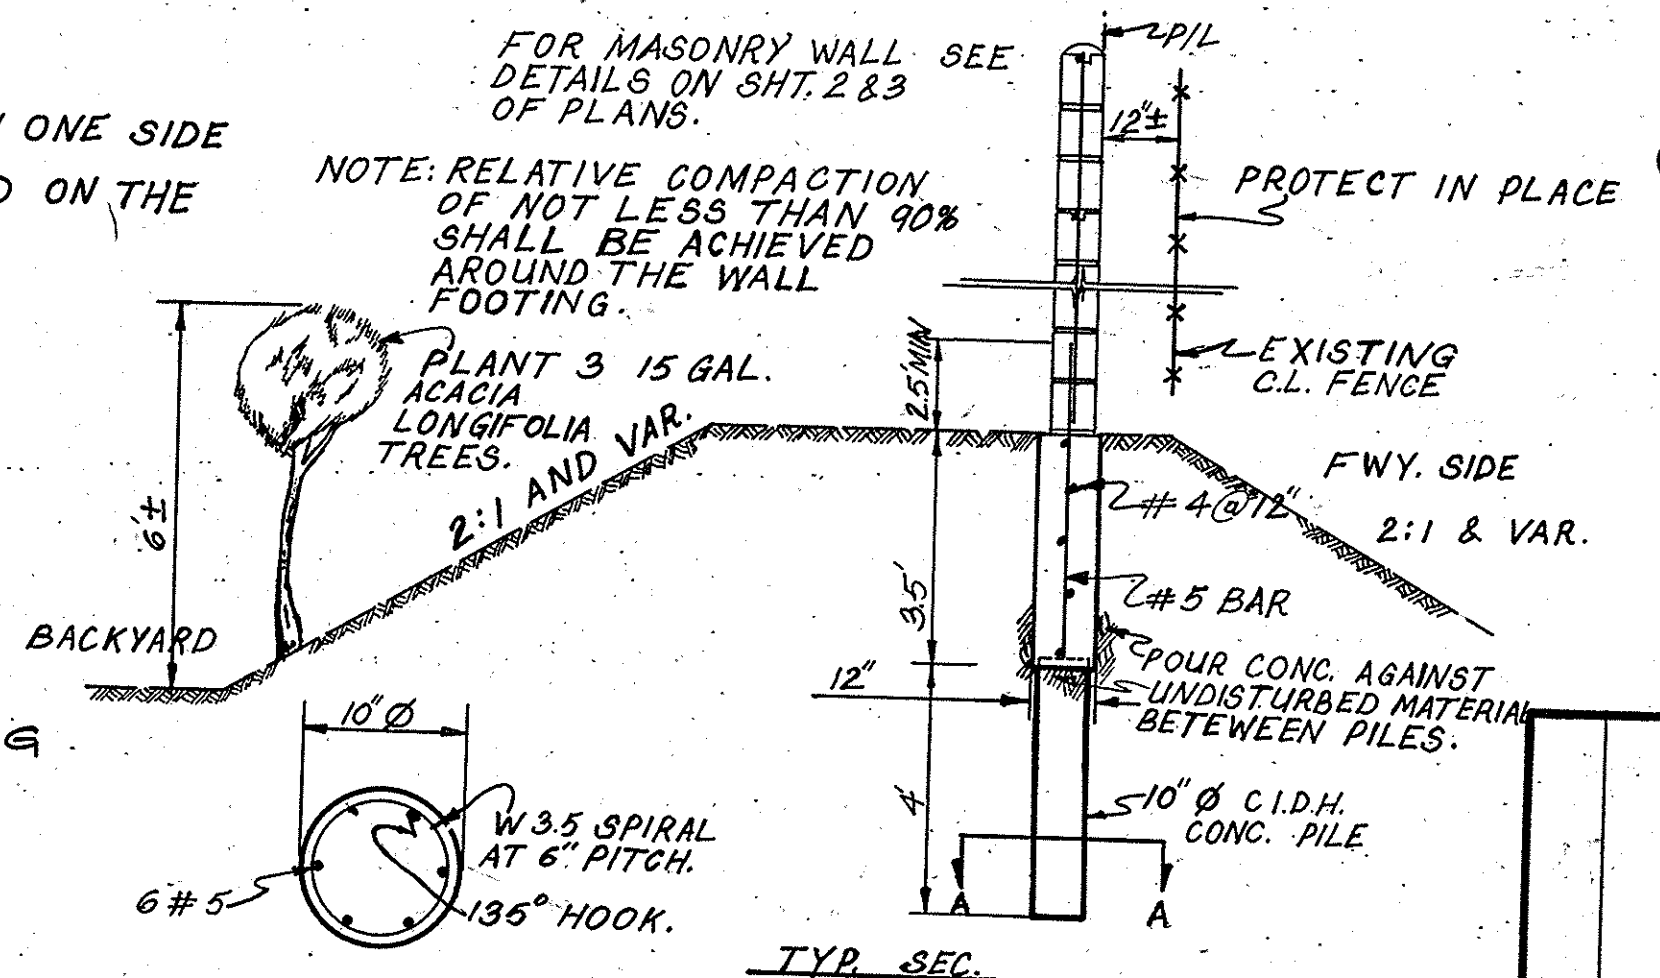

SECTION A-A
NO SCALE

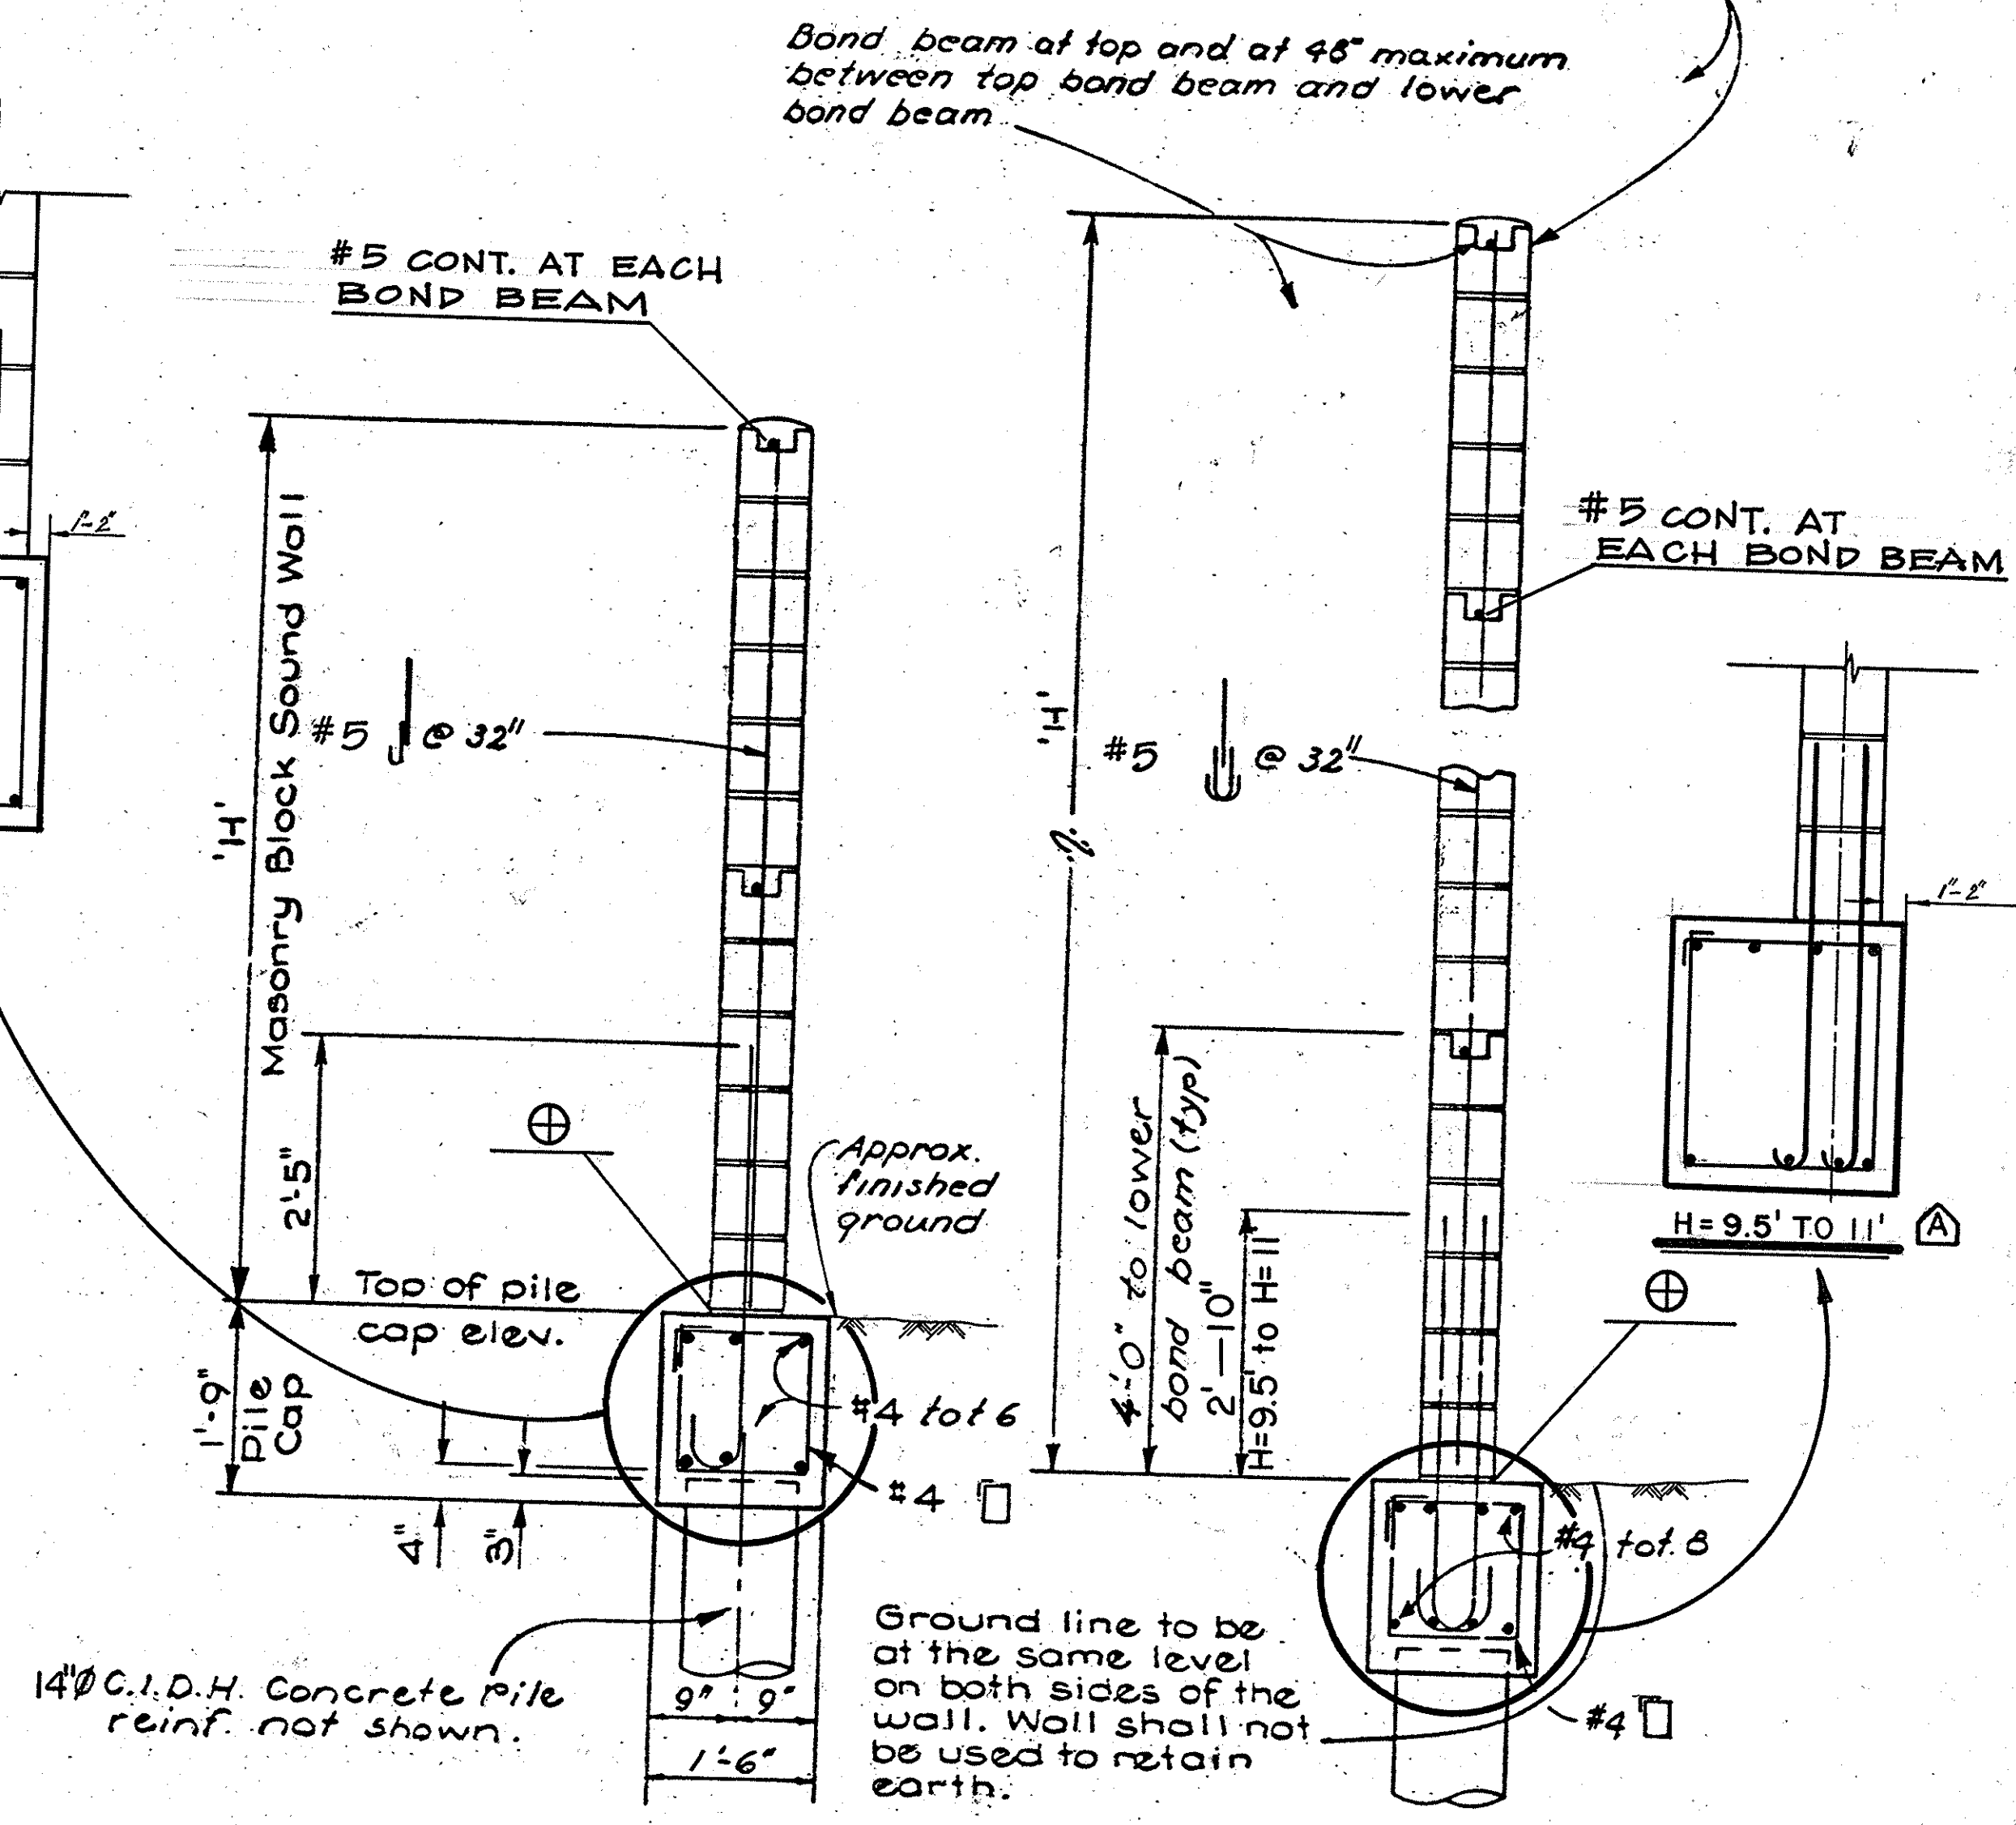

H=6' AND H=8'
H=9.5' TO H=11'
TYPICAL SECTIONS
NO SCALE

⊕ FULL MORTAR BED JOINT AT BOTTOM OF WALL.

1 1/2 0 1 2
3 inches on original drawing

ORANGE COUNTY ENVIRONMENTAL MANAGEMENT AGENCY	
SOUNDWALLS On LOS ALISOS BLVD.	
MASONRY SOUNDWALL DETAILS	
MARK DATE 12/17/05	AS BUILT
REVISIONS	DESCRIPTION
DESIGNED M. IDRIS	PREPARED UNDER SUPERVISION OF Vincent Rosales R.C.E. 3-0829 DATE
SCALE	DATE
DWG. NO.	SHEET 3