



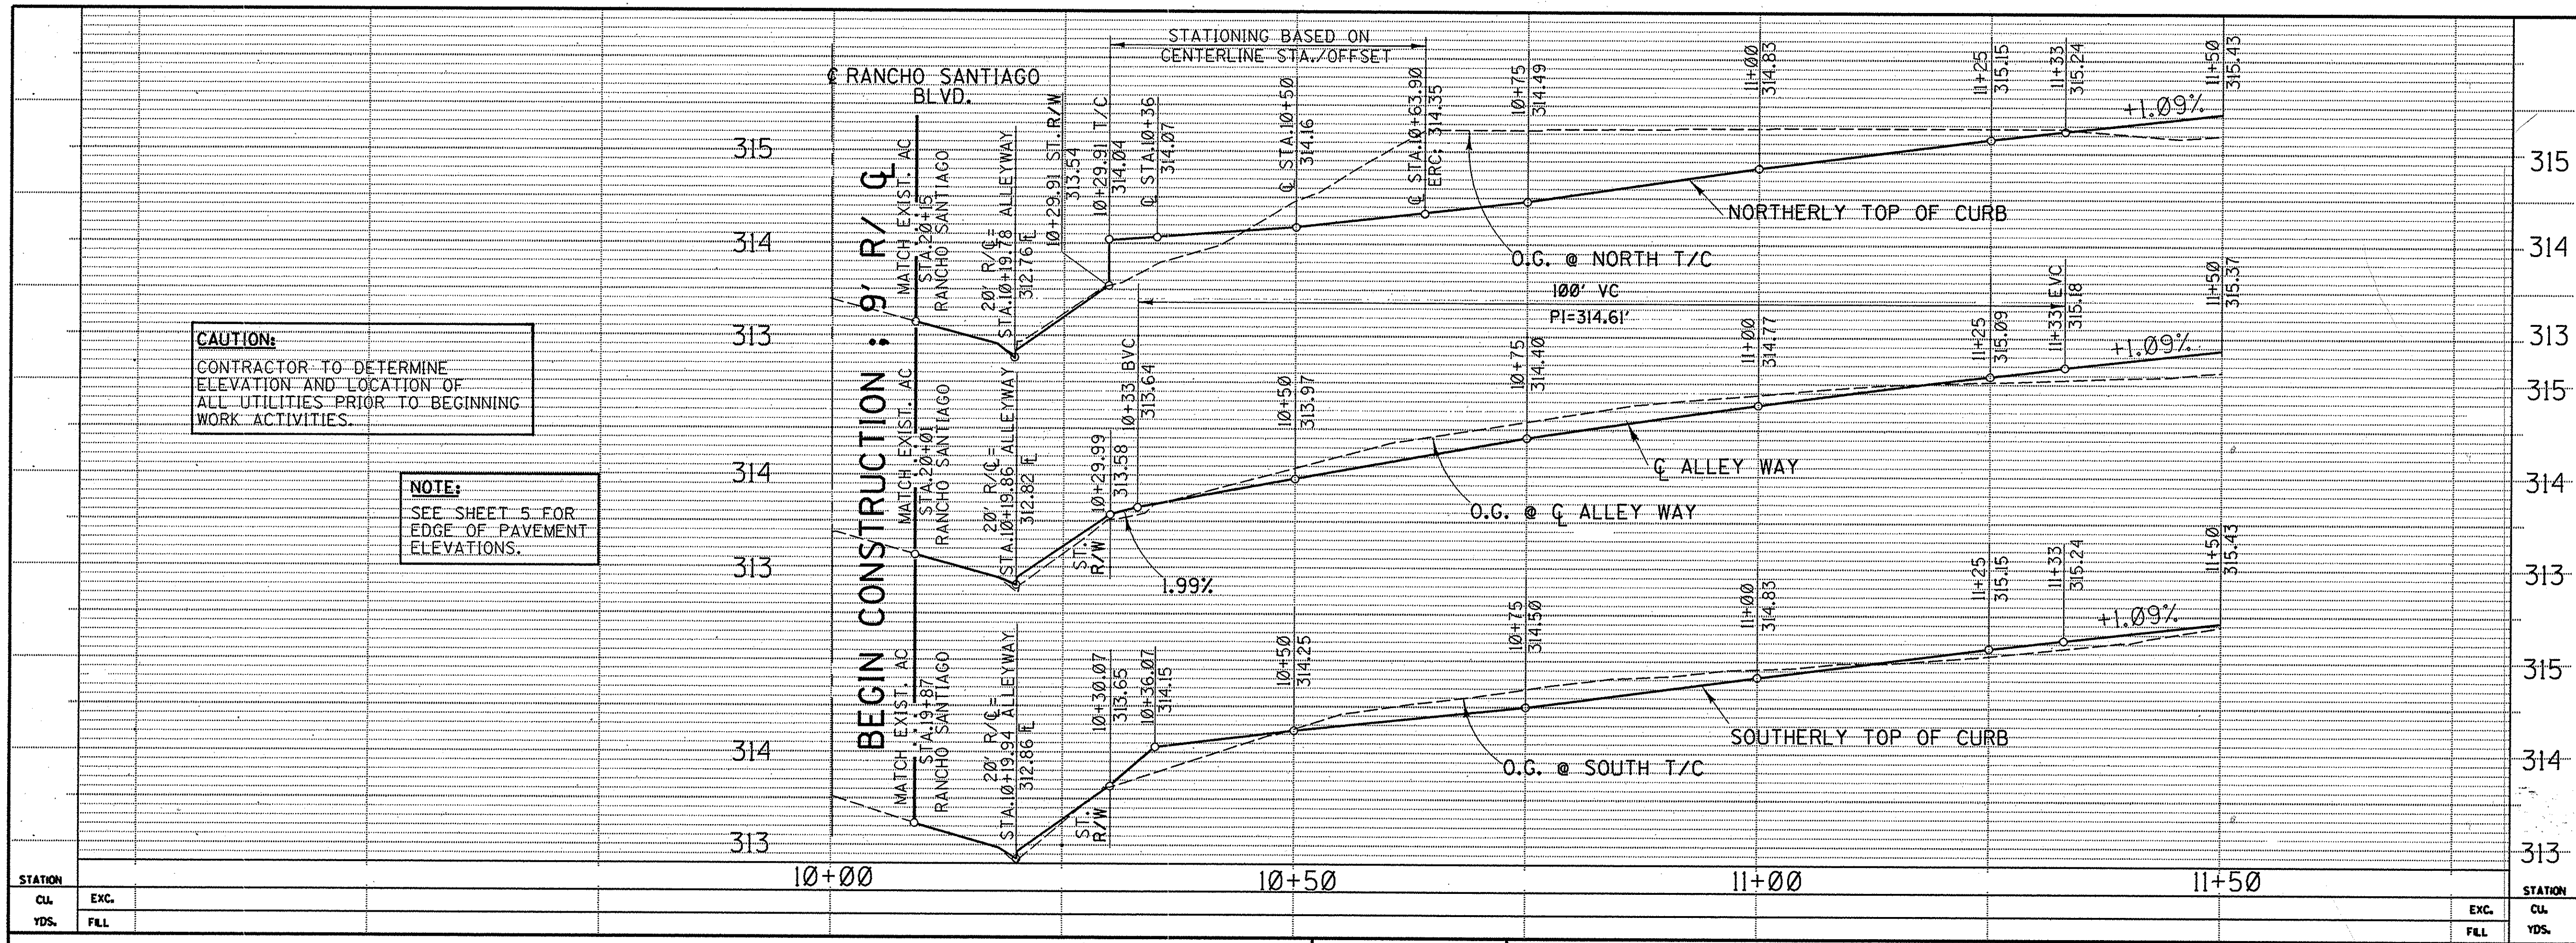

CONSTRUCTION NOTES

1. CONSTRUCT A2-8 CURB & GUTTER PER PF&RD PLAN NO. 120-0-0C & PLAN & PROFILE.
2. CONSTRUCT A2-6 CURB & GUTTER PER PF&RD STD. PLAN 120-0-0C & PLAN & PROFILE.
3. CONSTRUCT P.C.C. SIDEWALK PER PF&RD STD PLAN NO. 1205 & PLAN.
4. CONSTRUCT P.C.C. DRIVEWAY APPROACH PER PF&RD STD PLAN NO. 1209, PLAN AND PER DETAILS.
5. CONSTRUCT 0.25' AC OVER 0.40' AB PER PLAN, PROFILE AND TYPICAL SECTION.
6. CONSTRUCT 0.40' AC/NS TO MATCH EXISTING PER PLAN & DETAILS.
7. CONSTRUCT 6' HIGH MASONRY BLOCKWALL PER PF&RD STD PLAN 1414, PLAN & DETAILS.
8. CONSTRUCT A2-6 CURB & GUTTER TRANSITION PER PF&RD STD PLAN 120-0-0C, PLAN AND DETAILS.
9. CONSTRUCT 1.00' AC/NS PER PLAN & PROFILE.
10. CONSTRUCT PARKWAY CULVERT, TYPE "C", CASE II INLET PER PF&RD STD PLAN 1309, AND PLANS.
11. INSTALL TEMPORARY SECURITY FENCE PER TYPICAL SECTION, SPECIAL PROVISIONS AND AS DIRECTED BY ENGINEER.
12. INSTALL TYPE N MARKERS PER PF&RD STANDARD PLAN 1401 & PLAN & DETAILS.
13. INSTALL FIRE LANE SIGN PER PLAN & SPECIAL PROVISIONS.
14. PAINT CURB "OSHA SAFETY RED" PER PLAN & SPECIAL PROVISIONS.
15. CONSTRUCT 0.5' PCC/NS PER PF&RD STD. PLAN 1803, PLAN, TYPICAL SECTION & SPECIAL PROVISIONS.
16. PLACE 0.25' AC/NS PER PLAN, DETAILS AND AS DIRECTED BY ENGINEER.
17. CONSTRUCT VARIABLE HEIGHT PCC CURB PER PLAN, DETAILS AND AS DIRECTED BY ENGINEER.

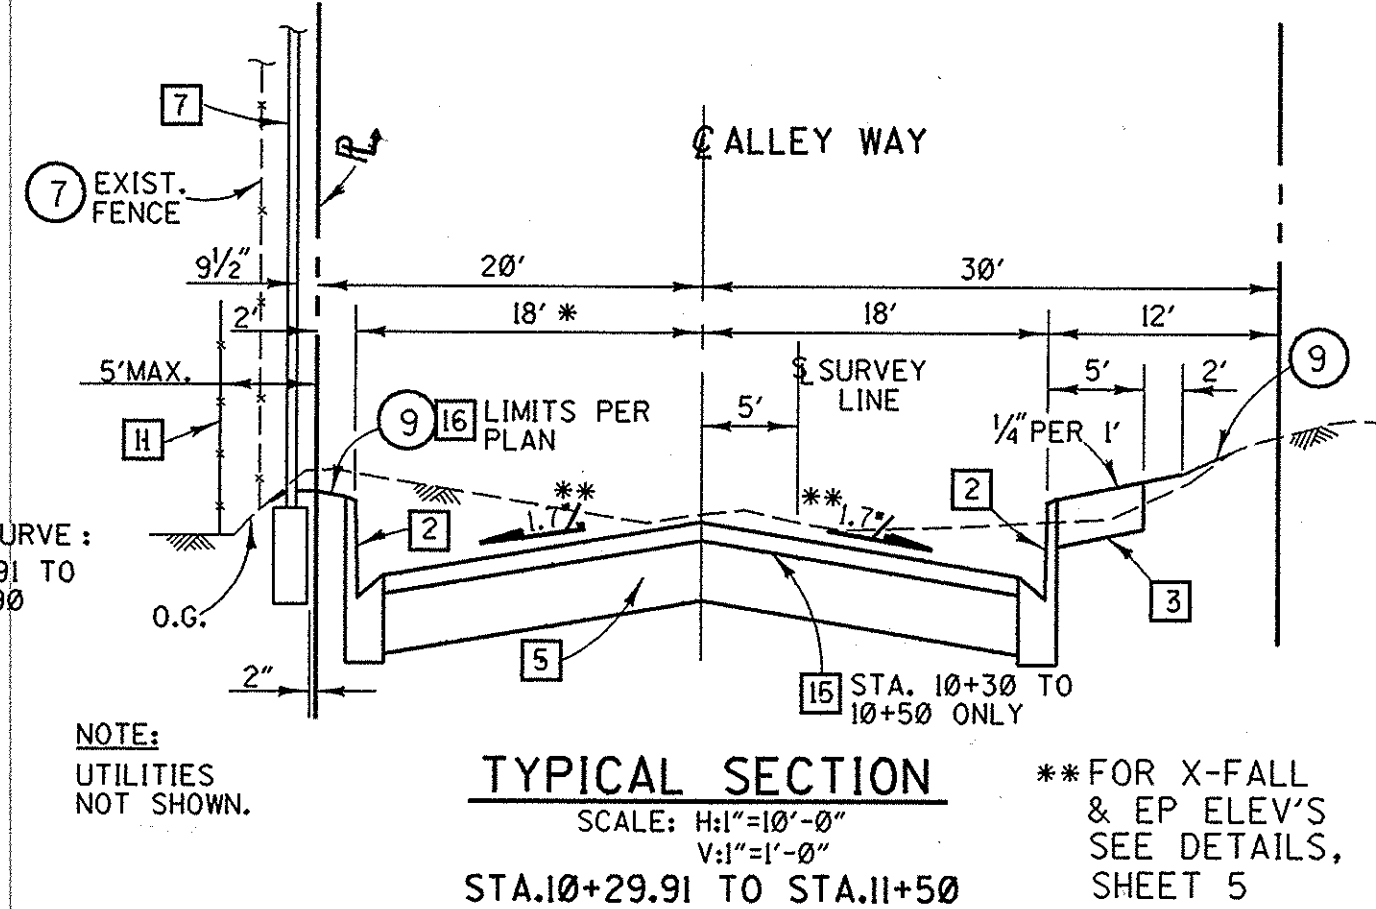

ORANGE COUNTY PUBLIC FACILITIES AND RESOURCES DEPARTMENT		SPRING STREET PRIVATE ALLEY IMPROVEMENTS	
PLAN AND PROFILE STA. 10+09.00 TO STA. 11+50.00		SHEET 2 OF 7	
DESIGNED: TED RIGONI		CHECKED: ED KUAN	
DRAWN: H.P. M.D.		DATE: 9/12/94	
SCALE: AS SHOWN		DRAWING NO.	