

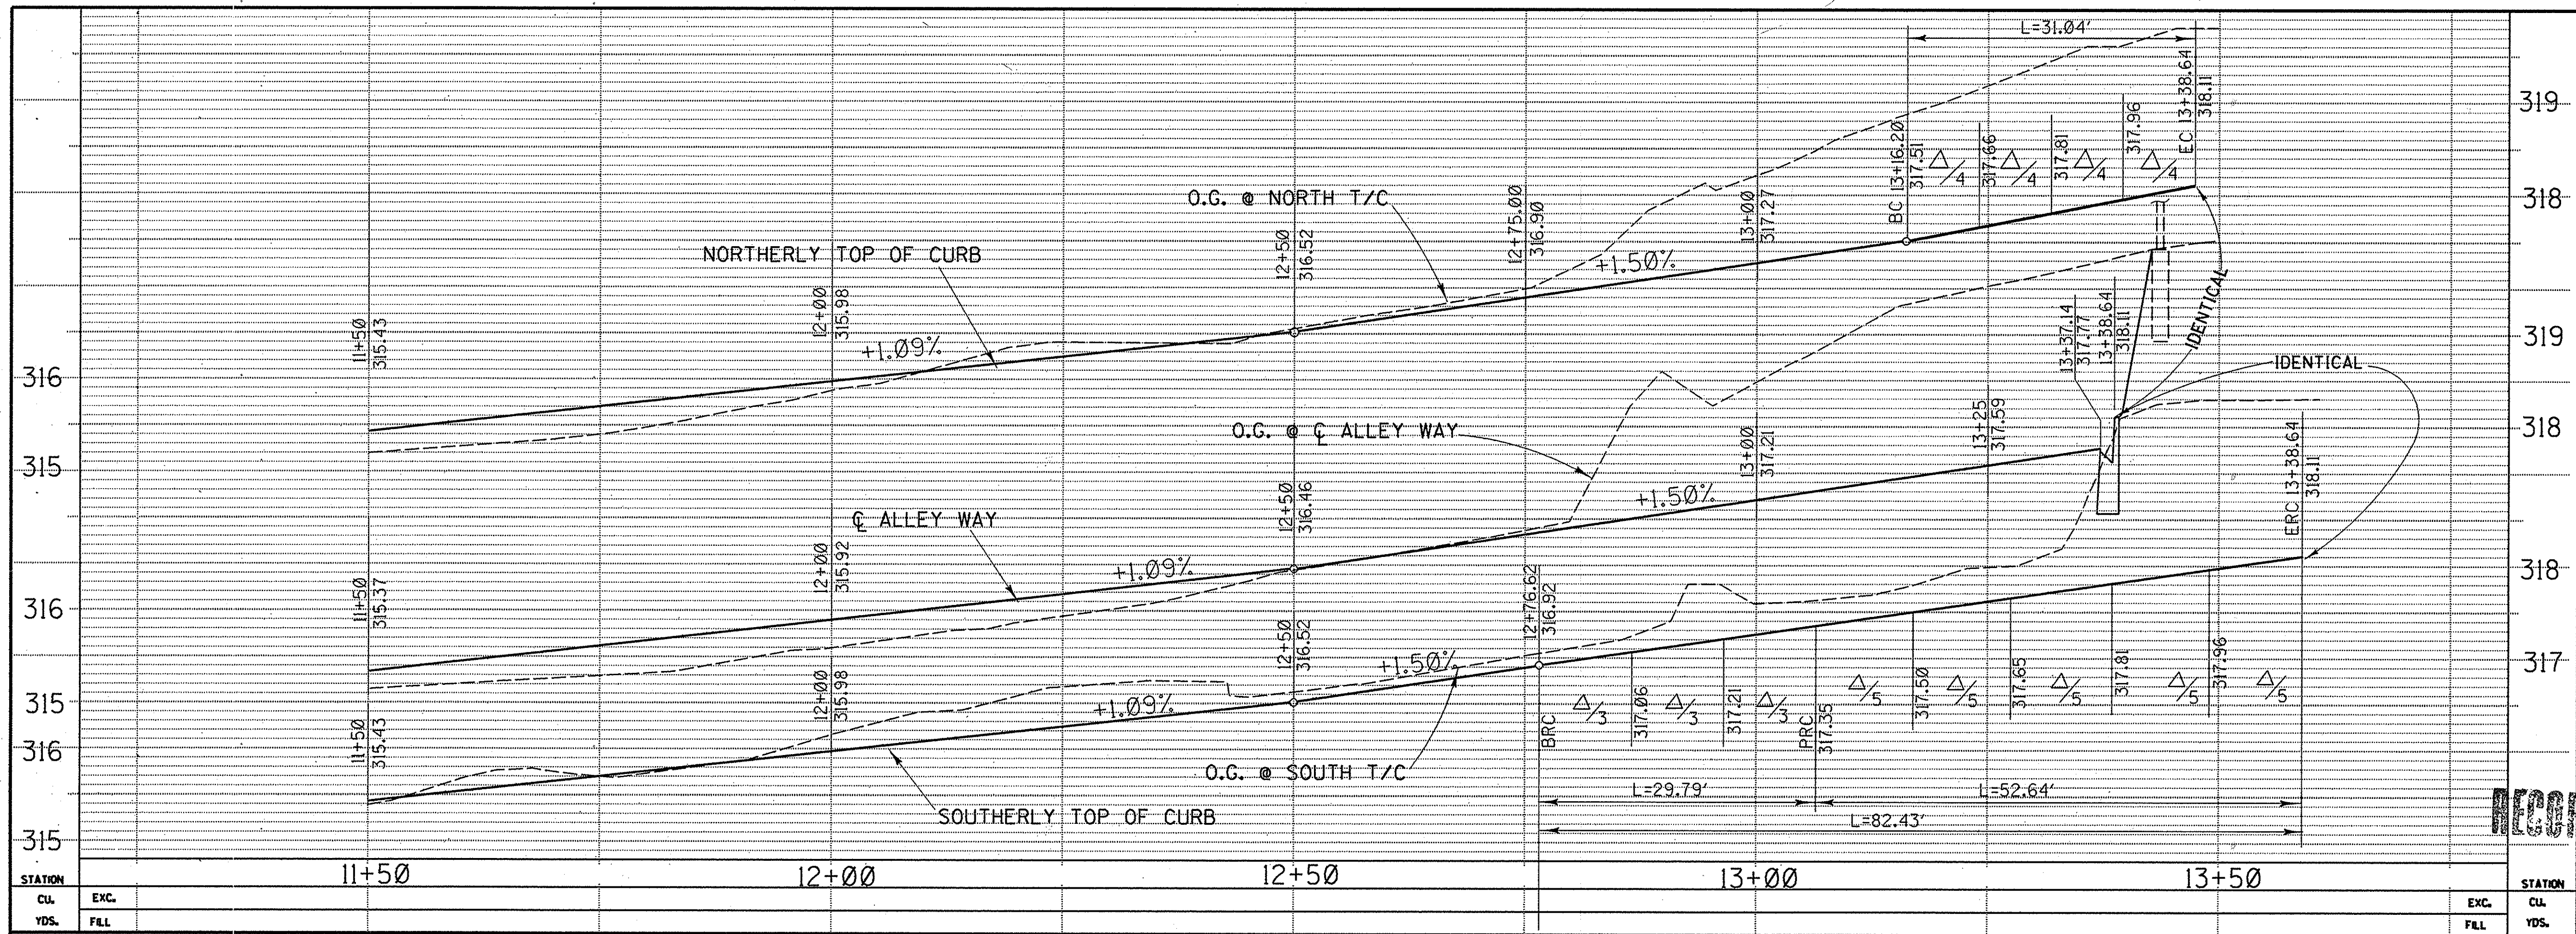


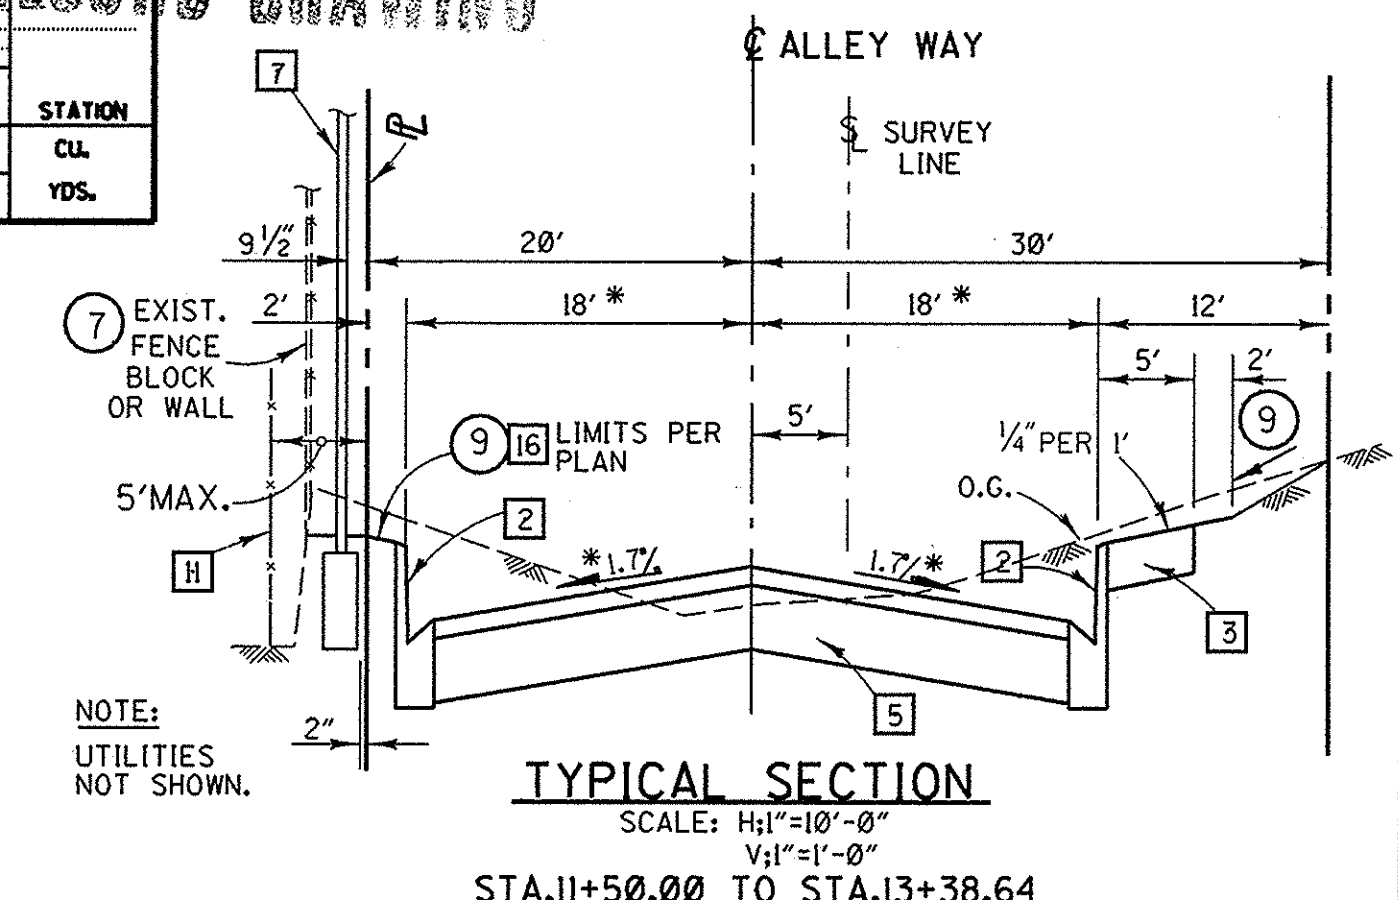

- CONSTRUCTION NOTES**
- 2 CONSTRUCT A2-6 CURB & GUTTER PER PF&RD STD. PLAN 120-0-OC & PLAN & PROFILE.
 - 3 CONSTRUCT P.C.C. SIDEWALK PER PF&RD STD PLAN NO. 1205 & PLAN.
 - 4 CONSTRUCT P.C.C. DRIVEWAY APPROACH PER PF&RD STD PLAN NO. 1209, PLAN AND PER DETAILS.
 - 5 CONSTRUCT 0.25' AC OVER 0.40' AB PER PLAN, PROFILE AND TYPICAL SECTION.
 - 6 CONSTRUCT 0.40' AC/NS TO MATCH EXISTING PER PLAN & DETAILS.
 - 7 CONSTRUCT 6' HIGH MASONRY BLOCKWALL PER PF&RD STD PLAN 1414 & PLAN.
 - 11 INSTALL TEMPORARY SECURITY FENCE PER TYPICAL SECTION, SPECIAL PROVISIONS AND AS DIRECTED BY ENGINEER.
 - 12 INSTALL TYPE N MARKERS PER PF&RD STANDARD PLAN 1401 & PLAN & DETAILS.
 - 13 INSTALL FIRE LANE SIGN PER PLAN & SPECIAL PROVISIONS.
 - 14 PAINT CURB "OSHA SAFETY RED" PER PLAN & SPECIAL PROVISIONS.
 - 16 PLACE 0.25' AC/NS PER PLAN, DETAILS AND AS DIRECTED BY ENGINEER.

RECORD DRAWING

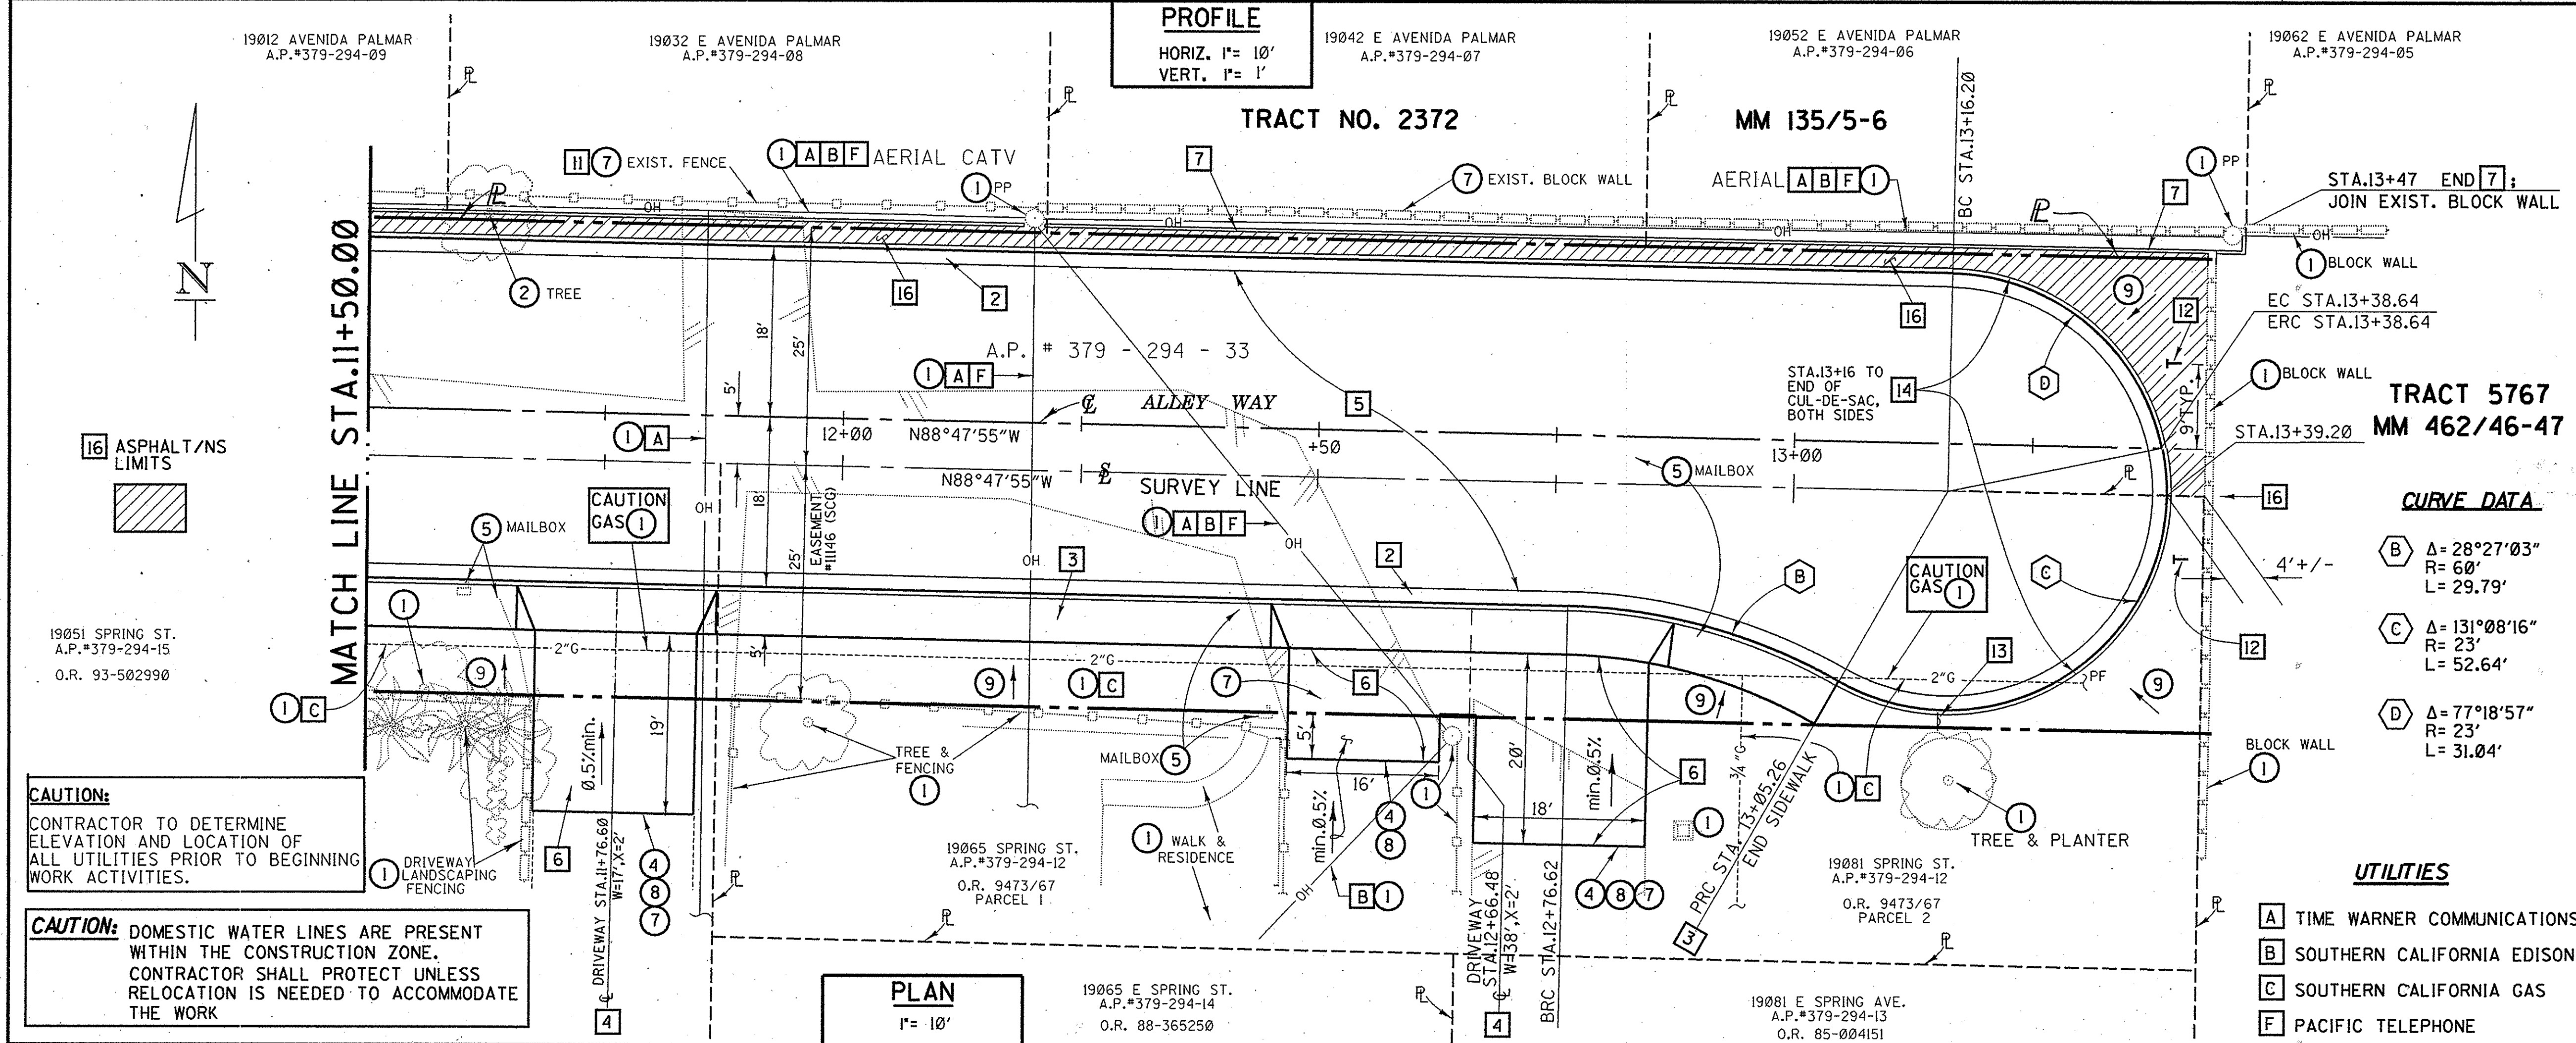

- LEGEND**
- 1 PROTECT IN PLACE
 - 2 REMOVE
 - 3 TO BE ADJUSTED TO GRADE BY OTHERS
 - 4 SAWCUT/JOIN
 - 5 REMOVE AND RELOCATE AS SHOWN ON PLAN
 - 6 TO BE RELOCATED BY OTHERS
 - 7 REMOVE INTERFERING PORTIONS
 - 8 JOIN EXISTING PAVEMENT AND FEATHER TO MATCH EXISTING
 - 9 GRADE TO DRAIN

**TRACT 5767
MM 462/46-47**

CURVE DATA

- B $\Delta = 28^\circ 27' 03''$
R = 60'
L = 29.79'
- C $\Delta = 131^\circ 08' 16''$
R = 23'
L = 52.64'
- D $\Delta = 77^\circ 18' 57''$
R = 23'
L = 31.04'

UTILITIES

- A TIME WARNER COMMUNICATIONS
B SOUTHERN CALIFORNIA EDISON
C SOUTHERN CALIFORNIA GAS
F PACIFIC TELEPHONE

ORANGE COUNTY PUBLIC FACILITIES AND RESOURCES DEPARTMENT		
SPRING STREET PRIVATE ALLEY IMPROVEMENTS		
PLAN AND PROFILE STA. 11+50.00 TO STA. 13+43.20		
DESIGNED: TED RIGONI		
DRAWN: H.P.M.D. CHECKED: ED KWAN		
SCALE: AS SHOWN	DATE: 9/26/17	DRAWING NO. 3 OF 7