


### DETAILS FOR JOINING EXISTING FENCE OR WALL TO PROPOSED WALL

NO SCALE

8" BLOCKS ADJACENT TO JOINT (TYP.)

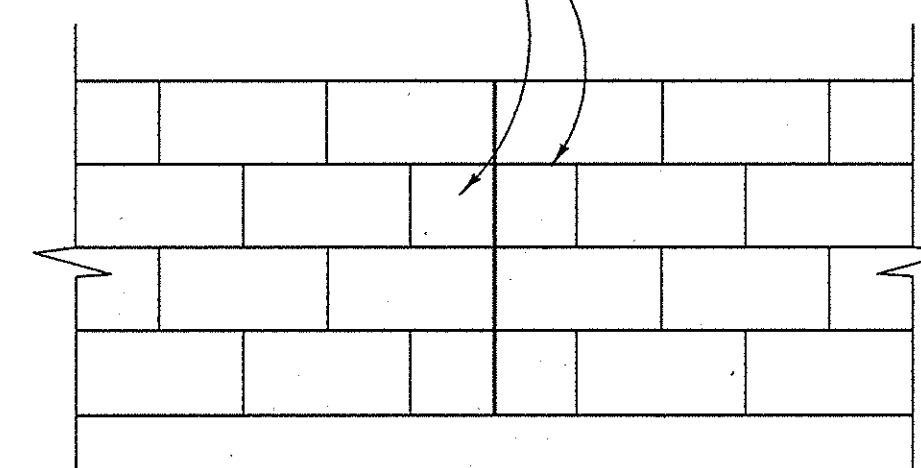

### CONSTRUCTION NOTES


- 7 CONSTRUCT 6' HIGH MASONRY BLOCK WALL PER PF&RD STD PLAN 1414, PLAN & DETAILS.
- 16 PLACE Ø.25' AC/NS PER PLAN, DETAILS AND AS DIRECTED BY ENGINEER.

### LEGEND


- 1 PROTECT IN PLACE
- 2 REMOVE
- 4 SAWCUT/JOIN
- 7 REMOVE INTERFERING PORTIONS
- 9 GRADE TO DRAIN

**RECORD DRAWING**


1/2 0 1 2  
 3 inches on original drawing

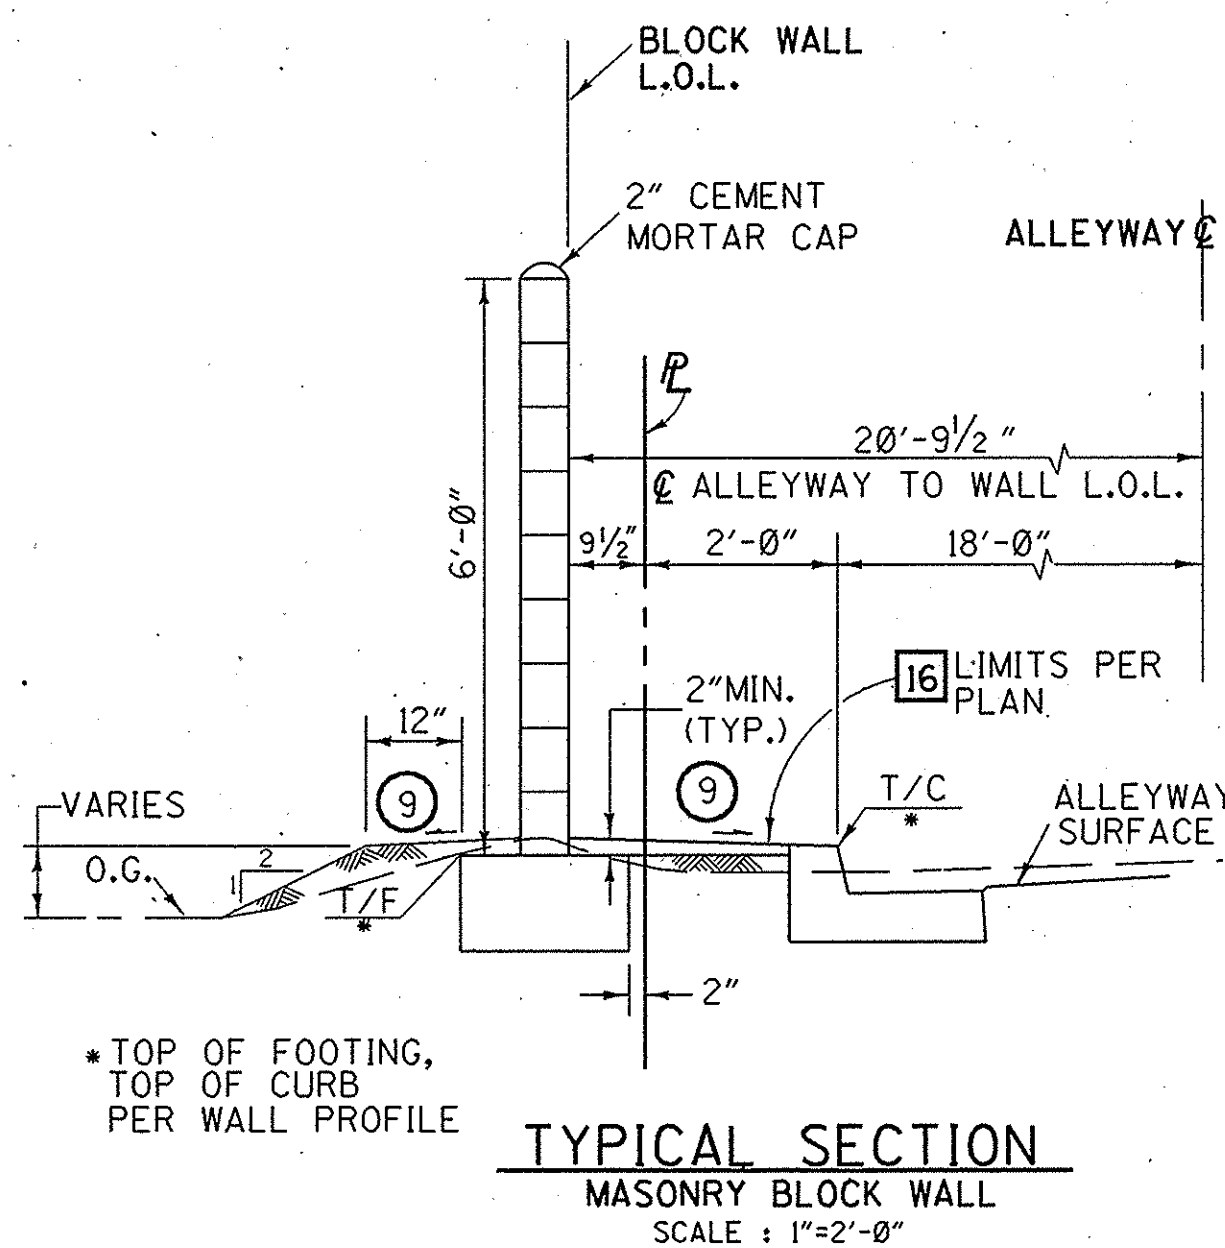

NOTE:  
 WALL REINFORCEMENT, UTILITIES AND EXISTING WALLS NOT SHOWN.

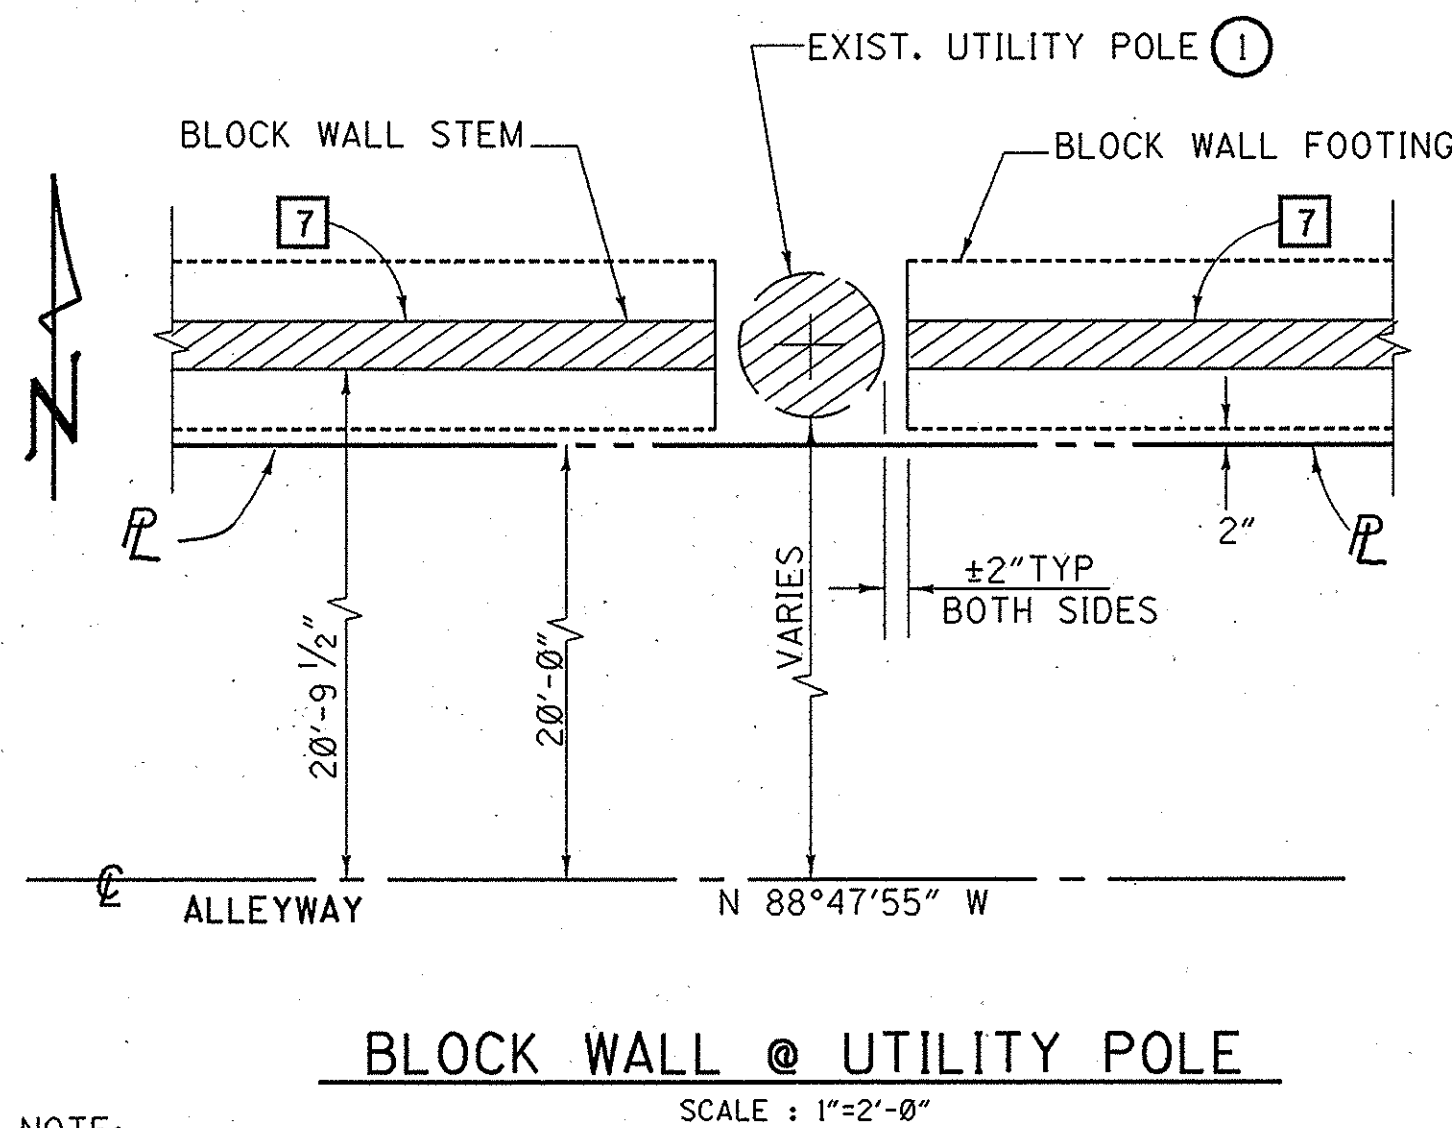

NOTE:  
 STREET IMPROVEMENTS AND UTILITIES NOT SHOWN.

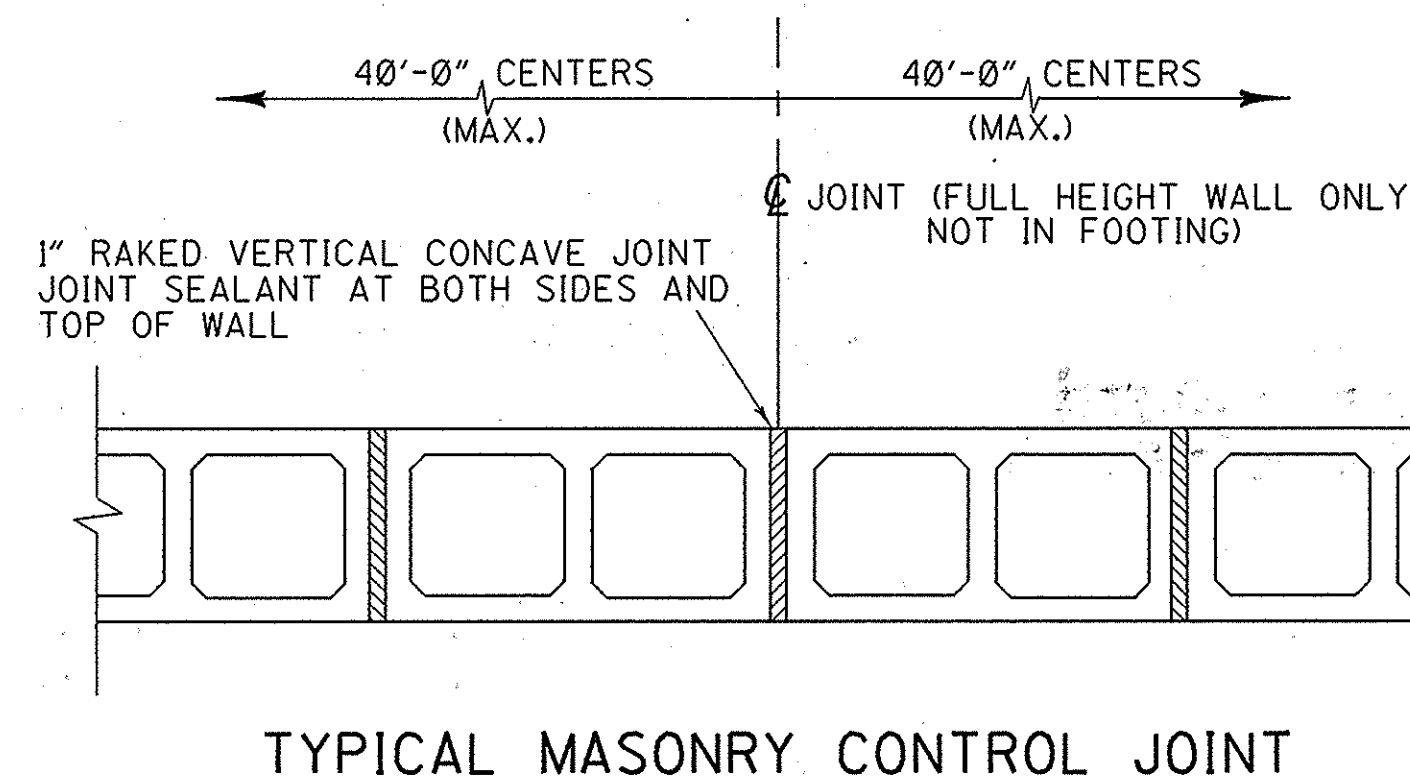

NOTE:  
 WALL REINFORCEMENT NOT SHOWN.

ORANGE COUNTY PUBLIC FACILITIES AND RESOURCES DEPARTMENT		SPRING STREET PRIVATE ALLEY IMPROVEMENTS	
DESIGNED: TED RIGONI		SHEET 4 OF 7	
DRAWN: H.P./M.D.		CHECKED: ED KWAN	
SCALE: AS SHOWN		DATE: 12/24	
DRAWING NO.		DATE	