

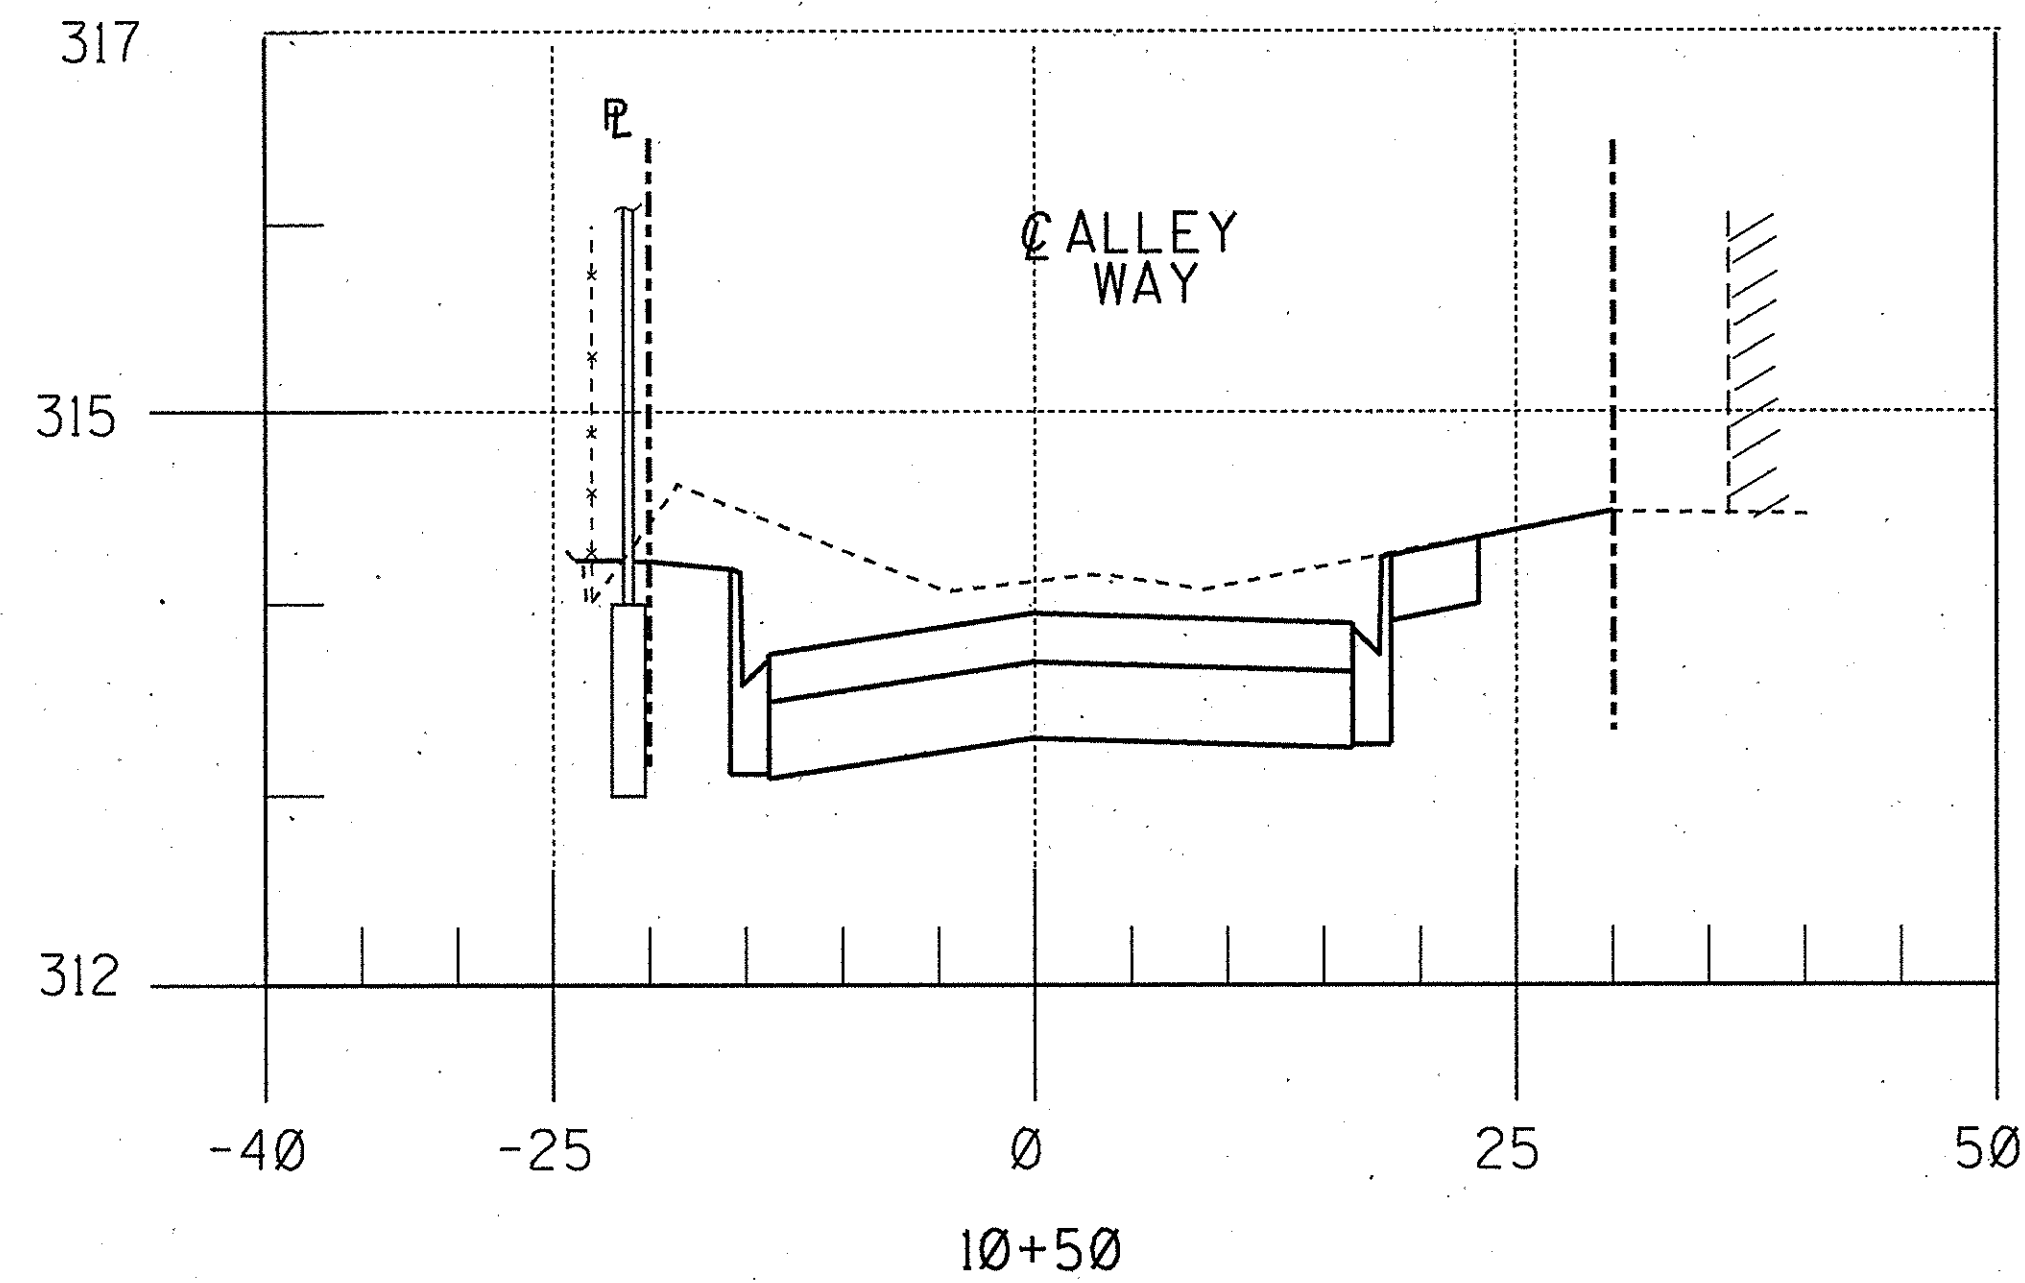
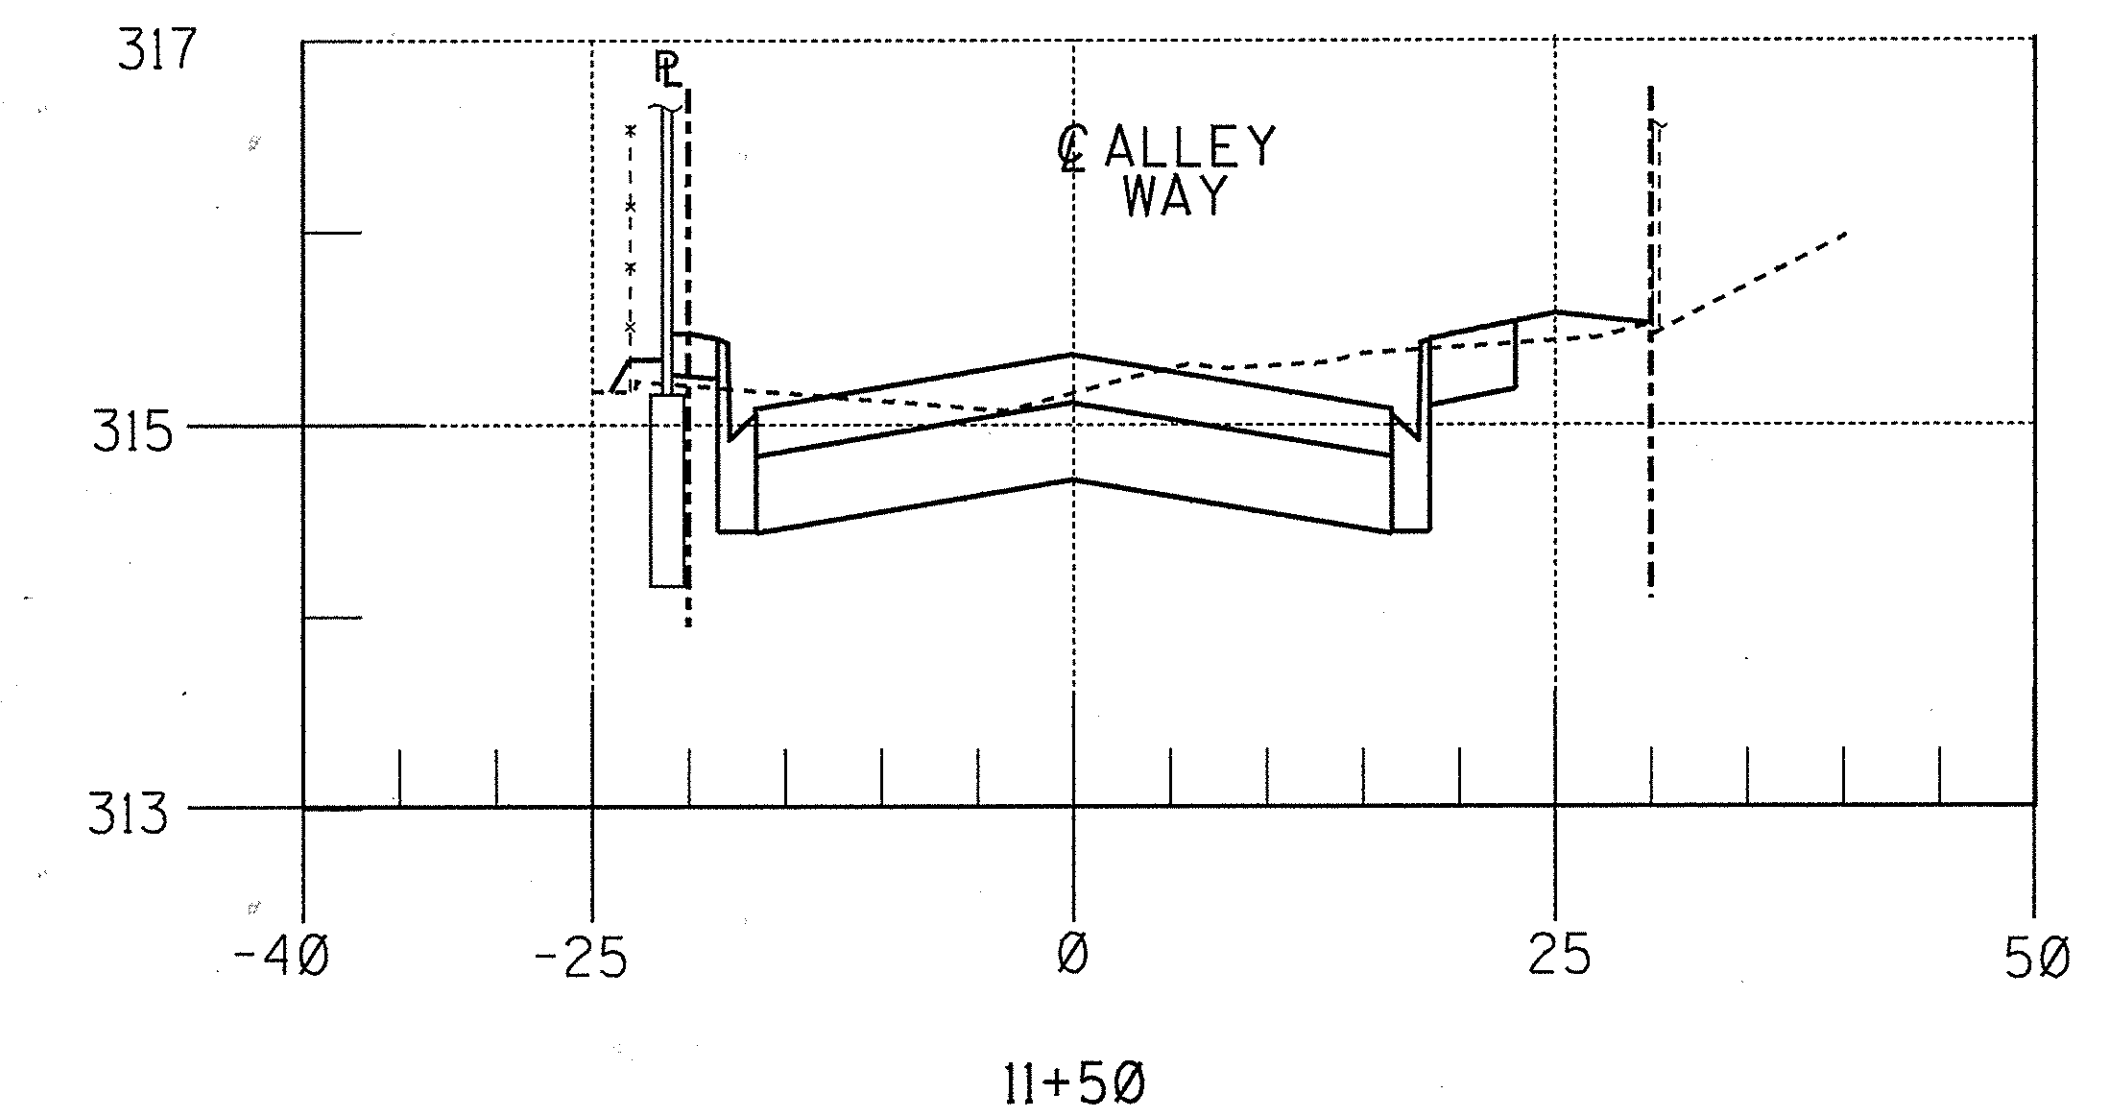
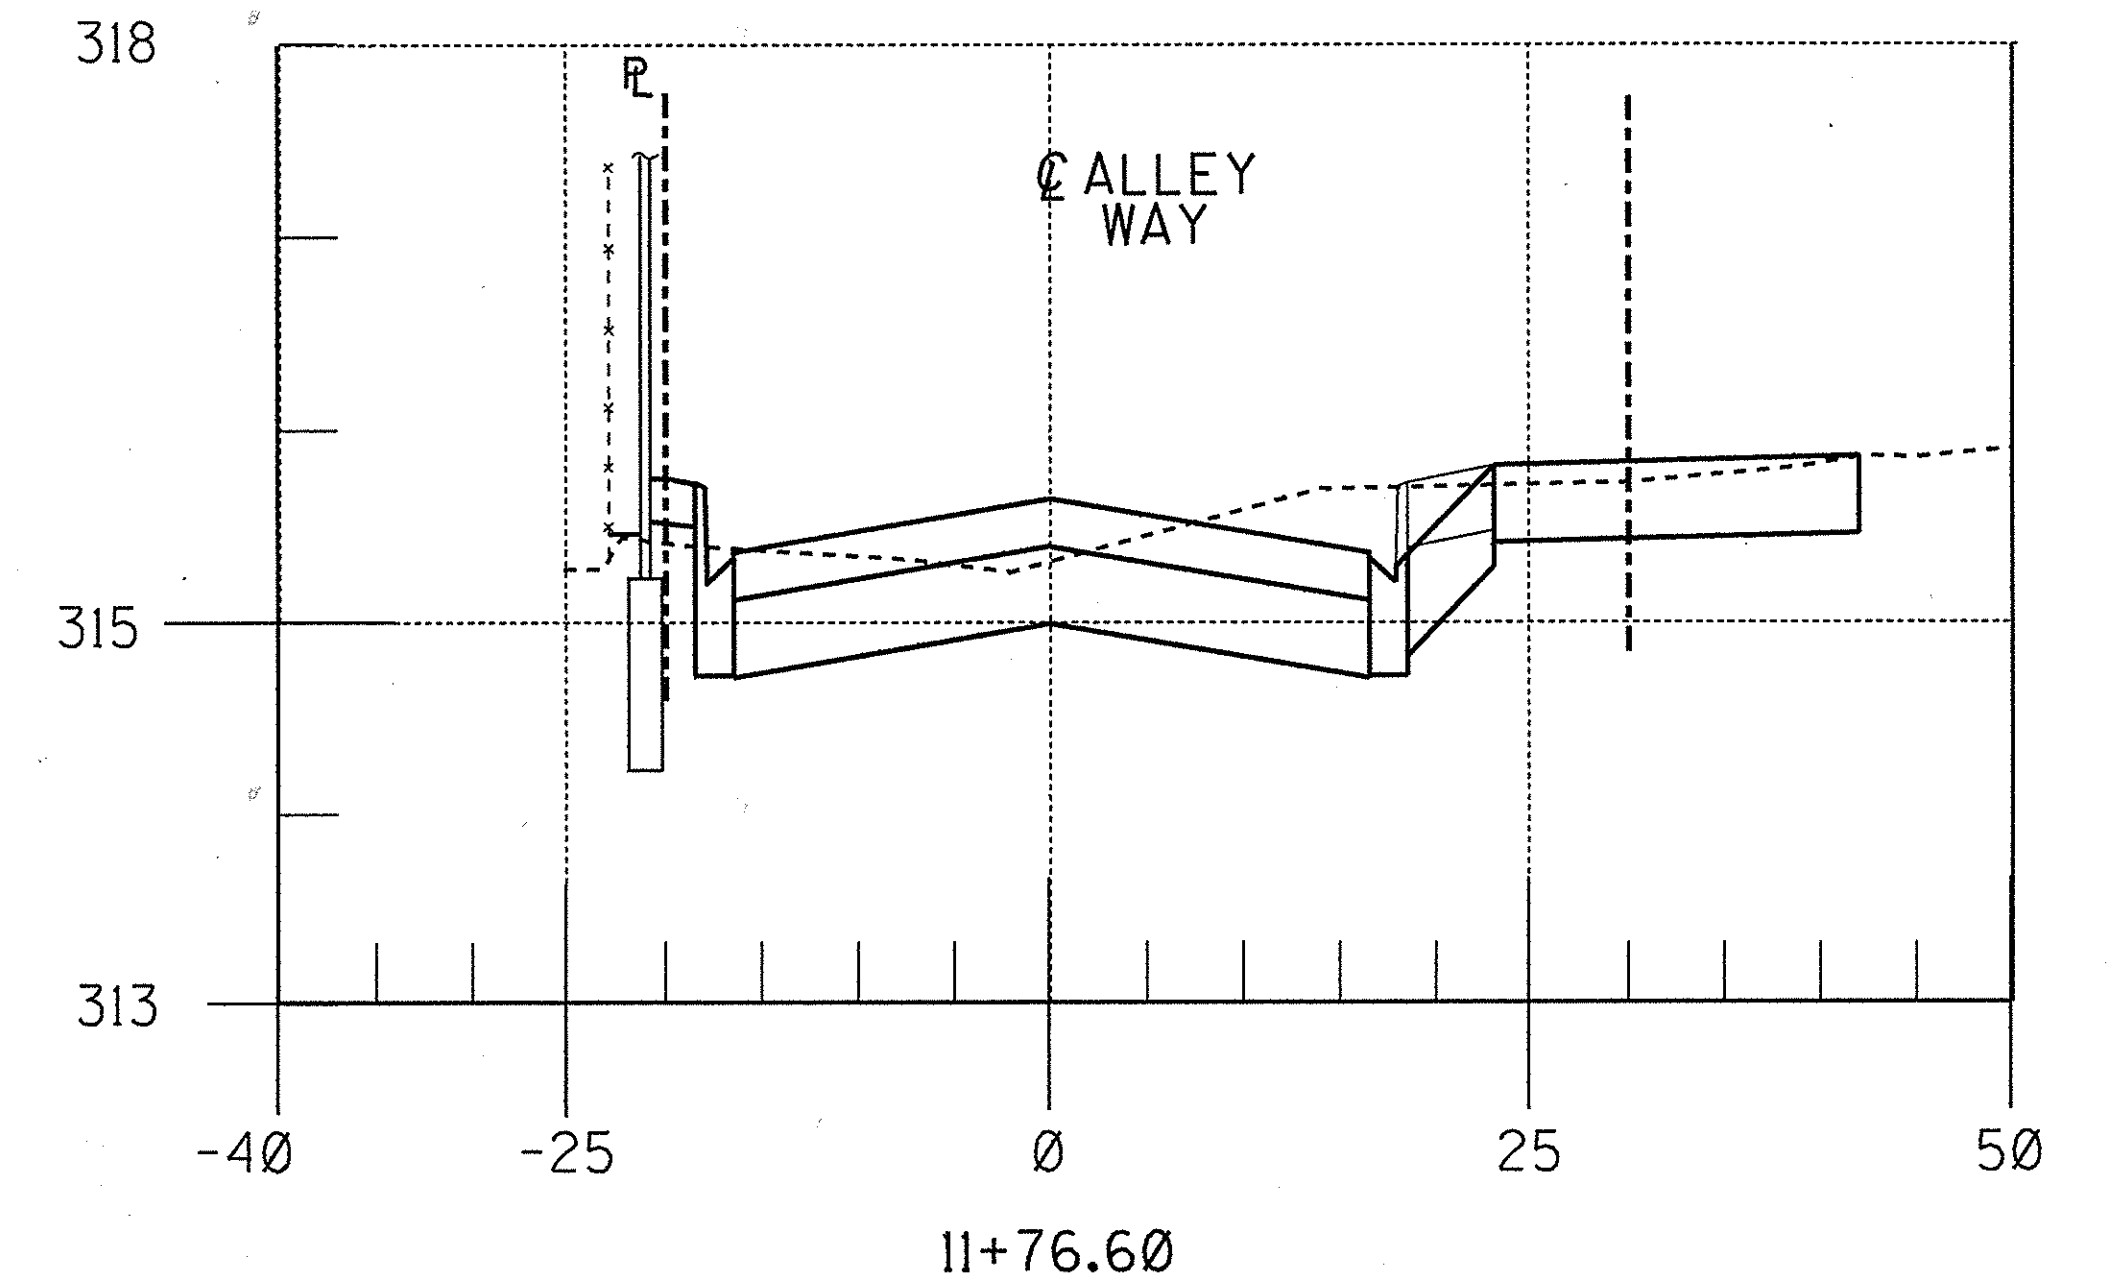
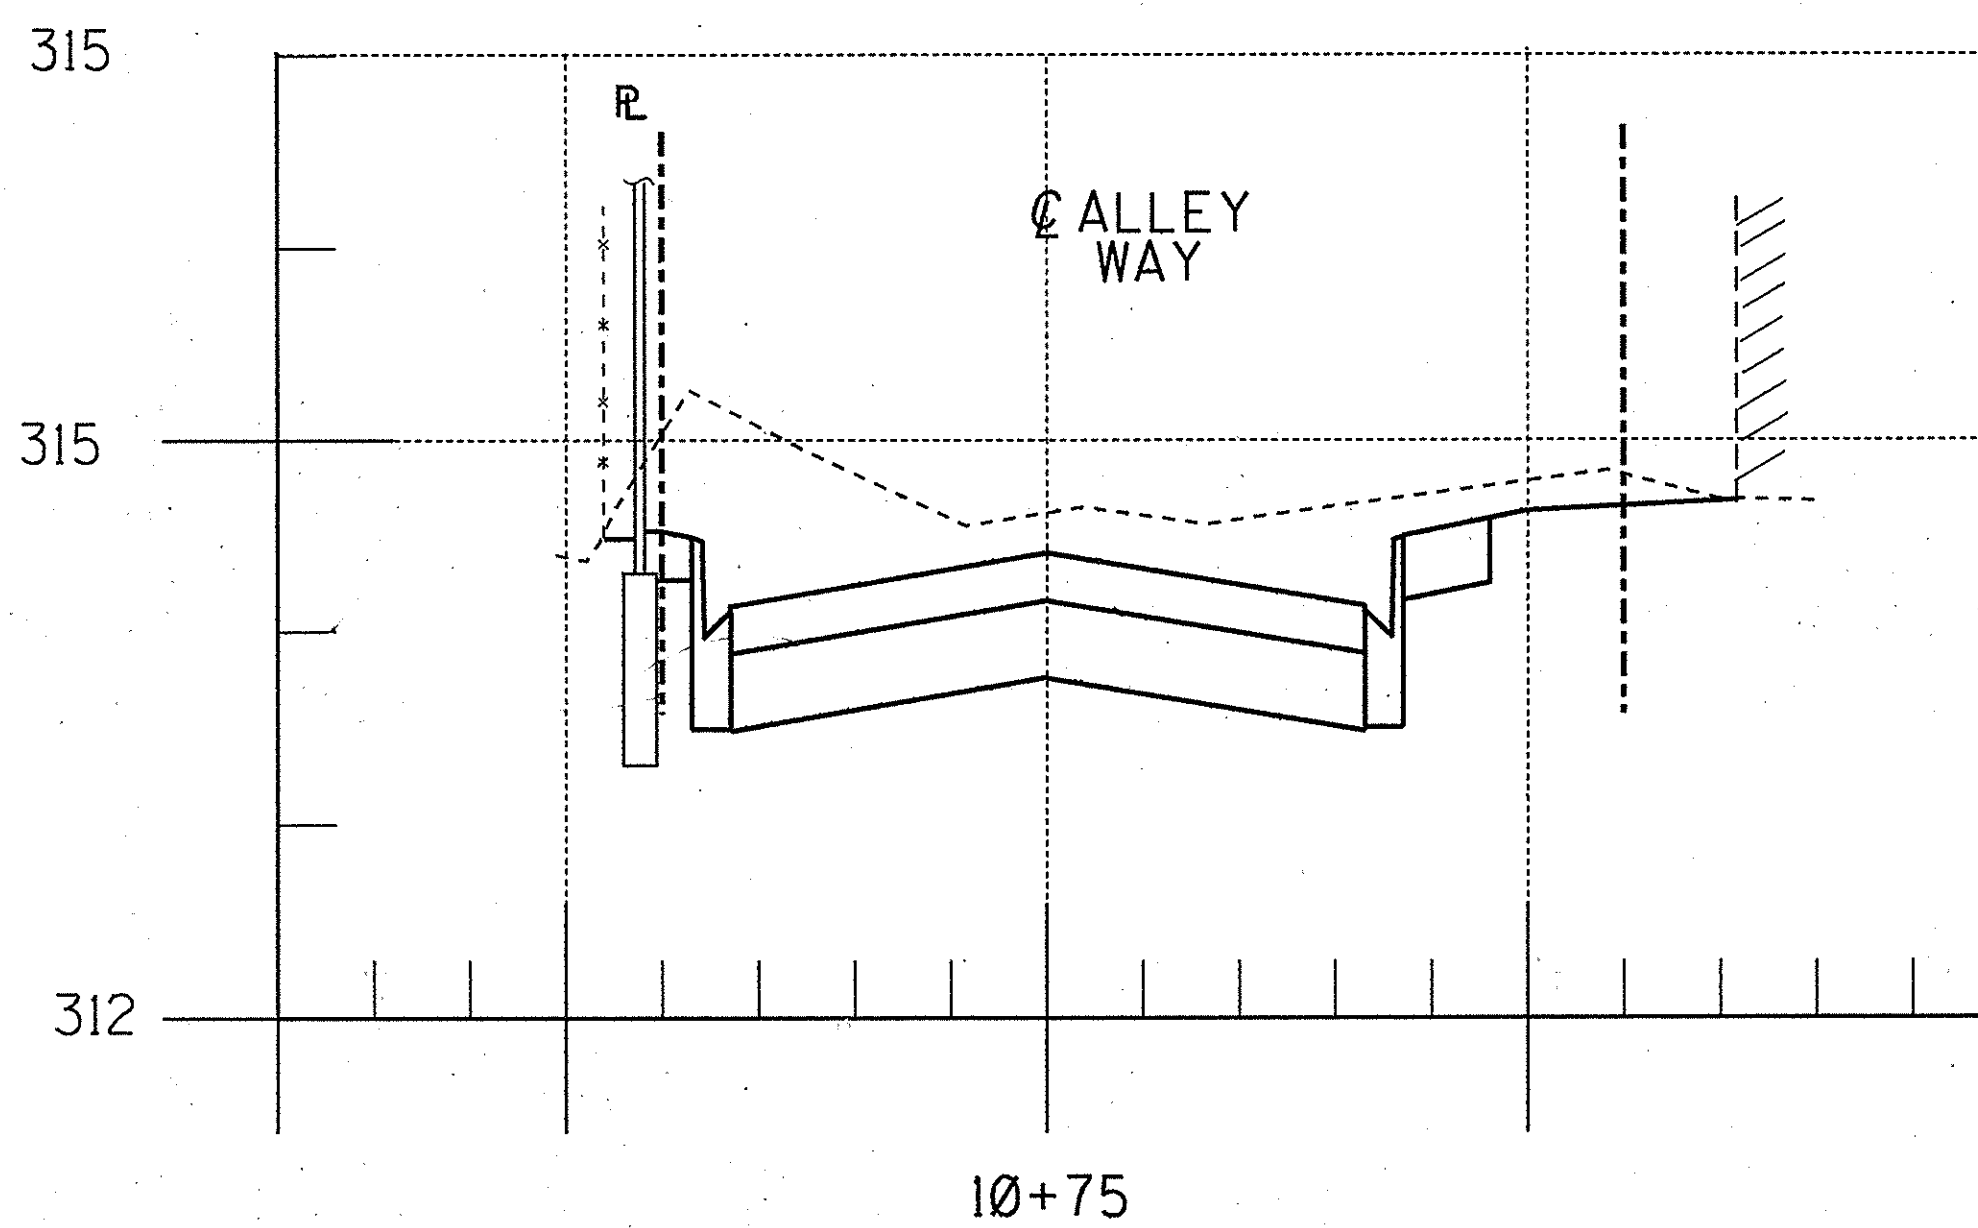
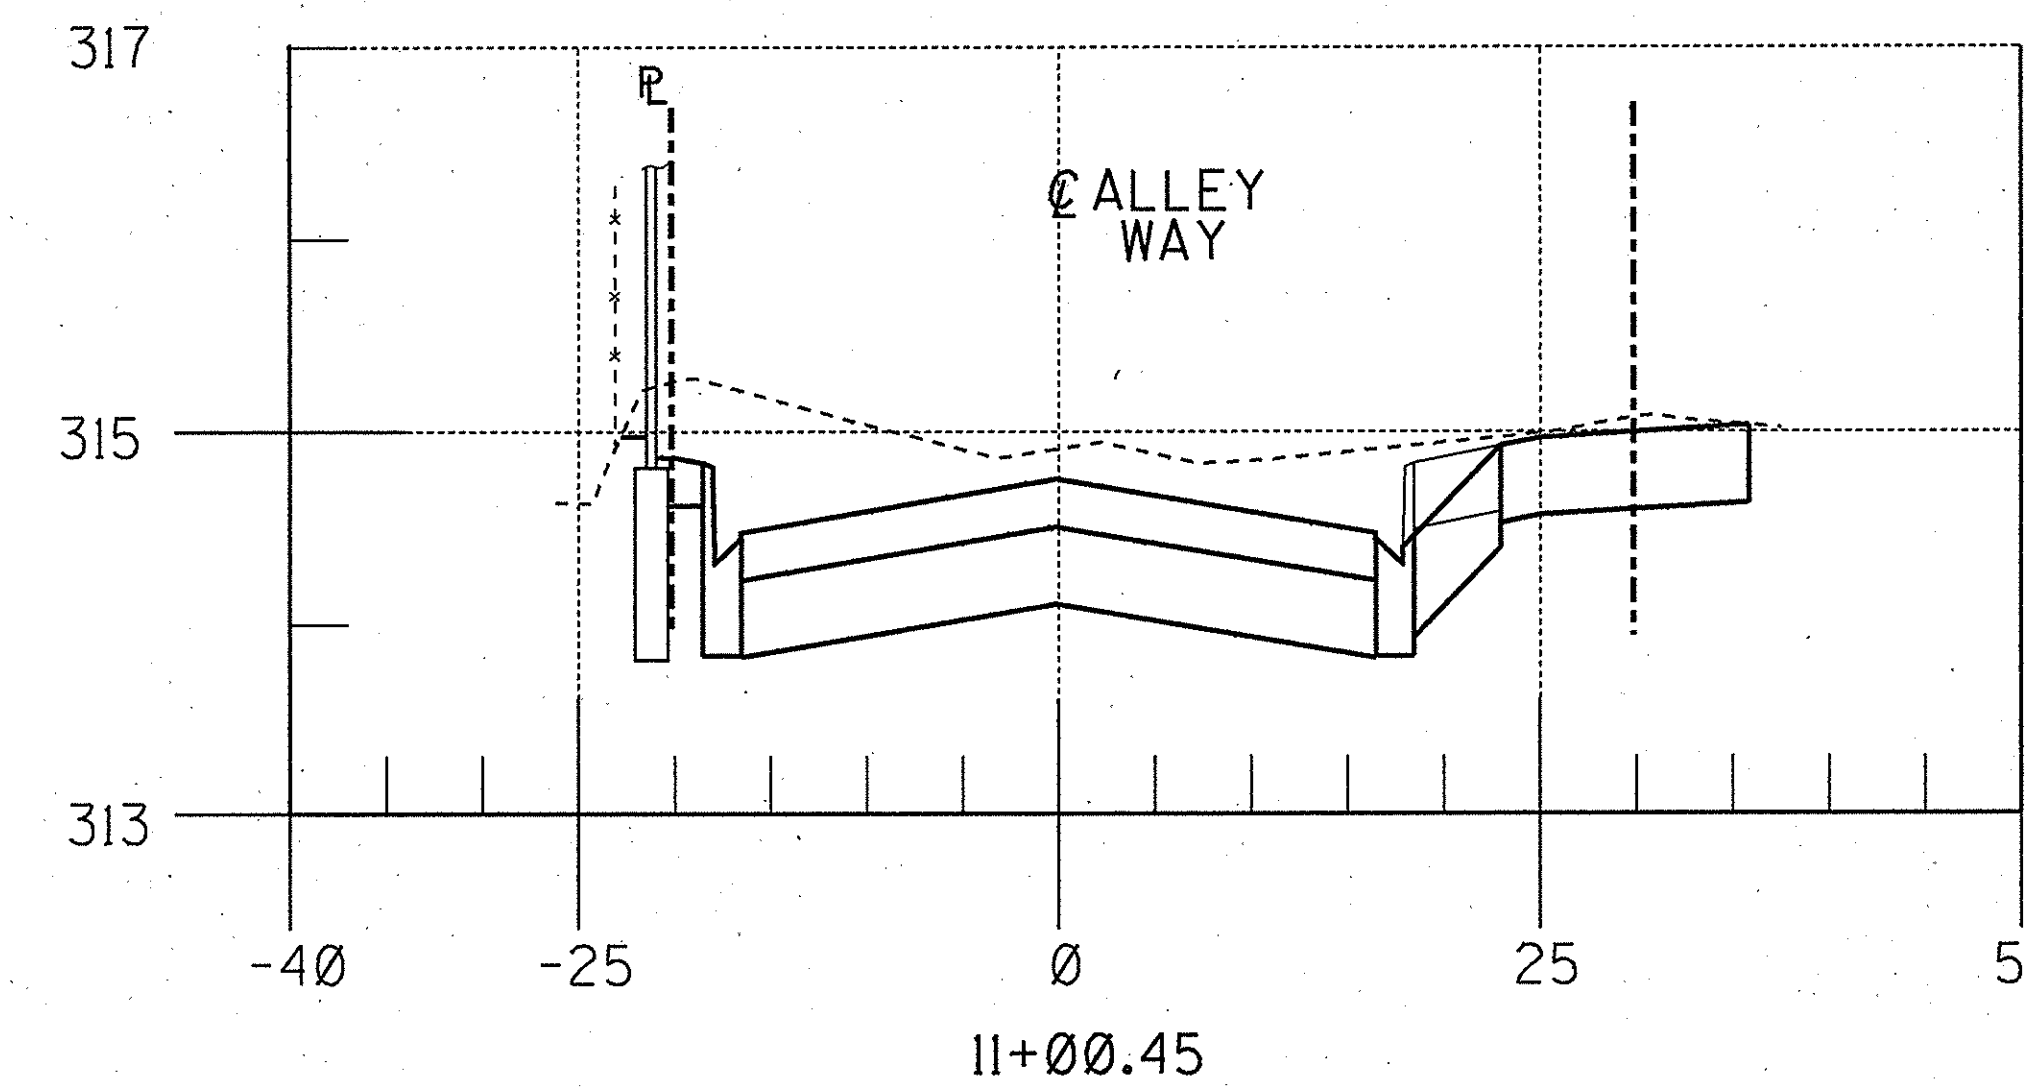
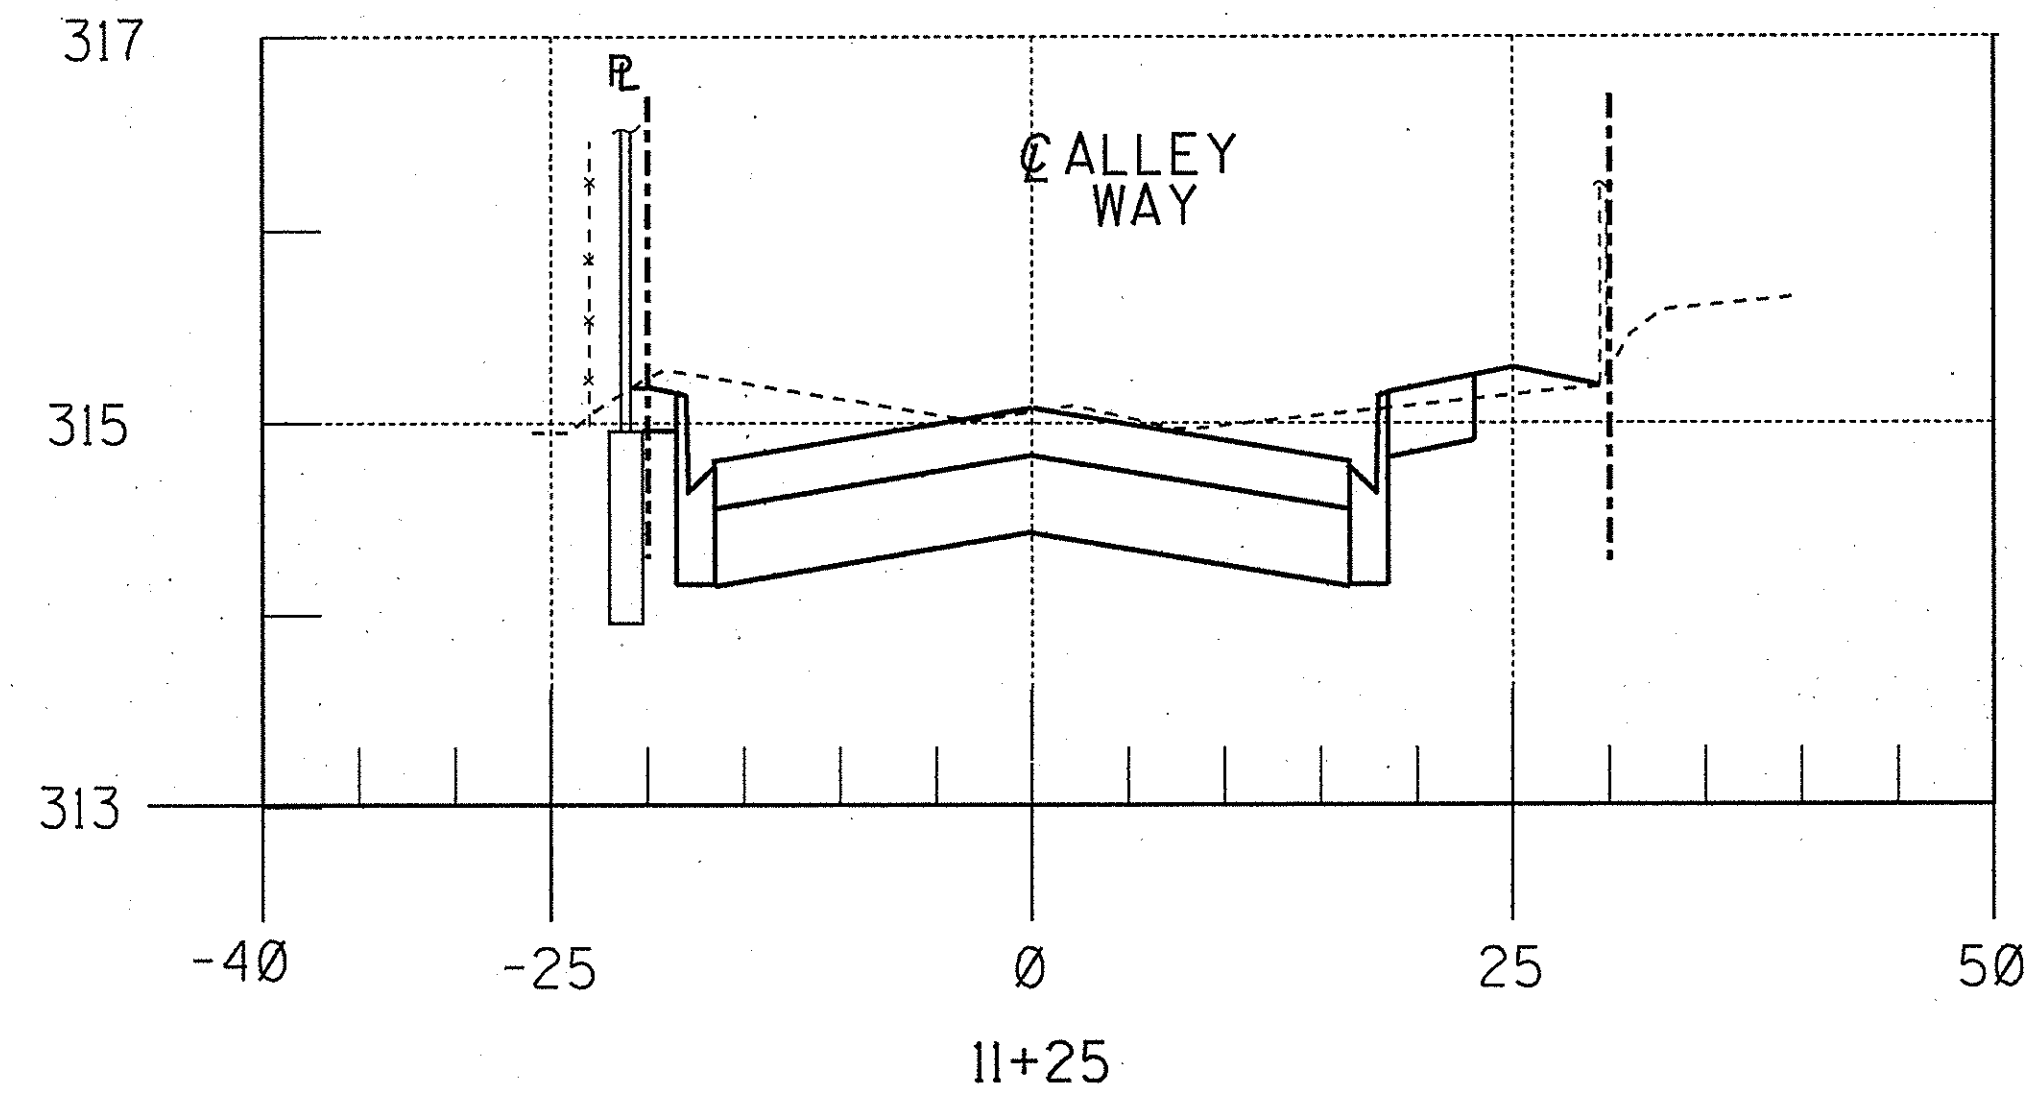


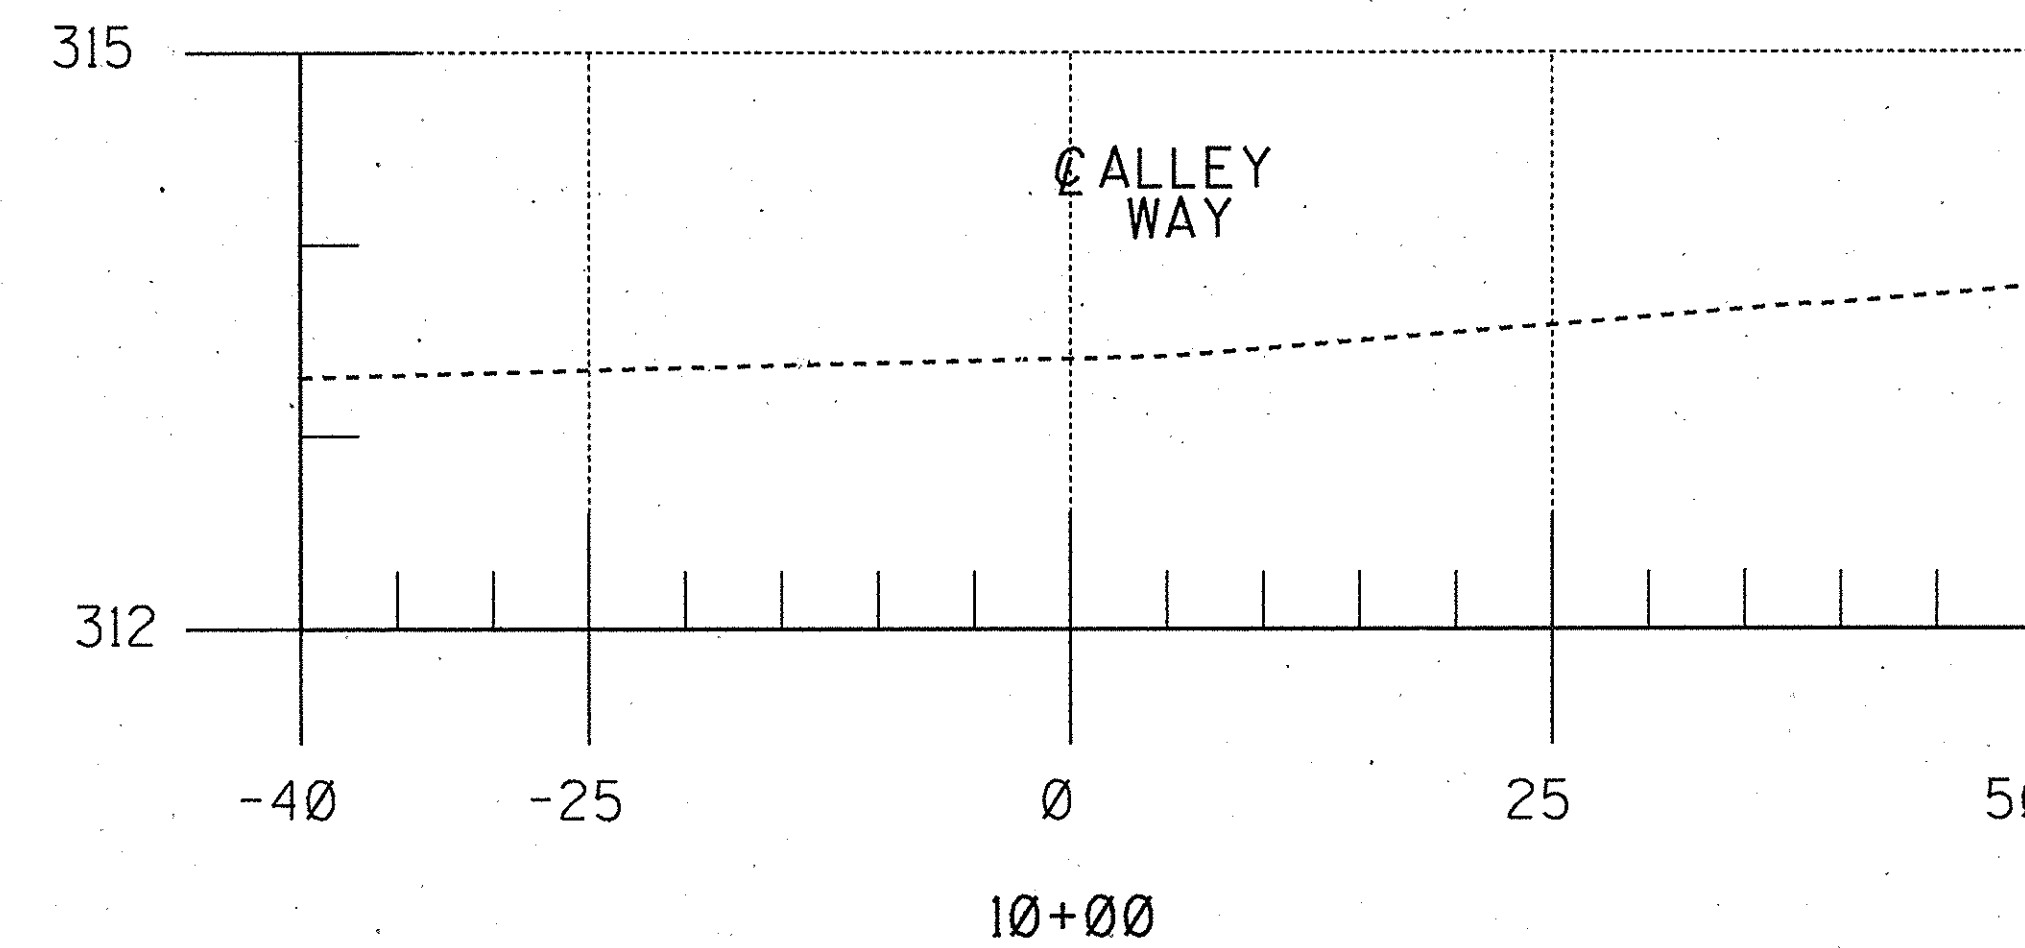

NOTE: FROM STA. 10+30 TO 10+50 =
0.50' PCC PAVEMENT OVER NS.

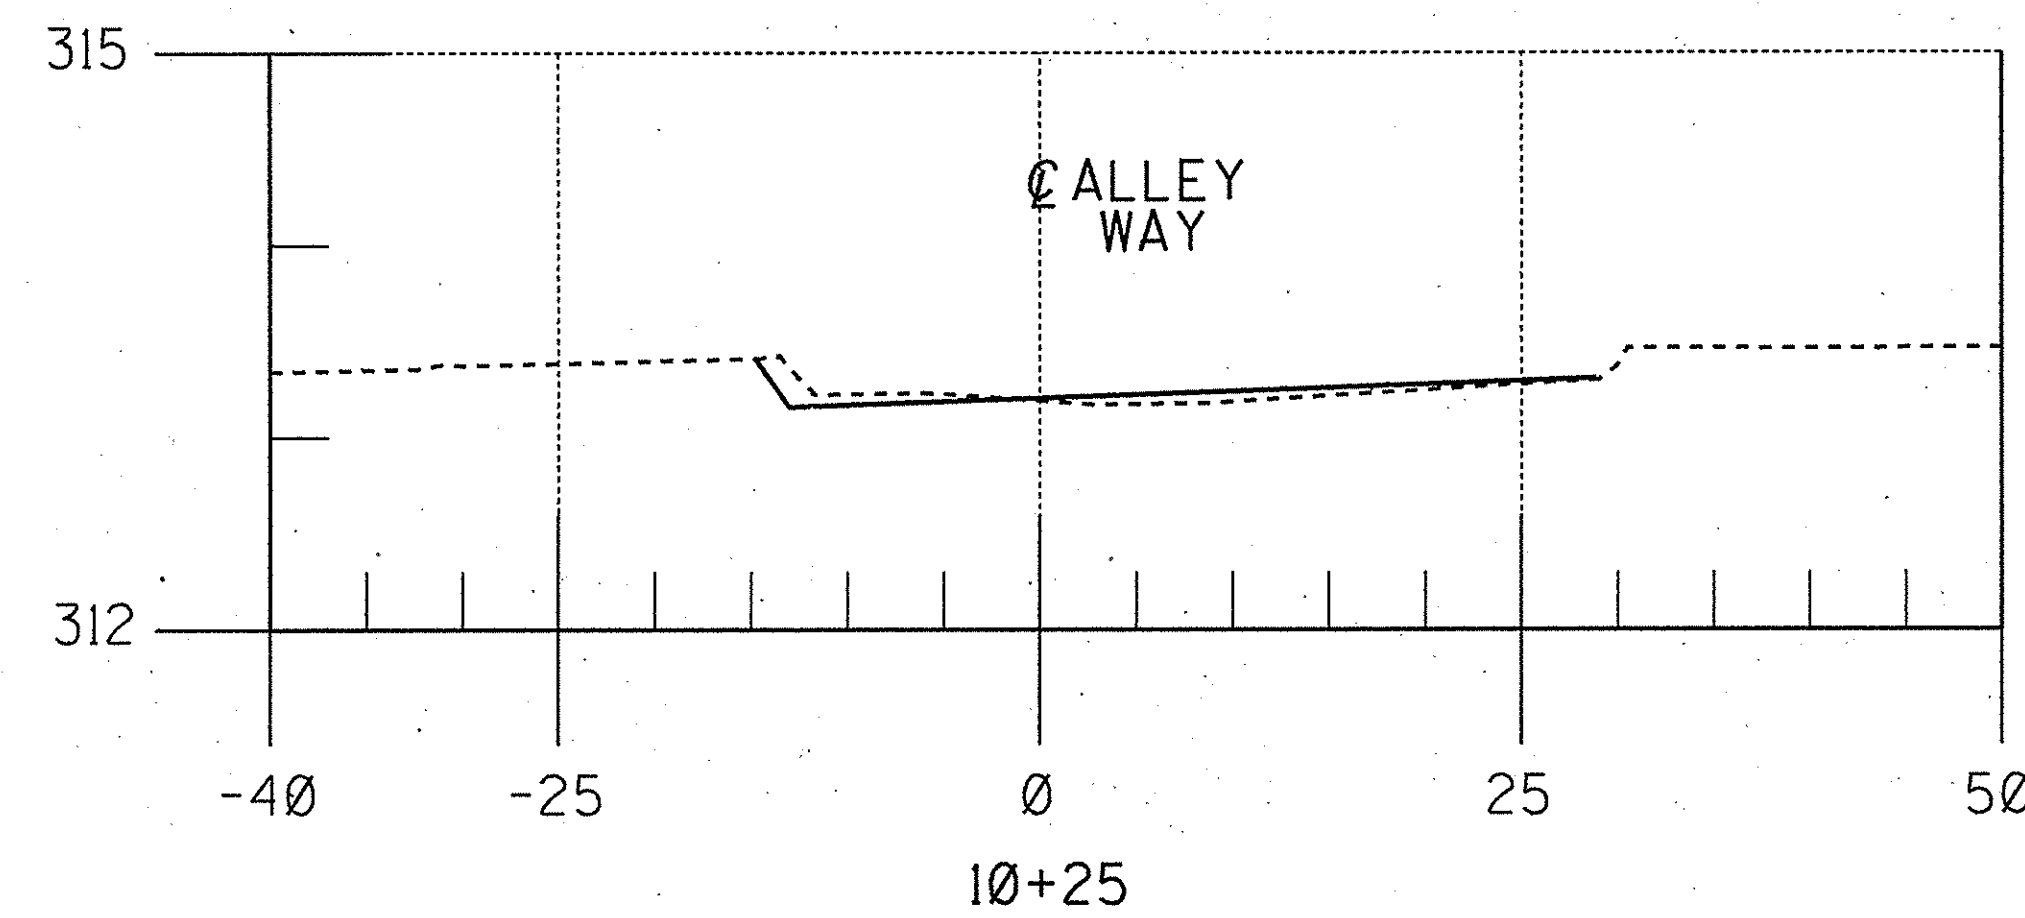

SCALE : H ; 1"=10'-0"
V ; 1"=1'-0"

RECORD DRAWING

ORANGE COUNTY PUBLIC FACILITIES AND RESOURCES DEPARTMENT	
SPRING STREET PRIVATE ALLEY IMPROVEMENTS	
X-SECTIONS	
STA. 10+00.00 TO STA. 11+76.90	
DESIGNED TED RIGONI	CHECKED ED KWAN
SCALE AS SHOWN	DATE
DRAWING NO.	
SHEET 6 OF 7	