
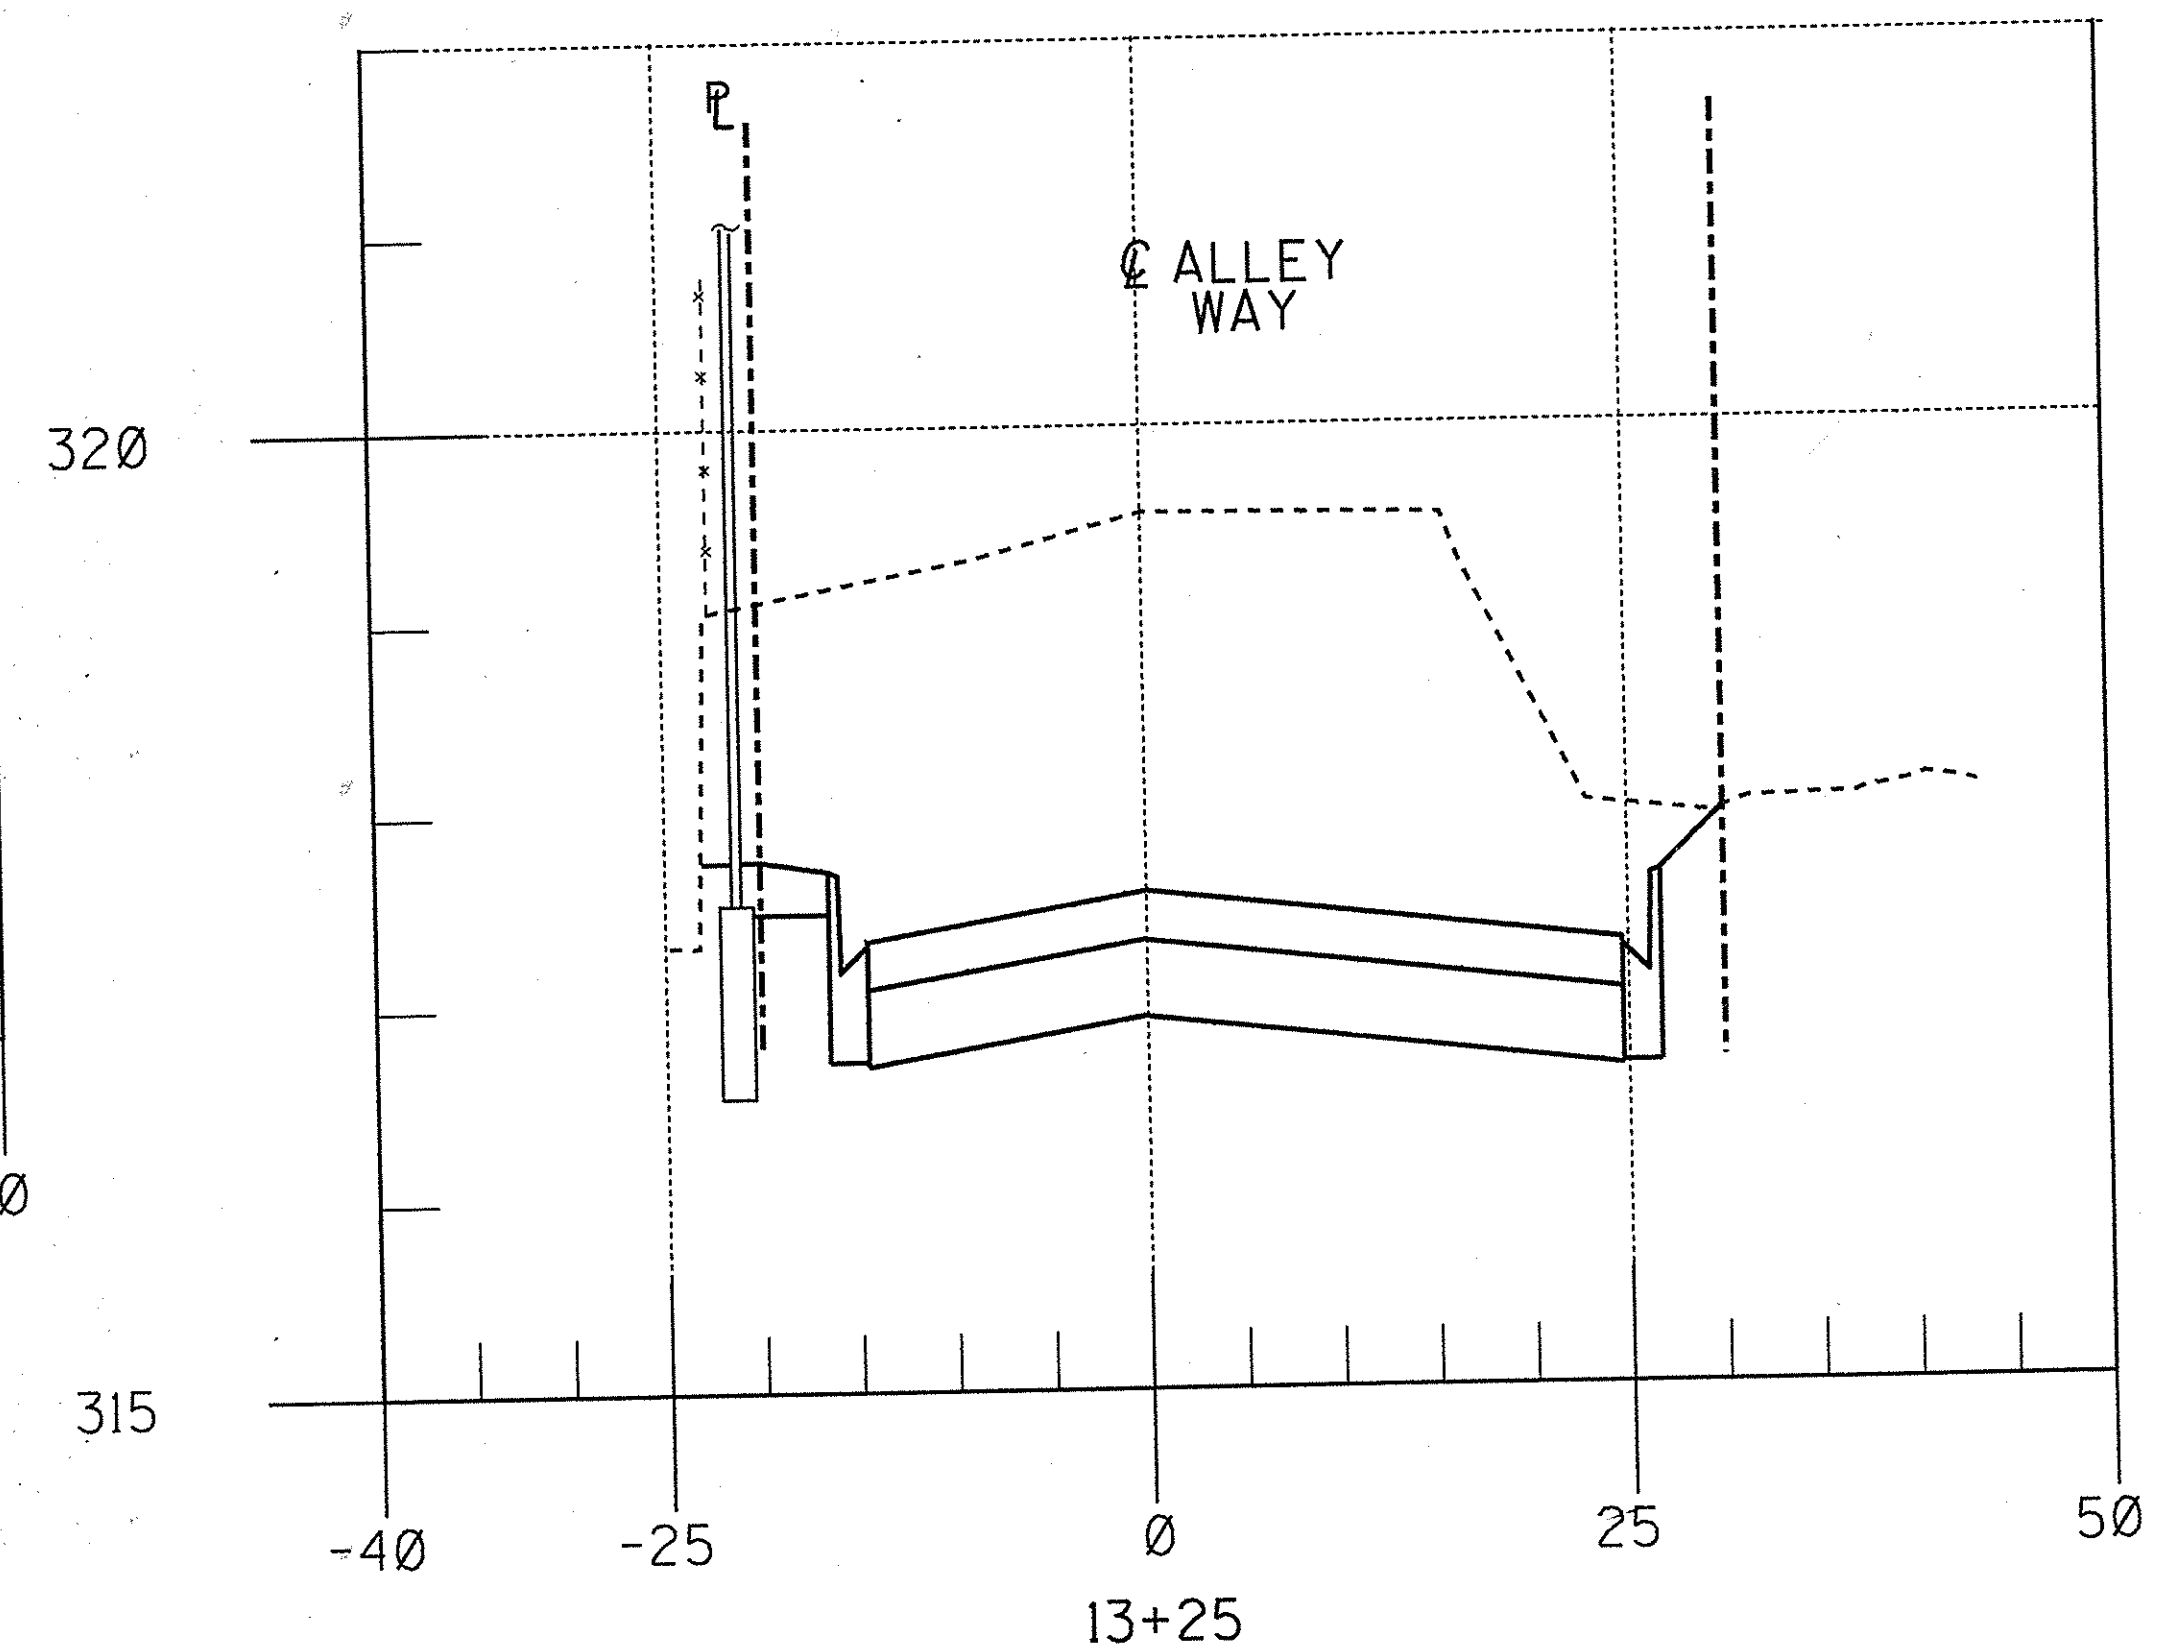
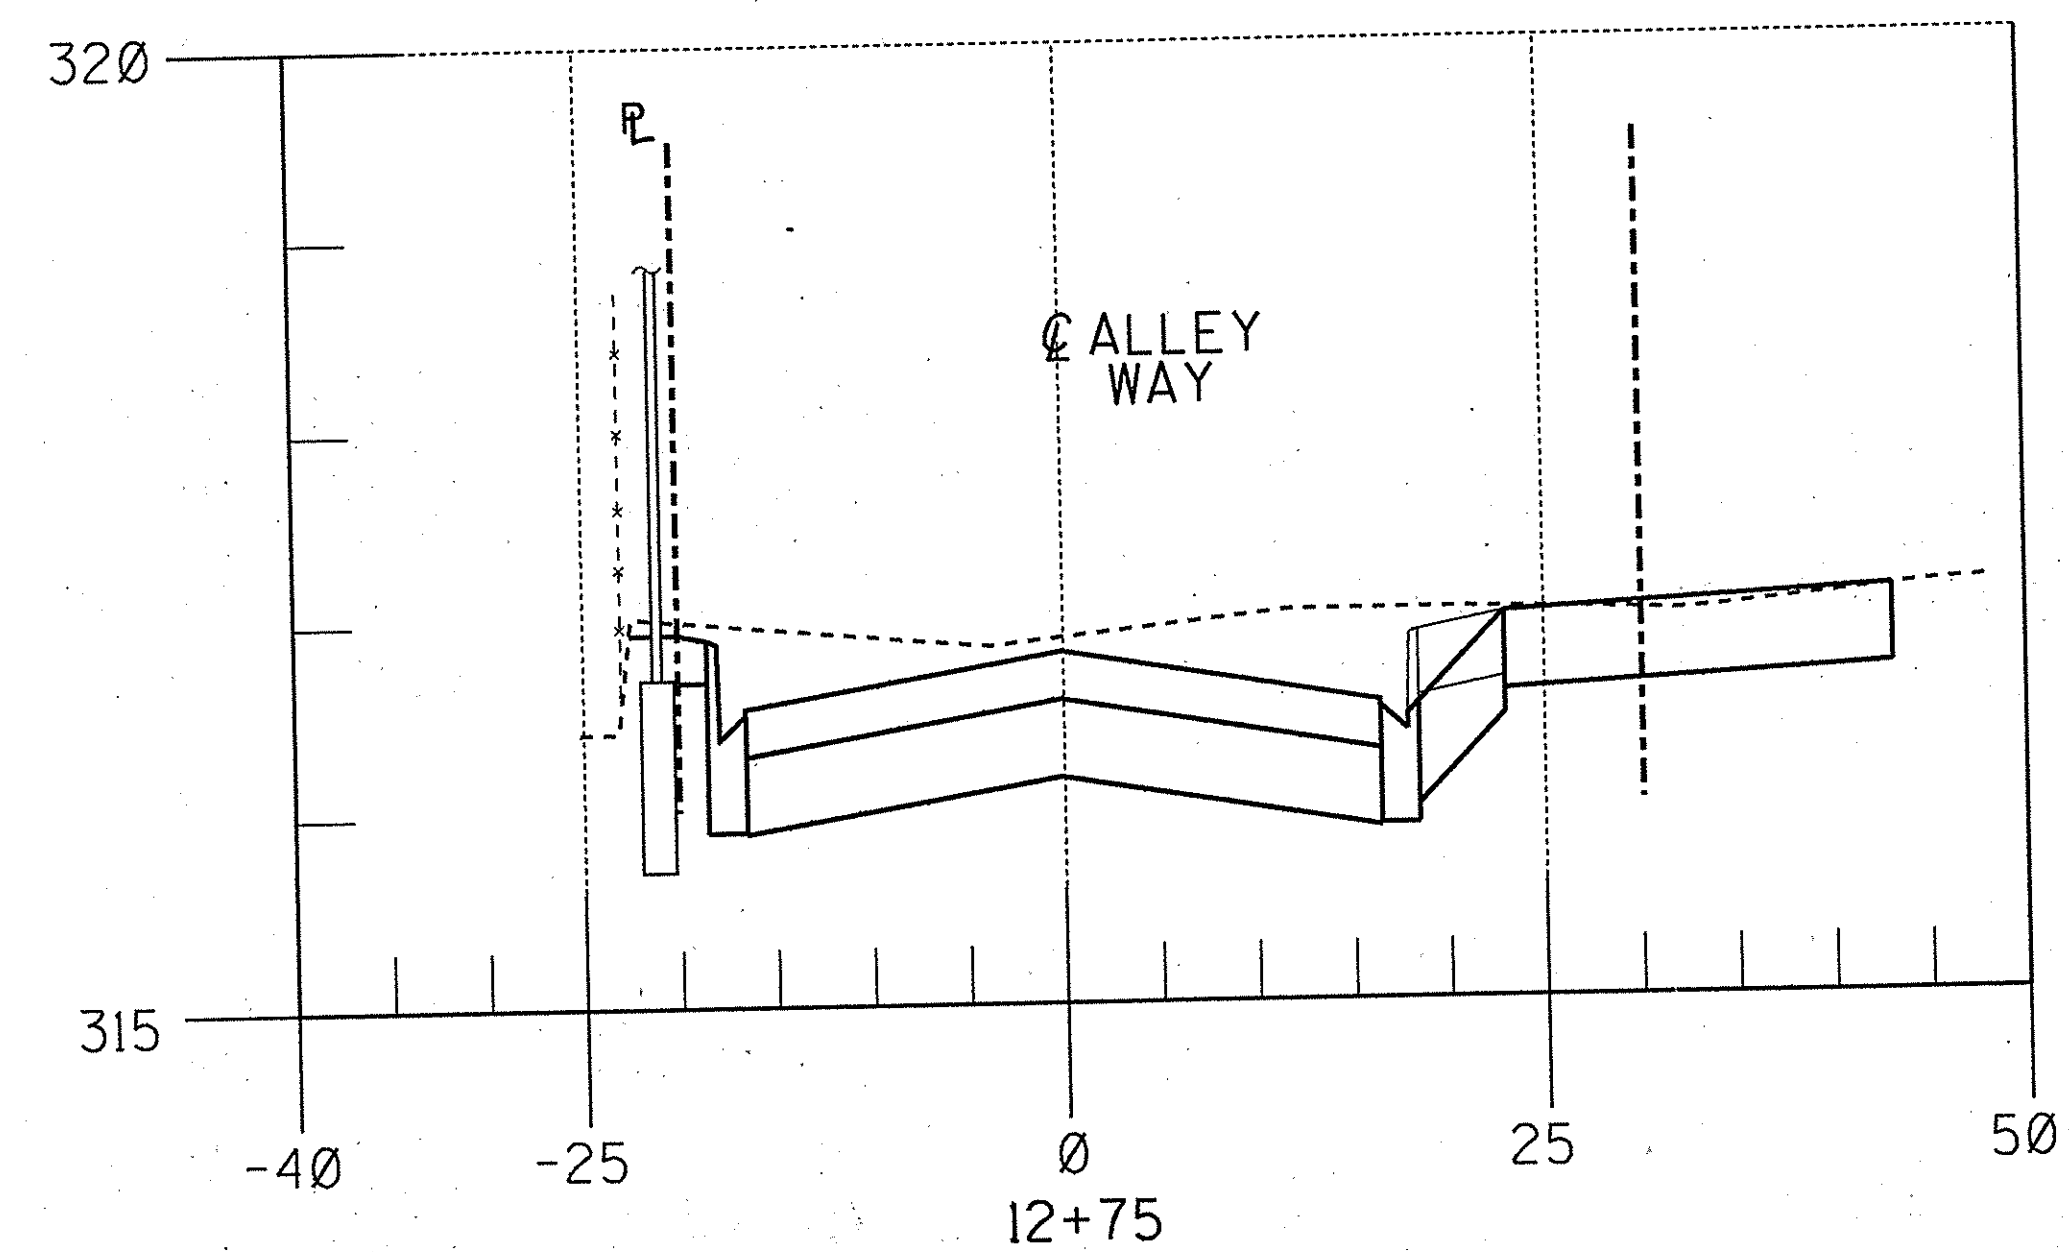
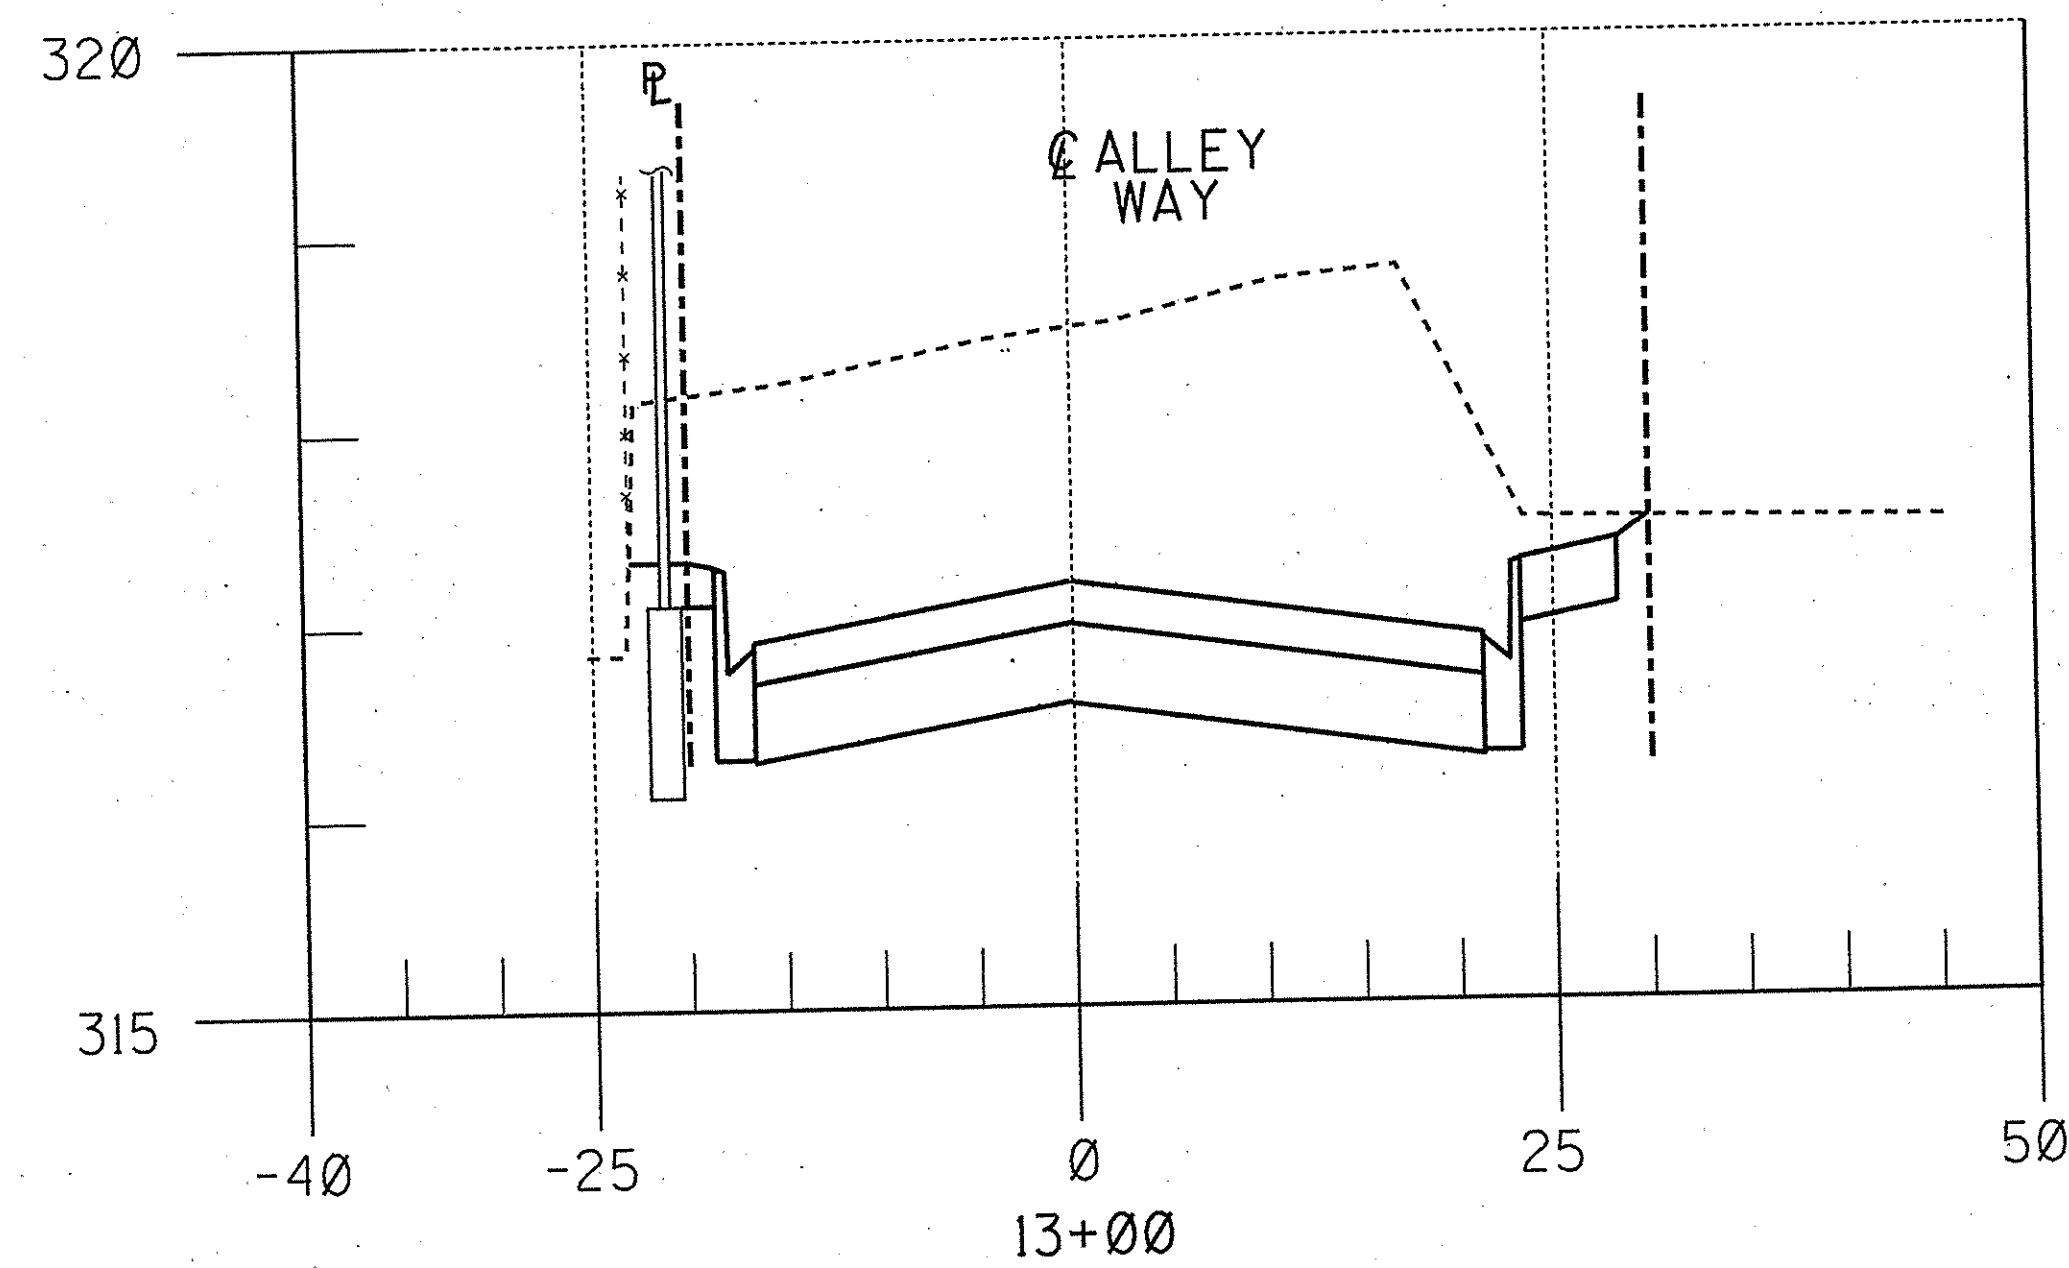
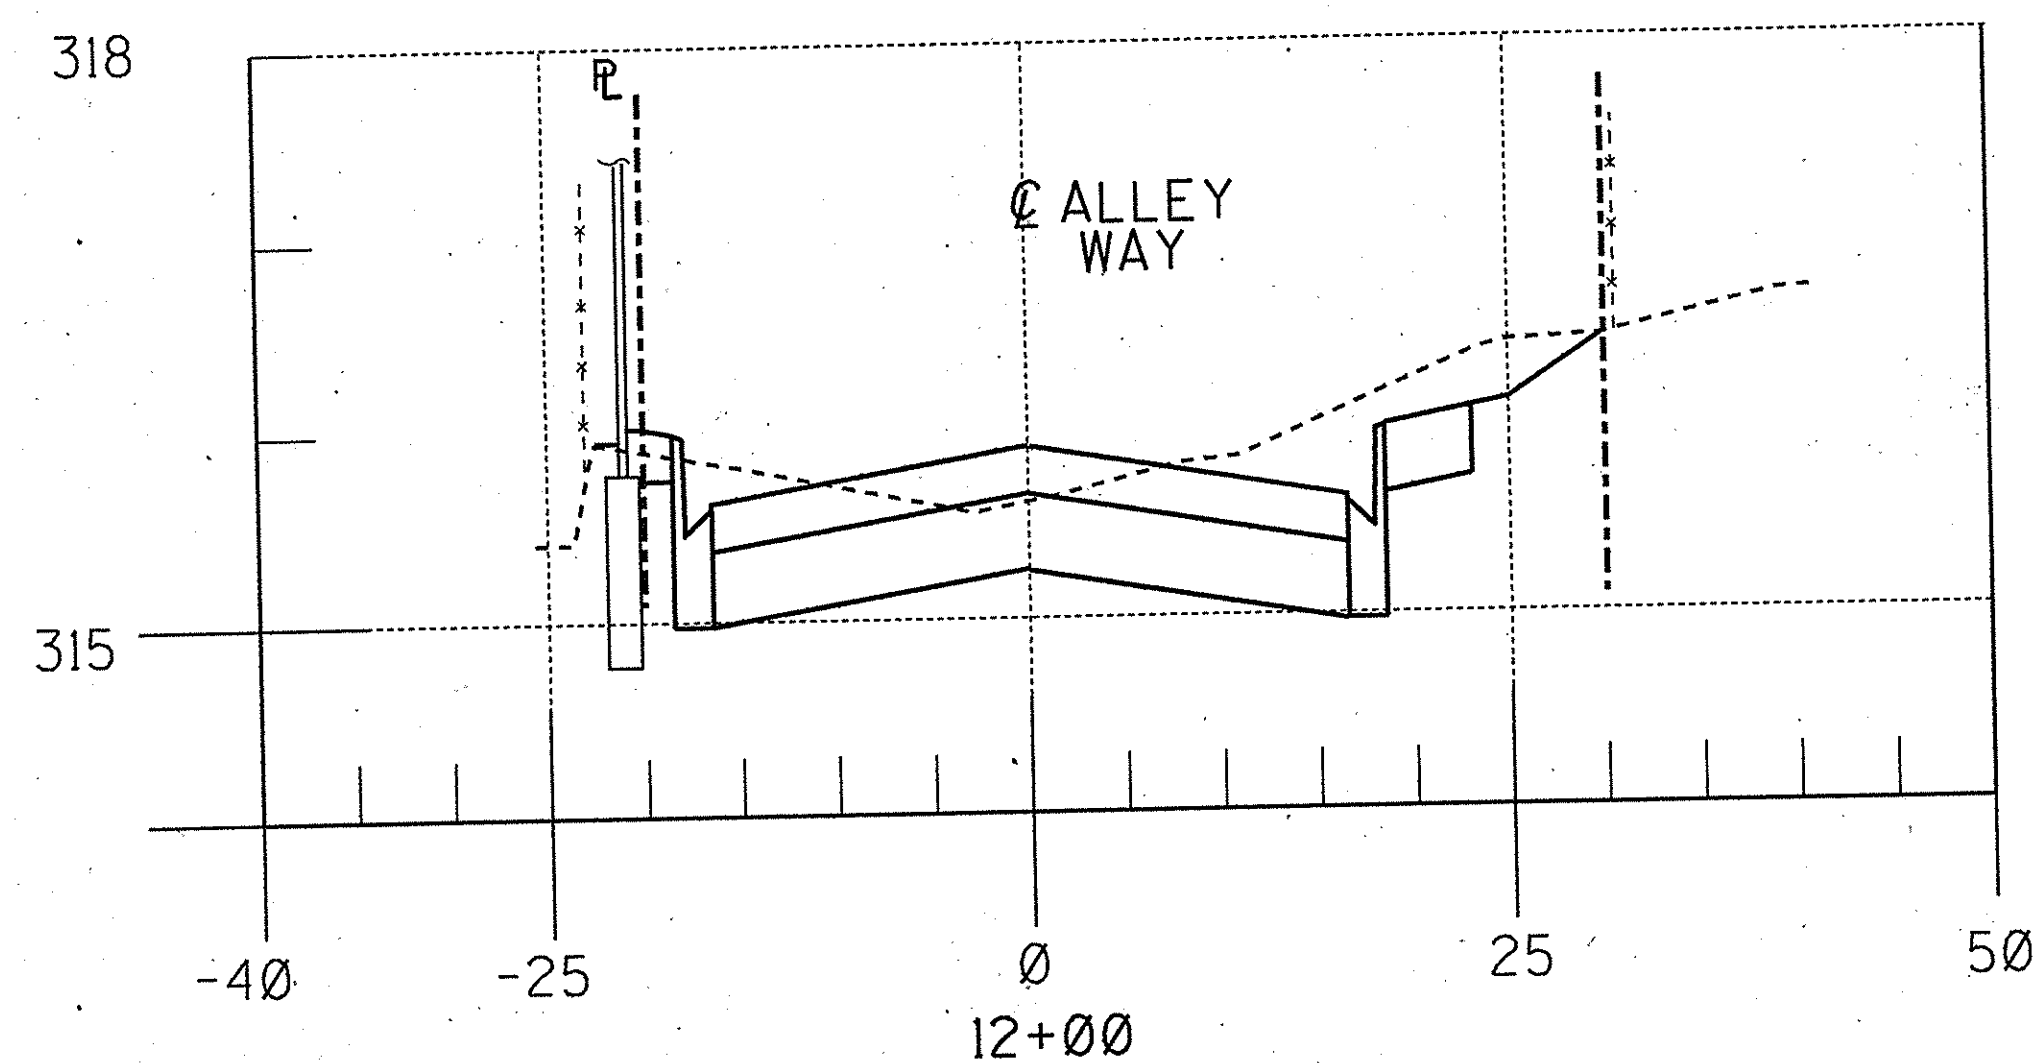
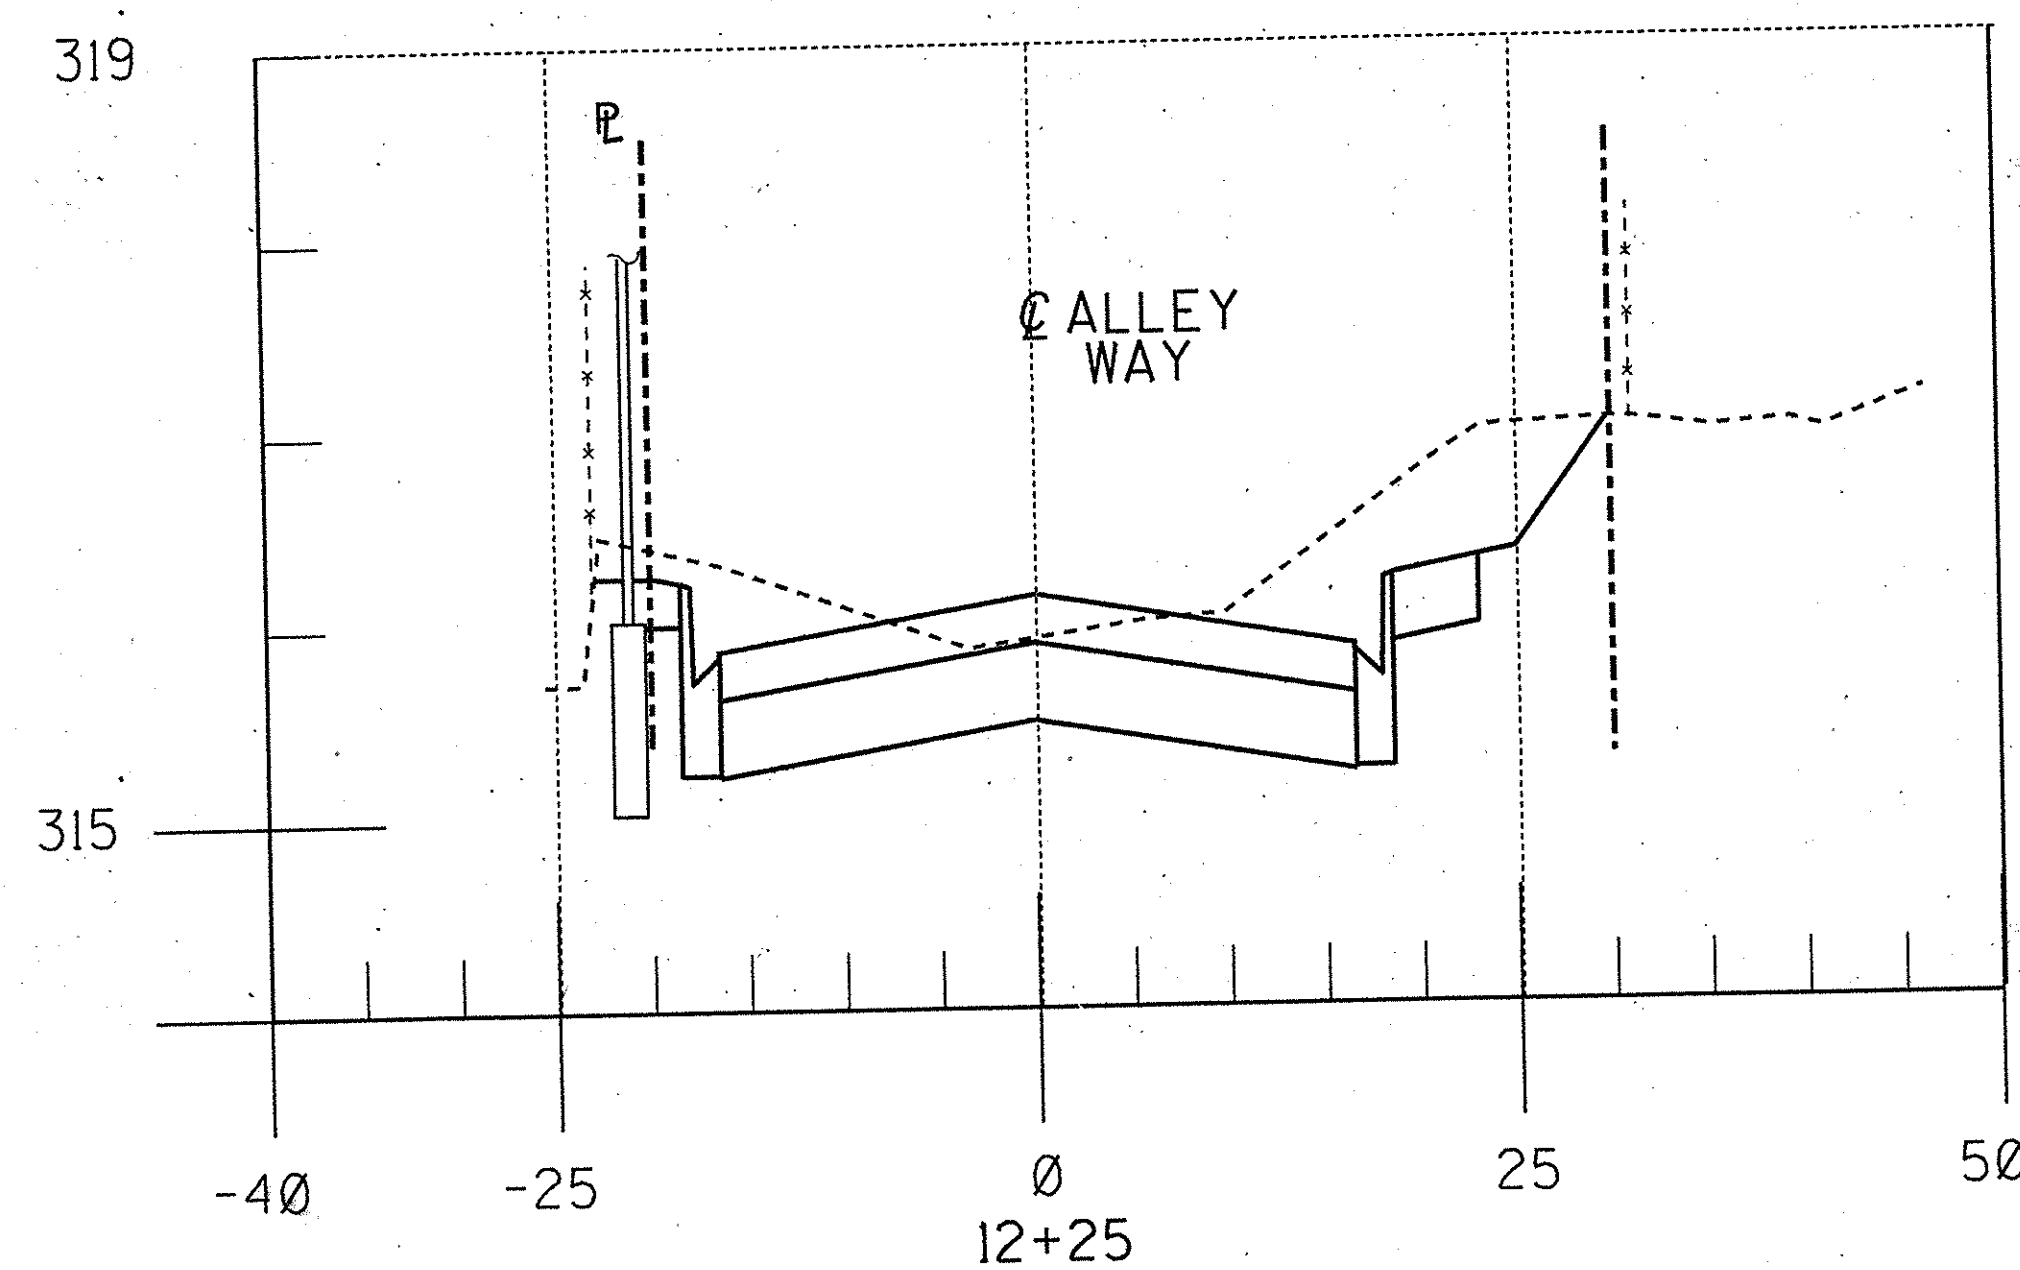


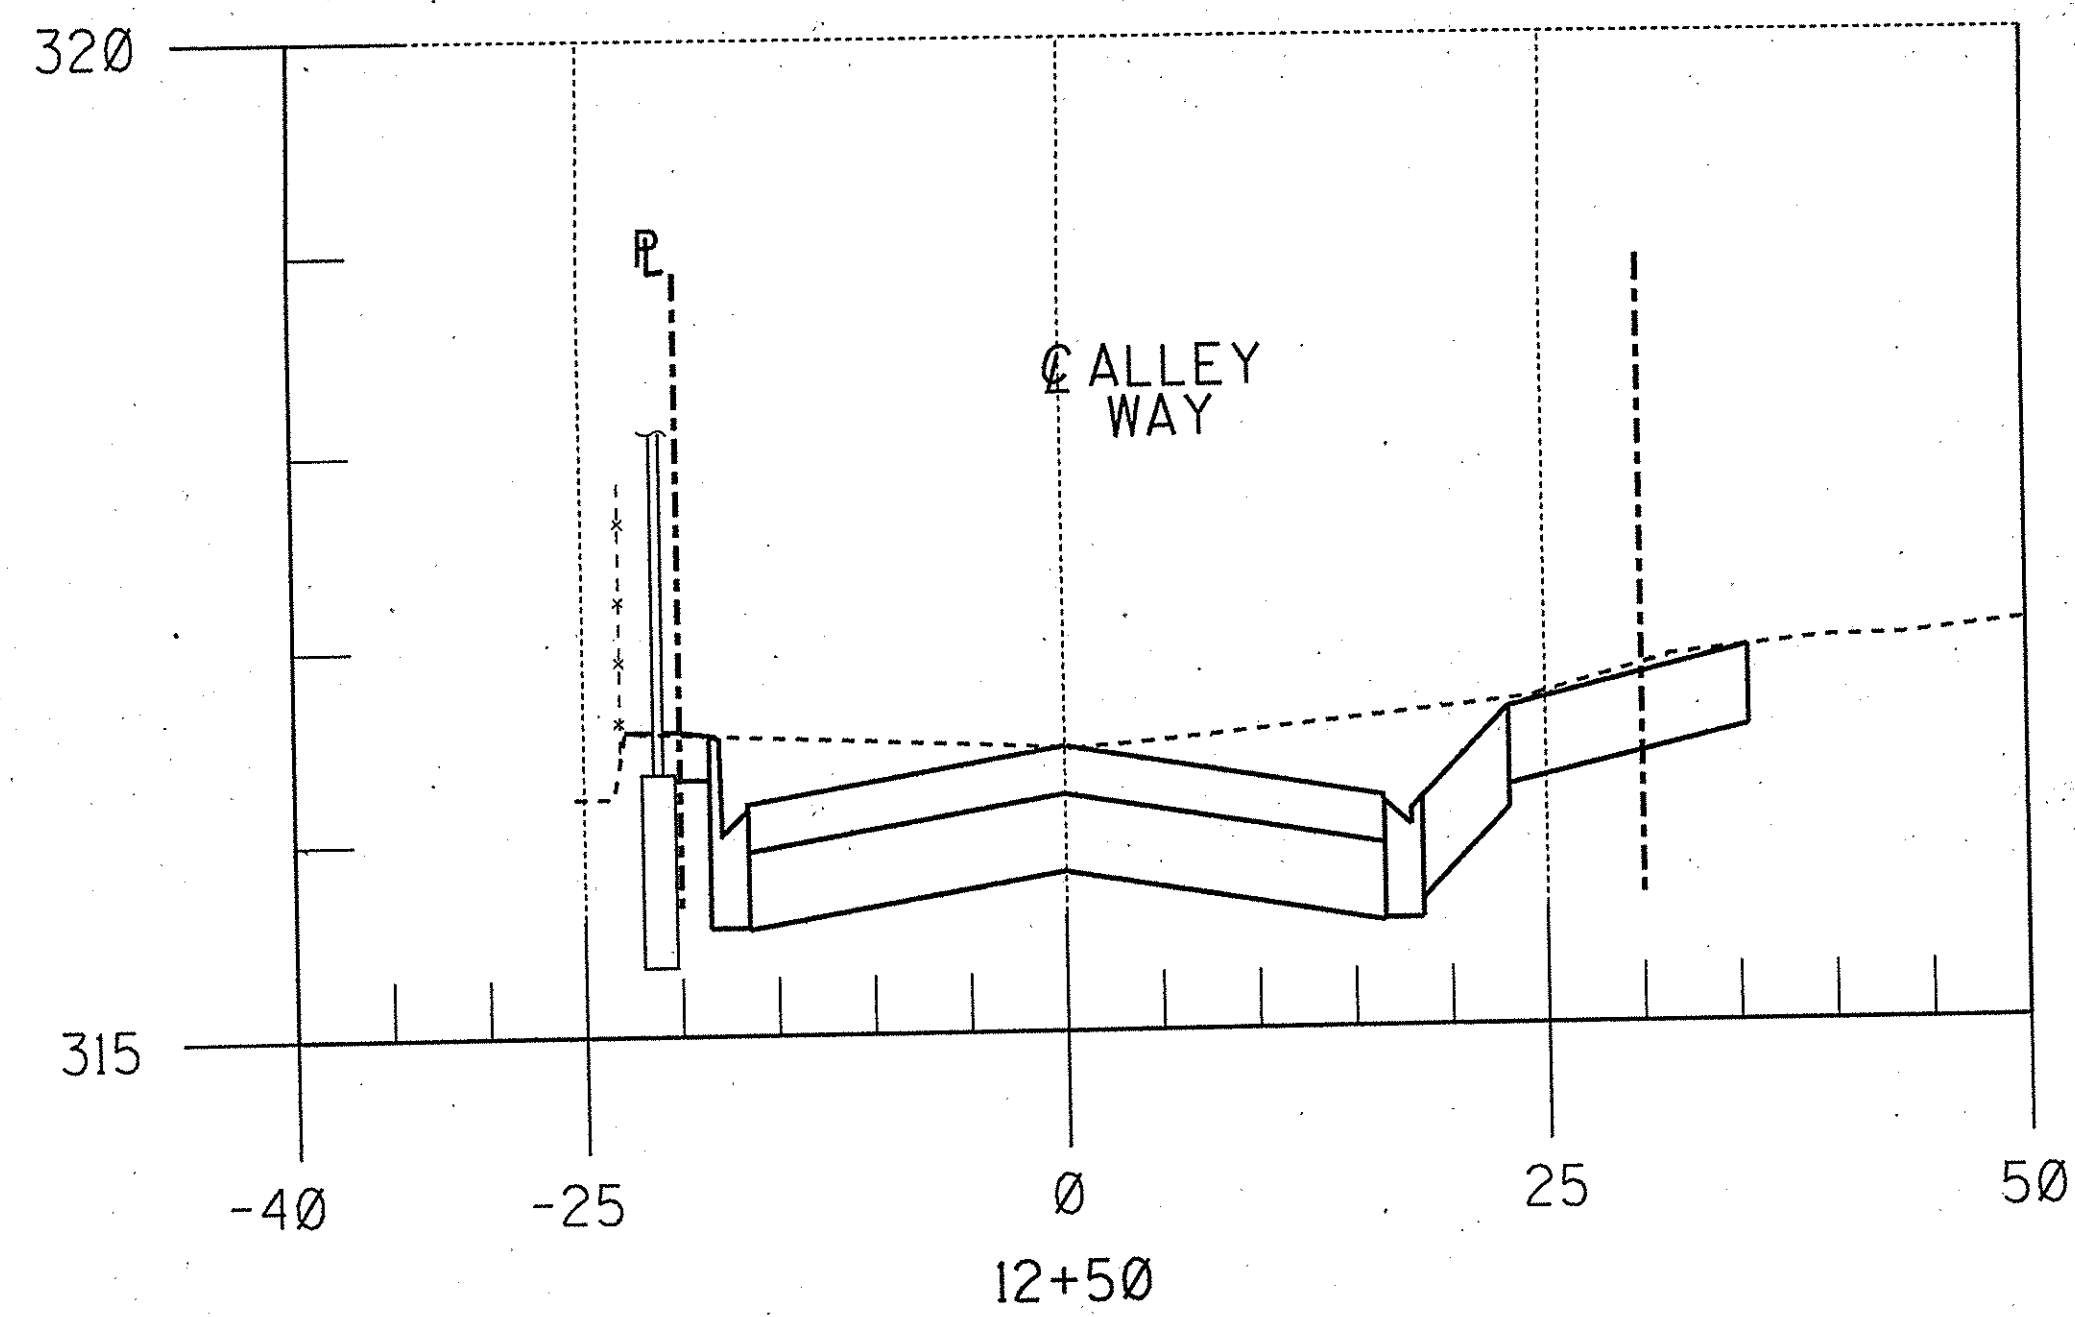

SCALE : H ; 1"=10'-0"
V ; 1"=1'-0"

RECORD DRAWING

ORANGE COUNTY PUBLIC FACILITIES AND RESOURCES DEPARTMENT		SPRING STREET PRIVATE ALLEY IMPROVEMENTS	
X-SECTIONS		STA.12+00.00 TO STA.13+25.00	
DESIGNED	TED RIGONI	CHECKED	ED KWAN
DRAWN	H.P.	DATE	
SCALE	AS SHOWN	DRAWING NO.	
		SHEET 7 OF 7	