

---

# Bridge Inspection Records Information System

---

The requested documents have been generated by the BIRIS.

*The documents provided are considered confidential and may only be released outside of the department of transportation upon proper execution of the confidentiality agreement.*

State of California  
Department of Transportation

**Division of Maintenance  
Structures Maintenance & Investigations**



DEPARTMENT OF TRANSPORTATION  
Structure Maintenance & Investigations

Bridge Number : 55C0371  
Facility Carried: SEGERSTROM-SLATER  
Location : 0.3 MI W HARBOR BLVD  
City :  
Inspection Date : 24-JUL-01  
Inspection Type  
Routine Group A Underwater Special Other  
X

# Bridge Inspection Report

Name : SANTA ANA RIVER CHANNEL

## CONSTRUCTION INFORMATION

Year Built : 1974  
Year Widened : 1982  
Length (m) : 100  
Skew (degrees): 13  
No. of Joints : 0  
No. of Hinges : 0

Description of Structure : Continuous 5-span CIP/RC T-beam (10 each) with RC pier walls and RC open end seat abutments, all supported upon concrete piles.

Span Configuration : (W) 16.5 m, 3 x 21.9 m, 16.5 m (E) c/c

## LOAD CAPACITY AND RATINGS

Design Live Load : MS - 18 OR HS - 20  
Inventory Rating : 59.8 metric tons  
Operating Rating : 99.9 metric tons  
Permit Rating : PPPPP  
Posting Load : Type 3 N/A english tons  
Calculation Method : LOAD FACTOR  
Calculation Method : LOAD FACTOR  
Type BS2 N/A english tons  
Type 3-3 N/A english tons

## DESCRIPTION ON STRUCTURE

Bridge width : (S) 0.1 m br, 1.5 m sw, 19.5 m, 1.5 m sw, 0.1 m br (N)  
Total Width : 23.2 m  
Net Width : 19.50 m  
Rail Description : Type 11 (Misc) Railing  
Min. Vertical Clearance : Unimpaired  
No. of Lanes : 4  
Rail Code : 1000

## DESCRIPTION UNDER STRUCTURE

Channel Description : RC trapezoidal.

## CONDITION OF STRUCTURE

Unsealed cracks exist in the concrete deck which are of moderate size or density. (O)  
Otherwise, the structure is in good condition.

## MISCELLANEOUS

Vehicular access into the channel is from the southwest quadrant.  
Transients are living beneath the structure at both abutments.

## ELEMENT LEVEL INSPECTION RATINGS

| F#     | Elem | Element Description              | Env | Total Units | Qty in each Condition State |       |       |       |       |
|--------|------|----------------------------------|-----|-------------|-----------------------------|-------|-------|-------|-------|
|        | No.  |                                  |     | Quantity    | St. 1                       | St. 2 | St. 3 | St. 4 | St. 5 |
| 01 12  |      | Concrete Deck - Bare             | 2   | 1930 sq.m.  | 1930                        | 0     | 0     | 0     | 0     |
| 01 110 |      | Reinforced Conc Open Girder/Beam | 2   | 1000 m.     | 1000                        | 0     | 0     | 0     | 0     |
| 01 210 |      | Reinforced Conc Pier Wall        | 2   | 96 m.       | 96                          | 0     | 0     | 0     | 0     |
| 01 215 |      | Reinforced Conc Abutment         | 2   | 48 m.       | 48                          | 0     | 0     | 0     | 0     |
| 01 227 |      | Reinforced Conc Submerged Pile   | 2   | 104 ea.     | 104                         | 0     | 0     | 0     | 0     |
| 01 256 |      | Slope Protection                 | 2   | 2 ea.       | 2                           | 0     | 0     | 0     | 0     |
| 01 302 |      | Compression Joint Seal           | 2   | 40 m.       | 40                          | 0     | 0     | 0     | 0     |
| 01 312 |      | Enclosed/Concealed Bearing       | 2   | 2 ea.       | 2                           | 0     | 0     | 0     | 0     |
| 01 335 |      | Other Bridge Railing             | 2   | 200 m.      | 200                         | 0     | 0     | 0     | 0     |
| 01 351 |      | Open Joint - Expansion Paper     | 2   | 100 m.      | 100                         | 0     | 0     | 0     | 0     |
| 01 358 |      | Deck Cracking                    | 2   | 1 ea.       | 0                           | 1     | 0     | 0     | 0     |

Bridge No.: 55C0371

Location: 0.3 MI W HARBOR BLVD

Inspection Date: 24-JUL-01

WORK RECOMMENDATIONS

Remove the temporary shelters and the transients from beneath the structure at both abutments.

| <u>Item#</u> | <u>Rec. Date</u> | <u>Work By</u> | <u>Work Id.</u> | <u>Prog. Method</u> | <u>Cost</u> |
|--------------|------------------|----------------|-----------------|---------------------|-------------|
| 1            | 20-JAN-1999      | County Agency  | 40371X99020X    |                     |             |

Inspected By : M. Ogata

*M. Ogata*  
Registered Civil Engineer

CC : TMRut  
Orange County

Bridge No.: 55C0371

Location: 0.3 MI W HARBOR BLVD

Inspection Date: 24-JUL-01

## STRUCTURE INVENTORY AND APPRAISAL REPORT

## \*\*\*\*\* IDENTIFICATION \*\*\*\*\*

(1) STATE NAME - CALIFORNIA 069  
 (2) STRUCTURE NUMBER 55C0371  
 (5) INVENTORY ROUTE (ON/UNDER) - ON 140 0M029N  
 (2) HIGHWAY AGENCY DISTRICT 12  
 (3) COUNTY CODE 059 (4) PLACE CODE 00000  
 (6) FEATURE INTERSECTED - SANTA ANA RIVER CHANNEL  
 (7) FACILITY CARRIED - SEGERSTROM-SLATER  
 (9) LOCATION - 0.3 MI W HARBOR BLVD  
 (11) MILEPOINT/KILOMETERPOINT 0  
 (12) BASE HIGHWAY NETWORK - NOT ON NET 0  
 (13) LRS INVENTORY ROUTE & SUBROUTE  
 (26) LATITUDE 33 DEG 42 MIN 32 SEC  
 (17) LONGITUDE 117 DEG 55 MIN 30 SEC  
 (98) BORDER BRIDGE STATE CODE % SHARE %  
 (99) BORDER BRIDGE STRUCTURE NUMBER

## \*\*\*\*\* STRUCTURE TYPE AND MATERIAL \*\*\*\*\*

(43) STRUCTURE TYPE MAIN: MATERIAL - CONCRETE CONT  
 TYPE - TEE BEAM CODE 2 04  
 (44) STRUCTURE TYPE APPR: MATERIAL -  
 TYPE - CODE  
 (45) NUMBER OF SPANS IN MAIN UNIT 5  
 (46) NUMBER OF APPROACH SPANS 0  
 (107) DECK STRUCTURE TYPE CIP CONCRETE CODE 1  
 (108) WEARING SURFACE / PROTECTIVE SYSTEM:  
 A) TYPE OF WEARING SURFACE - CONCRETE CODE 1  
 B) TYPE OF MEMBRANE - NONE CODE 0  
 C) TYPE OF DECK PROTECTION - NONE CODE 0

## \*\*\*\*\* AGE AND SERVICE \*\*\*\*\*

(27) YEAR BUILT 1974  
 (106) YEAR RECONSTRUCTED 1982  
 (42) TYPE OF SERVICE: ON - HIGHWAY-PEDESTRIAN 5  
 UNDER - WATERWAY 5  
 (28) LANES: ON STRUCTURE 04 UNDER STRUCTURE  
 (29) AVERAGE DAILY TRAFFIC 18000  
 (30) YEAR OF ADT 1999 (108) TRUCK ADT 1%  
 (19) BYPASS, DETOUR LENGTH 2 KM

## \*\*\*\*\* GEOMETRIC DATA \*\*\*\*\*

(48) LENGTH OF MAXIMUM SPAN 21.9 M  
 (49) STRUCTURE LENGTH 100 M  
 (50) CURB OR SIDEWALK: LEFT 1.5 M RIGHT 1.5 M  
 (51) BRIDGE ROADWAY WIDTH CURB TO CURB 19.5 M  
 (52) DECK WIDTH OUT TO OUT 23.2 M  
 (32) APPROACH ROADWAY WIDTH (W/SHOULDERS) 20.1 M  
 (33) BRIDGE MEDIAN - CLOSED (NO BARRIER) 2  
 (34) SKEW 13 DEG (35) STRUCTURE FLARED NO  
 (10) INVENTORY ROUTE MIN VERT CLEAR 99.99 M  
 (47) INVENTORY ROUTE TOTAL HORIZ CLEAR 19.5 M  
 (53) MIN VERT CLEAR OVER BRIDGE RDWY 99.99 M  
 (54) MIN VERT UNDERCLEAR REF - NOT H/RR 0 M  
 (55) MIN LAT UNDERCLEAR RT REF - NOT H/RR 0 M  
 (56) MIN LAT UNDERCLEAR LT 0 M

## \*\*\*\*\* NAVIGATION DATA \*\*\*\*\*

(38) NAVIGATION CONTROL - NOT APPLICABLE CODE N  
 (111) PIER PROTECTION - NOT REQUIRED CODE 1  
 (39) NAVIGATION VERTICAL CLEARANCE 0 M  
 (116) VERT-LIFT BRIDGE NAV MIN VERT CLEAR 0 M  
 (40) NAVIGATION HORIZONTAL CLEARANCE 0

## \*\*\*\*\* SUFFICIENCY RATING \*\*\*\*\*

SUFFICIENCY RATING = 96.3

STATUS =

HEALTH INDEX = 100

## \*\*\*\*\* CLASSIFICATION \*\*\*\*\*

| CODE  | DESCRIPTION                              | VALUE |
|-------|------------------------------------------|-------|
| (112) | NHS BRIDGE LENGTH - YES                  | Y     |
| (104) | HIGHWAY SYSTEM - NOT ON NHS              | 0     |
| (126) | FUNCTIONAL CLASS - MINOR ARTERIAL URBAN  | 16    |
| (106) | DEFENSE HIGHWAY - NOT STRAHNET           | 0     |
| (101) | PARALLEL STRUCTURE - NONE EXISTS         | N     |
| (103) | DIRECTION OF TRAFFIC - 2 WAY             | 2     |
| (109) | TEMPORARY STRUCTURE -                    |       |
| (105) | FEDERAL LANDS HIGHWAY - NOT APPLICABLE   | 0     |
| (114) | DESIGNATED NATIONAL NETWORK - NOT ON NET | 0     |
| (12)  | TOLL - ON FREE ROAD                      | 3     |
| (21)  | MAINTAIN - COUNTY HIGHWAY AGENCY         | 2     |
| (22)  | OWNER - COUNTY HIGHWAY AGENCY            | 2     |
| (37)  | HISTORICAL SIGNIFICANCE - NOT ELIGIBLE   | 5     |

## \*\*\*\*\* CONDITION \*\*\*\*\*

| CODE | DESCRIPTION                  | VALUE |
|------|------------------------------|-------|
| (58) | DECK                         | 6     |
| (59) | SUPERSTRUCTURE               | 7     |
| (60) | SUBSTRUCTURE                 | 7     |
| (1)  | CHANNEL & CHANNEL PROTECTION | 9     |
| (62) | CULVERTS                     | N     |

## \*\*\*\*\* LOAD RATING AND POSTING \*\*\*\*\*

| CODE | DESCRIPTION                                                              | VALUE |
|------|--------------------------------------------------------------------------|-------|
| (31) | DESIGN LOAD - MS - 18 OR HS - 20                                         | 5     |
| (63) | OPERATING RATING METHOD - LOAD FACTOR                                    | 1     |
| (64) | OPERATING RATING -                                                       | 99.9  |
| (65) | INVENTORY RATING METHOD - LOAD FACTOR                                    | 1     |
| (66) | INVENTORY RATING -                                                       | 59.8  |
| (70) | BRIDGE POSTING - Equal to or above legal loads                           | 5     |
| (41) | STRUCTURE OPEN, POSTED OR CLOSED -<br>DESCRIPTION - OPEN, NO RESTRICTION | A     |

## \*\*\*\*\* APPRAISAL \*\*\*\*\*

| CODE  | DESCRIPTION                            | VALUE |
|-------|----------------------------------------|-------|
| (67)  | STRUCTURAL EVALUATION                  | 7     |
| (68)  | DECK GEOMETRY                          | 7     |
| (69)  | UNDERCLEARANCES, VERTICAL & HORIZONTAL | N     |
| (71)  | WATER ADEQUACY                         | 9     |
| (72)  | APPROACH ROADWAY ALIGNMENT             | 8     |
| (36)  | TRAFFIC SAFETY FEATURES                | 1000  |
| (113) | SCOUR CRITICAL BRIDGES                 | 8     |

## \*\*\*\*\* PROPOSED IMPROVEMENTS \*\*\*\*\*

| CODE  | DESCRIPTION                       | VALUE |
|-------|-----------------------------------|-------|
| (75)  | TYPE OF WORK -                    |       |
| (76)  | LENGTH OF STRUCTURE IMPROVEMENT   | M     |
| (94)  | BRIDGE IMPROVEMENT COST           |       |
| (95)  | ROADWAY IMPROVEMENT COST          |       |
| (96)  | TOTAL PROJECT COST                |       |
| (97)  | YEAR OF IMPROVEMENT COST ESTIMATE |       |
| (114) | FUTURE ADT                        | 36000 |
| (115) | YEAR OF FUTURE ADT                | 2019  |

## \*\*\*\*\* INSPECTIONS \*\*\*\*\*

| CODE | DESCRIPTION                  | VALUE                |
|------|------------------------------|----------------------|
| (90) | INSPECTION DATE 07/01        | (91) FREQUENCY 24 MO |
| (92) | CRITICAL FEATURE INSPECTION: | (93) CFI DATE        |
| A)   | FRACTURE CRIT DETAIL - NO    | -1 MO A)             |
| B)   | UNDERWATER INSP - NO         | -1 MO B)             |
| C)   | OTHER SPECIAL INSP - NO      | -1 MO C)             |

Bridge Number 55C-371

TYPE OF INVESTIGATION/REPORT

BIENNIAL X DAMAGE       
CATEGORY A      OTHER       
UNDERWATER      OFFICE     

Location 12 - Ora - FAU M029-CR  
Dist.-Co.-Rte.-City

Date of Investigation July 14, 1995

Name SANTA ANA RIVER CHANNEL (Slater Avenue/Segerstrom Avenue,  
0.3 mile west of Harbor Boulevard)

CONDITION RATINGS:

Condition ratings of all bridge elements are  
shown on the PONTIS DATA FORM (Attachment A).

Channel & Channel Protection

9

SCOUR CRITICAL:

A scour rating of A-1 is appropriate.

DISCUSSION:

Transients have taken up residence at east abutment and there are  
indications of the use of fire.

CONDITION OF STRUCTURE:

- A. Anchors for PVC pipes in 4th bay from south have been damaged and  
there is concern that PVC pipes could break.
- B. Expansion joint for departure of north sidewalk is full of sand  
and debris.
- C. 0.1 m diameter PVC pipes in north exterior bay have separated  
(span 4) and wires are now exposed.

WORK RECOMMENDED:

- 1. Fix anchors for suspended PVC pipe in location "A".
- 2. Clean expansion joint in location "B".
- 3. Replace PVC couplers in location "C".

ENCROACHMENT:

Nine 4" PVC ducts in 4th bay from south.

Nine 4" PVC ducts in north exterior bay.

Four 5" PVC ducts in 2nd bay from north.


By

M. Hadi Behrooj *MHB*

G. P. Balinghasay

GPB:cd

cc: CDHarris  
Orange County  
WLindsey

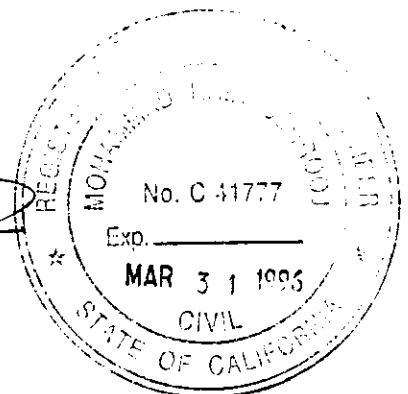

INFORMATION ONLY - NOT FOR UPDATE

| BRIDGE NUMBER | FRAME | INSPECTION DATE |
|---------------|-------|-----------------|
| 55C0371       | 01    | 071495          |
| 1             | 9     | 11 16           |

|                           |    |
|---------------------------|----|
| SCOUR CRITICAL            | NO |
| CATEGORY A                | NO |
| FRACTURE CRITICAL         | NO |
| ELIGIBLE FOR RAIL UPGRADE | NO |
| UNDERWATER INSPECTION     | NO |

|          |     |
|----------|-----|
| DISTRICT | 12  |
| COUNTY   | ORA |
| ROUTE    |     |
| POSTMILE |     |
| NAME     |     |

[illegible]

07/18/95

BY:

Bridge No. 55C-371

Name SANTA ANA RIVER CHANNEL (Slater  
Avenue/Seegerstrom Avenue, 0.3 mile  
west of Harbor Boulevard)

Location 12-Ora-FAS M029-CR  
Dist.-Co.-Rte.-City

## SUMMARY OF ENCROACHMENTS

| Permit No.<br>and Permittee | Date                | Description & Location on Bridge                                                                                              |
|-----------------------------|---------------------|-------------------------------------------------------------------------------------------------------------------------------|
|                             | Prior to<br>7-14-95 | 9 - 4" PVC ducts in 4th bay from south.<br>9 - 4" PVC ducts in north exterior bay.<br>4 - 5" PVC ducts in 2nd bay from north. |

HBD M 30

## PONTIS DATA FORM - PIA

| BRIDGE NUMBER | FRAME | INSPECTION DATE |
|---------------|-------|-----------------|
| 55C0371       | 01    | 041293          |
| 1             | 8     | 9               |
|               |       | 11              |
|               |       | 16              |

INFORMATION ONLY - NOT FOR UPDATE

|                           |    |
|---------------------------|----|
| SCOUR CRITICAL            | NO |
| CATEGORY A                | NO |
| FRACTURE CRITICAL         | NO |
| ELIGIBLE FOR RAIL UPGRADE | NO |
| UNDERWATER INSPECTION     | NO |

|          |       |
|----------|-------|
| DISTRICT | 12    |
| COUNTY   | ORA   |
| ROUTE    | ***   |
| POSTMILE | ***** |
| NAME     |       |

[illegible]

H. MA

**BY:**

**SUPPLEMENTARY BRIDGE REPORT**

DS-M19 (REV. 8/92)

Bridge Number 55C-371

Location 12 - Ora - FAU M029-CR  
Dist.-Co.-Rte.-City

Date of Investigation April 12, 1993

**TYPE OF INVESTIGATION/REPORT**

|            |          |        |     |
|------------|----------|--------|-----|
| BIENNIAL   | <u>X</u> | DAMAGE | ___ |
| CATEGORY A | ___      | OTHER  | ___ |
| UNDERWATER | ___      | OFFICE | ___ |

Name SANTA ANA RIVER CHANNEL (Slater Avenue/Segerstrom Avenue,  
0.3 mile west of Harbor Boulevard)

**CONDITION RATINGS:**

Condition ratings of all bridge elements are  
shown on the PONTIS DATA FORM (Attachment A).

Channel & Channel Protection

9

CONDITION OF STRUCTURE:

Condition of the structure is good.

Henry Ma

HM:cd

cc: INagai (2)  
County of Orange



BRIDGE REPORT

DS-M58 (REV. 1/91)

14W11

Bridge No. 55C - 371

Location 12 - Ora - FAU M029-CR  
Dist Co Rte City

REVISED ORIGINAL REPORT

Date of Investigation April 11, 1991

Name SANTA ANA RIVER CHANNEL (Slater Avenue/Segerstrom Avenue,  
0.3 mile west of Harbor Boulevard)

Lat. 33° - 42.5'N Long. 117° - 55.5'W

Custodian County of Orange Owner County of Orange

STRUCTURAL DATA AND HISTORY

Year Built 1974 By County of Orange Contract No. Unknown  
See Page 2

Designed by: County and Wheeler & Gray Plans Avail. @DOS

Description: 5 span continuous CIP RC "T" beam (10 each) supported by RC  
pier walls and open end RC seated abutments, all on concrete  
piles.

Spans (W) 54', 3 @ 72', 54' (E)

Length 328' NBIS Bridge Length Yes Skew 13° Right

Number Of Intermediate Joints: @Hinges None @Bents None

Maximum Column/Pier Height: (Less than 20') X (20'-29') (30' & Over)

Design Live Load HS20-44 & Alt Design Method Unknown

DESCRIPTION - ON STRUCTURE

Bridge Width (S) 1'br, 5'sw, 64', 5'sw, 1'br (N)

Total Width 76' Net Width 64' Lanes 4 Tracks None

Median None Rail Type 11 with tubular  
handrail 1000

Vert. Clearance over deck Unimpaired Appr. Rdwy. Width 66'

Deck Type 1 Wearing Surface/Prot. Sys. 100 Concrete/none

Alignment Tangent

DESCRIPTION - UNDER STRUCTURE

Roadway Section None

Clearances: Road: Vert. Horiz. Lt. ; Rt.

Lanes Tracks

Facilities Crossed Santa Ana River Channel (E 01)

April 11, 1991

## DESCRIPTION - HYDRAULICS

Channel Sandy bottom trapezoidal with concrete side slopes

Navigable: Yes ☐ No ☒ Clearances: Vert.

Horiz.

Pier/Abutment Protection (For Navigation) ☐

## TRAFFIC INFORMATION

|                                     | DECK       | YEAR  | UNDER              | YEAR        |
|-------------------------------------|------------|-------|--------------------|-------------|
| Average Daily Traffic & Year :      | 21,000     | 1989  | N                  |             |
| Average Daily Traffic (Future) :    | 22,000 Est | 2010  | N                  |             |
| Average Daily Trucks ( % OF ADT ) : | 1% Est     |       | N                  |             |
| Bypass Detour Length                | 1 mile     |       | N                  |             |
| Shell Route:                        | No         |       | No                 |             |
| Functional Classification :         | 16         |       | N                  |             |
| LOAD RATINGS:                       | Inventory  | HS 37 | Operating          | HS 62       |
|                                     | Permit     | PPPPP | Computation Method | Load Factor |

## CONDITION RATINGS:

|                              |   |                |   |              |     |
|------------------------------|---|----------------|---|--------------|-----|
| Deck                         | 7 | Superstructure | 8 | Substructure | 8   |
| Channel & Channel Protection | 9 | Culvert        | N | Widenable    | Yes |

## APPRAISAL RATINGS:

|                   |   |                            |   |
|-------------------|---|----------------------------|---|
| Waterway Adequacy | 9 | Approach Roadway Alignment | 8 |
|-------------------|---|----------------------------|---|

Date of Revisions

## STRUCTURAL DATA AND HISTORY (Con't.)

Date of Revision: 1982, widened 38' on south side.

CONDITION OF STRUCTURE:

There is moderate transverse and random cracking in the concrete bridge deck in north half (original construction) of the structure.

Condition of the structure is good.

ENCROACHMENT:


9-4" PVC ducts in 4th bay from south.  
 9-4" PVC ducts in north exterior bay.  
 4-5" PVC ducts in 2nd bay from north.

*Henry Ma*  
 Henry Ma

HM:ms

cc: INagai (2)

County of Orange

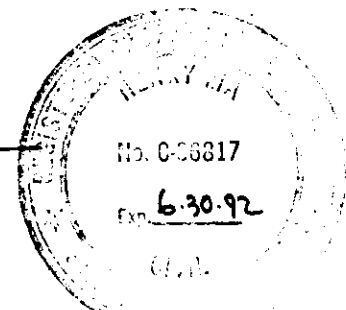

STATE OF CALIFORNIA  
DEPARTMENT OF TRANSPORTATION  
**SUPPLEMENTARY BRIDGE REPORT**  
DS-M19 (REV. 1/89)

Bridge No. 55C-371  
Location 12-Ora-FAU M029 - CR  
Dist. Co. Rte. City  
Date of Investigation 4-10-89

Name SANTA ANA RIVER (Segerstrom - Slater, 0.3 mile West of Harbor Boulevard)

**CONDITION RATING:**

Deck 7 Superstructure 8 Substr.&Pipes 8  
Channel & Channel Protection 8 Culvert N Widenable? Yes

**TYPE OF INVESTIGATION/REPORT**

BIENNIAL X DAMAGE         
CATEGORY A        OTHER         
UNDERWATER        OFFICE       

**CONDITION OF STRUCTURE:**

There is light random cracking in the concrete bridge deck in the north half (original construction) of the structure.

Condition of the structure is good.

**REVISION:**

Location: 12-Ora-FAU M029-CR  
Condition Rating: Deck - 7  
Approach Roadway Alignment - 7  
Original Appraisal: Approach Roadway Alignment - 7

**WORK RECOMMENDED:**

None.

**RECOMMENDED POSTING:**

None.

**SUBSTRUCTURE CODING UPDATE:**

2 RC open end seated abutments on concrete piles.  
4 RC pier walls on concrete piles.

  
Henry Ma

HM:ms  
cc: INagai (2)  
County of Orange (2)



STATE OF CALIFORNIA  
DEPARTMENT OF TRANSPORTATION  
**SUPPLEMENTARY BRIDGE REPORT**  
DH-OS M19 (REV. 1/74)

Bridge No. 55C-371

Location 7-Oran-Fall-M029-CR  
Dist - Co - Rte - Pd - City

Date of Investigation April 15, 1987

Name SANTA ANA RIVER (Segerstrom - Slater, 0.3 mi W. of Harbor Blvd)

**CONDITION RATING:**

Deck 8 Superstructure 8 Substr. & Pipes 8 Overall 8  
Channel & Channel Protection 8 Retaining Walls N

**APPRAISAL RATING:**

Widenable? Yes ☒ No ☐ Conditional ☐

Action Required By County Yes ☐ No ☒

**PRIORITY**

A - Immediate Action  
B - Early Scheduling  
C - Routine Maint.  
O - For Record Only

**REVISION:**

Approach Roadway Width - 64'  
Average Daily Traffic - 20,000 (1985)

**CONDITION OF STRUCTURE:**

Overall condition of the structure is good.

**RECOMMENDED POSTING:**

None


**WORK RECOMMENDED:**

None

HM:pht

cc: INagai (2)  
Orange County (2)

Henry Ma

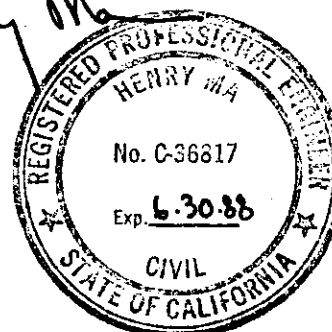

STATE OF CALIFORNIA  
DEPARTMENT OF TRANSPORTATION  
**SUPPLEMENTARY BRIDGE REPORT**  
DH-05 NIS (REV. 1/74)

Bridge No. 55C-371  
Location 7-Ora-FAU M029-CR  
San Joaquin River (On Deck)  
Date of Investigation January 7, 1986

Name SANTA ANA RIVER (Segerstrom - Slater, 0.3 mile west of Harbor Blvd.)

**CONDITION RATING:**

**APPRAISAL RATING:**

Deck 8 Superstructure 8 Substr. & Pipes 8 Overall 8  
Channel & Channel Protection 8 Retaining Walls N

Widenable? Yes ☒ No ☐ Conditional ☐

Action Required by County Yes ☒ No ☐

**PRIORITY**

A - Immediate Action  
B - Early Scheduling  
C - Routine Maint.  
O - For Record Only

**REVISION:**

Encroachments - 4 - 5" PVC ducts in the 2nd bay from the north.  
9 - 4" PVC ducts in the 4th bay from the south.

**CONDITION OF STRUCTURE:**

At the northwest corner of the structure, the wood sidewalk expansion joint form remaining in the abutment joint is protruding above the sidewalk surface.

Otherwise, the overall condition of the structure is good.


**RECOMMENDED POSTING:**

None

**WORK RECOMMENDED:**

Remove or cut-off wood form flush with sidewalk surface at the northwest abutment sidewalk.

HM:pdh  
cc: INagai (2)  
Orange County (2)

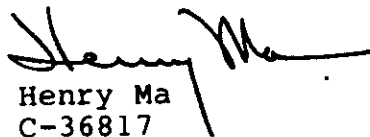  
Henry Ma  
C-36817

A

| DIST | ROUTE | COUNTY | STRU. NO | POSTMILE | RATING | WIDTH-FT | STRU TYPE | YR ORIG CONST |               |
|------|-------|--------|----------|----------|--------|----------|-----------|---------------|---------------|
| 07   | CO RD | 55 C   | 0371     | .        | 038.0  |          | CGC       | 82            | OCT. 22, 1982 |

|      | RATING<br>FACTOR | PT | SPAN | ULT MOM CAP<br>TOP IN COM | ULT MOM CAP<br>BOT IN COM | POS HS20<br>MOMENT | NEG HS20<br>MOMENT | POS PURP<br>MOMENT | NEG PURP<br>MOMENT | DEAD LOAD<br>MOMENT | SECONDARY<br>MOMENT |
|------|------------------|----|------|---------------------------|---------------------------|--------------------|--------------------|--------------------|--------------------|---------------------|---------------------|
| INV  | 1.82             | 4  | 1    | 11031.5                   | 0.0                       | 2267.8             | -640.9             | 3290.6             | -1161.8            | 1621.8              | 0.0                 |
| OPER | 3.03             | 4  | 1    | 11031.5                   | 0.0                       | 2267.8             | -640.9             | 3290.6             | -1161.8            | 1621.8              | 0.0                 |
| PURP | 1.82             | 10 | 4    | 0.0                       | 13950.1                   | 447.0              | -1799.0            | 810.3              | -4290.0            | -2918.0             | 0.0                 |

THE NUMBER OF AXLES ON THE TRUCK THAT CAUSES THE PURPLE RATING FACTOR IS 13.  
 FC = 1.30 FY = 60.

IF THE REPORTED ULTIMATE MOMENT CAPACITY IS 0, IT WAS DETERMINED NOT TO BE CRITICAL

- 2 SANTA ANA RIVER (SEGERSTROM AV-SLATER AV) WIDENING
- 3 CONT 5 SPAN RC T-BEAM W/NO ACWS
- 4 ~~REPAIRS ON BRIDGE~~

PPPPP

DIST 07 ROUTE CD RD COUNTY 55 C STRU. NO 0371 POSTMILE . RATING WIDTH-FT 038.0 STRU TYPE CGC YR ORIG CONST 82 OCT. 22, 1982

INFLUENCE LINE FOR CRITICAL INVENTORY RATING POINT SPAN 1 10TH POINT 4

| MEM NO | LEFT | .1     | .2     | .3     | .4     | .5     | .6     | .7     | .8     | .9     | RIGHT |
|--------|------|--------|--------|--------|--------|--------|--------|--------|--------|--------|-------|
| 1      | 0.0  | 2.711  | 5.454  | 8.262  | 11.165 | 8.797  | 6.589  | 4.573  | 2.782  | 1.247  | 0.0   |
| 2      | 0.0  | -1.212 | -1.981 | -2.272 | -2.449 | -2.279 | -1.927 | -1.458 | -0.937 | -0.429 | 0.0   |
| 3      | 0.0  | 0.306  | 0.500  | 0.599  | 0.619  | 0.575  | 0.486  | 0.368  | 0.236  | 0.108  | 0.0   |

THE CRITICAL OPERATING RATING POINT IS THE SAME AS THE CRITICAL INVENTORY RATING POINT

INFLUENCE LINE FOR CRITICAL PURPLE RATING POINT SPAN 4 10TH POINT 10

|   |     |        |        |        |        |        |        |        |        |        |     |
|---|-----|--------|--------|--------|--------|--------|--------|--------|--------|--------|-----|
| 2 | 0.0 | -0.072 | -0.160 | -0.250 | -0.333 | -0.396 | -0.427 | -0.414 | -0.347 | -0.213 | 0.0 |
| 3 | 0.0 | 0.299  | 0.652  | 1.016  | 1.343  | 1.589  | 1.708  | 1.654  | 1.382  | 0.846  | 0.0 |
| 4 | 0.0 | -1.105 | -2.587 | -4.026 | -5.323 | -6.296 | -6.765 | -6.550 | -5.471 | -3.348 | 0.0 |
| 5 | 0.0 | -2.039 | -3.434 | -4.256 | -4.578 | -4.471 | -4.006 | -3.255 | -2.289 | -1.180 | 0.0 |

- 2 SANTA ANA RIVER (SEGERSTROM AV-SLATER AV) WIDENING
- 3 CONT 5 SPAN RC T-BEAM W/NO ACWS
- 4 WIDENING ON SOUTHSIDE

Bridge No. 55C-371


Other No. \_\_\_\_\_

P.U.C. No. \_\_\_\_\_

Location 07-Oran-FAU M029-CR  
Dist - Co - Rte - PM - City (ON DECK)

Date of Investigation October 14, 1982

REVISED

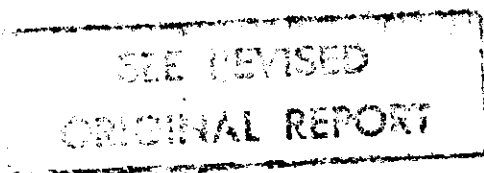

Name SANTA ANA RIVER (Segerstrom Ave./Slater Ave.), 0.3 mile west of Harbor Blvd.  
Lat. N 33°-42.5' Long. W 117°-55.5'

STRUCTURAL DATA AND HISTORY

Year Built 1974 By Orange County Contract No. Unknown

Date of Revisions 1982 - Widening 38.0' on the south side

Designed by: B.D. ☐ Wheeler and Gray, and Orange County Plans Avail. BD

Description: Continuous 5 span RC deck on T-beam (10) girders on seated pile cap RC abutments and solid RC pier walls, all supported on RC footings with piles.

Spans 1 @ 54'; 3 @ 72'; 1 @ 54' (c-c)

Length 327.5' Skew 13° Rt. Design LL HS 20-44 and Alt.

Ratings: Inventory HS 37/LF Operating HS 62/LF Permit PPPPP/LF

DESCRIPTION - ON STRUCTURE

Bridge Width 1.0'br; 5.0'sw; 64.0'; 5.0'sw; 1.0'br

Total Width 76.0' Lanes 4 Tracks None

Median Double yellow stripe Rail Type 11 (1000)

Vert. Clearance over deck Unimpaired Appr. Rdwy. Width 49'

Wearing Surface None Deck Seal None

Alignment Tangent

DESCRIPTION - UNDER STRUCTURE

Roadway Section None

Clearances: Vert. N Horiz. N Lt. N Rt. N

Lanes N Tracks N Pumpplant: None ☒ See Br. No. \_\_\_\_\_

Facilities Crossed Santa Ana River (EO 1)

cc: \_\_\_\_\_

(1) CON'T.

Bridge No. 55C-371  
Date October 14, 1982

DESCRIPTION - HYDRAULICS

Channel Earth cut trapezoidal shape with RC slope lining and a sandy bottom

Navigable: Yes ☐ No ☒ Clearances: Vert. \_\_\_\_\_ Horiz. \_\_\_\_\_

MAINTENANCE

Custodian Orange County Owner Orange County

ORIGINAL  
CONDITION RATING

|                              |           |
|------------------------------|-----------|
| Deck                         | <u>8</u>  |
| Superstructure               | <u>8</u>  |
| Substructure & Pipes         | <u>8</u>  |
| Channel & Channel Protection | <u>8</u>  |
| Retaining Walls              | <u>N</u>  |
| Approach Rdwy. Alignment     | <u>9</u>  |
| Estimated Remaining Life     | <u>50</u> |

ORIGINAL  
APPRAISAL

|                          |                 |
|--------------------------|-----------------|
| Overall                  | <u>8</u>        |
| Deck Geometry            | <u>8</u>        |
| Underclearances          | Vert. <u>N</u>  |
|                          | Horiz. <u>N</u> |
| Safe Load Capacity       | <u>9</u>        |
| Waterway Adequacy        | <u>8</u>        |
| Approach Rdwy. Alignment | <u>9</u>        |

Widenable? Yes ☒ No ☐ Conditional ☐

Action Required Yes ☐ No ☒

AVERAGE DAILY TRAFFIC: 25,000 Estimated 1982.

BYPASS DETOUR LENGTH: 2 miles.

ENCROACHMENTS: Nine 4"  $\varnothing$  conduits in the north exterior bay.

SEISMIC RETROFIT: Not applicable. Vertical restrainers were installed during construction.

CONDITION OF STRUCTURE: The overall condition of the structure is good.

LOAD CAPACITY: The inventory, operating and permit ratings shown were determined in accordance with the 1979 AASHTO Standard Specifications for Highway Bridges utilizing the "Frame Rate" program using the load factor method of analysis.

RECOMMENDED POSTING: None.

RECOMMENDATION: None.

*E. L. Neff*  
E. L. Neff  
C 28703

ELN:cd  
cc: DRHiggins (2)  
Orange County (2)

(2)

STATE OF CALIFORNIA  
DEPARTMENT OF TRANSPORTATION  
SUPPLEMENTARY BRIDGE REPORT  
DHQS M19 (REV. 1/74)

Bridge No. 55C-371  
Location 7-Ora-FAU M029-CR  
Dist - Co - Rte - PM - City (On deck)  
Date of Investigation June 8, 1982

Name SANTA ANA RIVER (Segerstrom - Slater, 0.3 mile west of Harbor Boulevard)

CONDITION RATING:

APPRAISAL RATING:

Deck 8 Superstructure 8 Substr. & Pipes 8 Overall 8  
Channel & Channel Protection 8 Retaining Walls N

Widenable? Yes ☒ No ☐ Conditional ☐

Action Required by <sup>County</sup> District: Yes ☐ No ☒

PRIORITY

A - Immediate Action  
B - Early Scheduling  
C - Routine Maint.  
O - For Record Only

CONDITION OF STRUCTURE:

The overall condition of the structure is good.

RECOMMENDED POSTING:

None.

RECOMMENDATION:

None.

*E. L. Neff*  
E. L. Neff  
C 28703

ELN:cd

cc: DRHiggins (2)  
Orange County (2)

STATE OF CALIFORNIA  
DEPARTMENT OF TRANSPORTATION  
SUPPLEMENTARY BRIDGE REPORT  
DH-QS M19 (REV. 1/74)

Bridge No. 55C-371  
Location 07-0ra-FAU M029-CR  
Dist - Co - Rte - PM - City (On deck)  
Date of Investigation August 20, 1981

Name SANTA ANA RIVER (Segerstrom Ave./Slater Ave., 0.3 mile west  
of Harbor Blvd.)  
CONDITION RATING: APPRAISAL RATING:

Deck 8 Superstructure 8 Substr. & Pipes 8 Overall 8  
Channel & Channel Protection 8 Retaining Walls N

Widenable? Yes ☒ No ☐ Conditional ☐  
County: Orange  
Action Required by District: Yes ☒ No ☐

WORK DONE:

The previously recommended work has not been done, i.e., correct the offset between the bridge deck and the AC approach pavement at the westerly paving notch.

CONDITION OF STRUCTURE:

The overall condition of the structure is good.

RECOMMENDED POSTING:

None.

RECOMMENDATION:



Place 1" AC leveling blanket at the west bridge approach.

*E. L. Neff*  
E. L. Neff  
C 28703

ELN:cd  
cc: DRHiggins (2)  
Orange County (2)

ORANGE COUNTY  
ENVIRONMENTAL MANAGEMENT AGENCY  
SANTA ANA, CALIFORNIA  
M. STORM, DIRECTOR

PLANS FOR THE WIDENING OF  
**SLATER - SEGERSTROM  
BRIDGE**  
**SA-31A**  
ACROSS  
SANTA ANA RIVER  
(CHANNEL E01)

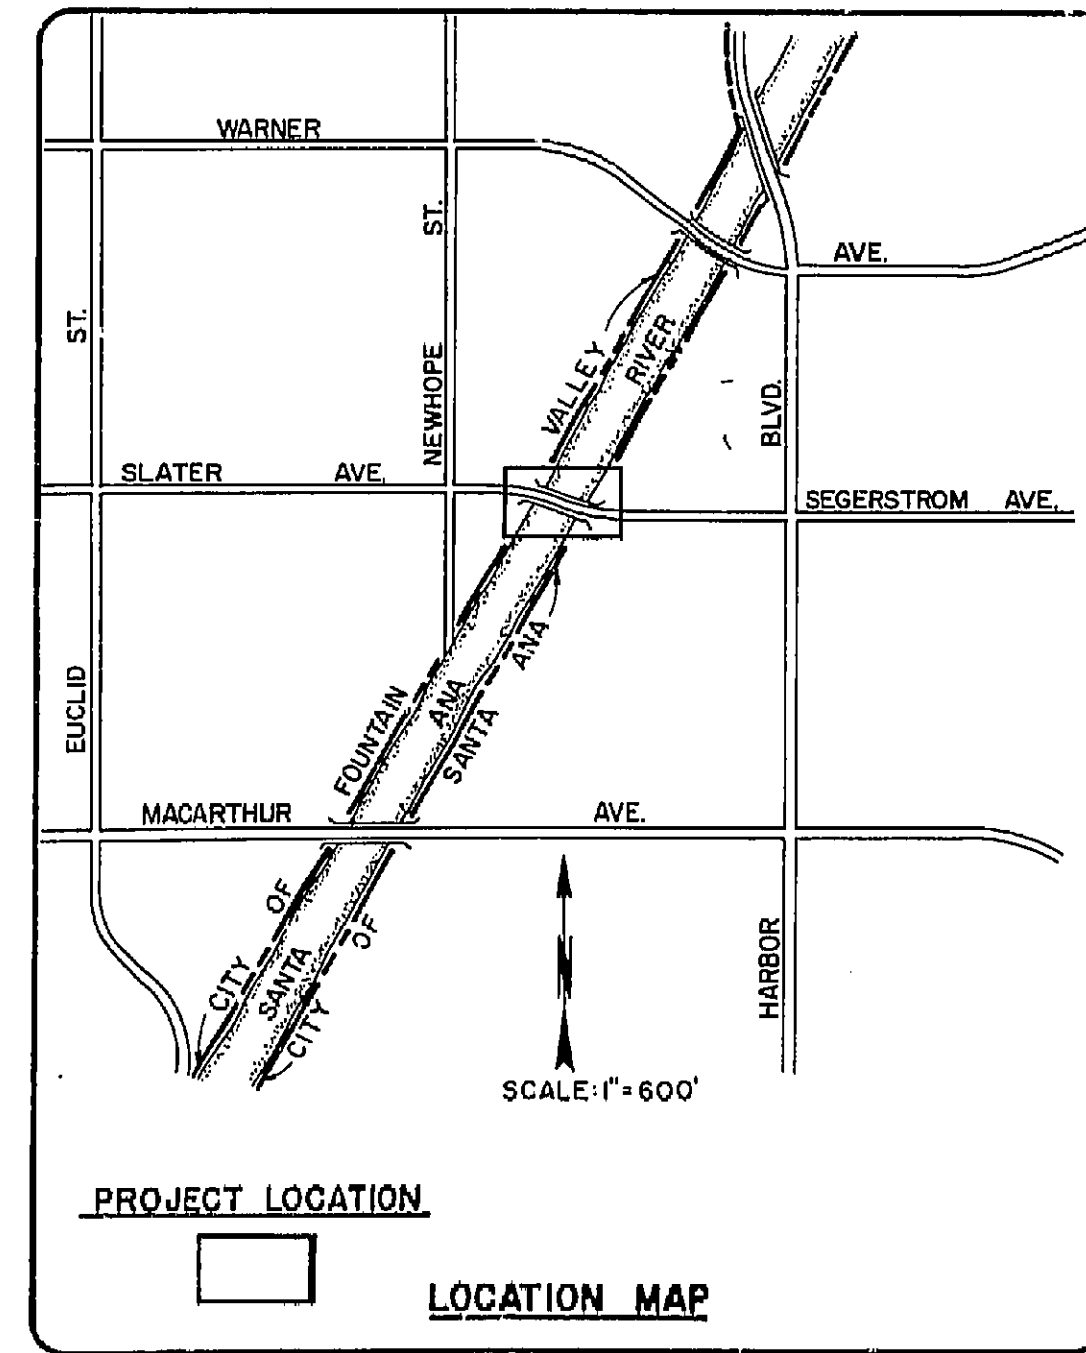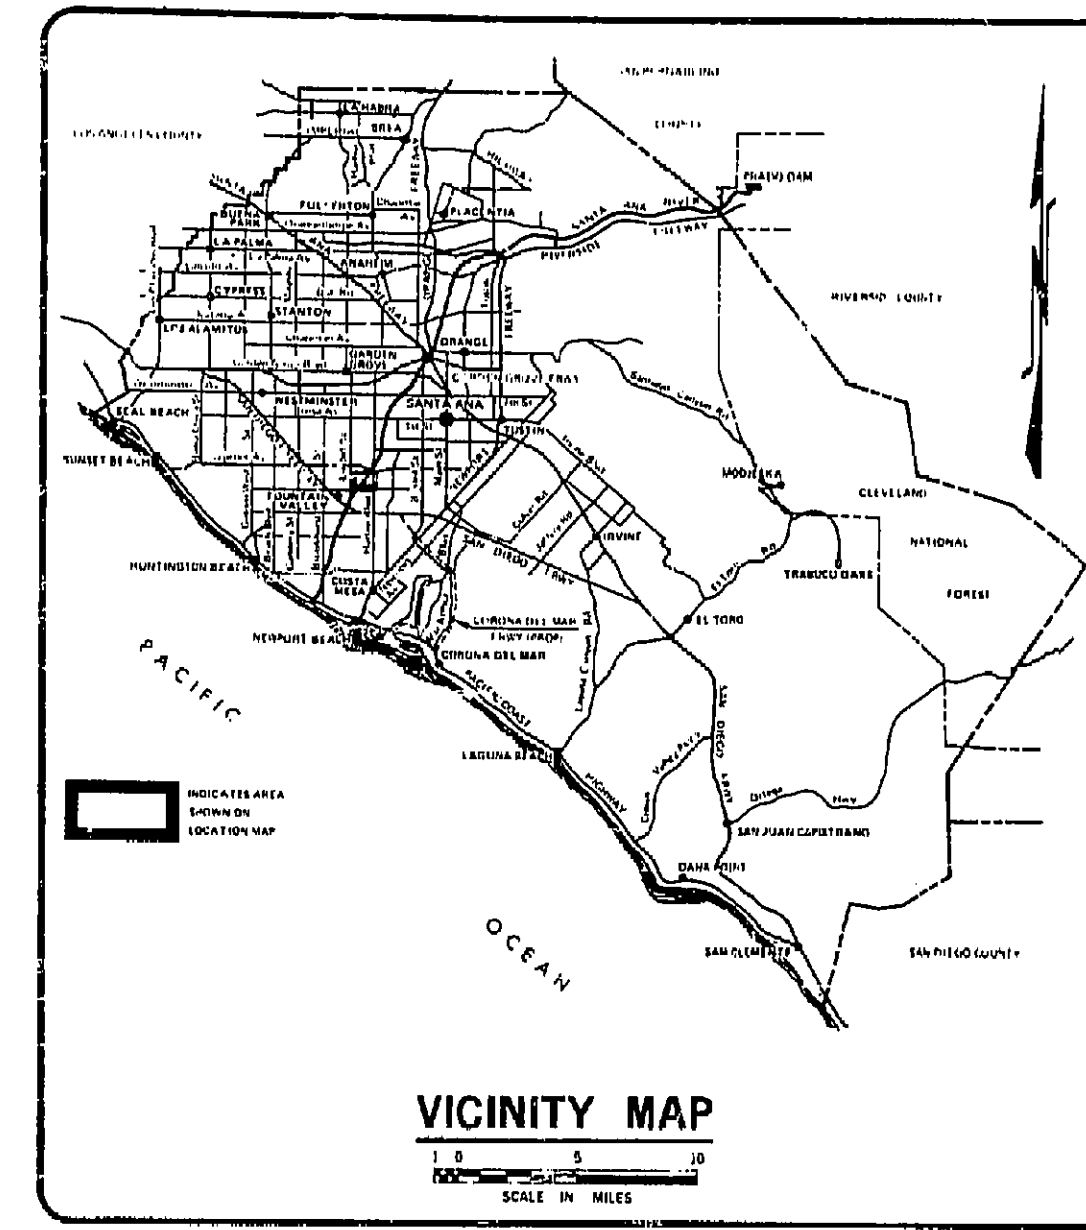

| INDEX OF SHEETS |                                         |
|-----------------|-----------------------------------------|
| SHEET           | DESCRIPTION                             |
| 1               | TITLE SHEET                             |
| 2               | GENERAL PLAN                            |
| 3               | FOUNDATION PLAN                         |
| 4               | ABUTMENT DETAILS                        |
| 5               | PIER DETAILS                            |
| 6               | SUPERSTRUCTURE LAYOUT AND REINFORCEMENT |
| 7               | TYPICAL SECTION                         |
| 8               | BARRIER RAILING - TYPE II               |
| 9               | METAL RAILING DETAILS - TYPE II         |
| 10              | T-BEAM AND EXCAVATION DETAILS           |
| 11              | MISCELLANEOUS DETAILS                   |
| 12              | PILING DETAILS                          |
| 13              | TEMPORARY RAILING                       |
| 14              | ELECTRICAL DETAILS                      |
| 15              | LOG OF TEST BORINGS                     |
| 16              | CONCRETE SLOPE LINING REMOVAL (4)       |
| 17              | REPLACEMENT DETAILS                     |
| 18              | ROAD APPROACH DETAILS                   |
| 19              | TRAFFIC STRIPING DIAGRAM                |

| UTILITY                                     | PHONE NO.            |
|---------------------------------------------|----------------------|
| SOUTHERN CALIFORNIA EDISON COMPANY          | (213) 435-1121 X 368 |
| PACIFIC TELEPHONE & TELEGRAPH COMPANY       | (714) 999 5715       |
| COUNTY SANITATION DISTRICT OF ORANGE COUNTY | (714) 962-2411       |
| CITY OF SANTA ANA                           | (714) 834-4152       |
| CITY OF FOUNTAIN VALLEY                     | (714) 963-8321       |
| NATIONAL WEATHER SERVICE                    | (213) 824 7211       |

**BENCH MARK:**  
ALUMINUM CAP FV-73-75  
AT THE NW'LY CORNER OF SLATER AVE AND NEWHOPE ST. 108.6' NORTH OF CL. OF SLATER AVE. AND 33.2' WEST OF CL. OF NEWHOPE ST. IN NE'LY CORNER OF A LARGE CATCH BASIN.  
ELEV. 35.713 ADJUSTED, 1976

**BASIS OF BEARING:**  
THE CENTERLINE OF SLATER-SEGERSTROM AVENUES  
S. 74° 11' 52" W. AS SHOWN ON S.M. 71-4

FUNDED BY: HIGHWAY USERS' TAXES

**EMA-DEVELOPMENT**  
SUBMITTED: *William H. Taylor* 6/9/81  
SECTION CHIEF RCE 16799  
RECOMMENDED: *William H. Taylor* 6/9/81  
DIVISION MANAGER RCE 13184  
APPROVED: *C.R. Nelson* 6-9-81  
DIRECTOR PUBLIC WORKS RCE 13142


PREPARED BY:  
**WHEELER AND GRAY**  
2912 CHAMBERS RD., STE 206  
TUSTIN, CA. 92680  
PH. (714) 731-4717  
*Donald Blackford* S.E. # 918

| NO.       | DESCRIPTION | SHT. | APPROVED | DATE |
|-----------|-------------|------|----------|------|
| REVISIONS |             |      |          |      |

W.O. NO. R09288  
DWG. NO. SHEET 1 OF 18

**AS BUILT PLANS**  
Contract No. UNKNOWN  
Date Completed           
Document No. 70008509


I HEREBY CERTIFY THAT THIS IS A TRUE AND ACCURATE COPY OF THE ABOVE DOCUMENT TAKEN UNDER MY DIRECTION AND CONTROL ON THIS DATE IN SACRAMENTO, CALIFORNIA PURSUANT TO AUTHORIZATION BY THE DIRECTOR OF TRANSPORTATION.  
DATE 10-29-82 SIGNATURE *Donald Blackford* TITLE SUPERVISOR OF MICROFILM SERVICES  
DAS-55-78

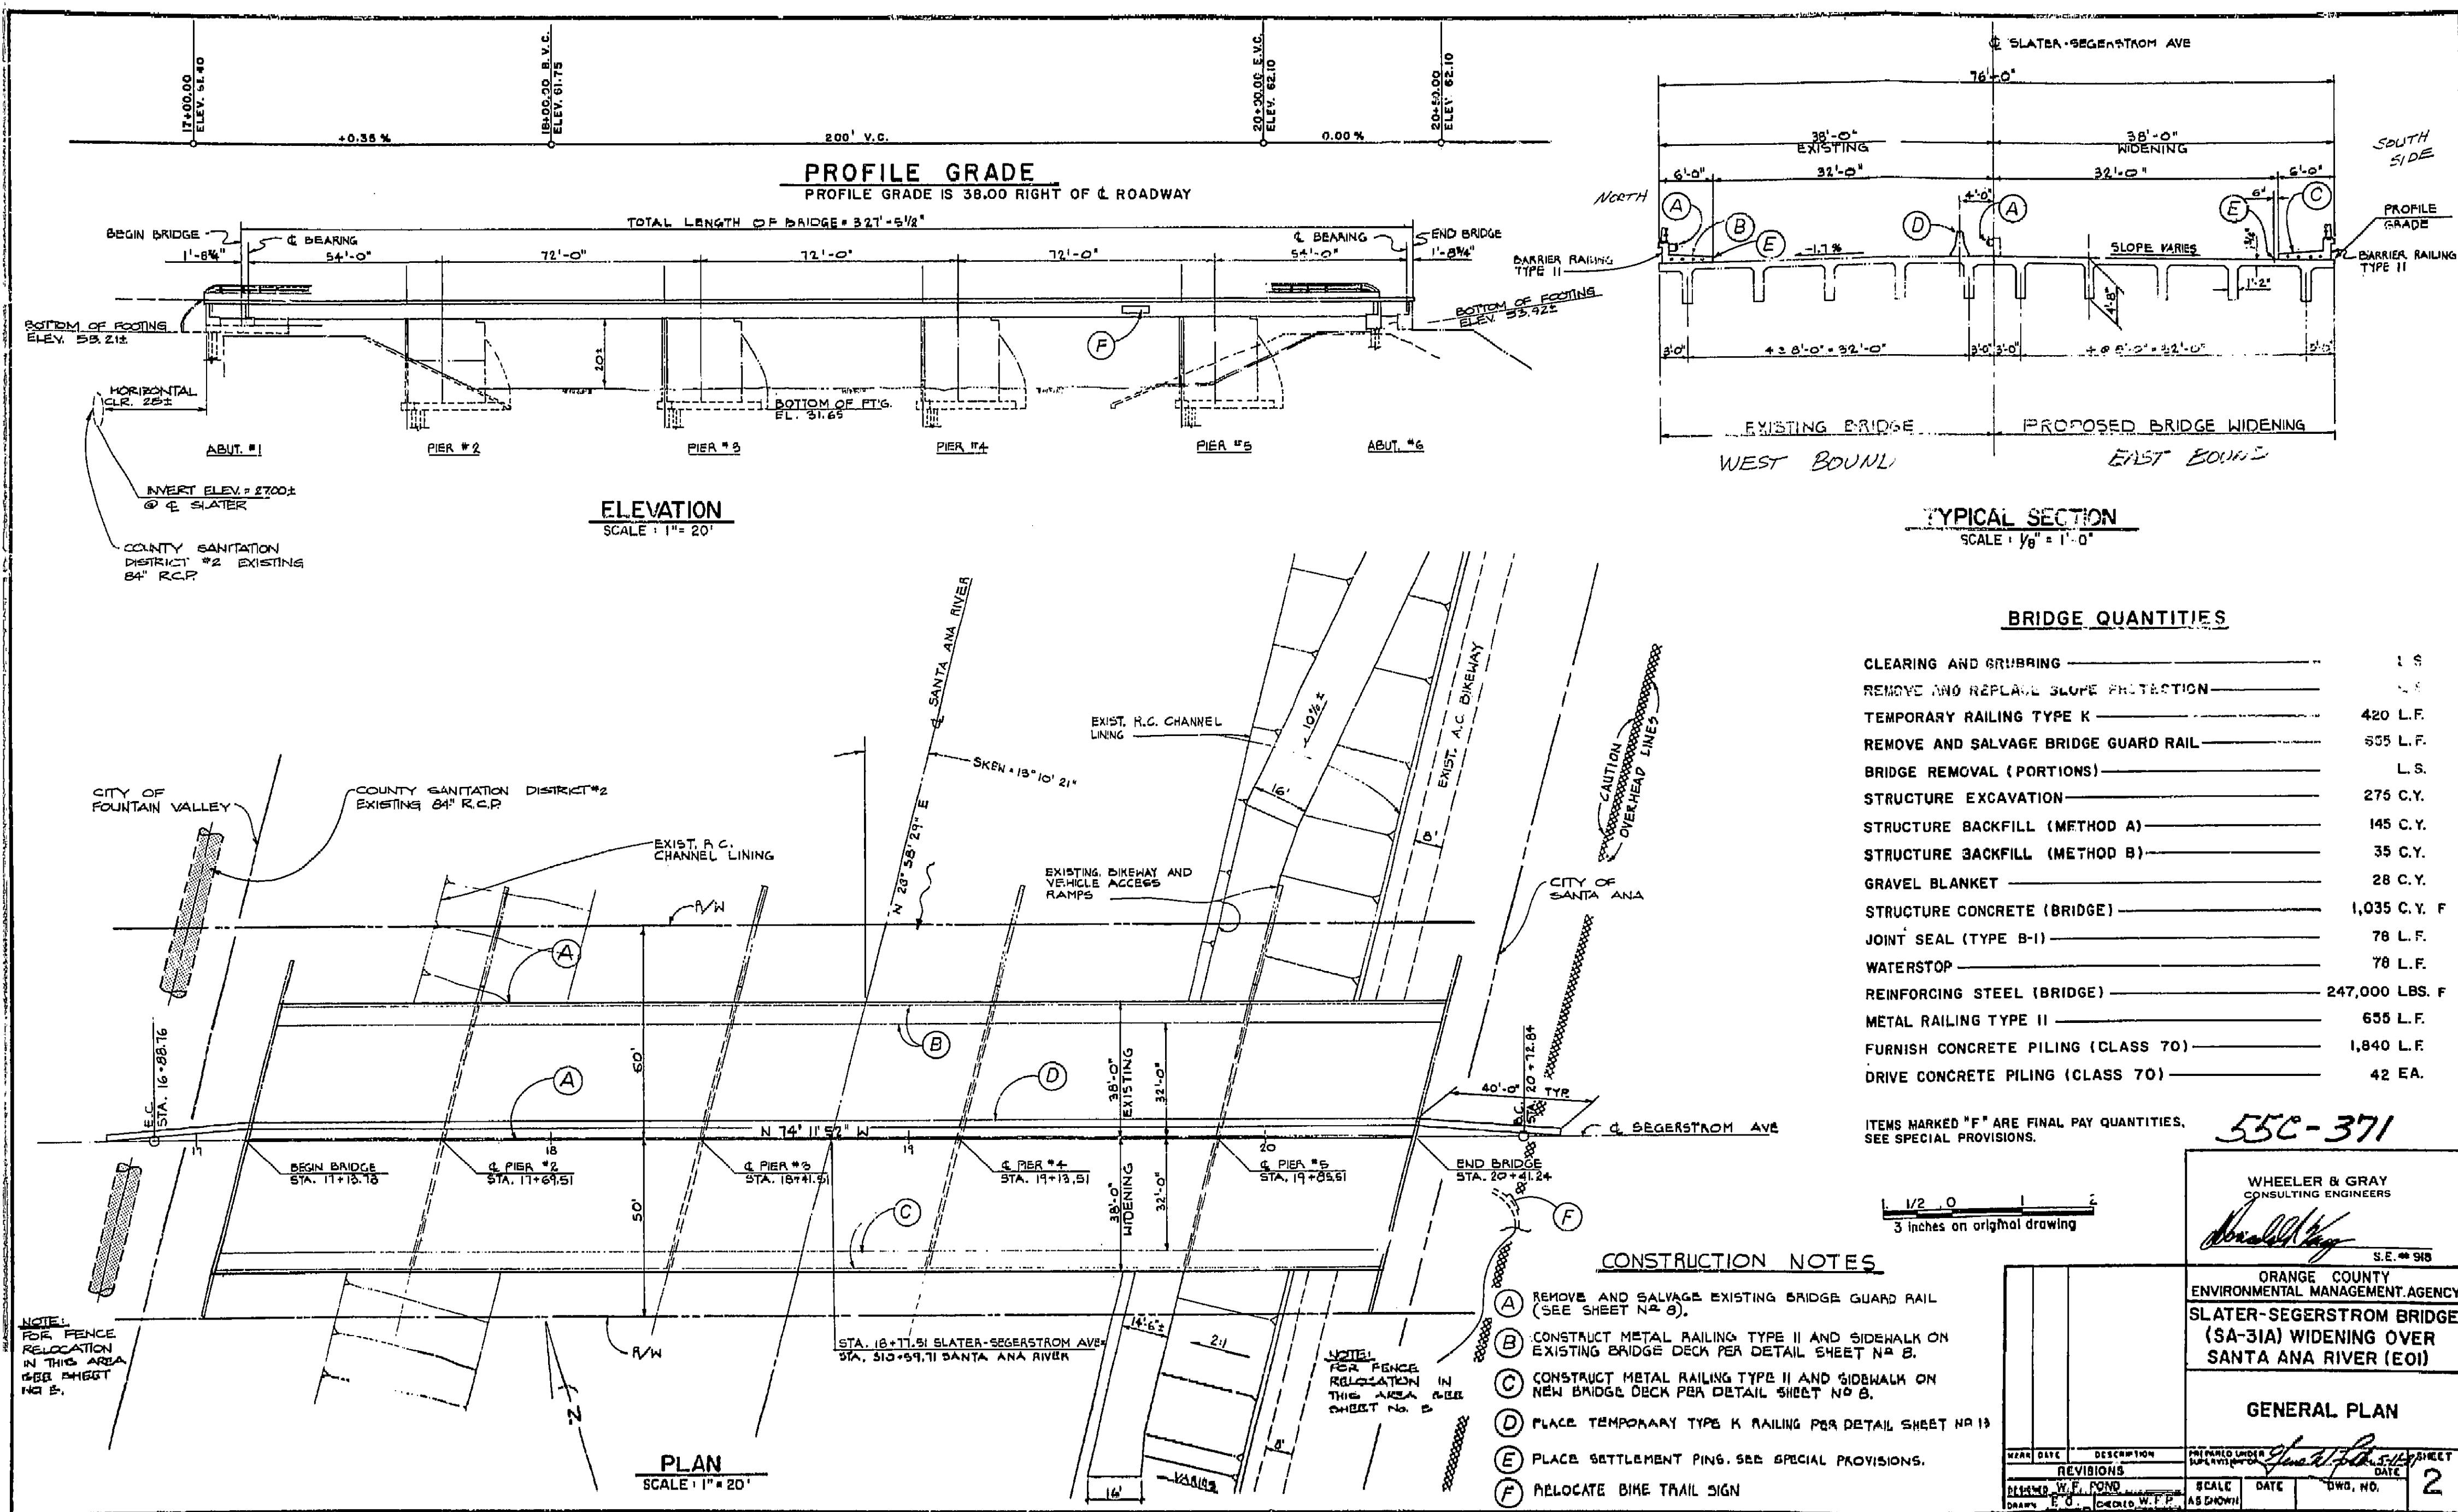

**AS BUILT PLANS**  
Contract No. UNKNOWN  
Date Completed         
Document No. 70008509

I HEREBY CERTIFY THAT THIS IS A TRUE AND ACCURATE COPY OF THE ABOVE DOCUMENT TAKE UNDER MY DIRECTION AND CONTROL ON THIS DATE IN SACRAMENTO, CALIFORNIA PURSUANT TO AUTHORIZATION BY THE DIRECTOR OF TRANSPORTATION.


DATE: 10-29-82  
SIGNATURE: Donald Blackford  
TITLE: SUPERVISOR OF MICROFILM SERVICES

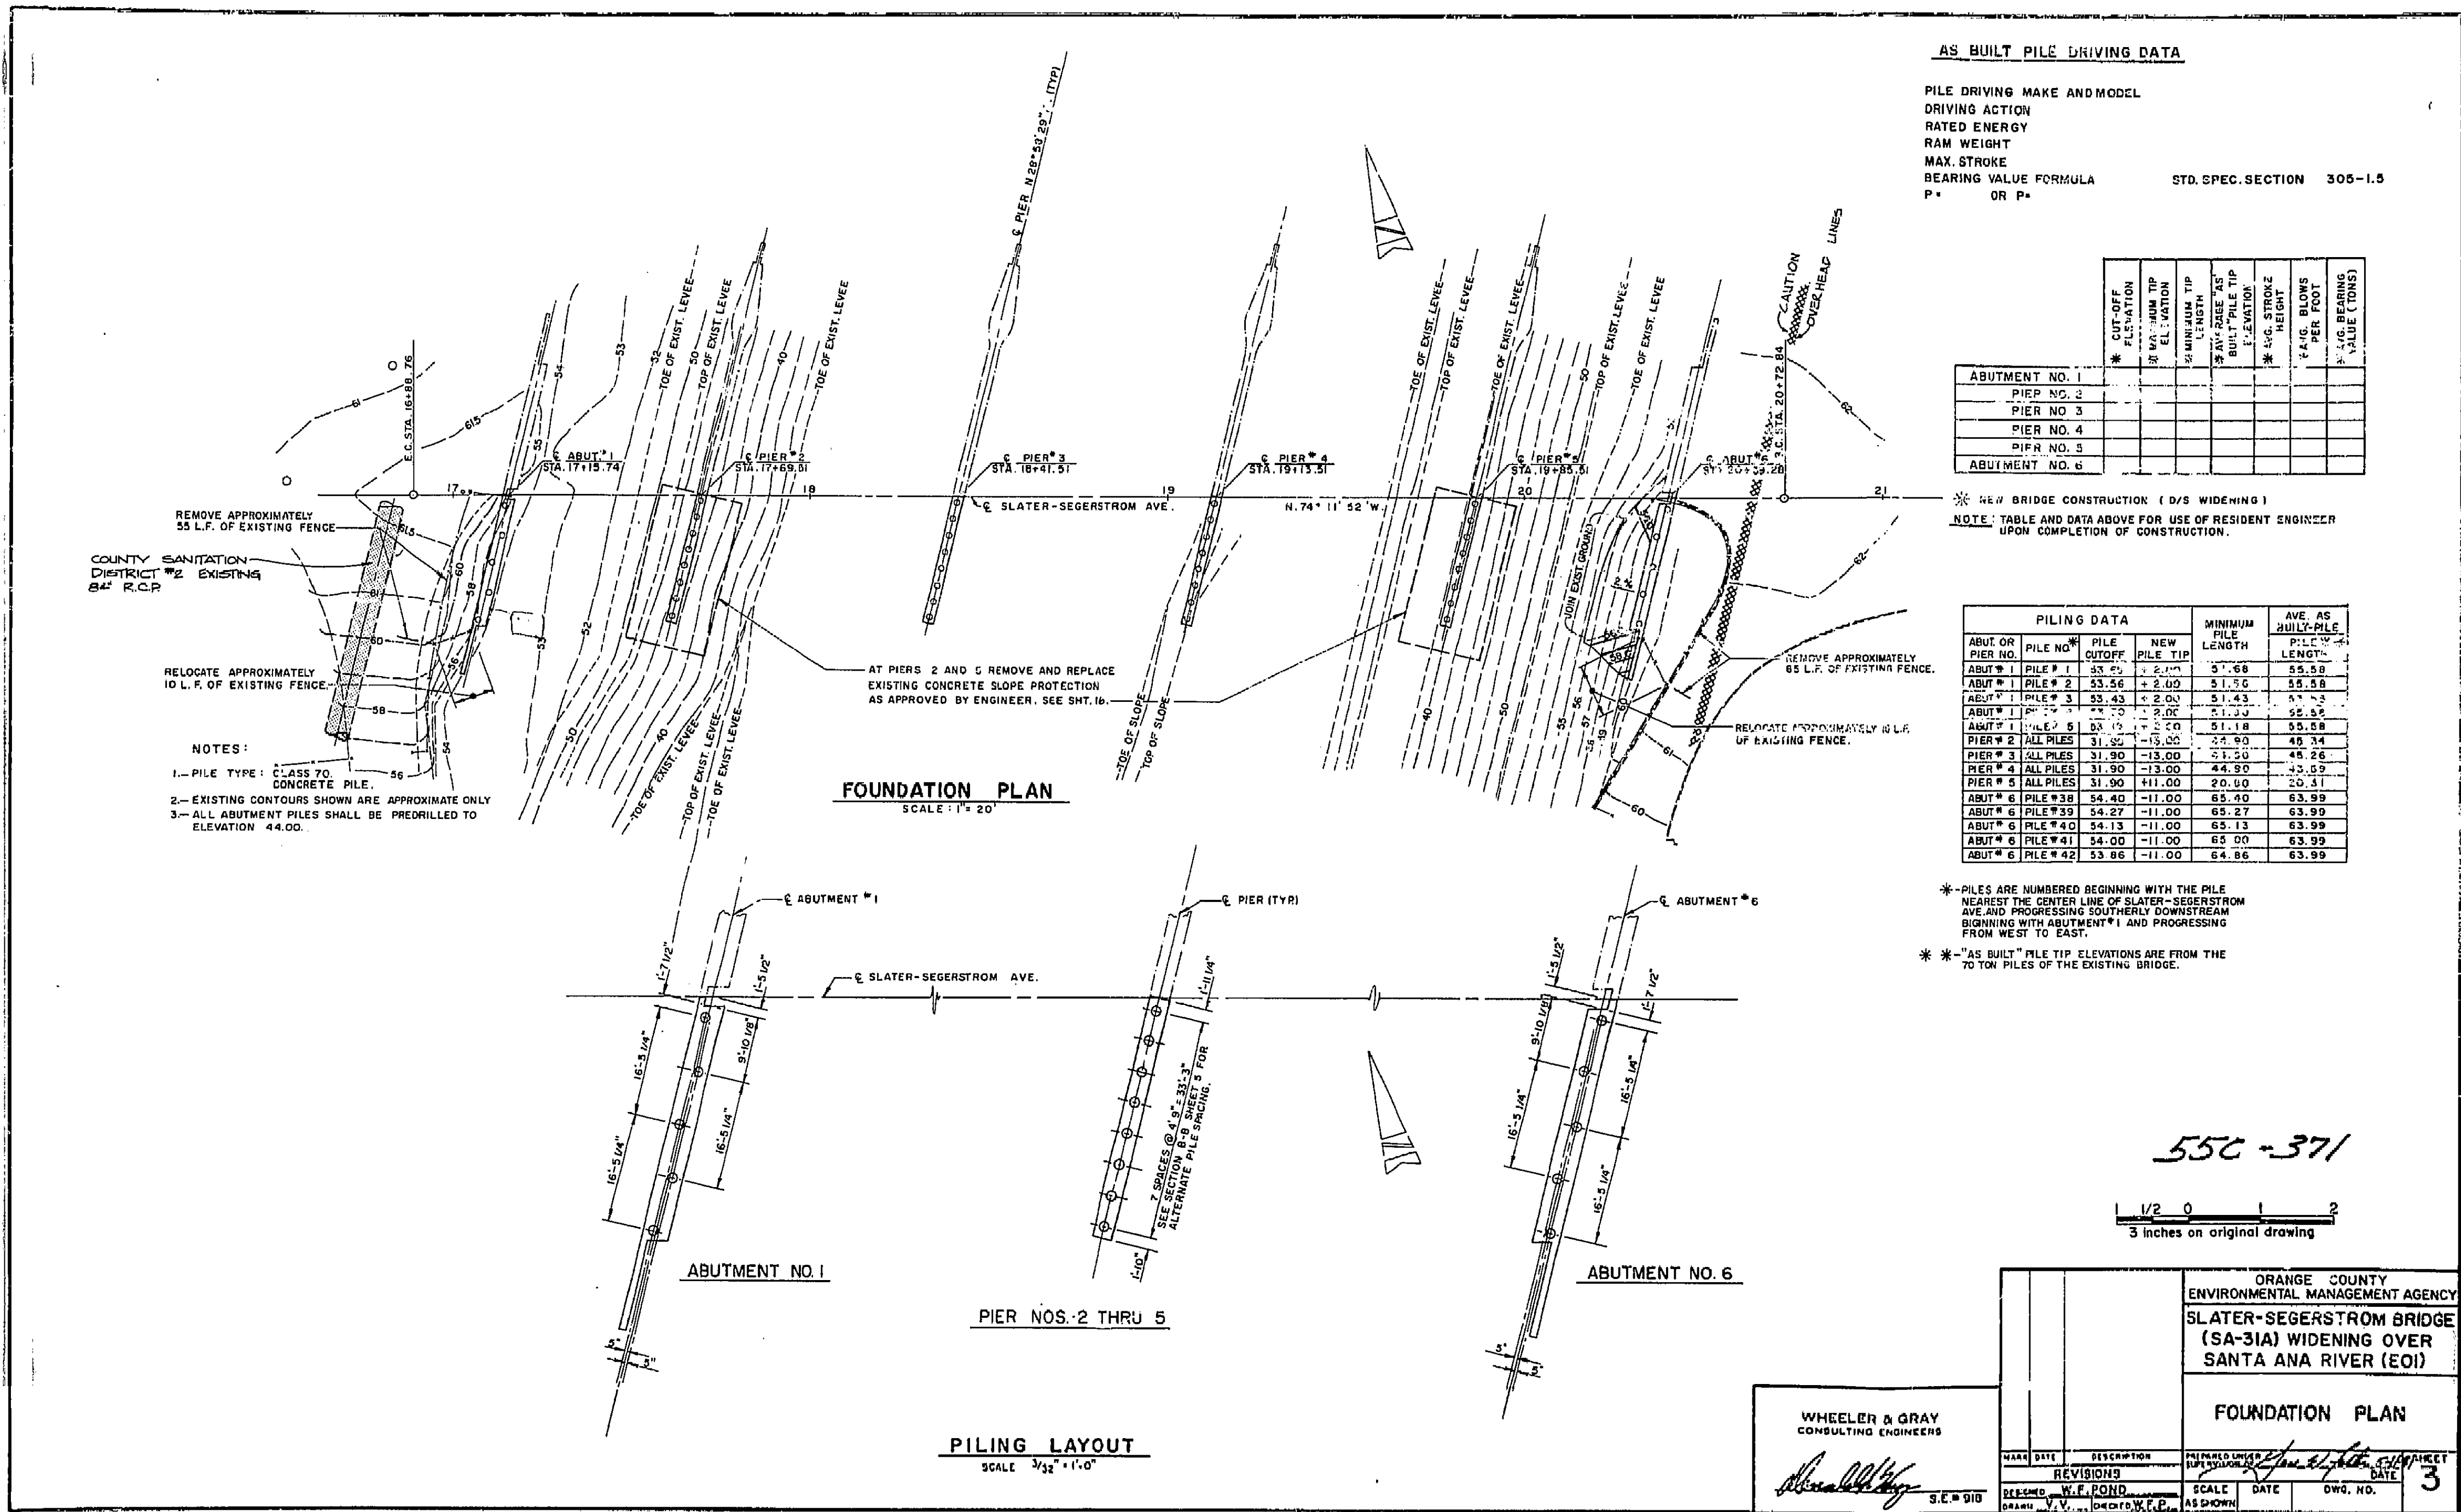

**AS BUILT PLANS**  
Contract No. UNKNOWN  
Date Completed             
Document No. 70008509

I HEREBY CERTIFY THAT THIS IS A TRUE AND ACCURATE COPY OF THE ABOVE DOCUMENT TAKEN UNDER MY DIRECTION AND CONTROL ON THIS DATE IN SACRAMENTO, CALIFORNIA PURSUANT TO AUTHORIZATION BY THE DIRECTOR OF TRANSPORTATION.


DATE: 10-29-82 SIGNATURE: Donald Blackford TITLE: SUPERVISOR OF MICROFILM SERVICES

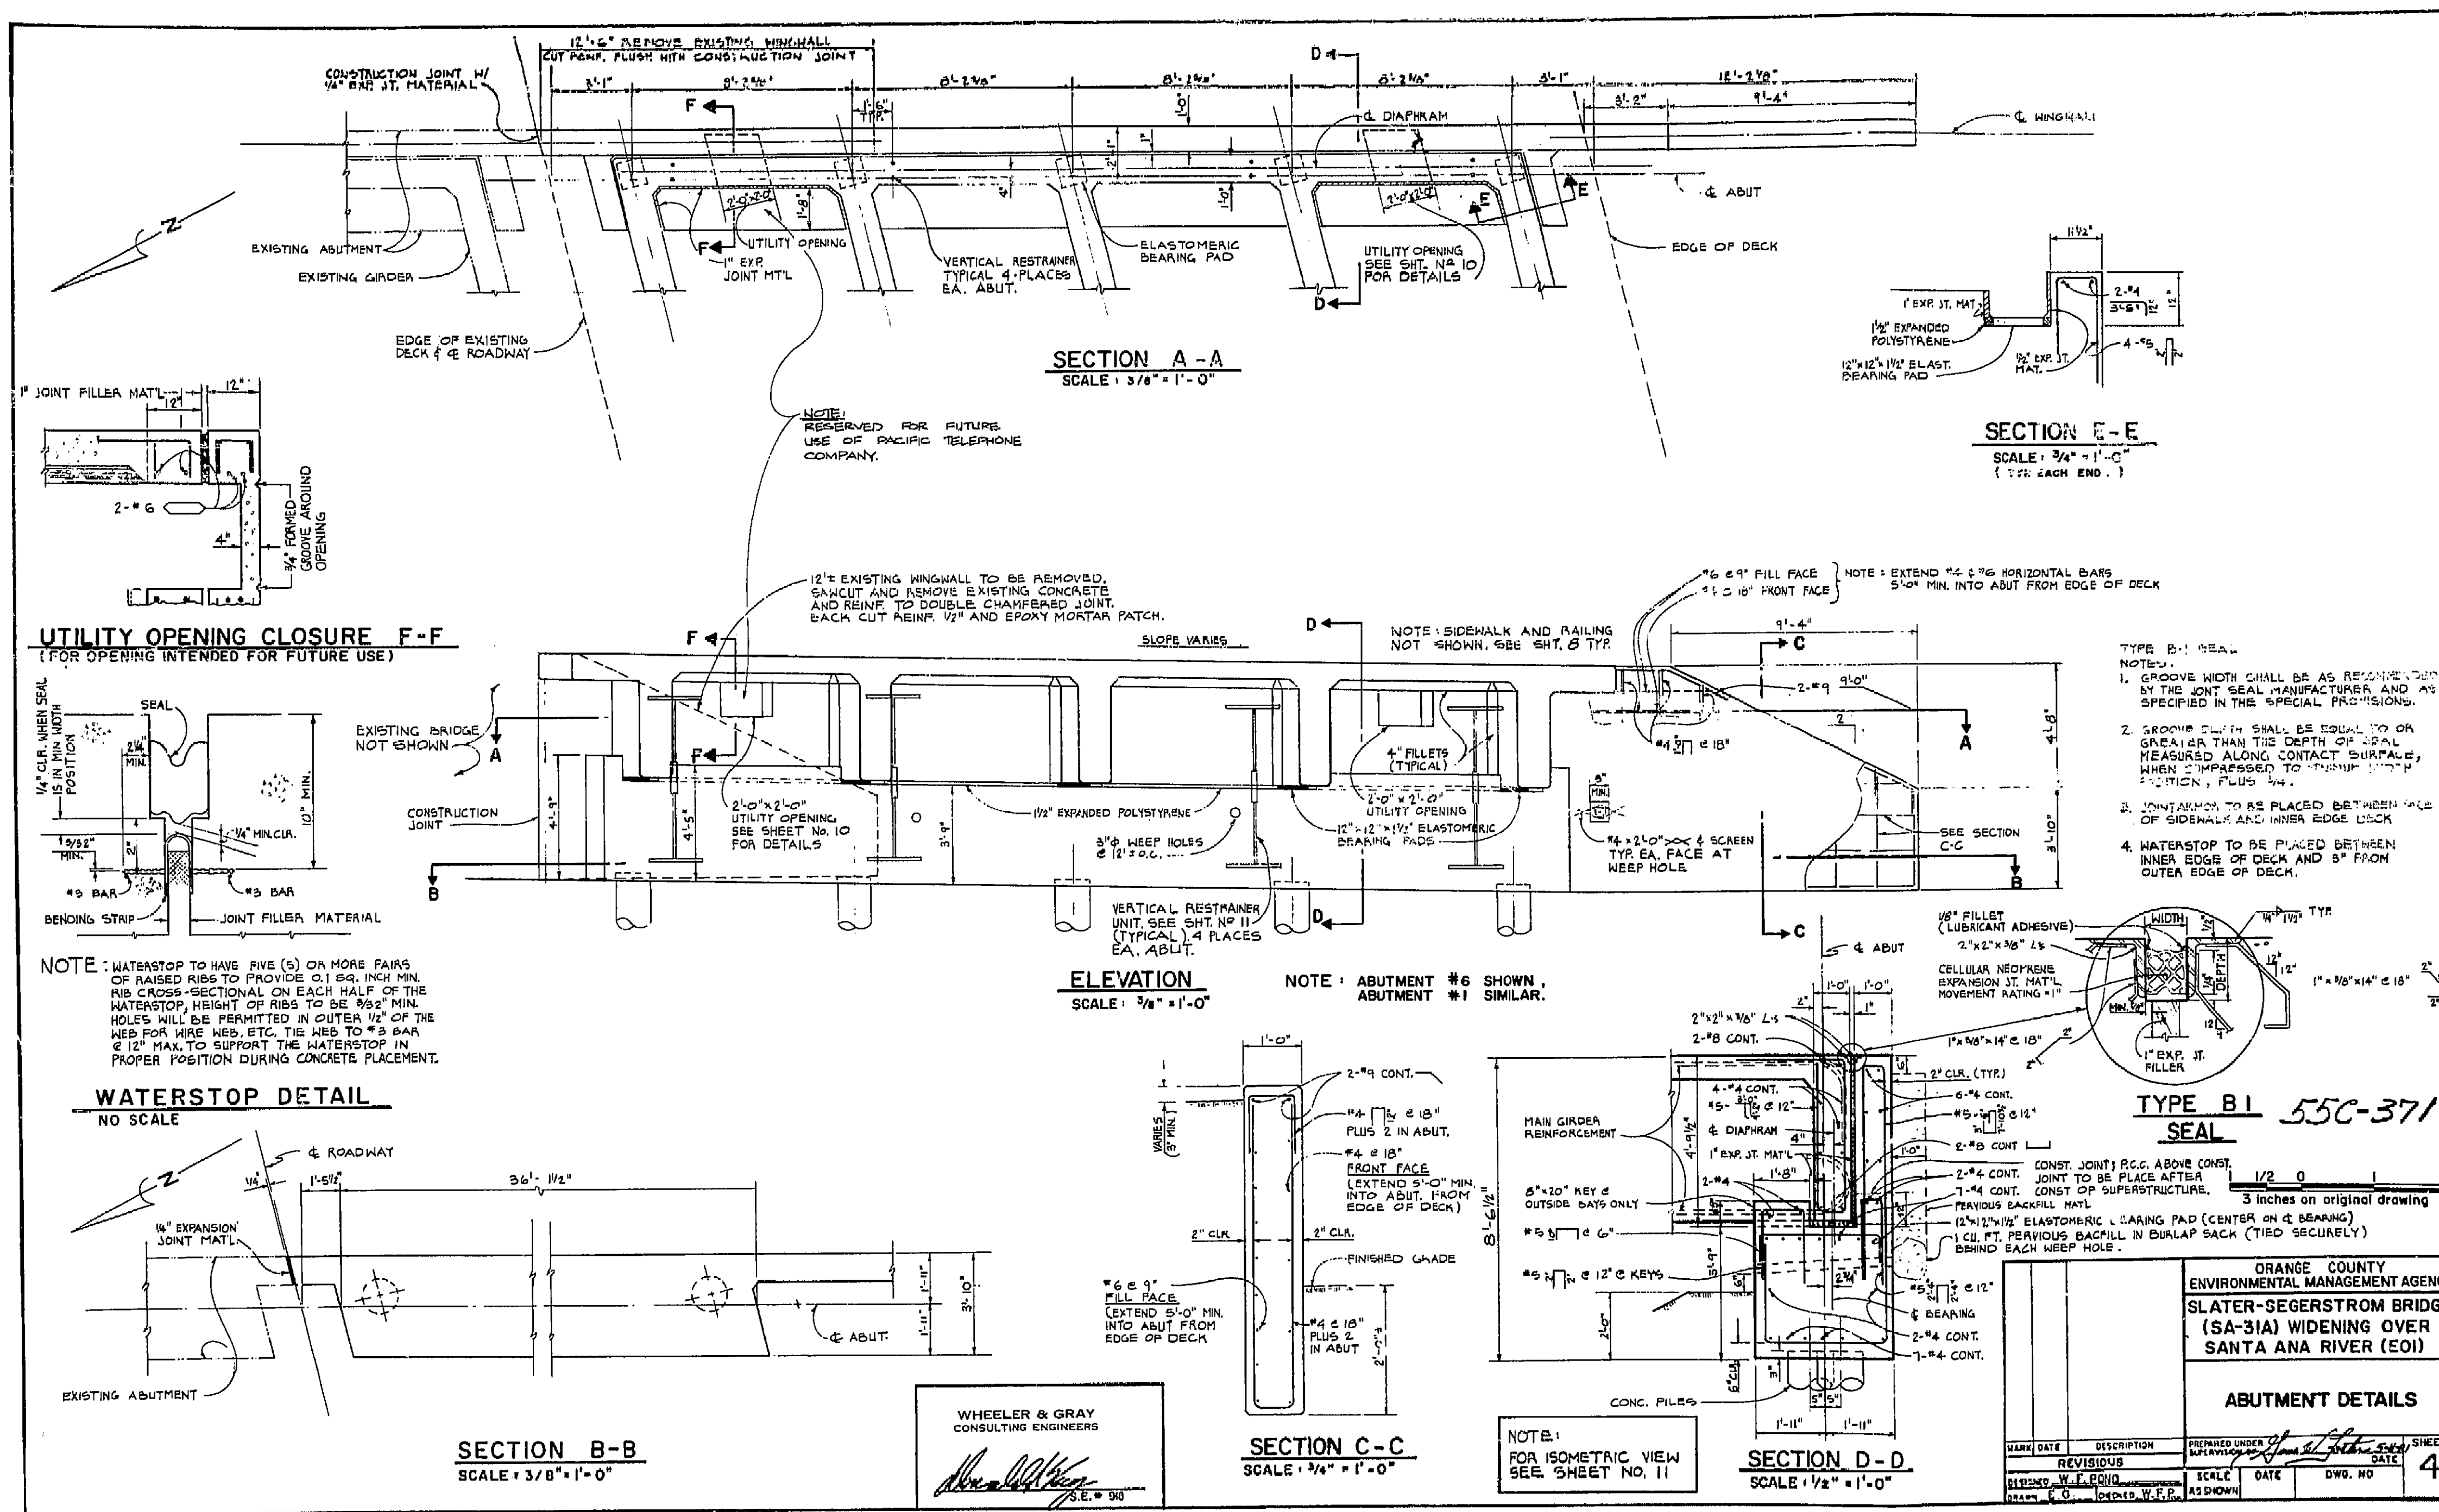

**AS BUILT PLANS**  
Contract No. UNKNOWN  
Date Completed 10-29-82  
Document No. 70008509

I HEREBY CERTIFY THAT THIS IS A TRUE AND ACCURATE COPY OF THE ABOVE DOCUMENT TAKEN UNDER MY DIRECTION AND CONTROL ON THIS DATE IN SACRAMENTO, CALIFORNIA PURSUANT TO AUTHORIZATION BY THE DIRECTOR OF TRANSPORTATION.


DATE 10-29-82 SIGNATURE Donald Blackford TITLE SUPERVISOR OF MICROFILM SERVICES

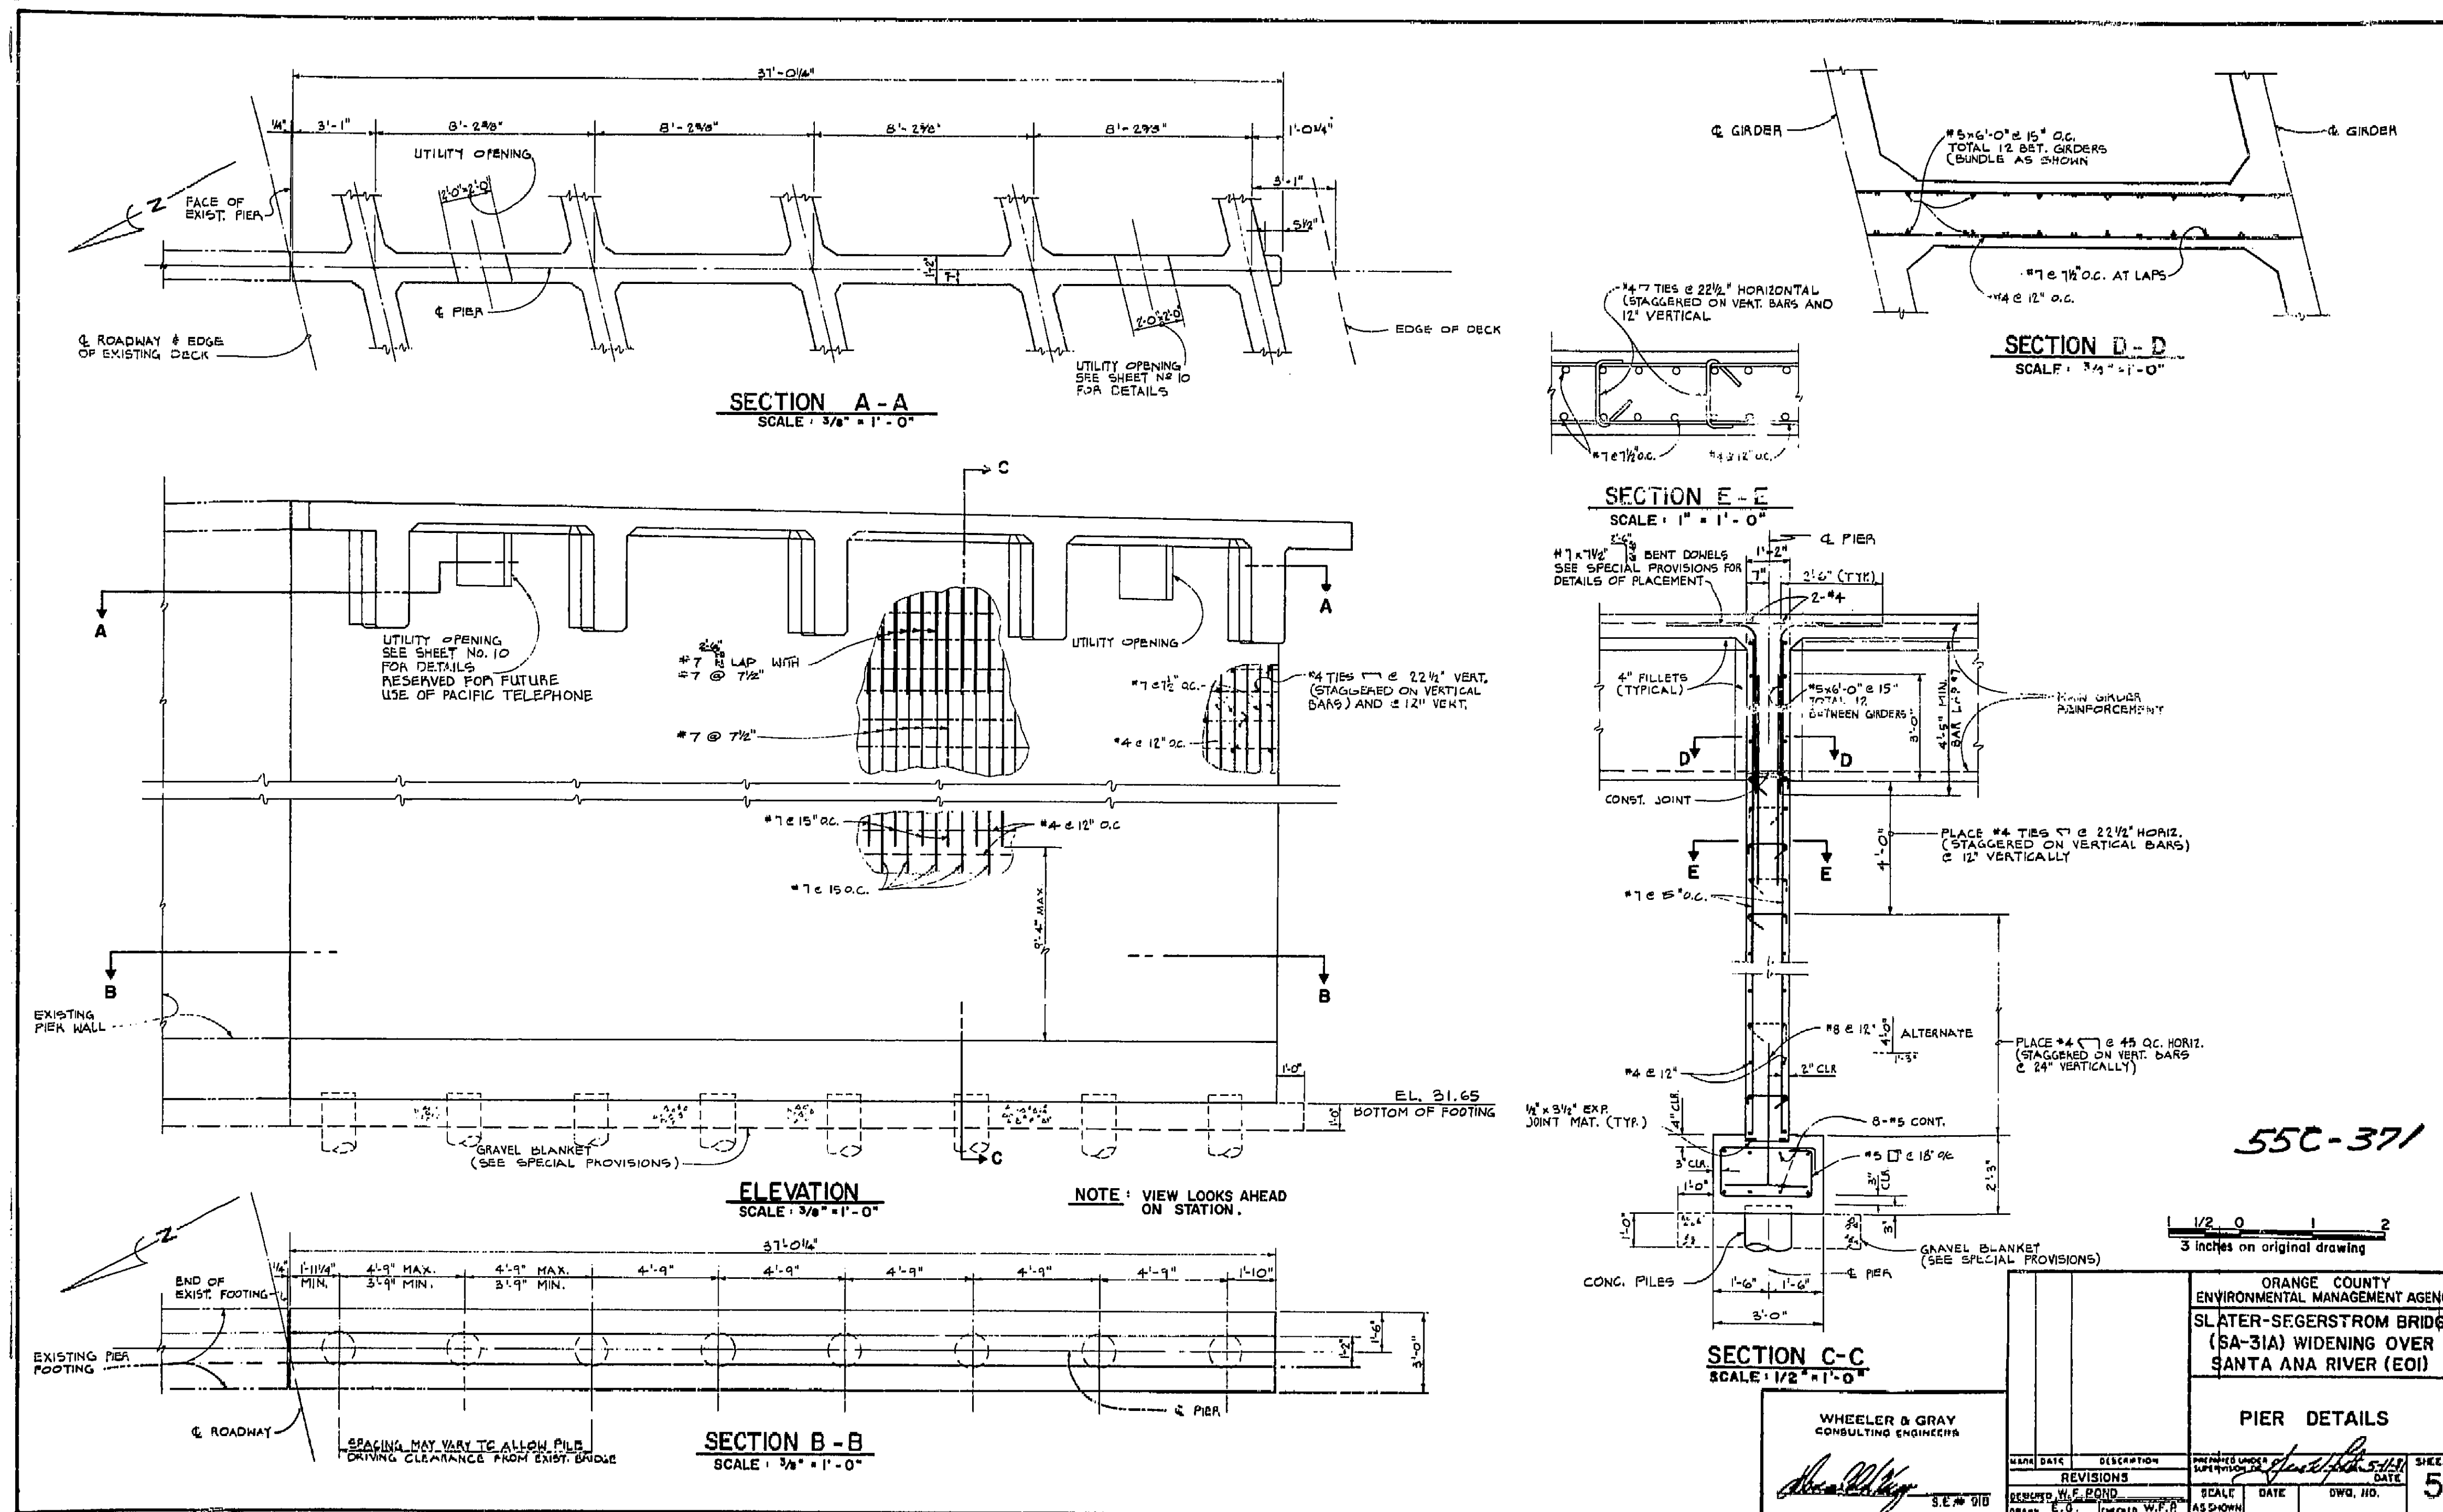

**AS BUILT PLANS**  
Contract No. **UNKNOWN**  
Date Completed  
Document No. **70008509**

I HEREBY CERTIFY THAT THIS IS A TRUE AND ACCURATE COPY OF THE ABOVE DOCUMENT TAKEN UNDER MY DIRECTION AND CONTROL ON THIS DATE IN SACRAMENTO, CALIFORNIA PURSUANT TO AUTHORIZATION BY THE DIRECTOR OF TRANSPORTATION.

**DATE** 10-29-82 **SIGNATURE** Donald Blackford **TITLE** SUPERVISOR OF MICROFILM SERVICES

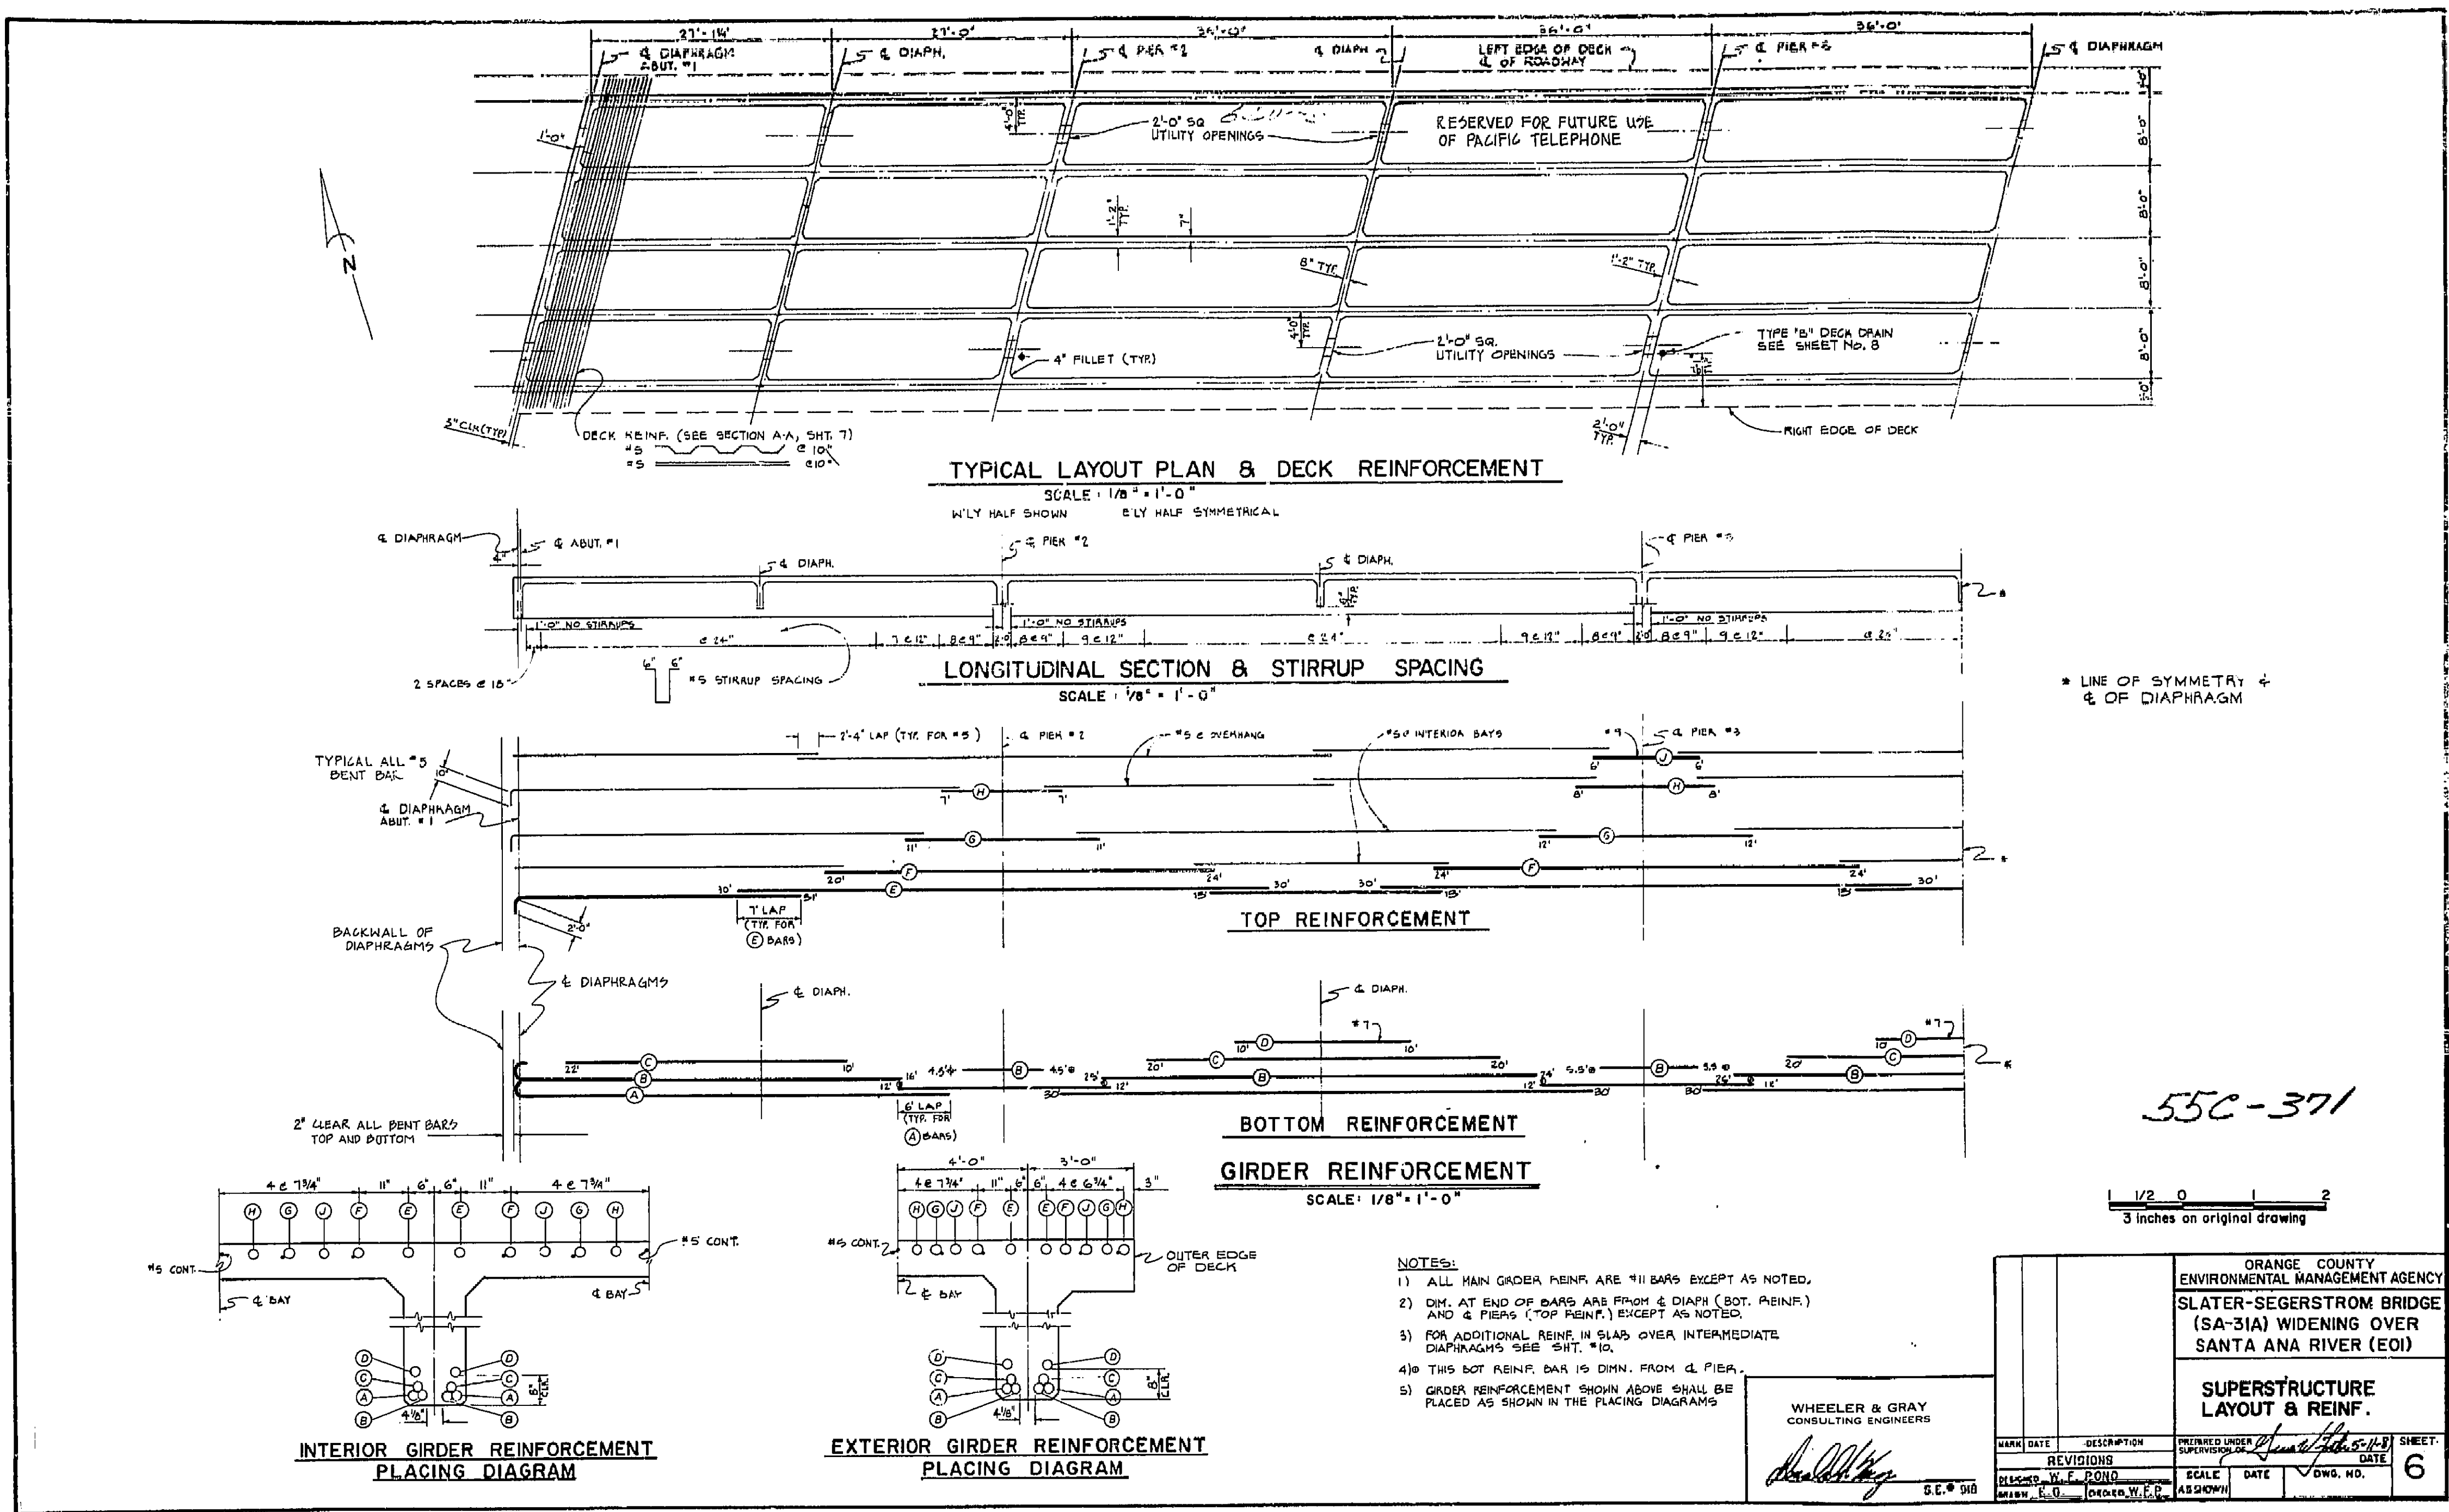


**AS BUILT PLANS**  
Contract No. UNKNOWN  
Date Completed 70008509  
Document No. 70008509

I HEREBY CERTIFY THAT THIS IS A TRUE AND ACCURATE COPY OF THE ABOVE DOCUMENT TAKEN UNDER MY DIRECTION AND CONTROL ON THIS DATE IN SACRAMENTO, CALIFORNIA PURSUANT TO AUTHORIZATION BY THE DIRECTOR OF TRANSPORTATION.

DATE: 10-29-82  
SIGNATURE: Donald E. Lachford  
TITLE: SUPERVISOR OF MICROFILM SERVICES



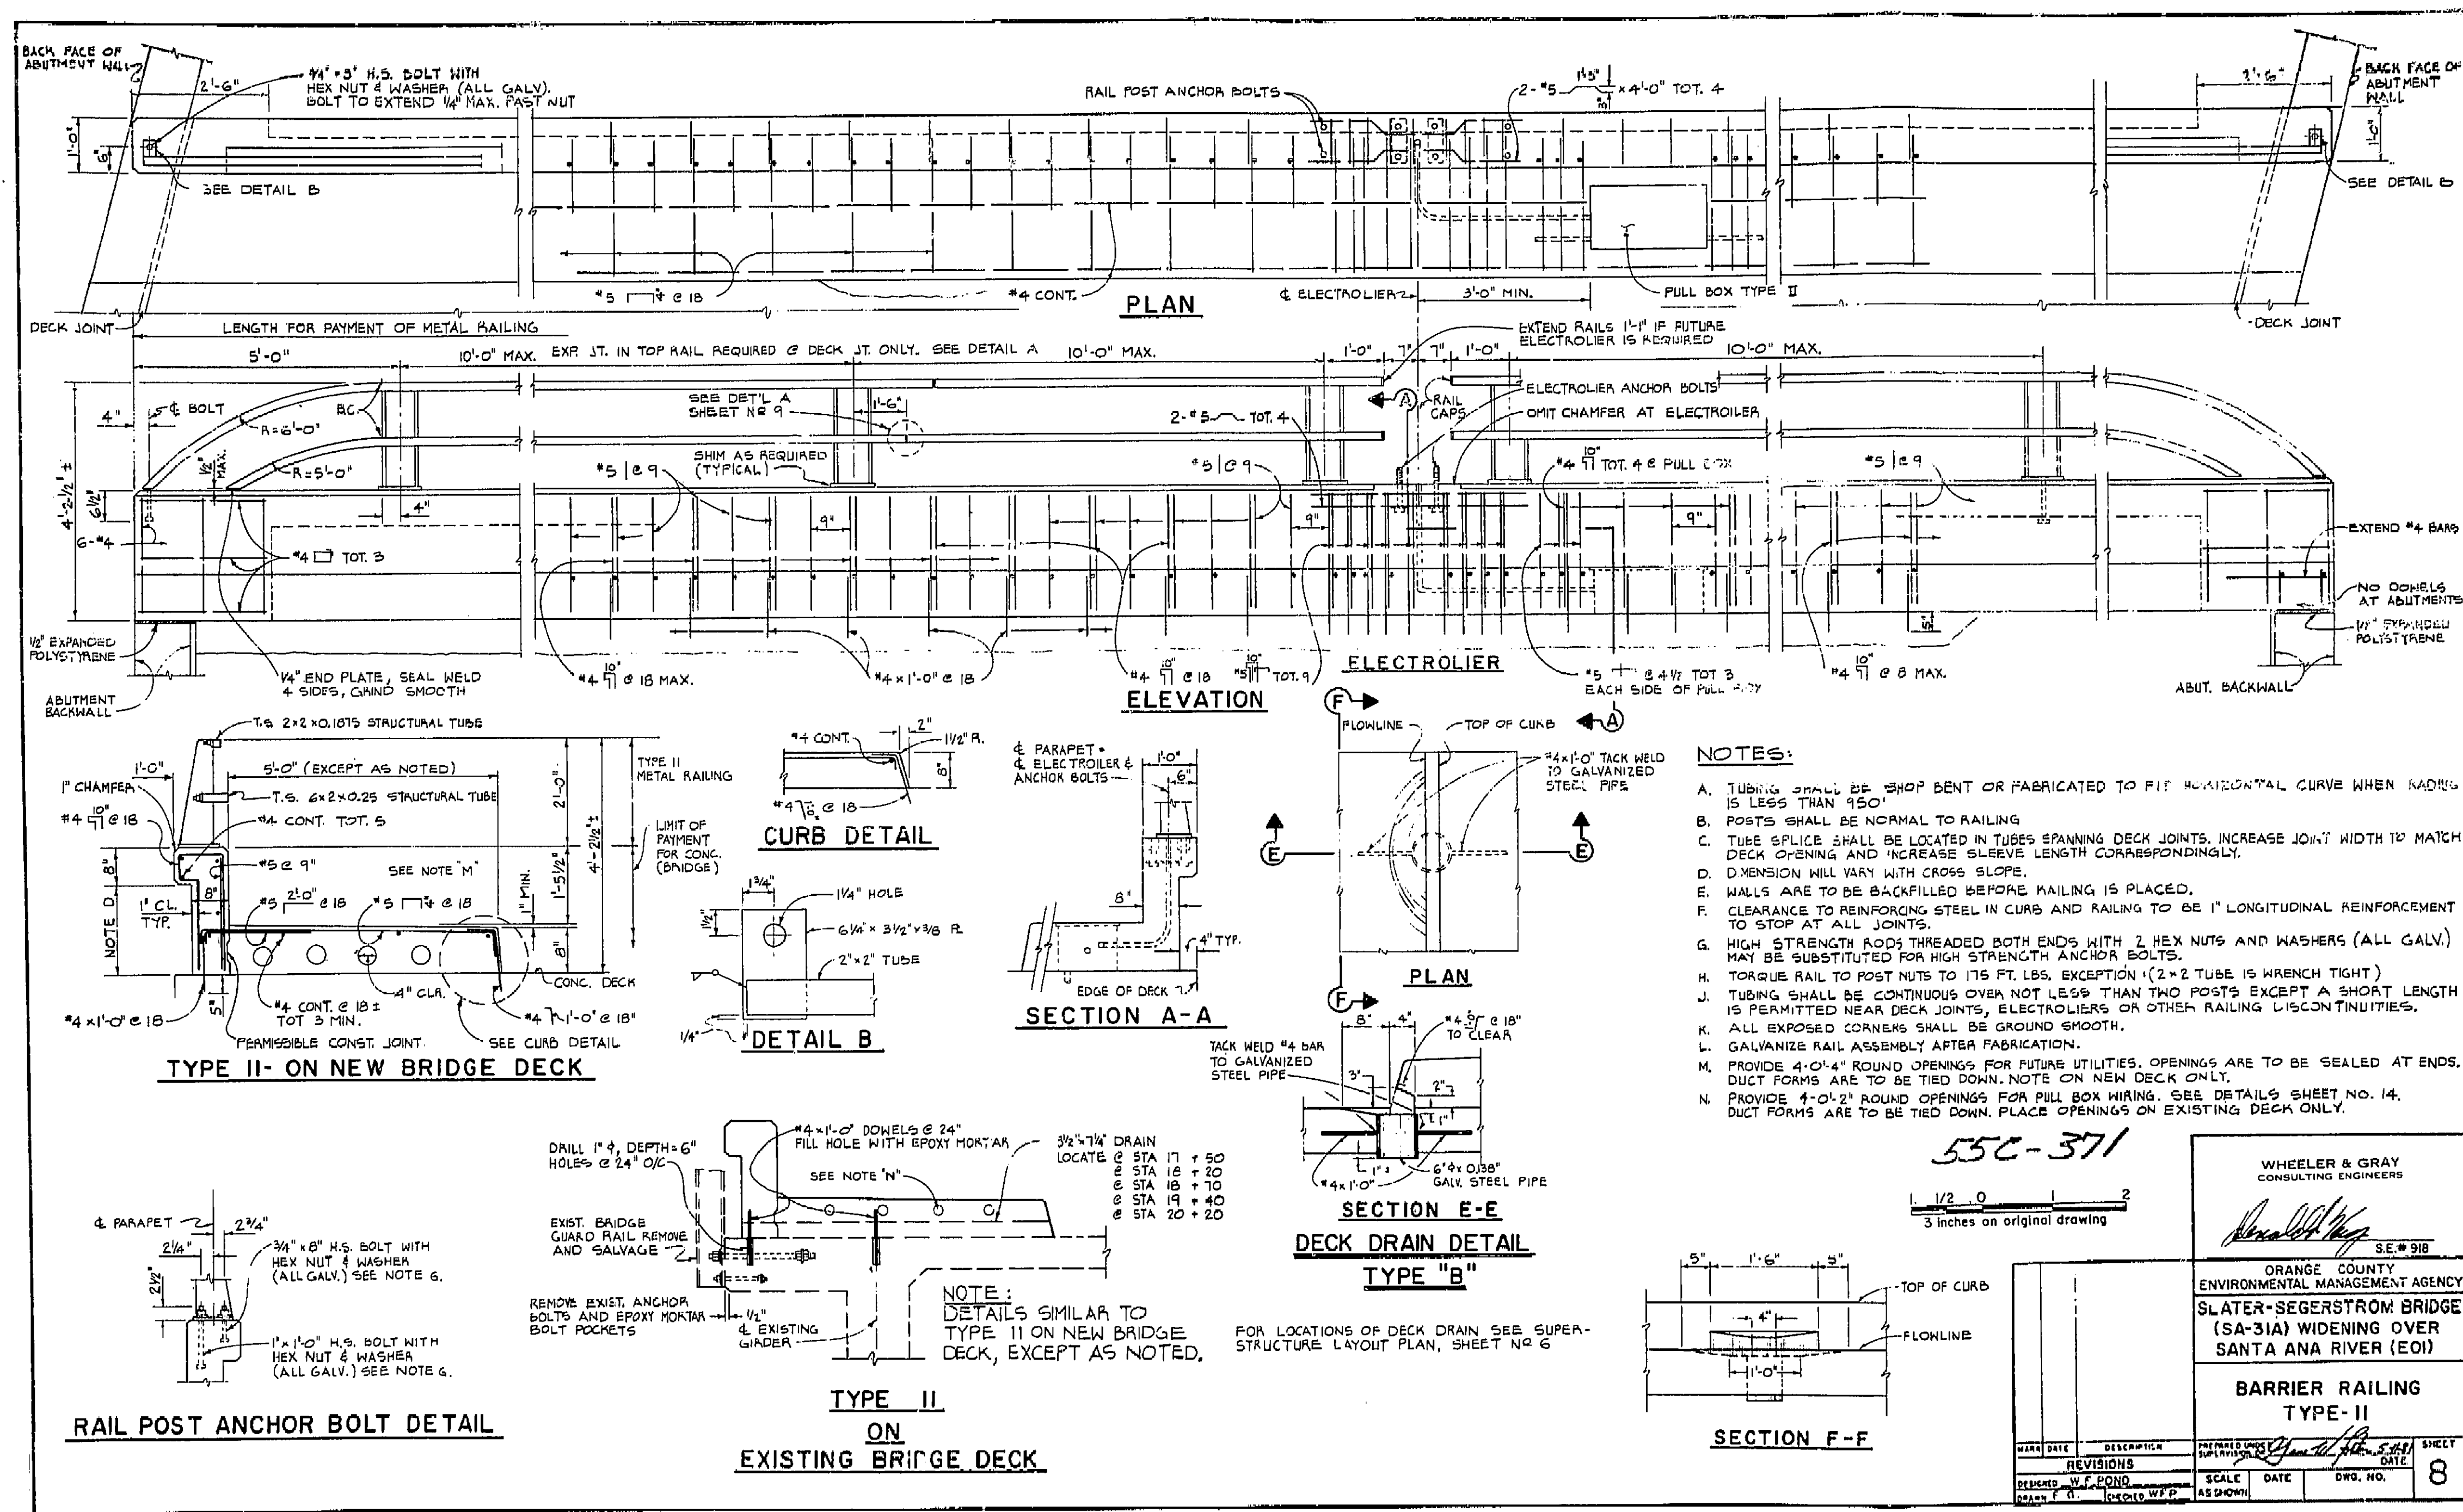


**AS BUILT PLANS**  
Contract No. UNKNOWN  
Date Completed             
Document No. 70008509

I HEREBY CERTIFY THAT THIS IS A TRUE AND ACCURATE COPY OF THE ABOVE DOCUMENT TAKEN UNDER MY DIRECTION AND CONTROL ON THIS DATE IN SACRAMENTO, CALIFORNIA PURSUANT TO AUTHORIZATION BY THE DIRECTOR OF TRANSPORTATION.

**DATE** 10-29-82 **SIGNATURE** Donald Blackford **TITLE** SUPERVISOR OF MICROFILM SERVICES




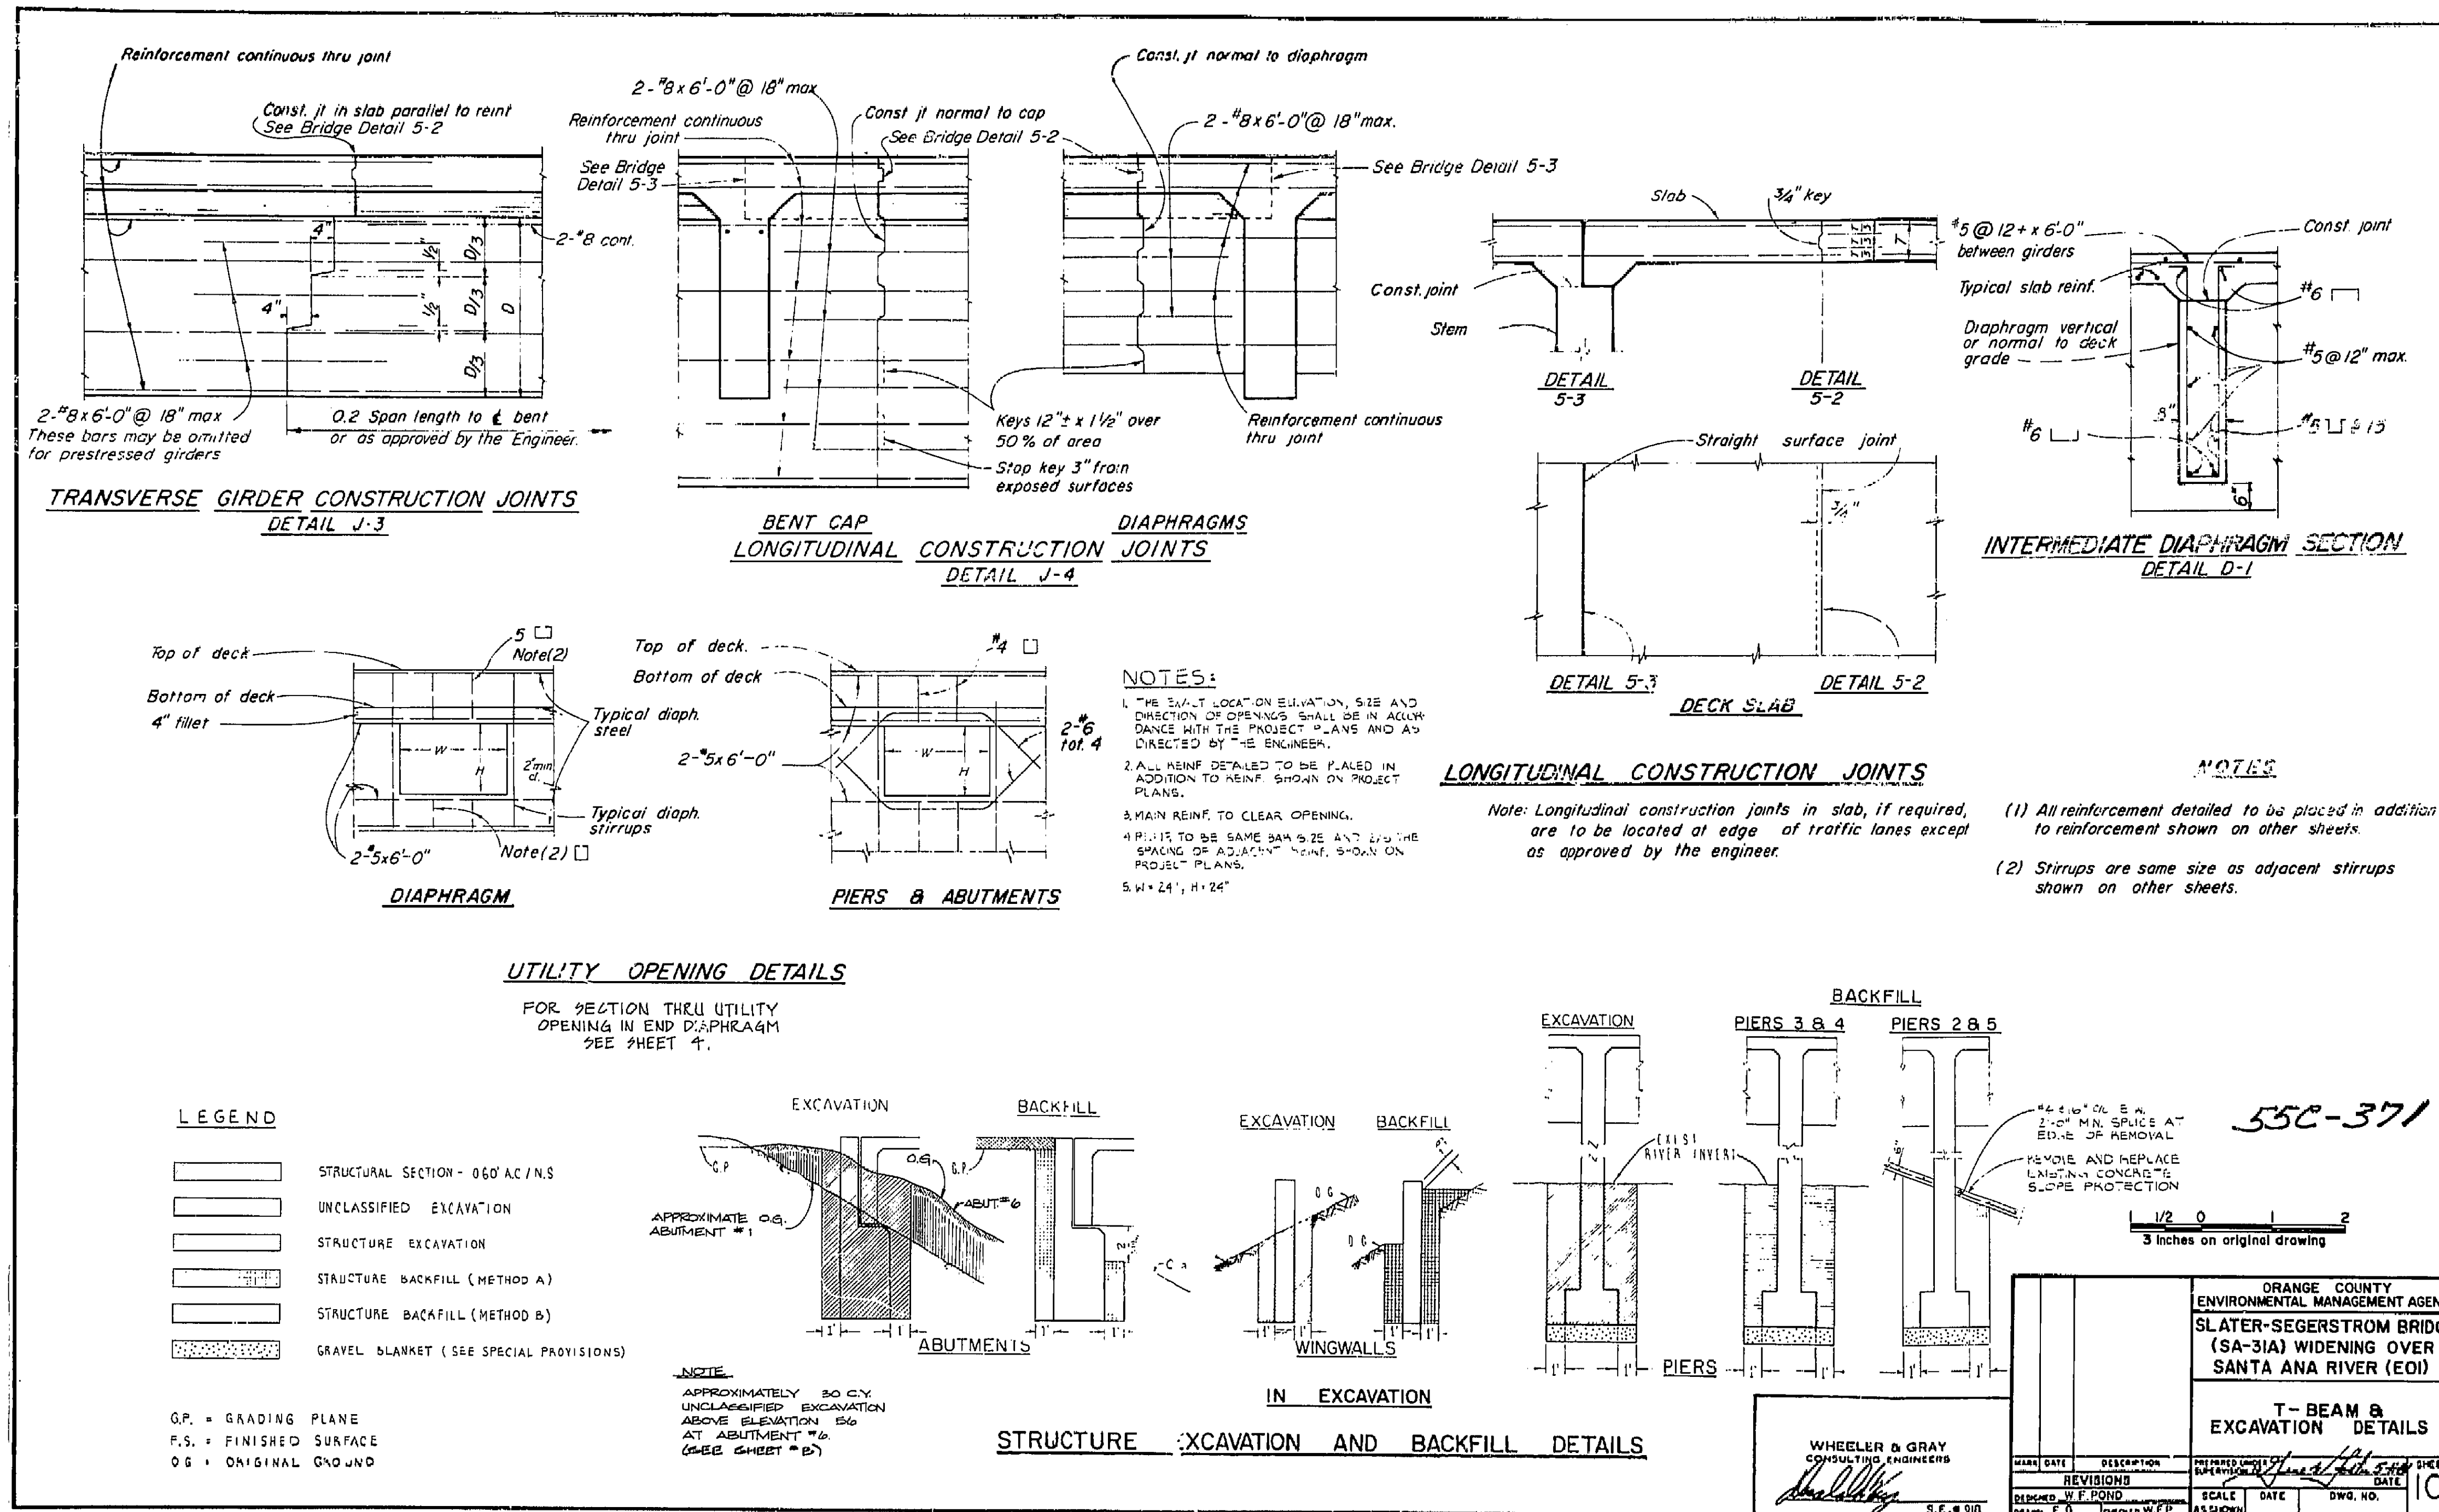

**AS BUILT PLANS**  
Contract No. UNKNOWN  
Date Completed             
Document No. 70008509

I HEREBY CERTIFY THAT THIS IS A TRUE AND ACCURATE COPY OF THE ABOVE DOCUMENT TAKEN UNDER MY DIRECTION AND CONTROL ON THIS DATE IN SACRAMENTO, CALIFORNIA PURSUANT TO AUTHORIZATION BY THE DIRECTOR OF TRANSPORTATION.


**DATE** 10-29-82 **SIGNATURE** Donald Blackford **TITLE** SUPERVISOR OF MICROFILM SERVICES

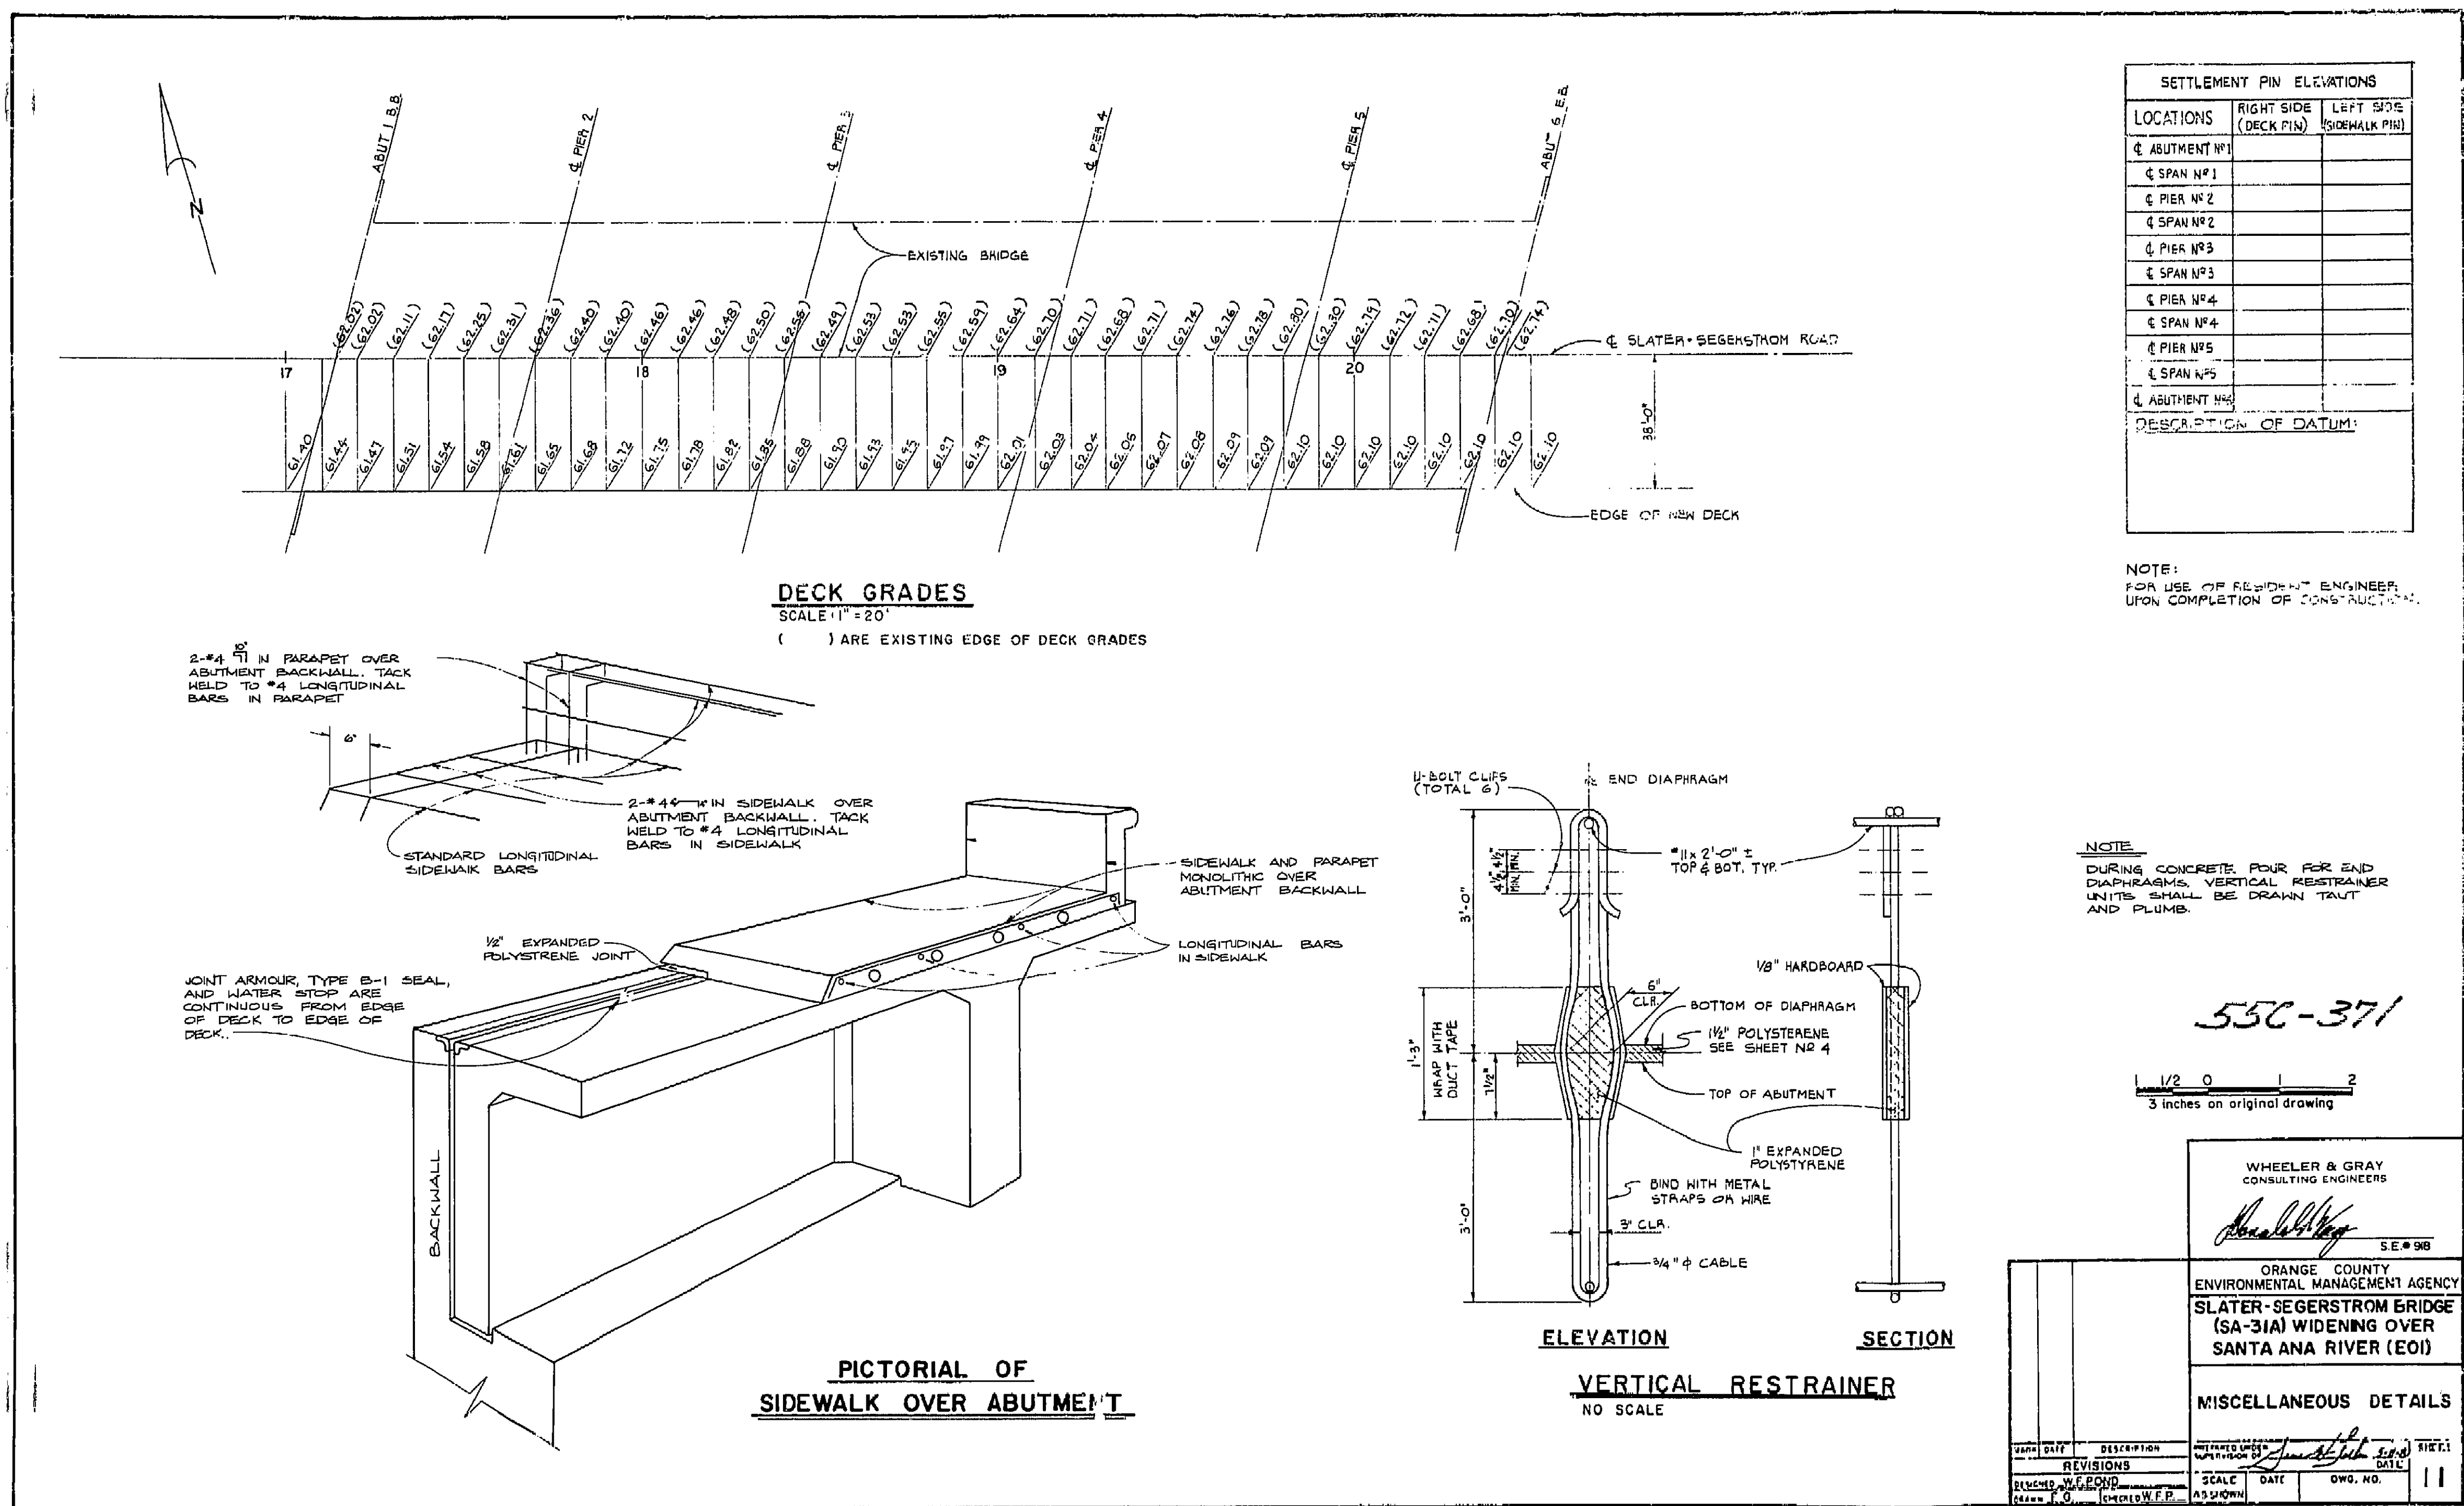

**AS BUILT PLANS**  
Contract No. UNKNOWN  
Date Completed             
Document No. 70008509

I HEREBY CERTIFY THAT THIS IS A TRUE AND ACCURATE COPY OF THE ABOVE DOCUMENT TAKE UNDER MY DIRECTION AND CONTROL ON THIS DATE IN SACRAMENTO, CALIFORNIA PURSUANT TO AUTHORIZATION BY THE DIRECTOR OF TRANSPORTATION.

**DATE:** 10-29-82  
**SIGNATURE:** Donald Blackford  
**TITLE:** SUPERVISOR OF MICROFILM SERVICES

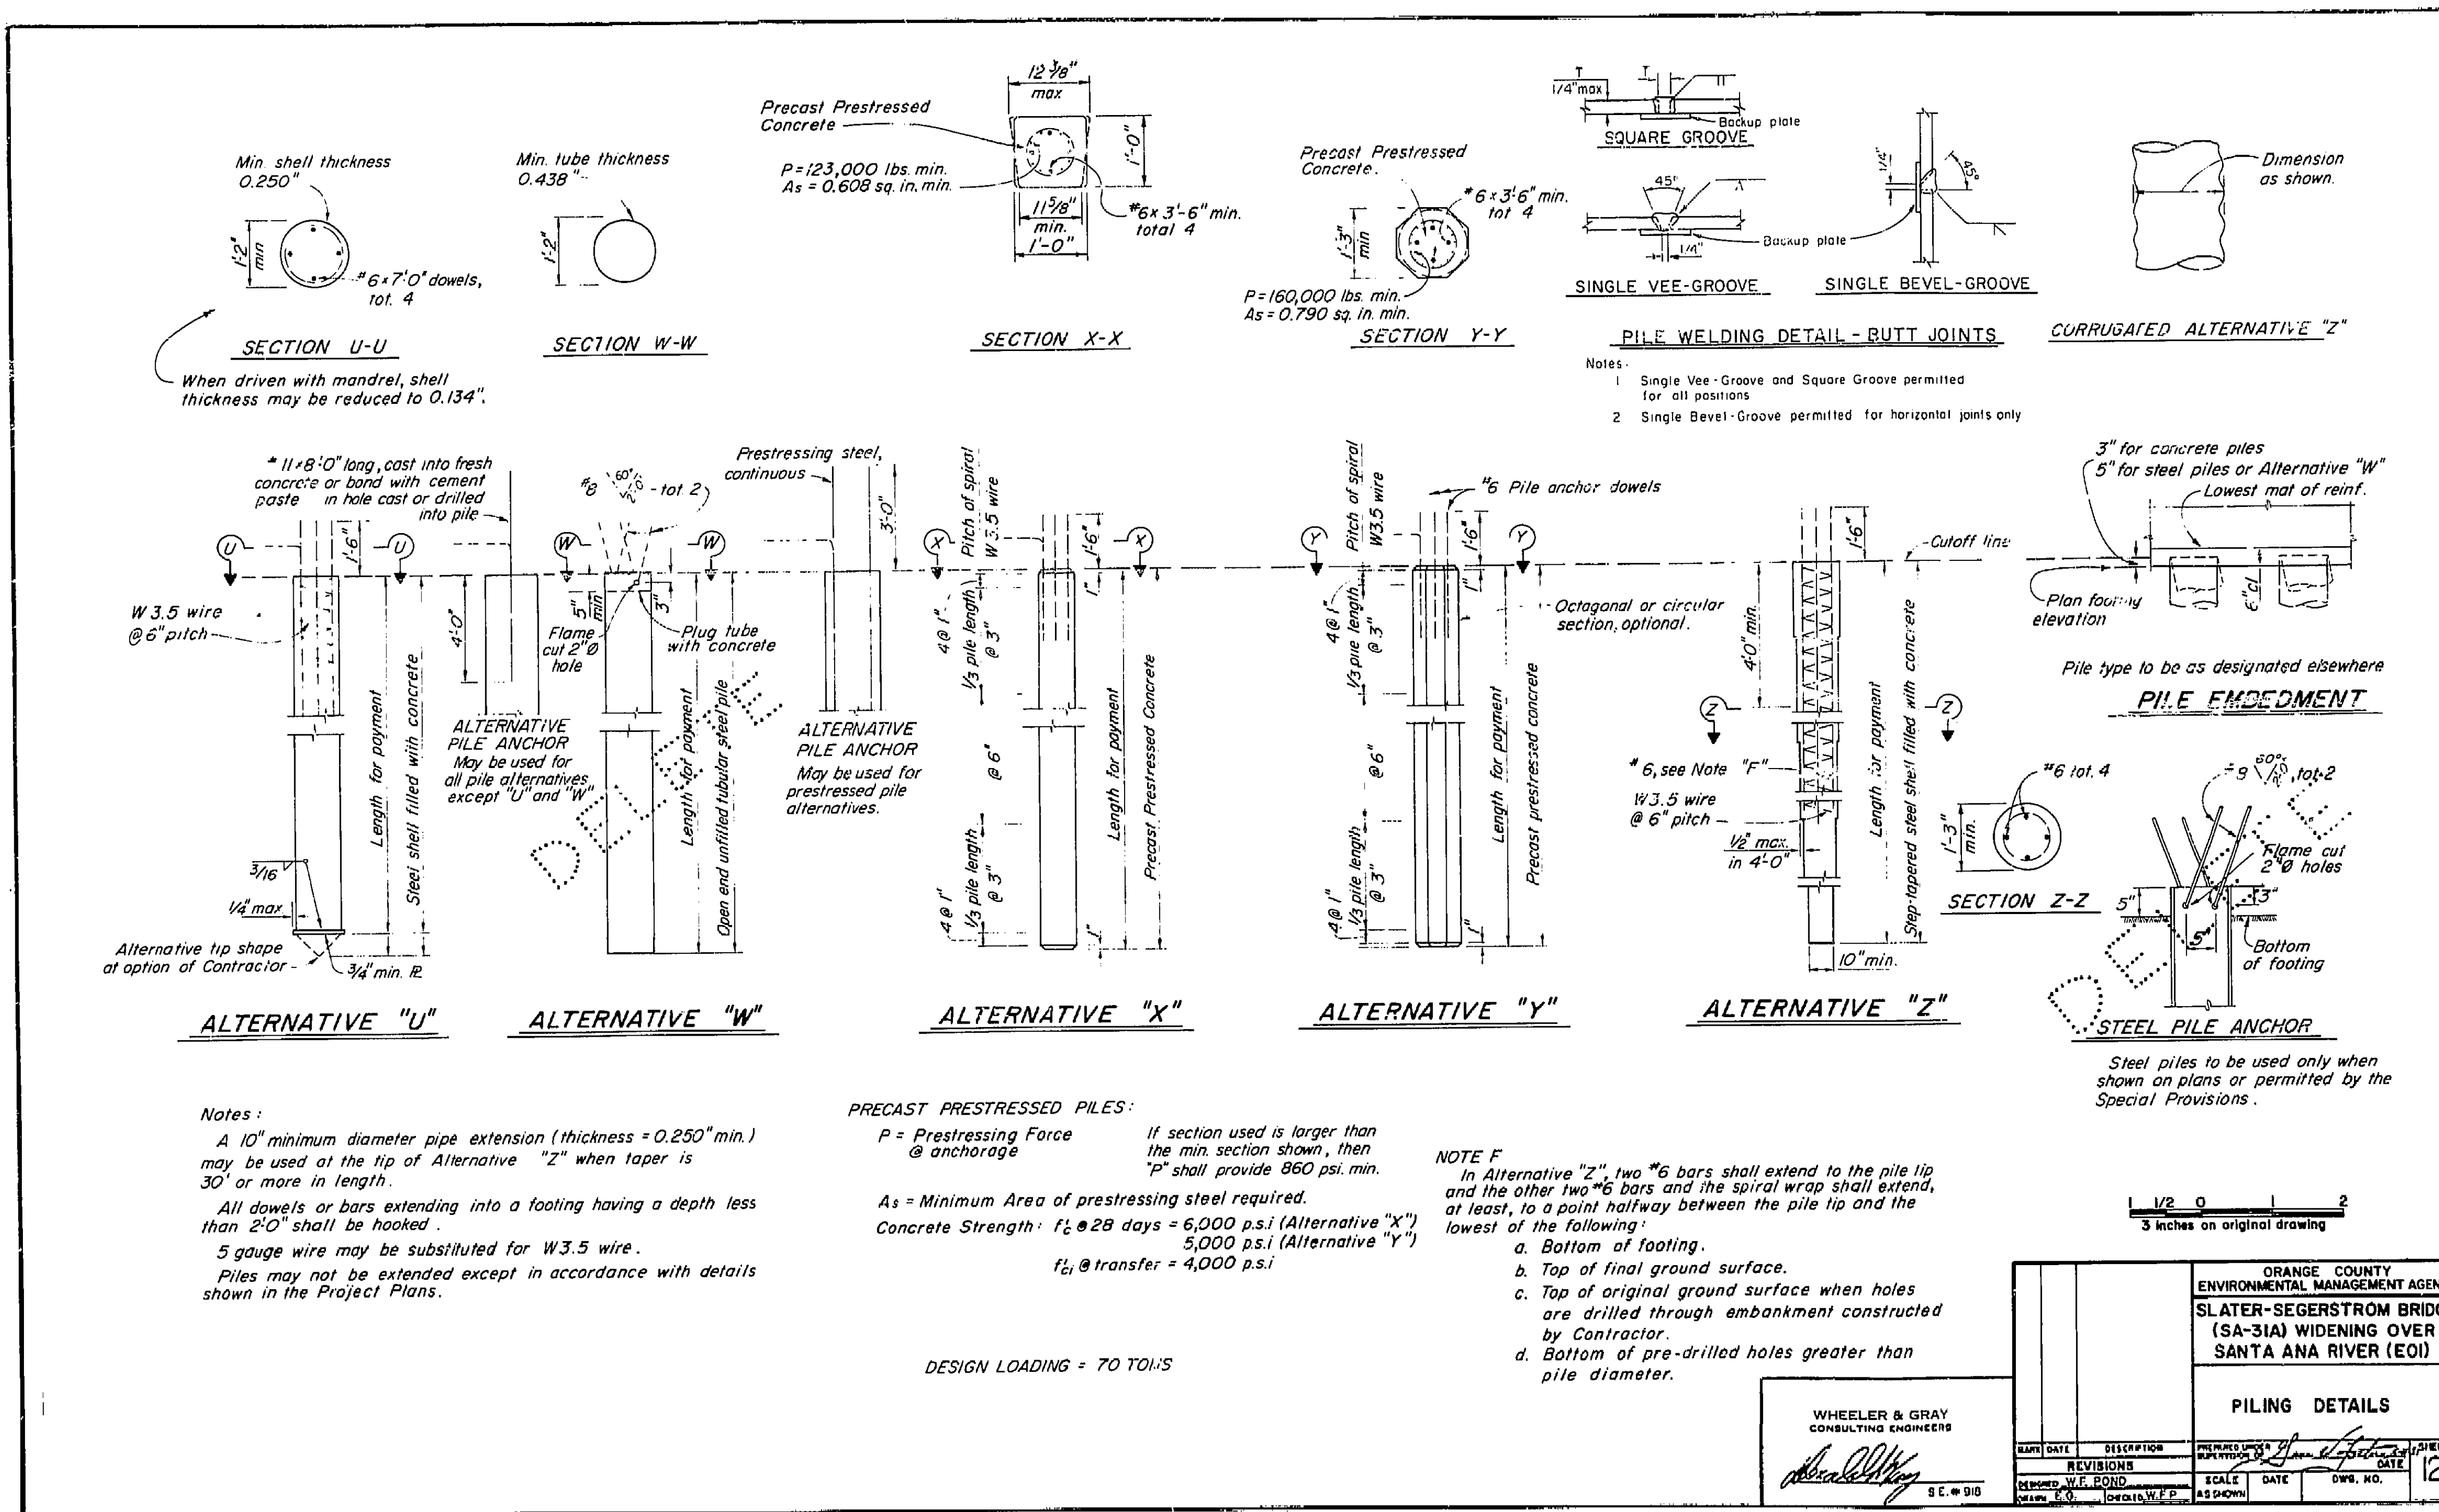


**AS BUILT PLANS**  
Contract No. UNKNOWN  
Date Completed             
Document No. 70008509


I HEREBY CERTIFY THAT THIS IS A TRUE AND ACCURATE COPY OF THE ABOVE DOCUMENT TAKEN UNDER MY DIRECTION AND CONTROL ON THIS DATE IN SACRAMENTO, CALIFORNIA PURSUANT TO AUTHORIZATION BY THE DIRECTOR OF TRANSPORTATION.

DATE 10-29-82 SIGNATURE Donald Blackford TITLE SUPERVISOR OF MICROFILM SERVICES



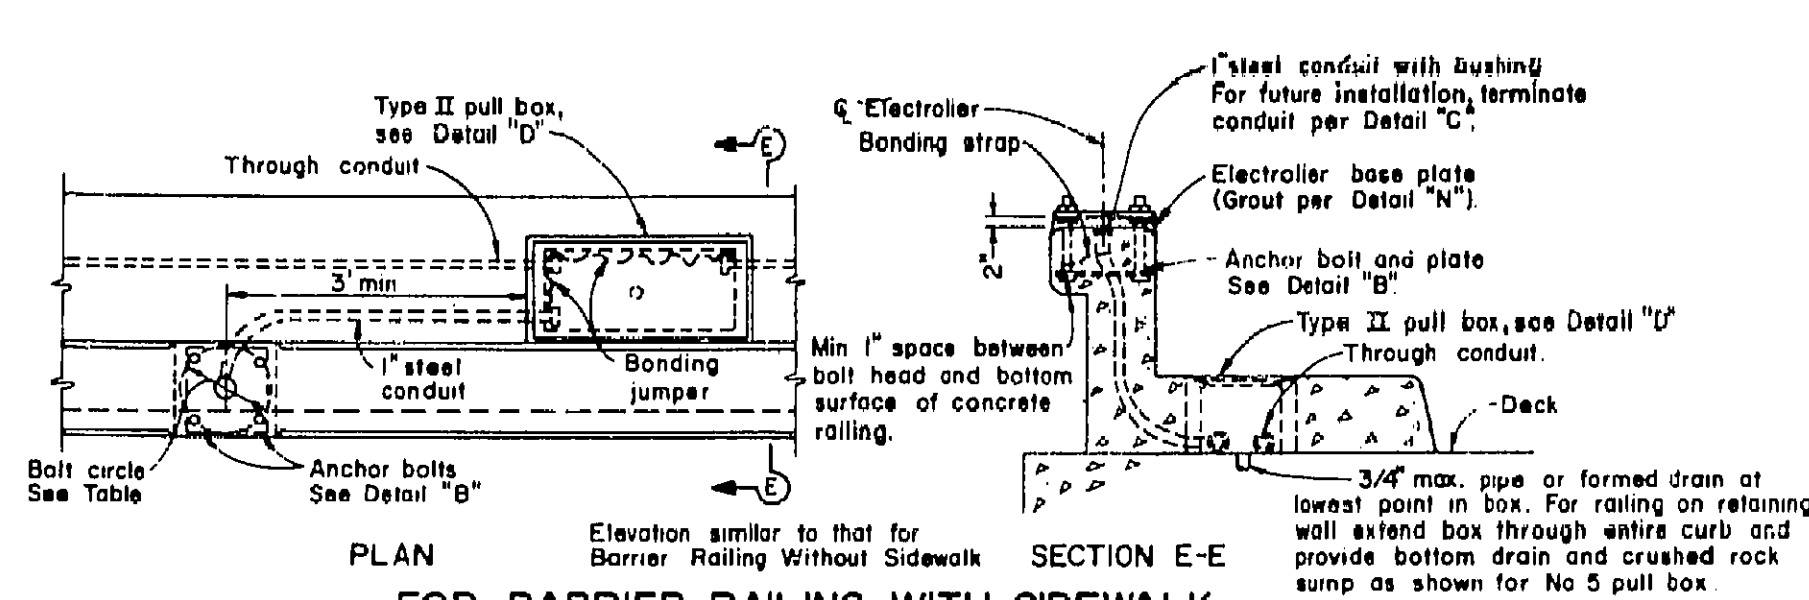

PLAN  
FOR BARRIER RAILING WITH SIDEWALK  
DETAIL "A" ELECTROLIER BASE AND PULL BOX INSTALLATION

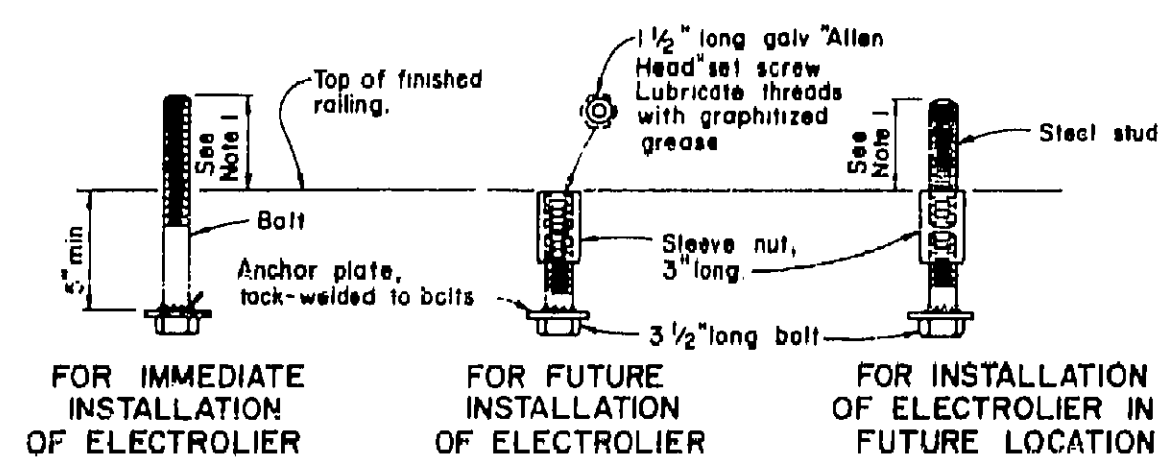


- NOTES:
1. Anchor bolt or stud length shall be such that thread extends 1/2" maximum above nut on level base plate after grouting. See Detail "N".
  2. Electrolier anchor bolts shall be held in position for pouring by means of suitable templates. Deviation from the true position, vertical and height, shall not exceed 1/16".

DETAIL "B"  
ELECTROLIER ANCHOR BOLTS


TABLE B

| TYPE | BOLT CIRCLE | ANCHOR BOLT DIAMETER |
|------|-------------|----------------------|
| XX   | 11"         | 1"                   |
| XXI  | 11 1/2"     | 1 1/8"               |


3/8" Steel plate. Drill 4 holes at specified bolt circle as shown in table B. Galvanizing of plate not required.

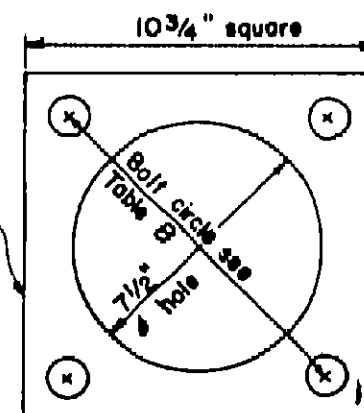


ANCHOR PLATE

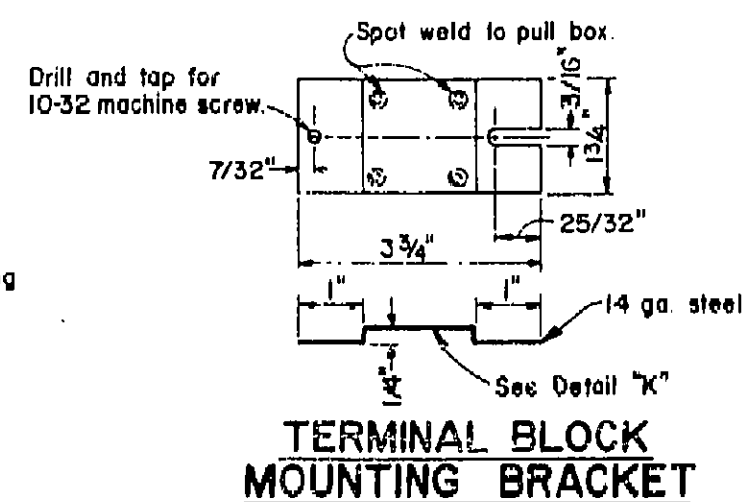


TERMINAL BLOCK  
MOUNTING BRACKET

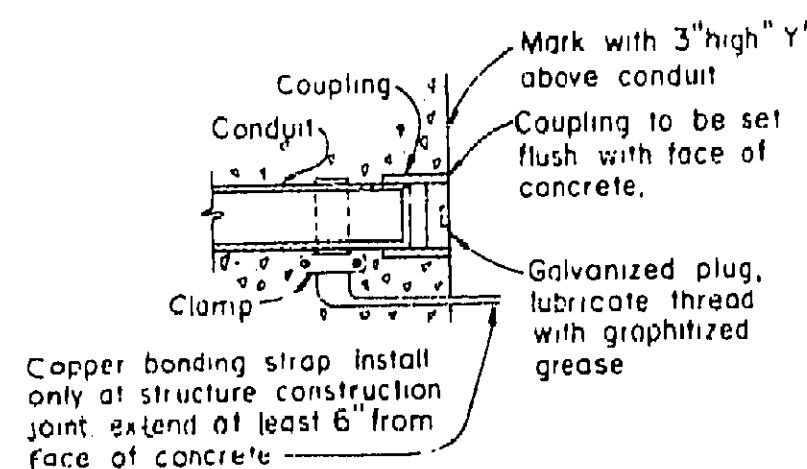

DETAIL "C"  
CONDUIT TERMINATION

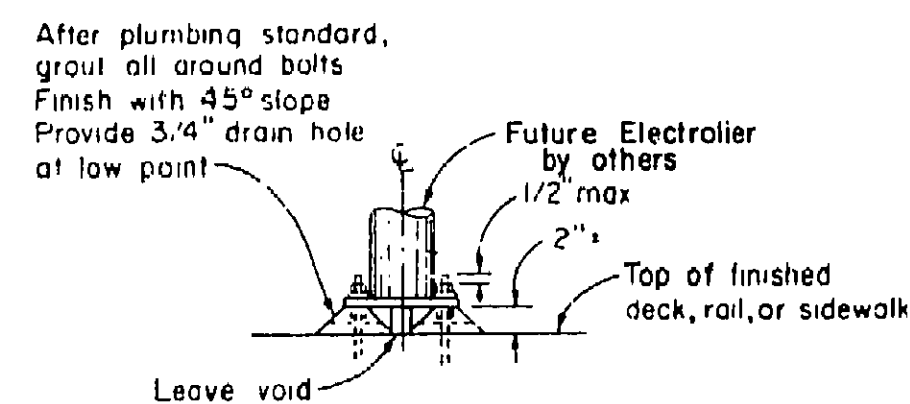


DETAIL "N"  
GROUTING AT ELECTROLIER

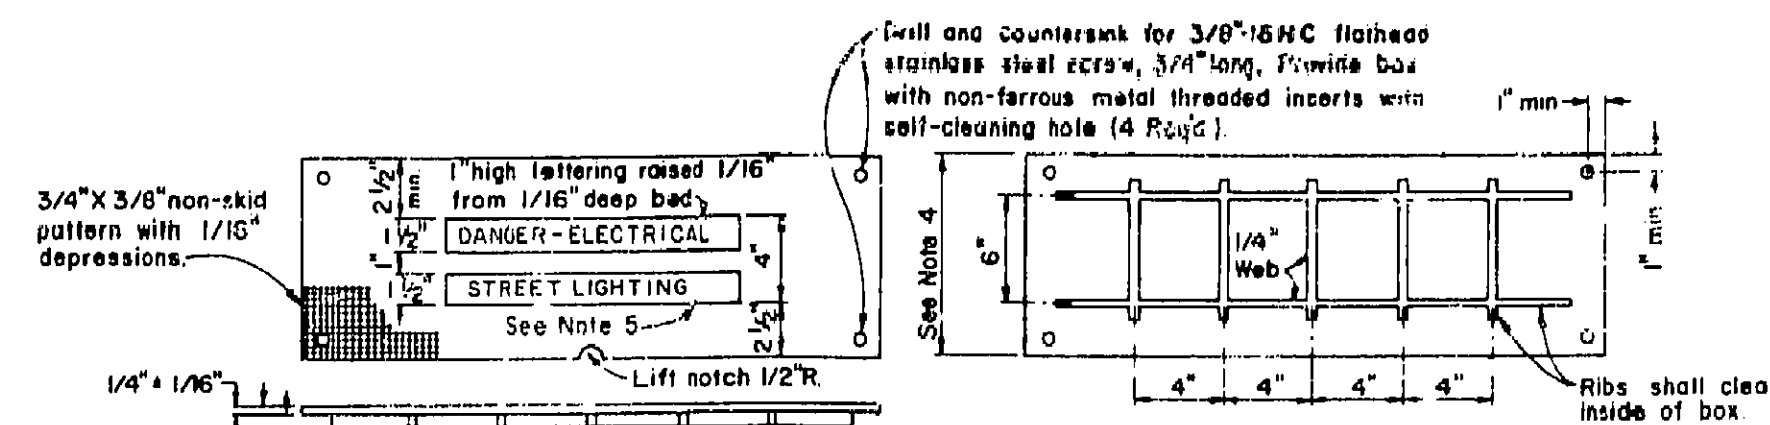


- NOTES:
1. Cover shall conform to the ASTM specification for gray iron castings, designation A-48, class 30, and shall be hot-dipped galvanized after fabrication.
  2. Completed cover shall be free from warp and shall fit into box facing either direction.
  3. Steel reinforcing may be used in standard products of respective manufacturer.
  4. Dimensions of cover shall provide 1/2" min overlap all around top inside edge of box.
  5. Circuit designation as shown on ES-3A.

CAST GRAY IRON COVER DETAIL

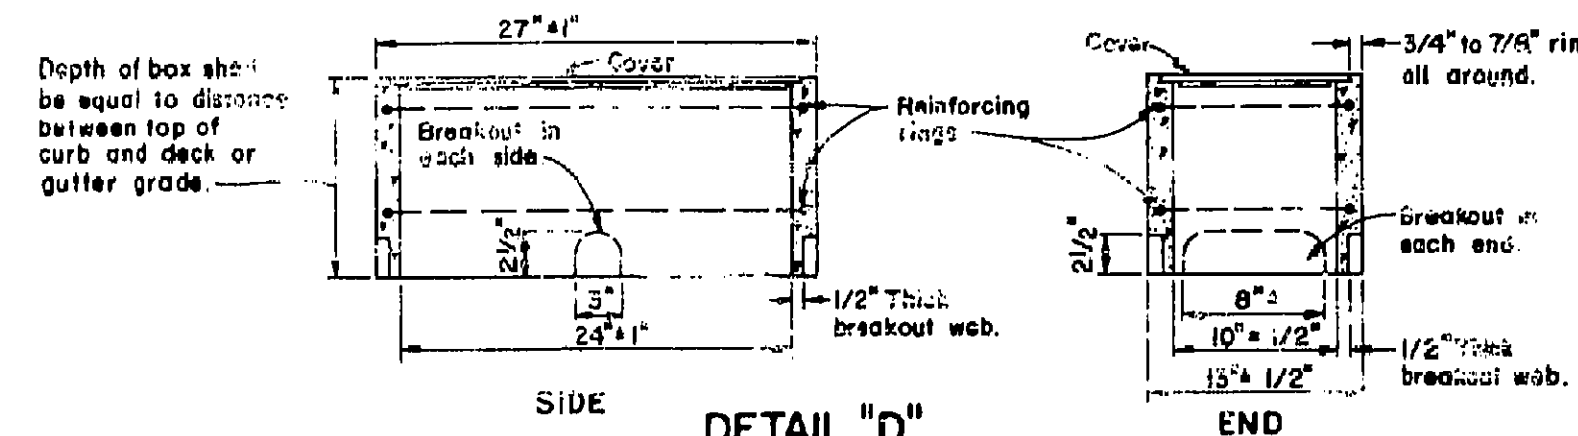

DETAIL "D"  
STRUCTURE PULL BOX (TYPE II)

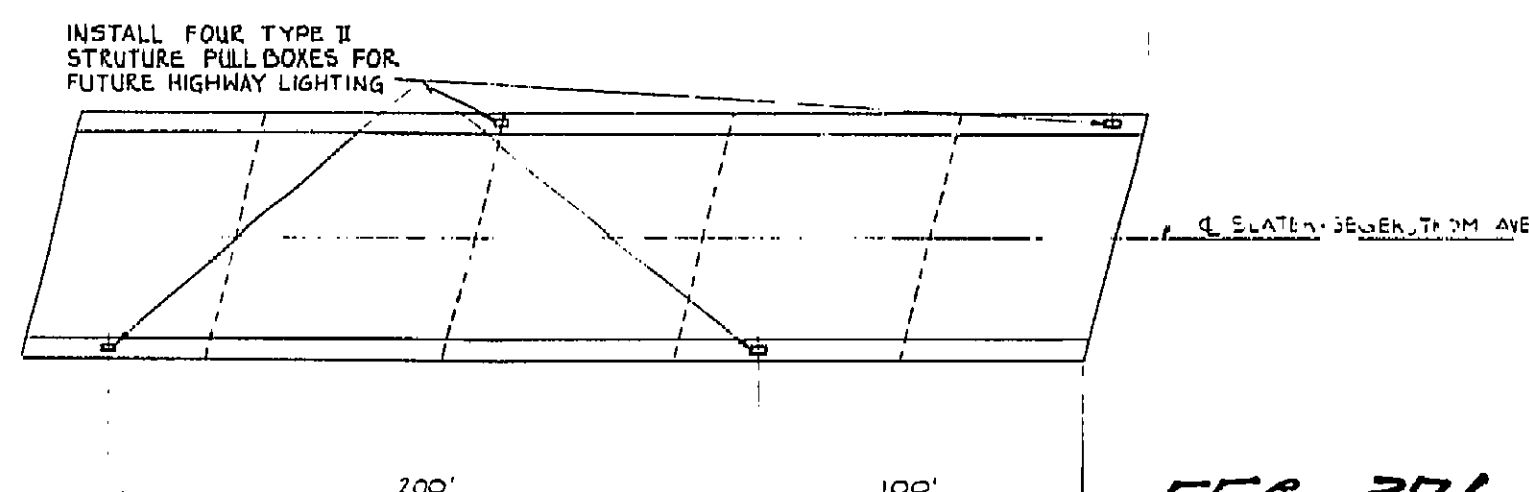


ELECTROLIER PLAN  
SCALE 1"=40'

|                                                    |             |                                                                                                                                 |         |
|----------------------------------------------------|-------------|---------------------------------------------------------------------------------------------------------------------------------|---------|
| WHEELER & GRAY<br>CONSULTING ENGINEERS<br>S.E.#910 |             | ORANGE COUNTY<br>ENVIRONMENTAL MANAGEMENT AGENCY<br>SLATER-SEGERSTROM BRIDGE<br>(SA-31A) WIDENING OVER<br>SANTA ANA RIVER (EOI) |         |
| DATE                                               | DESCRIPTION | PREPARED UNDER                                                                                                                  | SHEET   |
| 10-29-82                                           | REVISIONS   | SUPERVISOR                                                                                                                      | 14      |
| DESIGNED                                           | W.F. HOND   | SCALE                                                                                                                           | DATE    |
| DRAWN                                              | E.G.        | CHECKED                                                                                                                         | W.F. H. |

AS BUILT PLANS  
Contract No. UNKNOWN  
Date Completed 70008509  
Document No. 70008509

I HEREBY CERTIFY THAT THIS IS A TRUE AND ACCURATE COPY OF THE ABOVE DOCUMENT TAKEN UNDER MY DIRECTION AND CONTROL ON THIS DATE IN SACRAMENTO, CALIFORNIA PURSUANT TO AUTHORIZATION BY THE DIRECTOR OF TRANSPORTATION.

DATE 10-29-82 SIGNATURE Ronald Blackford TITLE SUPERVISOR OF MICROFILM SERVICES

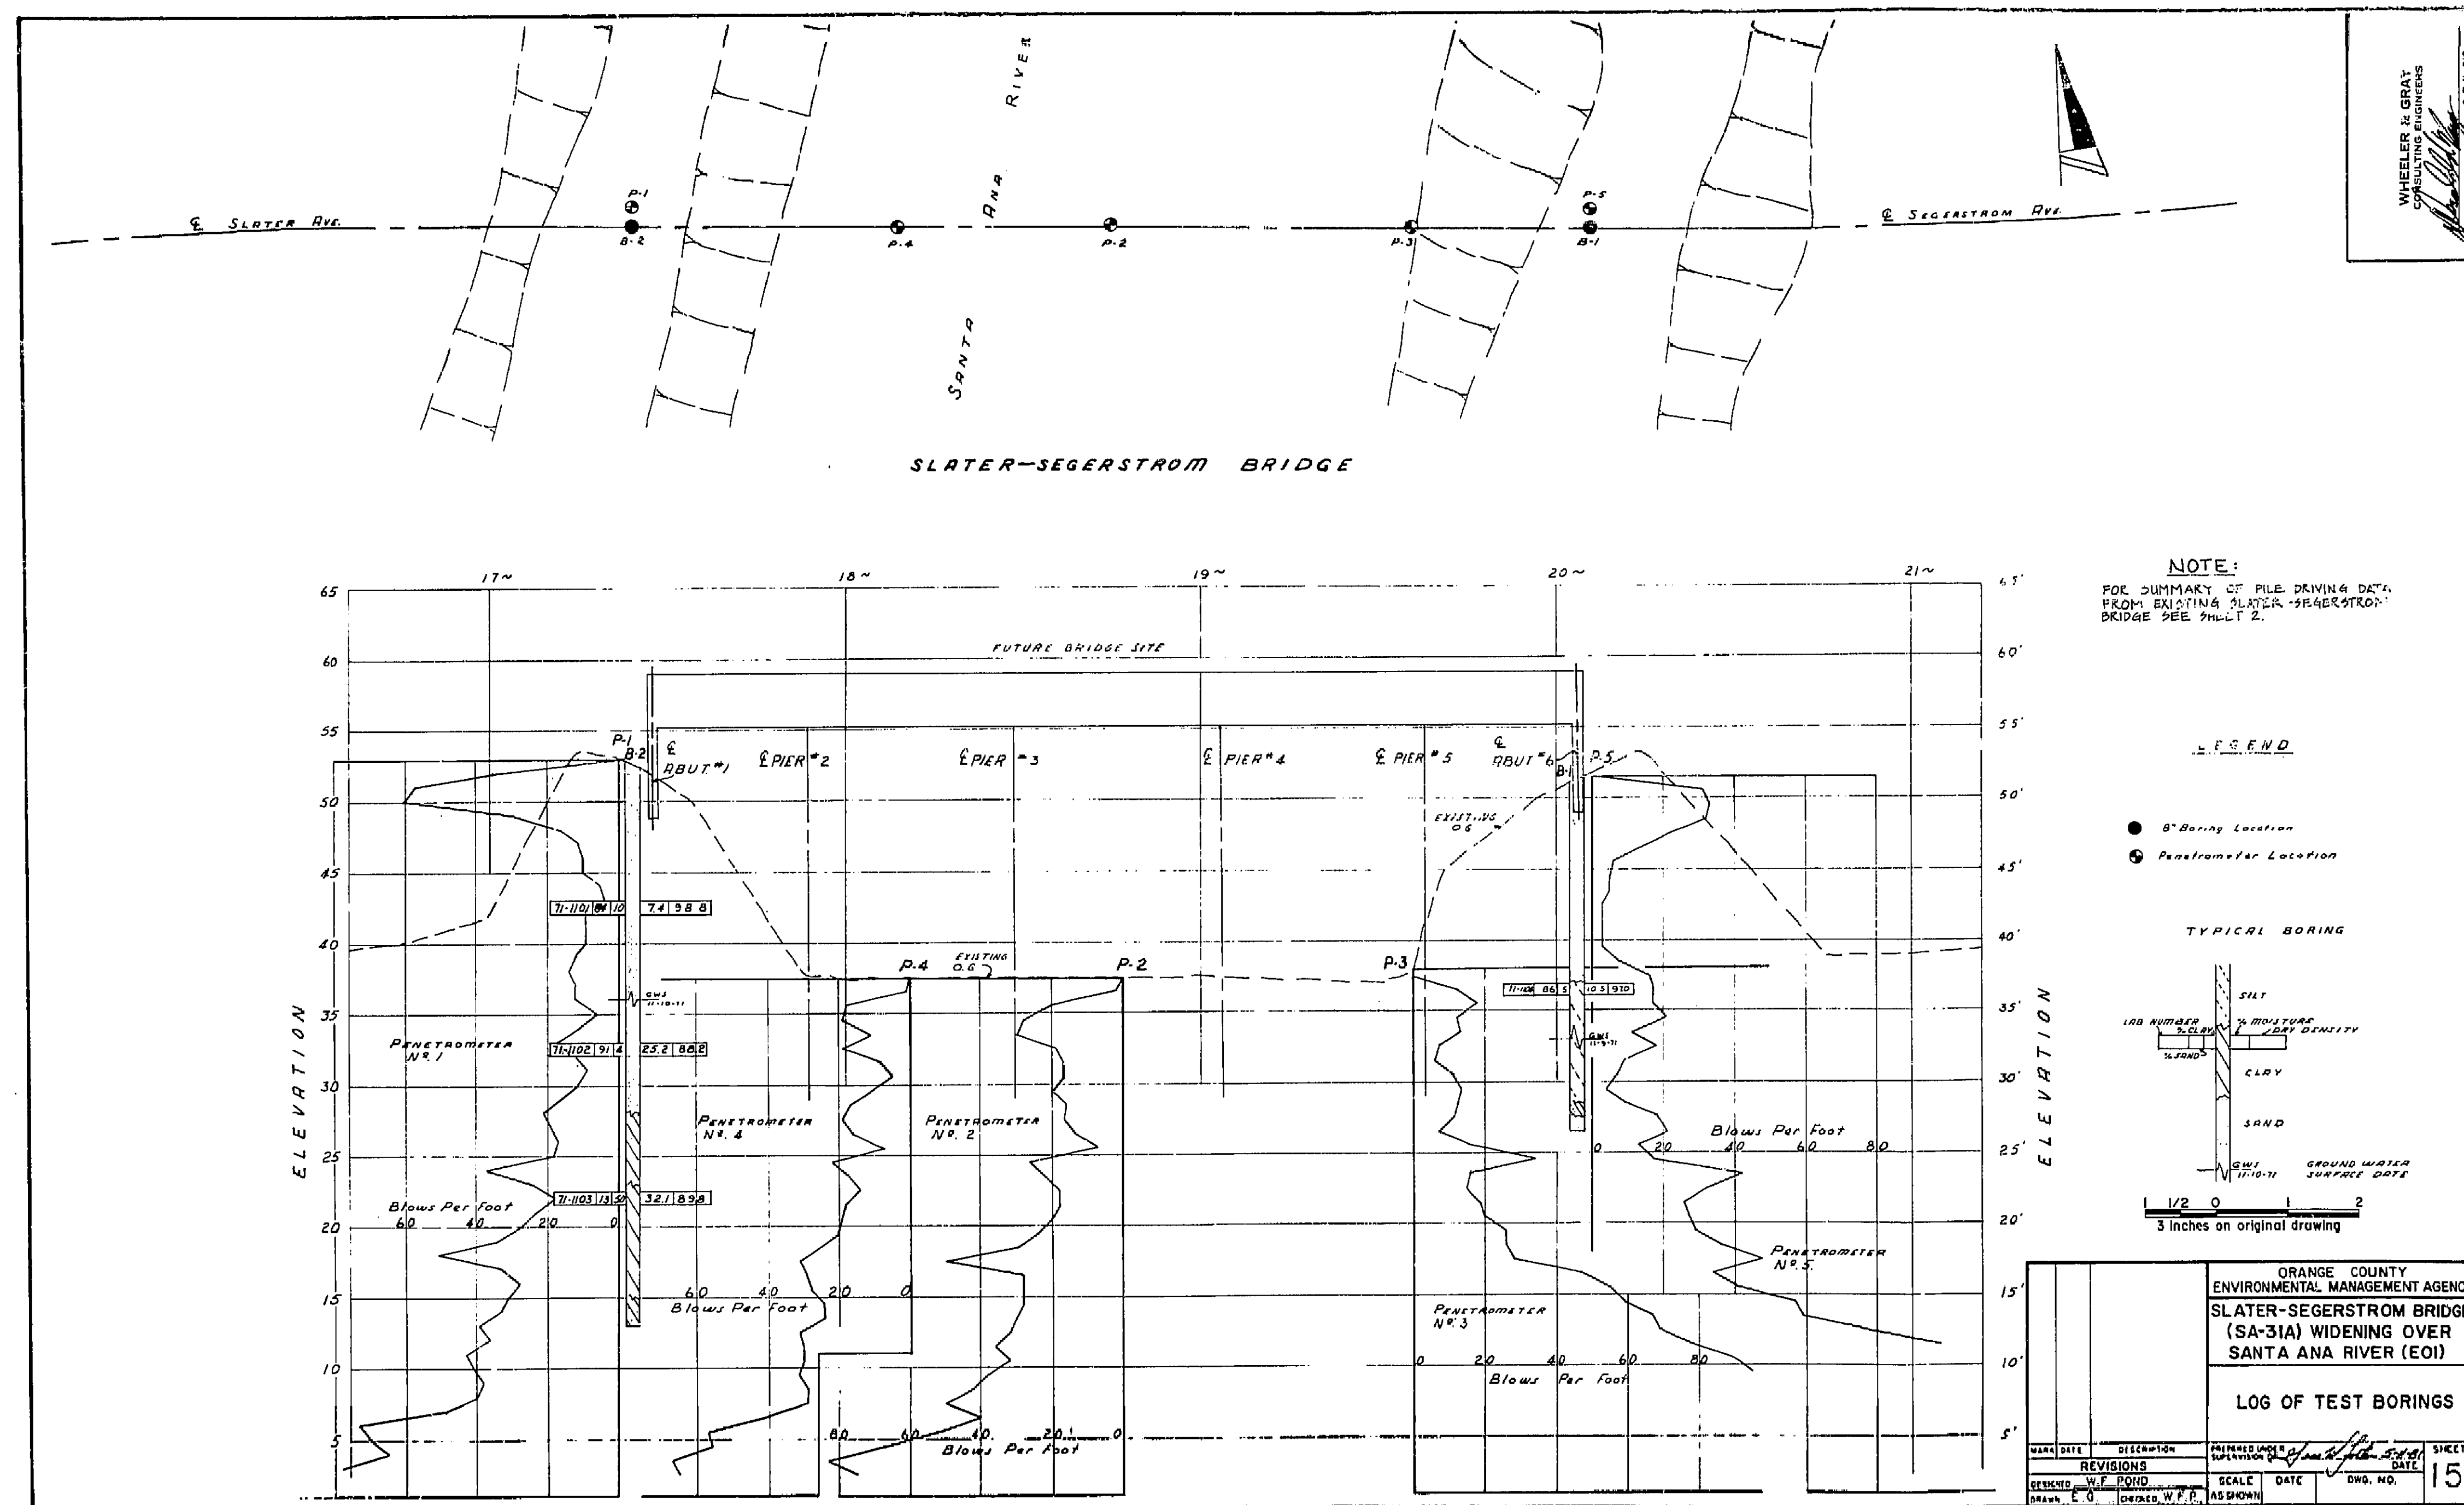


**AS BUILT PLANS**  
 Contract No. **UNKNOWN**  
 Date Completed  
 Document No. **70008509**


I HEREBY CERTIFY THAT THIS IS A TRUE AND ACCURATE COPY OF THE ABOVE DOCUMENT TAKEN UNDER MY DIRECTION AND CONTROL ON THIS DATE IN SACRAMENTO, CALIFORNIA PURSUANT TO AUTHORIZATION BY THE DIRECTOR OF TRANSPORTATION.

DATE **10-29-82** SIGNATURE **Donald Blackford** TITLE **SUPERVISOR OF MICROFILM SERVICES**


OAS-55-70

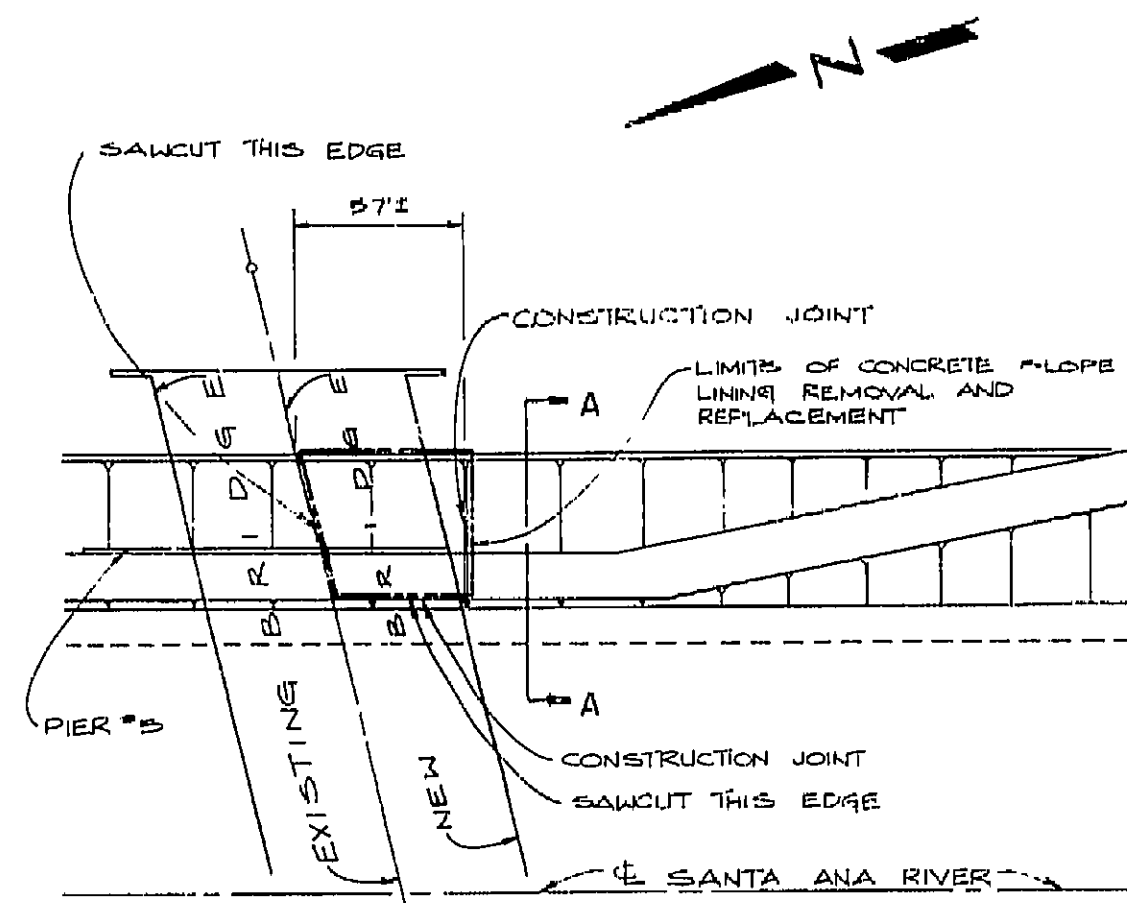


PLAN  
FOR REMOVAL & REPLACEMENT OF  
EAST LEVEE SLOPE LINING  
NO SCALE

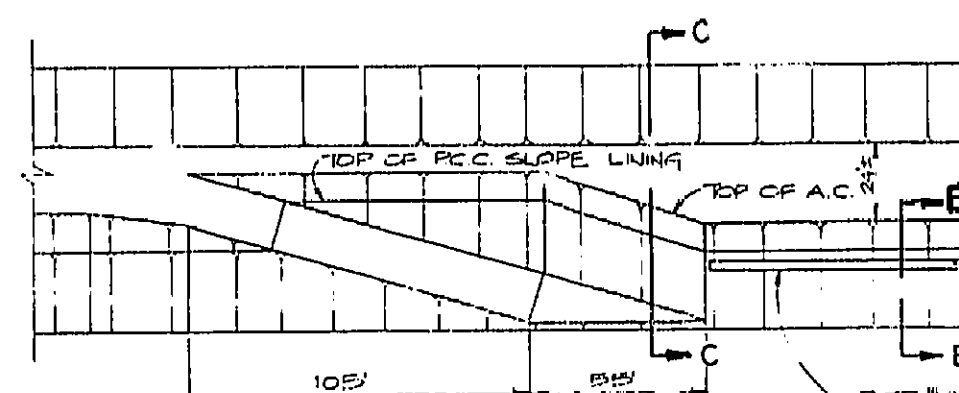


PLAN  
FOR REMOVAL & REPLACEMENT OF  
WEST LEVEE SLOPE LINING  
NO SCALE

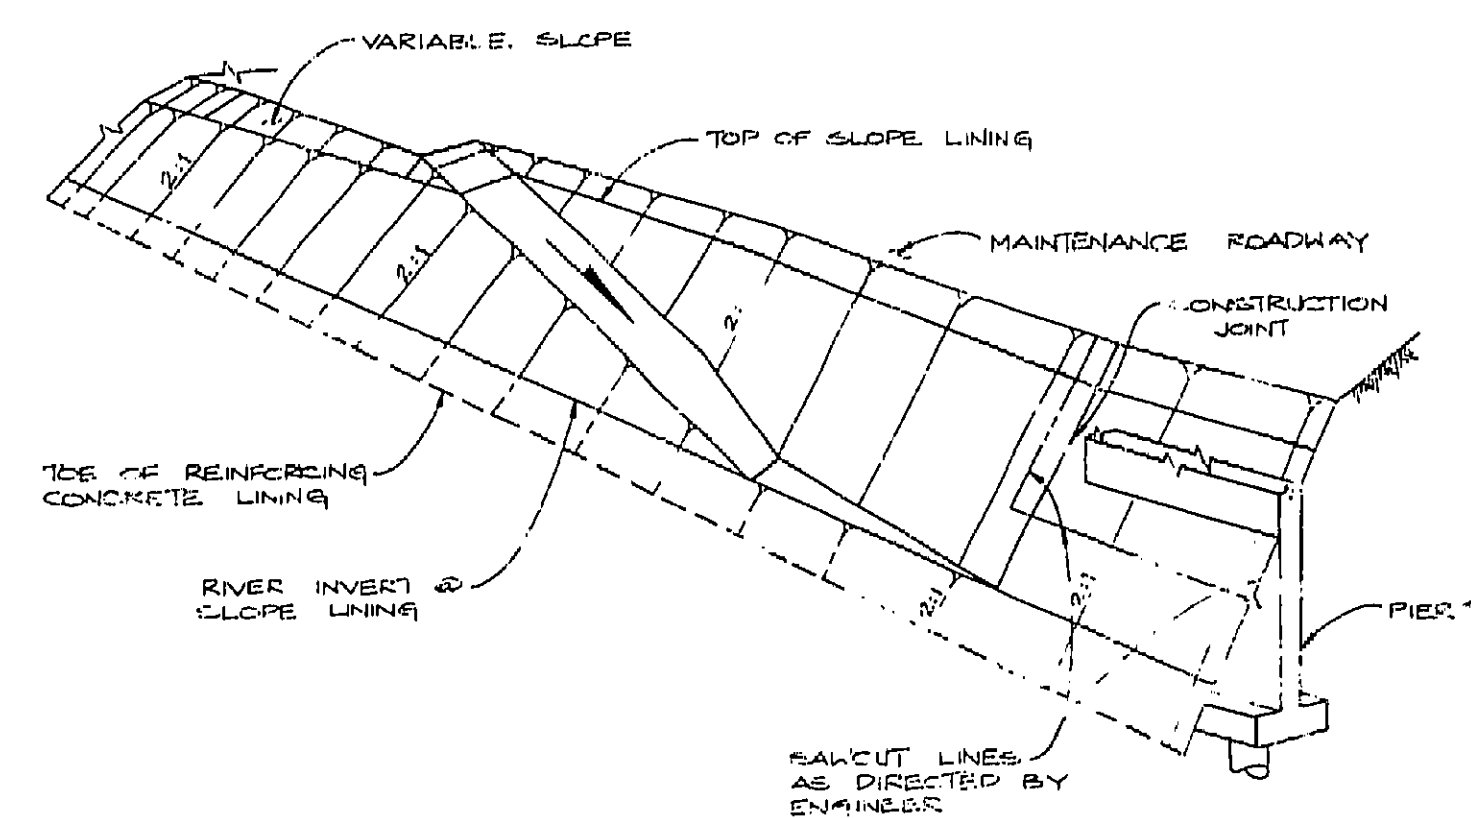


PICTORIAL OF WEST LEVEE  
CONCRETE SLOPE REMOVAL LIMITS  
NO SCALE

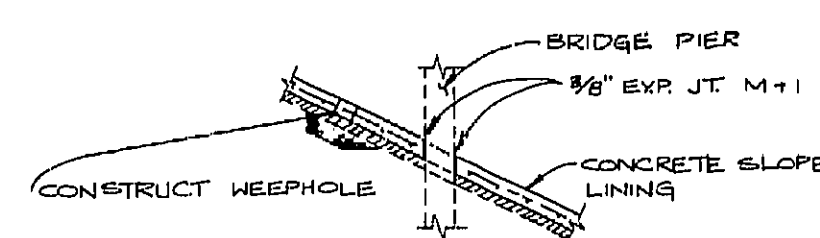


TYPICAL SECTION  
BRIDGE PIER DETAIL  
NO SCALE

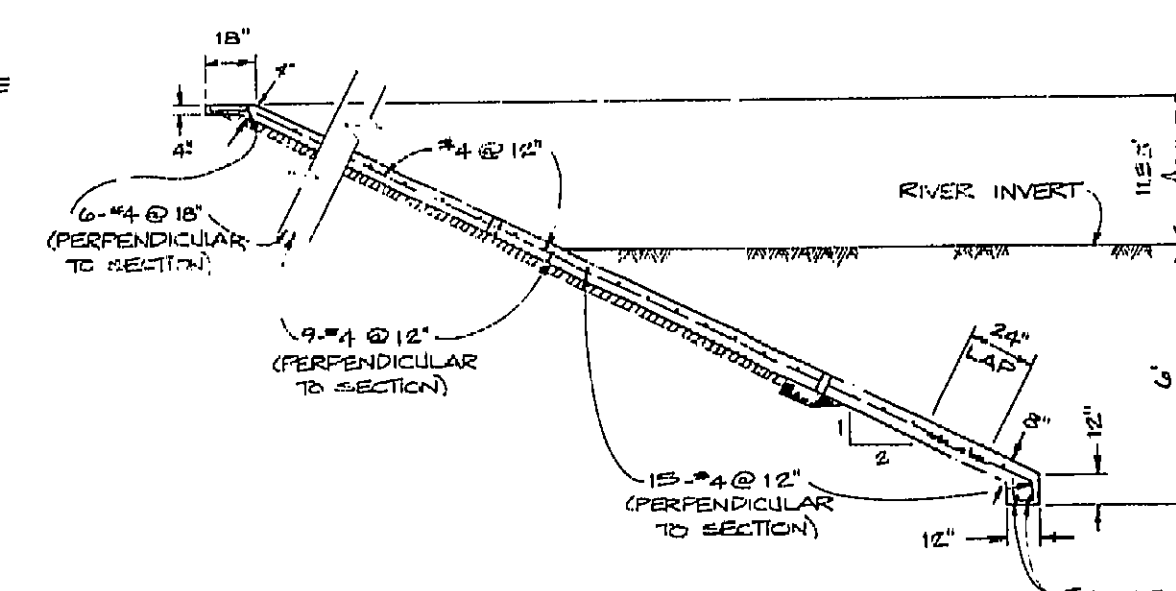


SECTION B-B  
SCALE: 1/4\"/>

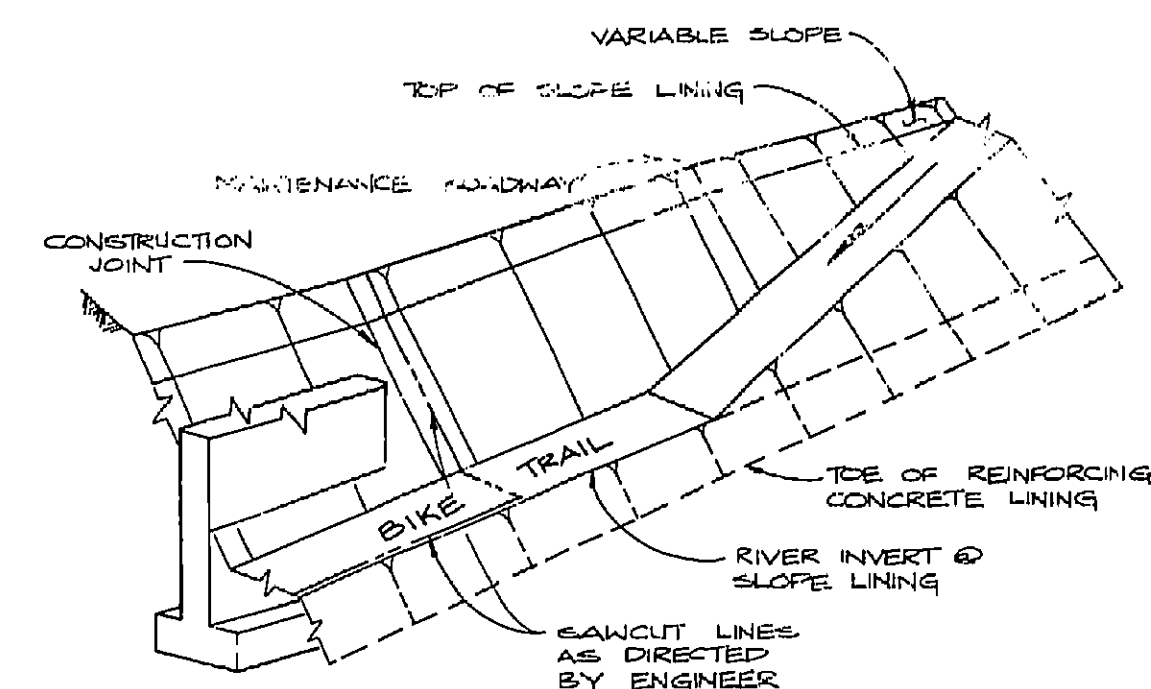

PICTORIAL OF EAST LEVEE  
CONCRETE SLOPE REMOVAL LIMITS  
NO SCALE

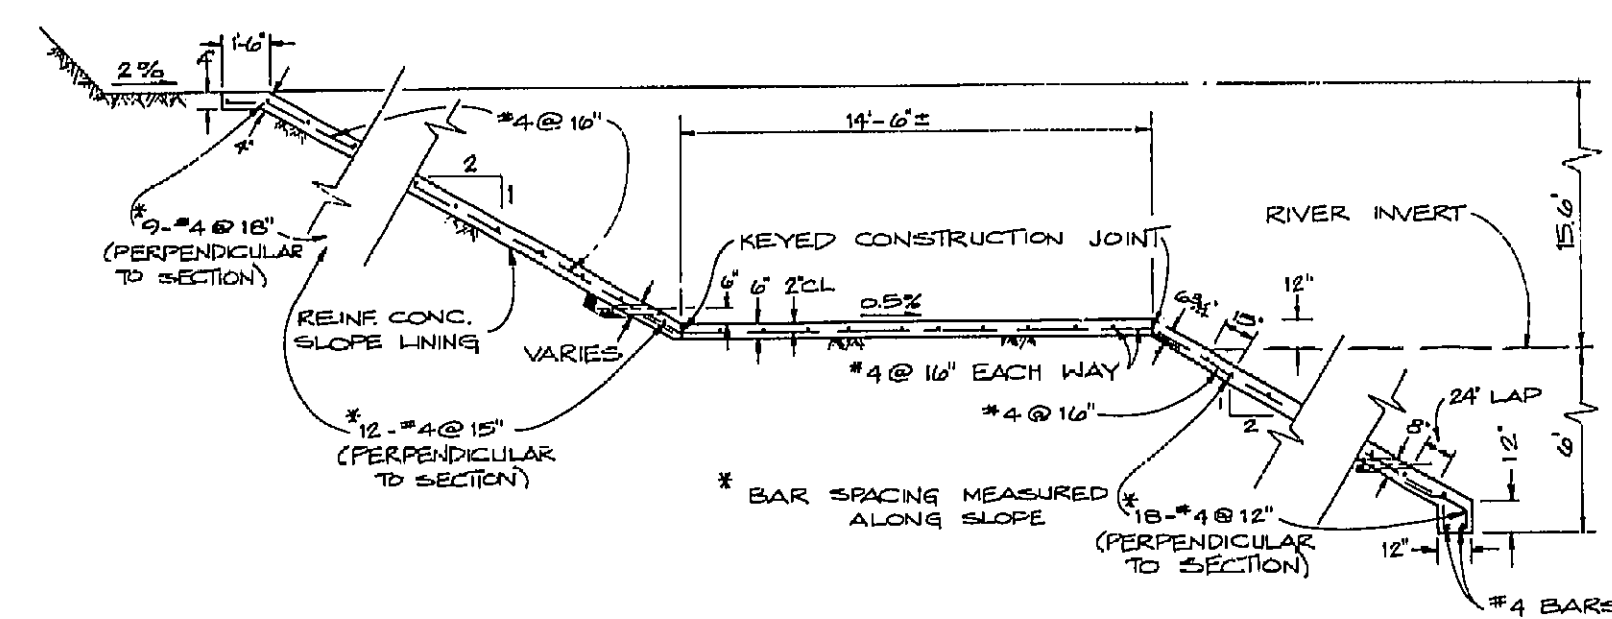

SECTION A-A  
NO SCALE

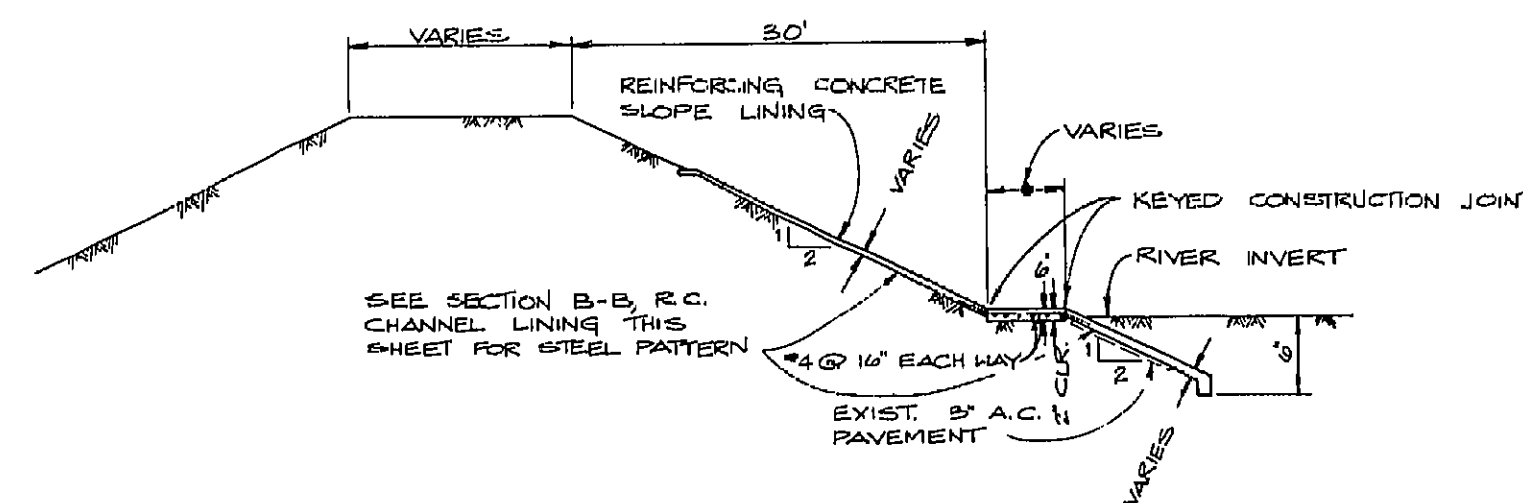

SECTION C-C  
NO SCALE


|                                                                             |                                                              |
|-----------------------------------------------------------------------------|--------------------------------------------------------------|
| ORANGE COUNTY<br>ENVIRONMENTAL MANAGEMENT AGENCY                            |                                                              |
| SLATER SEGERSTROM BRIDGE<br>(SA 31A) WIDENING OVER<br>SANTA ANA RIVER (EOI) |                                                              |
| CONCRETE SLOPE LINING<br>REMOVAL & REPLACEMENT<br>DETAILS                   |                                                              |
| DATE: 10-29-82                                                              | REVISIONS: 1. BY: G.W. FOSTER, DATE: 11-1-82, SCALE: 1/4\"/> |
| DWG NO: 16                                                                  | TITLE: SUPERVISOR OF MICROFILM SERVICES                      |

AS BUILT PLANS  
Contract No. UNKNOWN  
Date Completed             
Document No. 70008509

I HEREBY CERTIFY THAT THIS IS A TRUE AND ACCURATE COPY OF THE ABOVE DOCUMENT TAKEN UNDER MY DIRECTION AND CONTROL ON THIS DATE IN SACRAMENTO, CALIFORNIA PURSUANT TO AUTHORIZATION BY THE DIRECTOR OF TRANSPORTATION.

|                |                                    |                                         |
|----------------|------------------------------------|-----------------------------------------|
| DATE: 10-29-82 | SIGNATURE: <i>Donald Blackford</i> | TITLE: SUPERVISOR OF MICROFILM SERVICES |
|----------------|------------------------------------|-----------------------------------------|

Bridge No. 55C-371  
Other No. ....

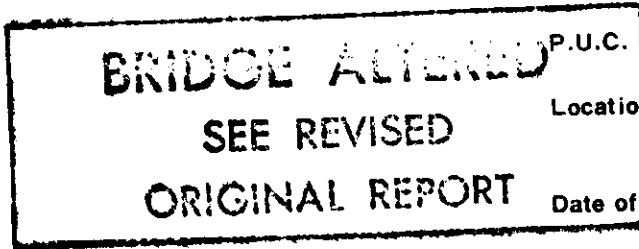

P.U.C. No. ....  
Location 07-Ora-FAU-M029  
Dist - Co - Rte - PM - City  
Date of Investigation October 1, 1980

Name SANTA ANA RIVER (Segerstrom Ave. (Slater Ave.) - 0.3 mi. W. of Harbor Blvd.)  
Lat. N33°-42.5' Long. W117°-55.5'

STRUCTURAL DATA AND HISTORY

Year Built 1974 By Orange County Contract No. Unknown

Date of Revisions ..... County  
Designed by: B.D. ☐ Orange County Plans Avail. @ .....

Description: Continuous five "T" beam (5) spans on RC abutments and RC piers.

Spans 1 @ 54'; 3 @ 72'; 1 @ 54' c/c  
Length 327.5' Skew 13° Rt. Design LL HS20-44  
Ratings: Inventory HS37/LF Operating HS62/LF Permit PPPPP/LF

DESCRIPTION - ON STRUCTURE

Bridge Width 1'br; 36'; 1'br  
Total Width 38' Lanes 2 Tracks None  
Median None Rail Type Metal Beam Guard Rail (0000)  
Vert. Clearance over deck Unimpaired Appr. Rdwy. Width 37'  
Wearing Surface None Deck Seal None  
Alignment Tangent (between curves)

DESCRIPTION - UNDER STRUCTURE

Roadway Section None  
Clearances: Vert. .... Horiz. .... Lt. .... Rt. ....  
Lanes .... Tracks .... Pumpplant: None ☒ See Br. No. ....  
Facilities Crossed Santa Ana River (OCFCD - E01)

Bridge No. 55C-371  
Date October 1, 1980

DESCRIPTION - HYDRAULICS

Channel Well defined. Side slopes - concrete paved.  
Navigable: Yes ☐ No ☒ Clearances: Vert. N Horiz. N

MAINTENANCE

Custodian Orange County Owner Orange County

ORIGINAL  
CONDITION RATING

|                              |    |
|------------------------------|----|
| Deck                         | 8  |
| Superstructure               | 8  |
| Substructure & Pipes         | 8  |
| Channel & Channel Protection | 8  |
| Retaining Walls              | N  |
| Approach Rdwy. Alignment     | 9  |
| Estimated Remaining Life     | 50 |

ORIGINAL  
APPRAISAL

|                          |          |
|--------------------------|----------|
| Overall                  | 8        |
| Deck Geometry            | 7        |
| Underclearances          | Vert. N  |
|                          | Horiz. N |
| Safe Load Capacity       | 9        |
| Waterway Adequacy        | 8        |
| Approach Rdwy. Alignment | 9        |

Widenable? Yes ☒ No ☐ Conditional ☐

Action Required by County District: Yes ☒ No ☐  
XXXXX

AVERAGE DAILY TRAFFIC: 10,000 (Estimated 1980)

BYPASS DETOUR LENGTH: 3 miles

ENCROACHMENTS: Nine 4"  $\phi$  conduits in the north exterior bay.

CONDITION OF STRUCTURE: The grade of the AC approach pavement at the westerly paving notch is lower than the grade of the bridge deck (1"±).

Otherwise, the structure is in good condition.

LOAD CAPACITY: The inventory, operating and permit ratings shown were obtained through the "Frame Rate" program using the load factor (LF) method of analysis.

RECOMMENDATIONS: Correct the offset between the bridge deck and the AC approach pavement at the westerly paving notch.

RECOMMENDED POSTING: None

FJW:ym  
cc: DRHiggins  
Orange County (2)

Original signed by  
FRANK J. WALLISER  
C 019767

AUG. 11, 1980

DIST 07 ROUTE CO RD COUNTY 55 C STRU. NO 0371 POSTMILE . RATING 038.0 WIDTH-FT STRU TYPE CGC YR ORIG CONST 70

|      | RATING<br>FACTOR | PT | SPAN | ULT MOM<br>TOP IN COM | ULT MOM CAP<br>IN COM | POS HS20<br>MOMENT | NEG HS20<br>MOMENT | POS PURP<br>MOMENT | NEG PURP<br>MOMENT | DEAD LOAD<br>MOMENT | SECONDARY<br>MOMENT |
|------|------------------|----|------|-----------------------|-----------------------|--------------------|--------------------|--------------------|--------------------|---------------------|---------------------|
| INV  | 1.87             | 4  | 1    | 11032.4               | 0.0                   | 2267.7             | -640.8             | 3290.6             | -1161.7            | 1450.6              | 0.0                 |
| OPER | 3.10             | 4  | 1    | 11032.4               | 0.0                   | 2267.7             | -640.8             | 3290.6             | -1161.7            | 1450.6              | 0.0                 |
| PURP | 1.40             | 10 | 3    | 0.0                   | 12489.9               | 418.9              | -2010.0            | 758.9              | -4817.0            | -2873.0             | 0.0                 |

THE NUMBER OF AXLES ON THE TRUCK THAT CAUSES THE PURPLE RATING FACTOR IS 13.  
FC = 1.30 FY = 60.

IF THE REPORTED ULTIMATE MOMENT CAPACITY IS 0, IT WAS DETERMINED NOT TO BE CRITICAL

- 2 SANTA ANA RIVER (SEGERSTROM ROAD)
- 3 CONT 5 SPAN RC T-BEAM W/NO AC SURFACING
- 4 ASSUMED STRUCTURE BUILT IN EARLY 70'S

PPPPPP

DIST 07 ROUTE CO RD COUNTY 55 C STRU. NO 0371 POSTMILE . RATING WIDTH-FT 038.0 STRU TYPE CGC YR ORIG CONST 70

AUG. 11, 1980

INFLUENCE LINE FOR CRITICAL INVENTORY RATING POINT SPAN 1 10TH POINT 4

| MEM NO | LEFT | .1     | .2     | .3     | .4     | .5     | .6     | .7     | .8     | .9     | RIGHT |
|--------|------|--------|--------|--------|--------|--------|--------|--------|--------|--------|-------|
| 1      | 0.0  | 2.711  | 5.454  | 8.262  | 11.165 | 8.797  | 6.589  | 4.573  | 2.782  | 1.247  | 0.0   |
| 2      | 0.0  | -1.212 | -1.981 | -2.371 | -2.449 | -2.279 | -1.927 | -1.458 | -0.936 | -0.429 | 0.0   |
| 3      | 0.0  | 0.306  | 0.500  | 0.599  | 0.618  | 0.575  | 0.486  | 0.368  | 0.236  | 0.108  | 0.0   |

THE CRITICAL OPERATING RATING POINT IS THE SAME AS THE CRITICAL INVENTORY RATING POINT

INFLUENCE LINE FOR CRITICAL PURPLE RATING POINT SPAN 3 10TH POINT 10

|   |     |        |        |        |        |        |        |        |        |        |     |
|---|-----|--------|--------|--------|--------|--------|--------|--------|--------|--------|-----|
| 1 | 0.0 | -0.085 | -0.164 | -0.234 | -0.288 | -0.321 | -0.329 | -0.306 | -0.246 | -0.146 | 0.0 |
| 2 | 0.0 | 0.271  | 0.600  | 0.941  | 1.251  | 1.486  | 1.603  | 1.556  | 1.303  | 0.799  | 0.0 |
| 3 | 0.0 | -1.122 | -2.451 | -3.817 | -5.048 | -5.972 | -6.419 | -6.216 | -5.193 | -3.178 | 0.0 |
| 4 | 0.0 | -2.813 | -4.588 | -5.479 | -5.643 | -5.233 | -4.405 | -3.313 | -2.111 | -0.955 | 0.0 |
| 5 | 0.0 | 0.515  | 0.868  | 1.076  | 1.157  | 1.130  | 1.013  | 0.823  | 0.579  | 0.298  | 0.0 |

- 2 SANTA ANA RIVER (SEGERSTROM ROAD)
- 3 CONT 5 SPAN RC T-BEAM W/NO AC SURFACING
- 4 ASSUMED STRUCTURE BUILT IN EARLY 70'S

# ORANGE COUNTY ROAD DEPT.

STATE OF CALIFORNIA


PLANS FOR CONSTRUCTION OF

55C-371

## SLATER - SEGERSTROM BRIDGE

### SA-31

ACROSS SANTA ANA RIVER  
(CHANNEL E-01)

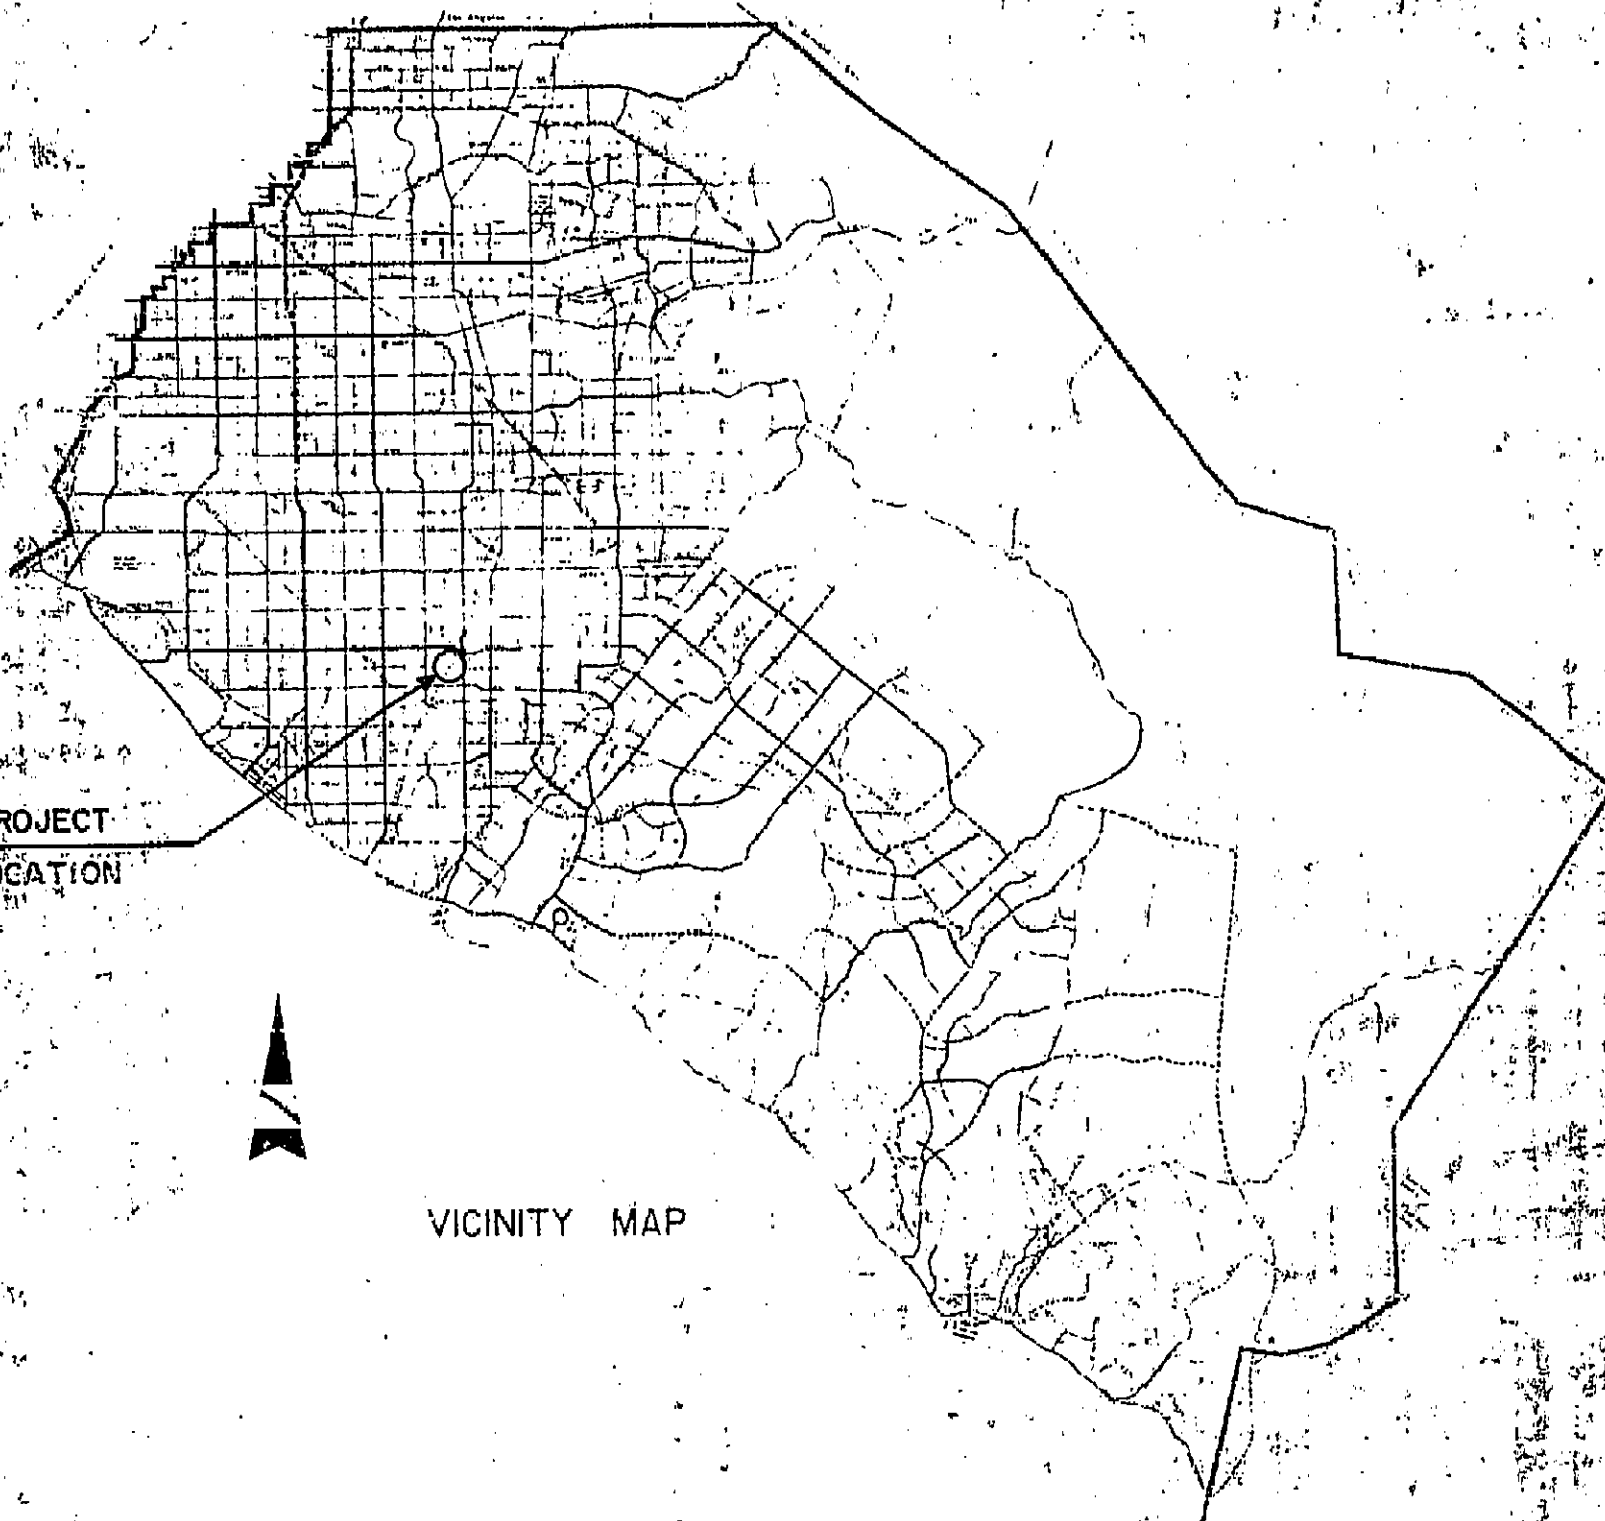

VICINITY MAP


BENCH MARK F.V. 69-70

IN THE SOUTHEAST PART OF INTERSECTION OF  
NEWHOPE STREET AND SLATER AVENUE;  
20.5 FEET EAST OF THE CENTERLINE  
PROLONGATION OF THE STREET TO THE NORTH;  
ABOUT 9 FEET SOUTH OF THE CENTERLINE  
PROLONGATION OF THE AVENUE TO THE  
WEST, 1 FOOT WEST OF THE CORNER OF A  
CONCRETE BLOCK WALL IN THE TOP OF A  
CONCRETE POST ABOUT 0.4 OF A FOOT  
HIGHER THAN THE GROUND.

ELEV. 38.784 1970 ADJ.

| CONVENTIONAL SIGNS   |           |
|----------------------|-----------|
| COUNTY LINE          | SHEET     |
| CITY LIMIT           | ENCLOSURE |
| BASE OF SURVEY LINE  | PAVING    |
| CONSTRUCTION         | PAVING    |
| THROWING             | PAVING    |
| VALUING              | PAVING    |
| CULVERT              | PAVING    |
| UNDO FENCE           | PAVING    |
| CHAIN LINE FENCE     | PAVING    |
| CONCRETE METAL FENCE | PAVING    |
| CONCRETE WALL        | PAVING    |
| MASONRY WALL         | PAVING    |
| WHEEL OF RIGGS       | PAVING    |
| TOP OF SLOPE         | PAVING    |
| TOP OF SLOPE         | PAVING    |

AS BUILT PLANS  
Contract No. 55C-371  
Date Completed 1970  
Document No. 12

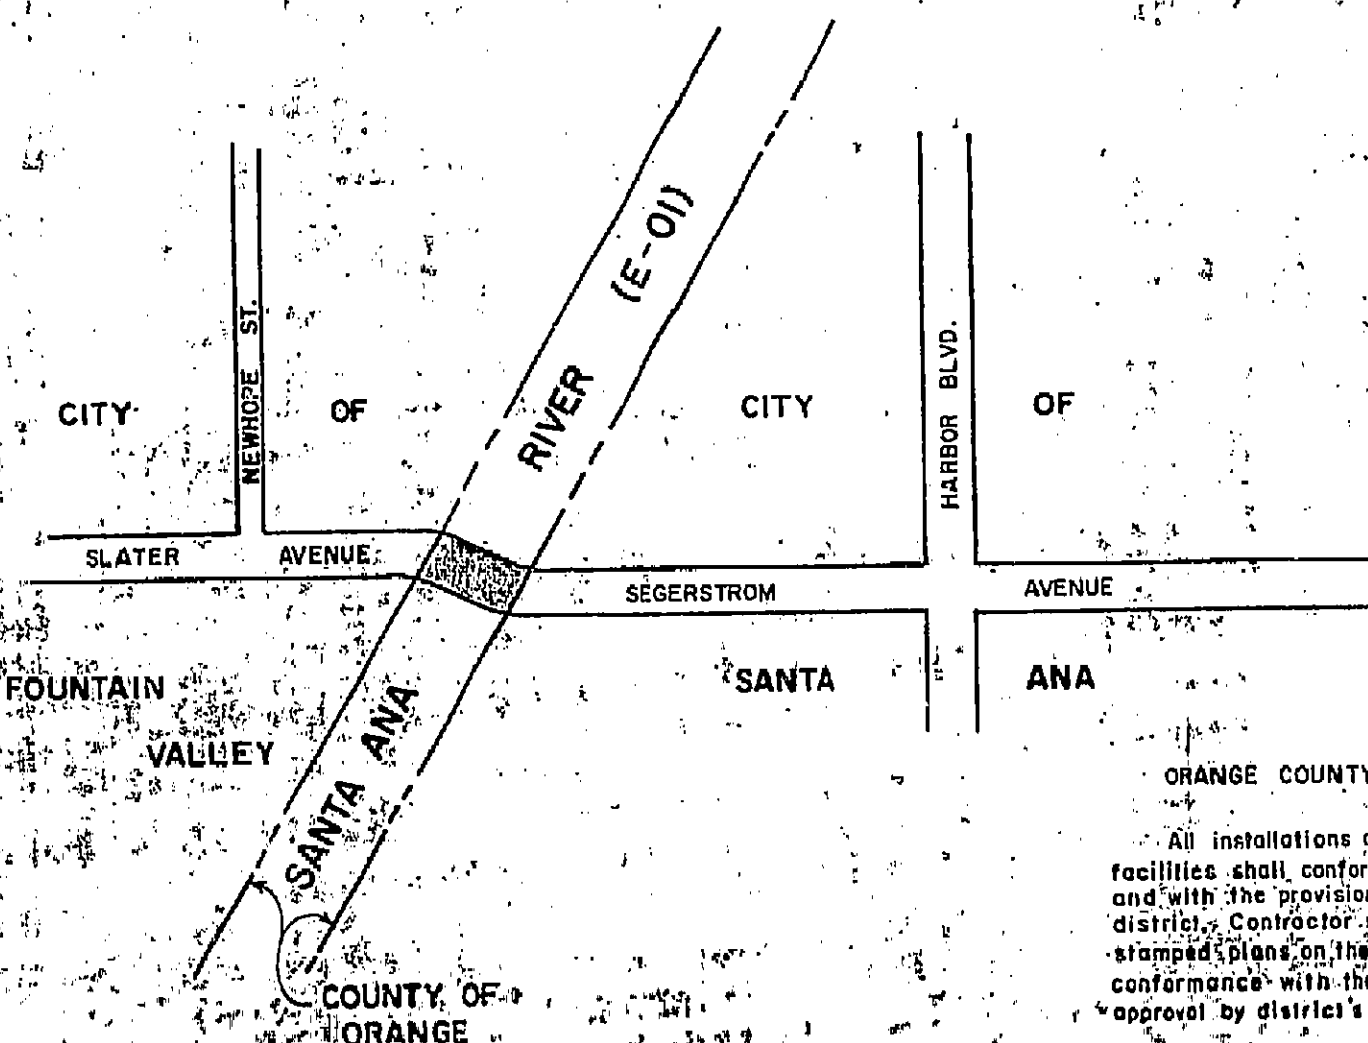

#### ORANGE COUNTY FLOOD CONTROL DISTRICT

All installations and work affecting flood control district facilities shall conform with district's standard specifications and with the provisions of the construction permit granted by district. Contractor shall maintain a copy of said permit and stamped plans on the job site. Use of district property and conformance with the above shall be subject to inspection and approval by district's duly assigned inspector.

DISTRICT INSPECTOR SHALL BE NOTIFIED PRIOR TO COMMENCEMENT OF ANY WORK IN ACCORDANCE WITH PERMIT PROVISIONS.


#### INDEX OF SHEETS

| SHT. NO. | DESCRIPTION                        |
|----------|------------------------------------|
| 1        | TITLE SHEET                        |
| 2        | GENERAL PLAN & APPROXIMATE         |
| 3        | FOUNDATION                         |
| 4        | ABUTMENT DETAILS                   |
| 5        | PIER DETAILS                       |
| 6        | PIER EXTENSION DETAILS             |
| 7        | SUPERSTRUCTURE LAYOUT &            |
| 8        | REINFORCEMENT                      |
| 9        | TYPICAL SECTION                    |
| 10       | MISCELLANEOUS DETAIL               |
| 11       | GUARD RAIL - STRUCTURE, EXCAVATION |
| 12       | AND BACKFILL                       |
| 13       | PILING DETAILS                     |
| 14       | LOG OF TEST BORINGS                |
| 15       | EAST LEVEE ACCESS RAMP DETAILS     |
| 16       | LEVEE EXCAVATION & BACKFILL        |
| 17       | SLOPE PROTECTION DETAILS           |



APPROVED: [Signature] DATE April 23, 1971  
ROAD COMMISSIONER R.D.E. 6978

DR. 12 (11359)



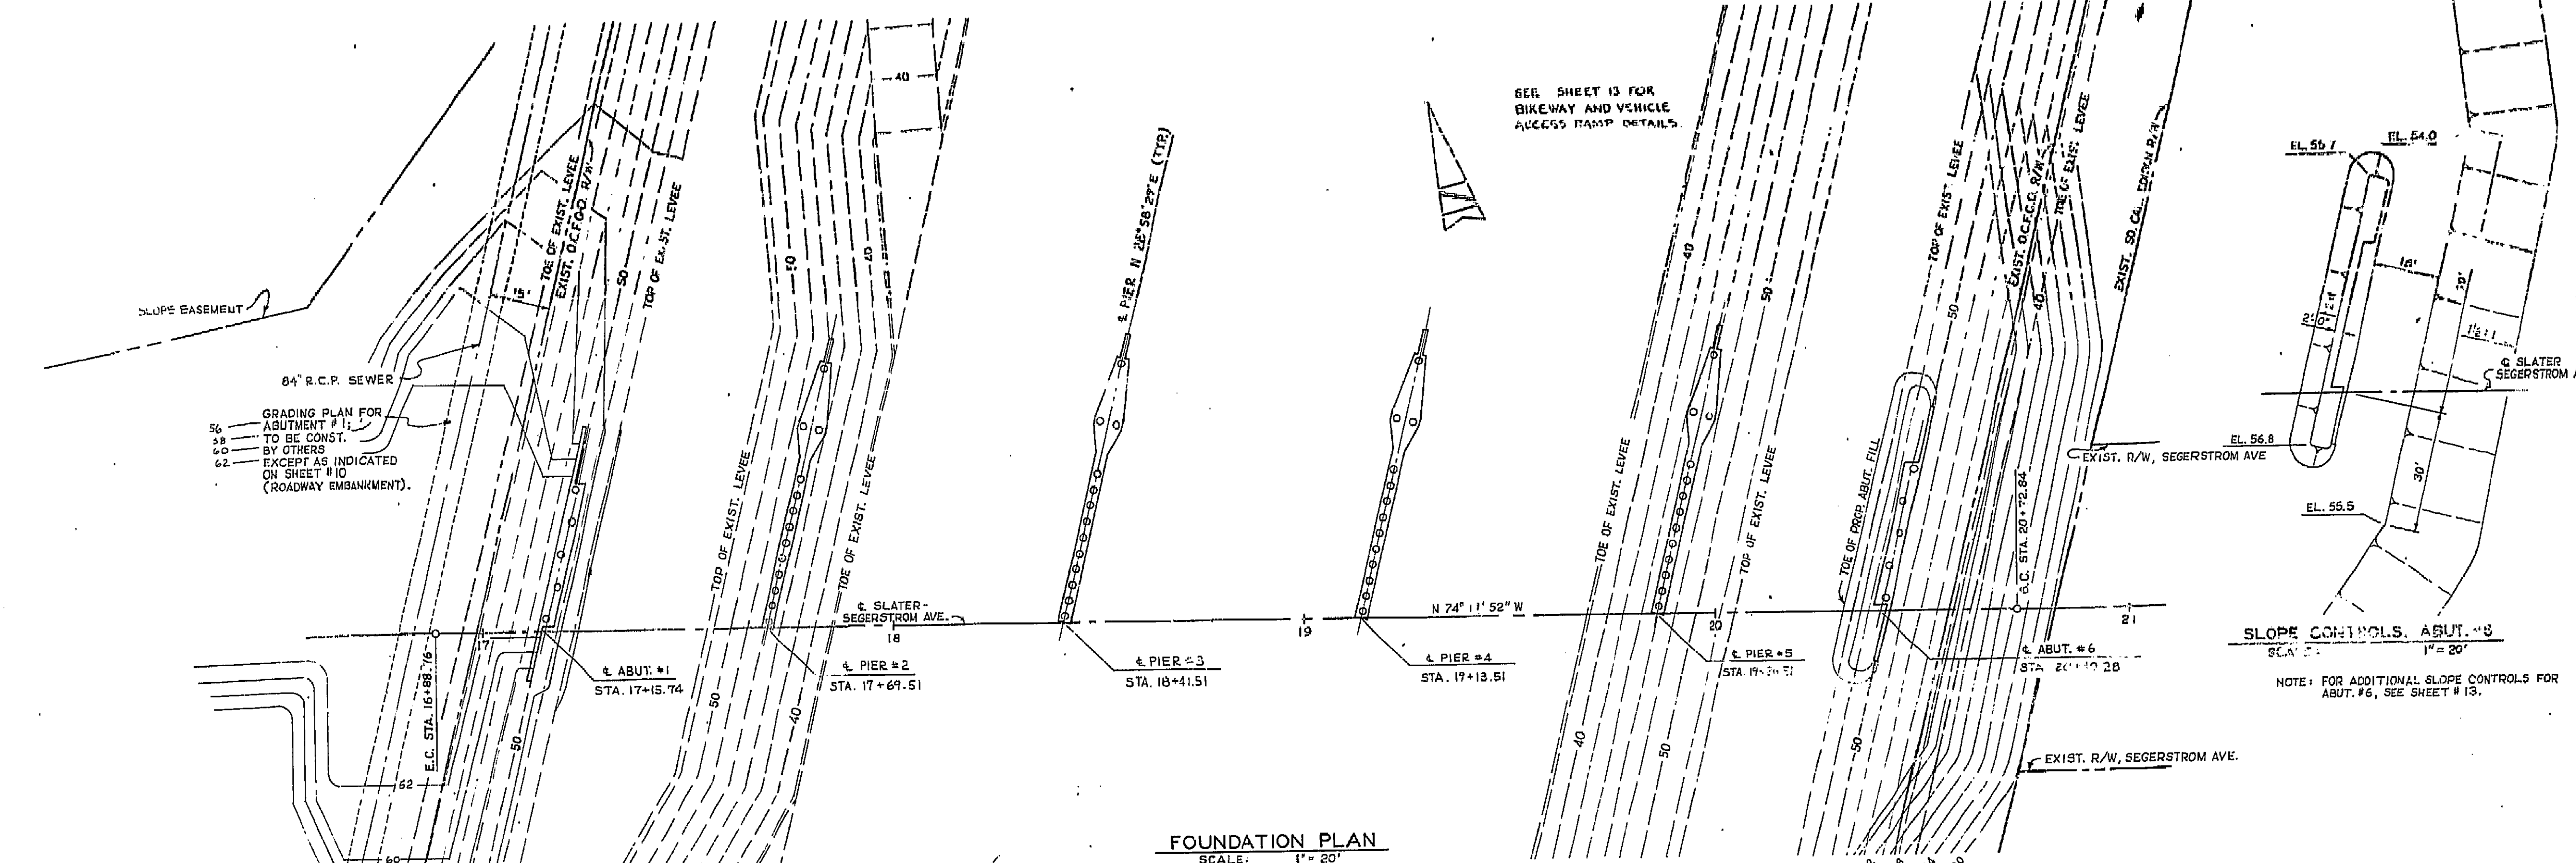


- NOTES:
1. PILE TYPE: CLASS 70 CONCRETE PILE
  2. EXISTING CONTOURS SHOWN ARE APPROXIMATE ONLY.
  3. ALL ABUTMENT PILES SHALL BE PREDRILLED TO ELEVATION 44.50
  4. CONTRACTOR SHALL CONSTRUCT TEMPORARY ACCESS ROAD TO MAINTAIN THROUGH ACCESS ALONG LEVEE.

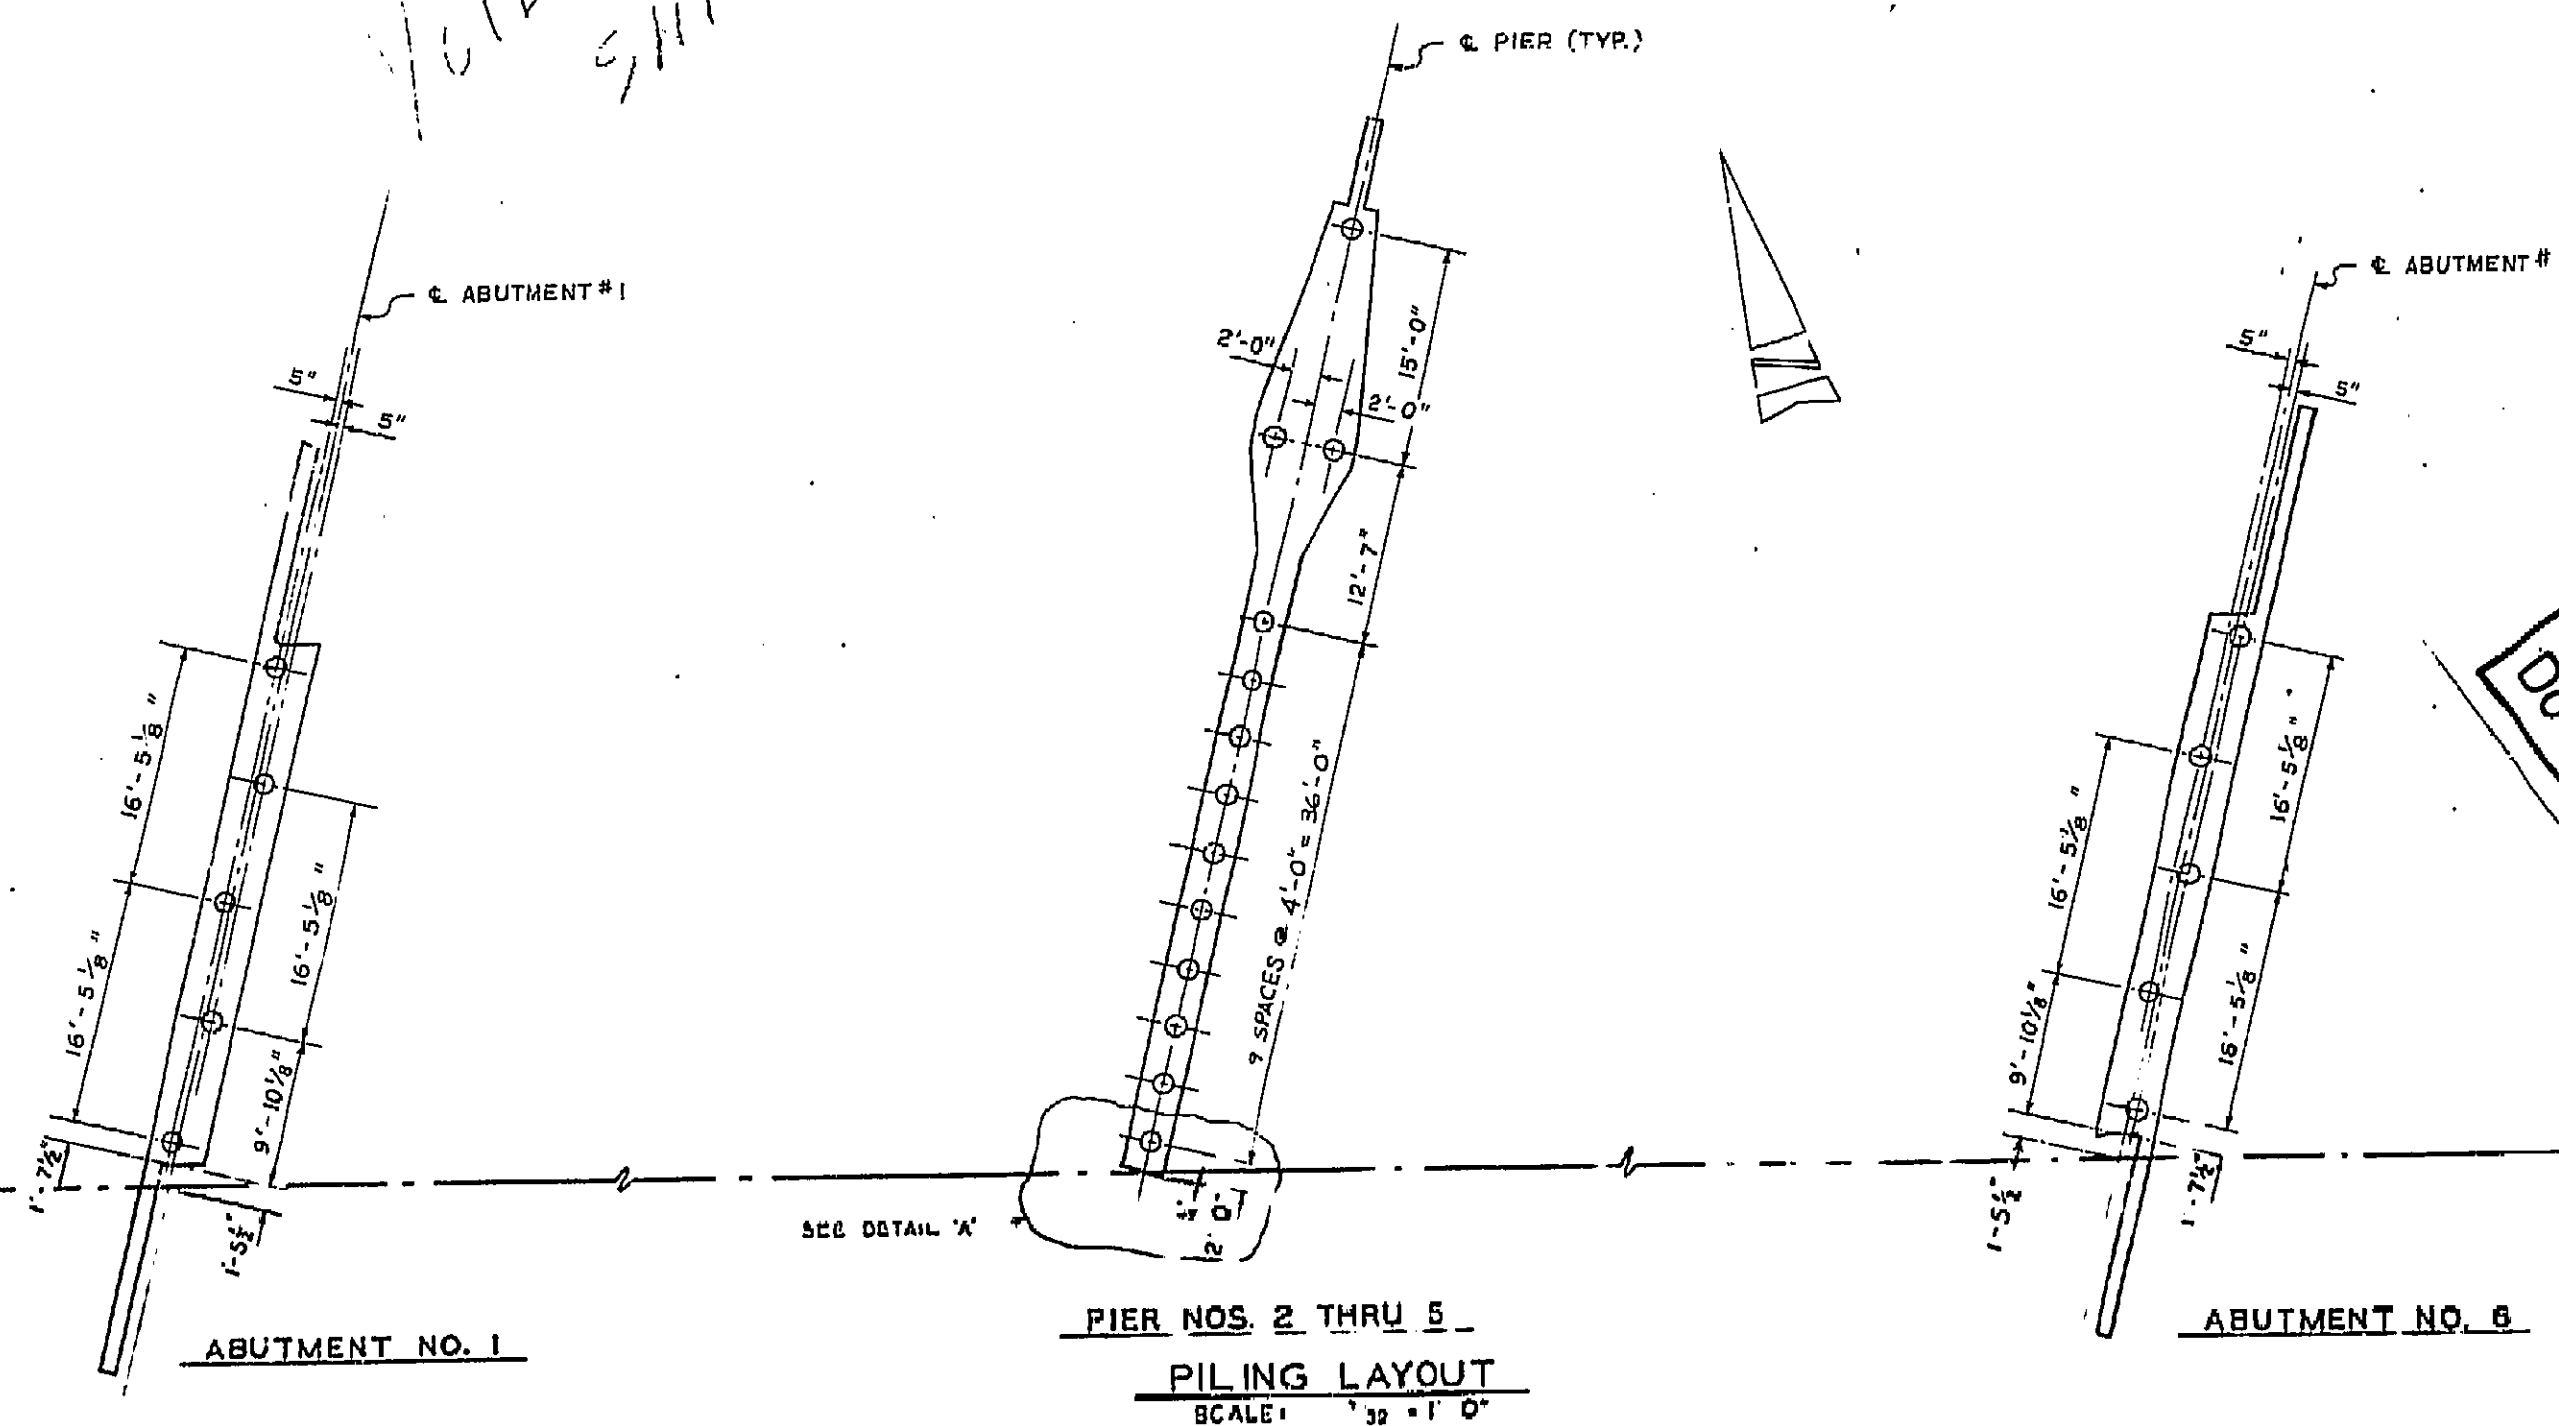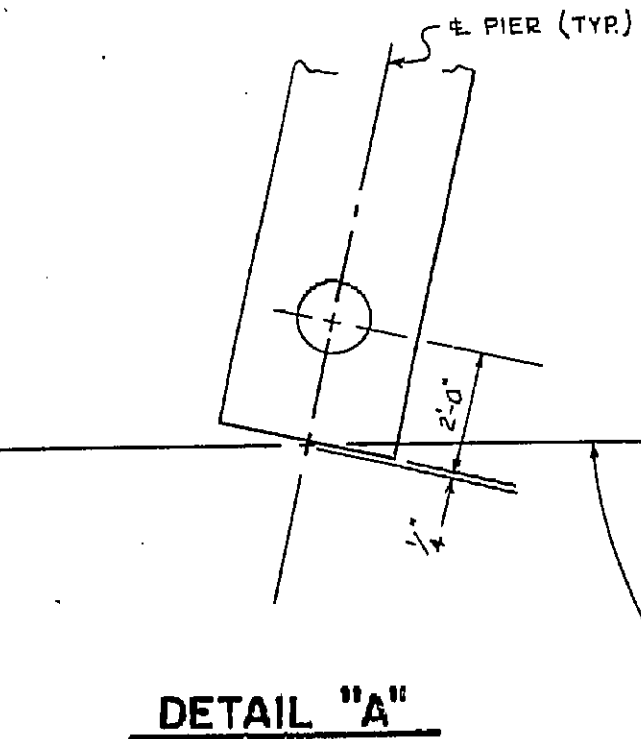

| PILING DATA |           |             |          |
|-------------|-----------|-------------|----------|
| PIER NO.    | PILE NO.  | PILE CUTOFF | PILE TIP |
| ABUT. #1    | PILE #1   | 54.15       | 4.00     |
| ABUT. #1    | PILE #2   | 54.03       | 4.00     |
| ABUT. #1    | PILE #3   | 53.89       | 4.00     |
| ABUT. #1    | PILE #4   | 53.75       | 4.00     |
| ABUT. #1    | PILE #5   | 53.63       | 4.00     |
| PIER #2     | ALL PILES | 32.25       | 4.00     |
| PIER #3     | ALL PILES | 32.25       | 4.00     |
| PIER #4     | ALL PILES | 32.25       | 4.00     |
| PIER #5     | ALL PILES | 32.25       | 4.00     |
| ABUT. #6    | PILE #58  | 54.81       | 10.00    |
| ABUT. #6    | PILE #59  | 54.68       | 10.00    |
| ABUT. #6    | PILE #60  | 54.55       | 10.00    |
| ABUT. #6    | PILE #61  | 54.41       | 10.00    |
| ABUT. #6    | PILE #62  | 54.28       | 10.00    |


\* PILES ARE NUMBERED BEGINNING WITH THE PILE NEAREST THE CENTERLINE OF SLATER-SEGERSTROM AVE. AND PROGRESSING NORTHERLY UPSTREAM BEGINNING WITH ABUTMENT #1 AND PROGRESSING FROM WEST TO EAST.

**AS BUILT PLANS**  
 Contract No. 22-1100-100  
 Date Completed 10/10/19  
 Document No. 1000-8277

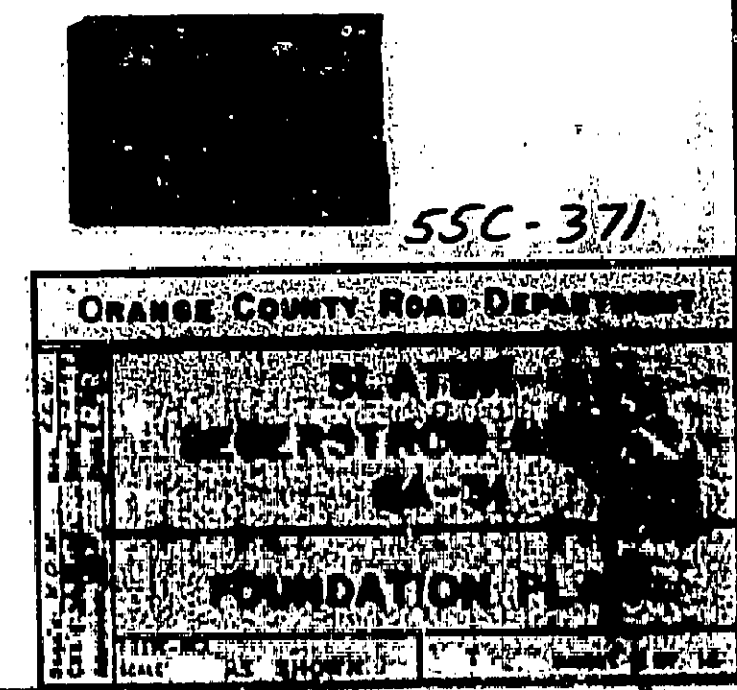


I HEREBY CERTIFY THAT THIS IS A TRUE AND ACCURATE COPY OF THE ABOVE DOCUMENT TAKEN UNDER MY DIRECTION AND CONTROL ON THIS DATE IN SACRAMENTO, CALIFORNIA PURSUANT TO AUTHORIZATION BY THE DIRECTOR OF TRANSPORTATION.  
 10/10/19 [Signature] Supervisor of Planning



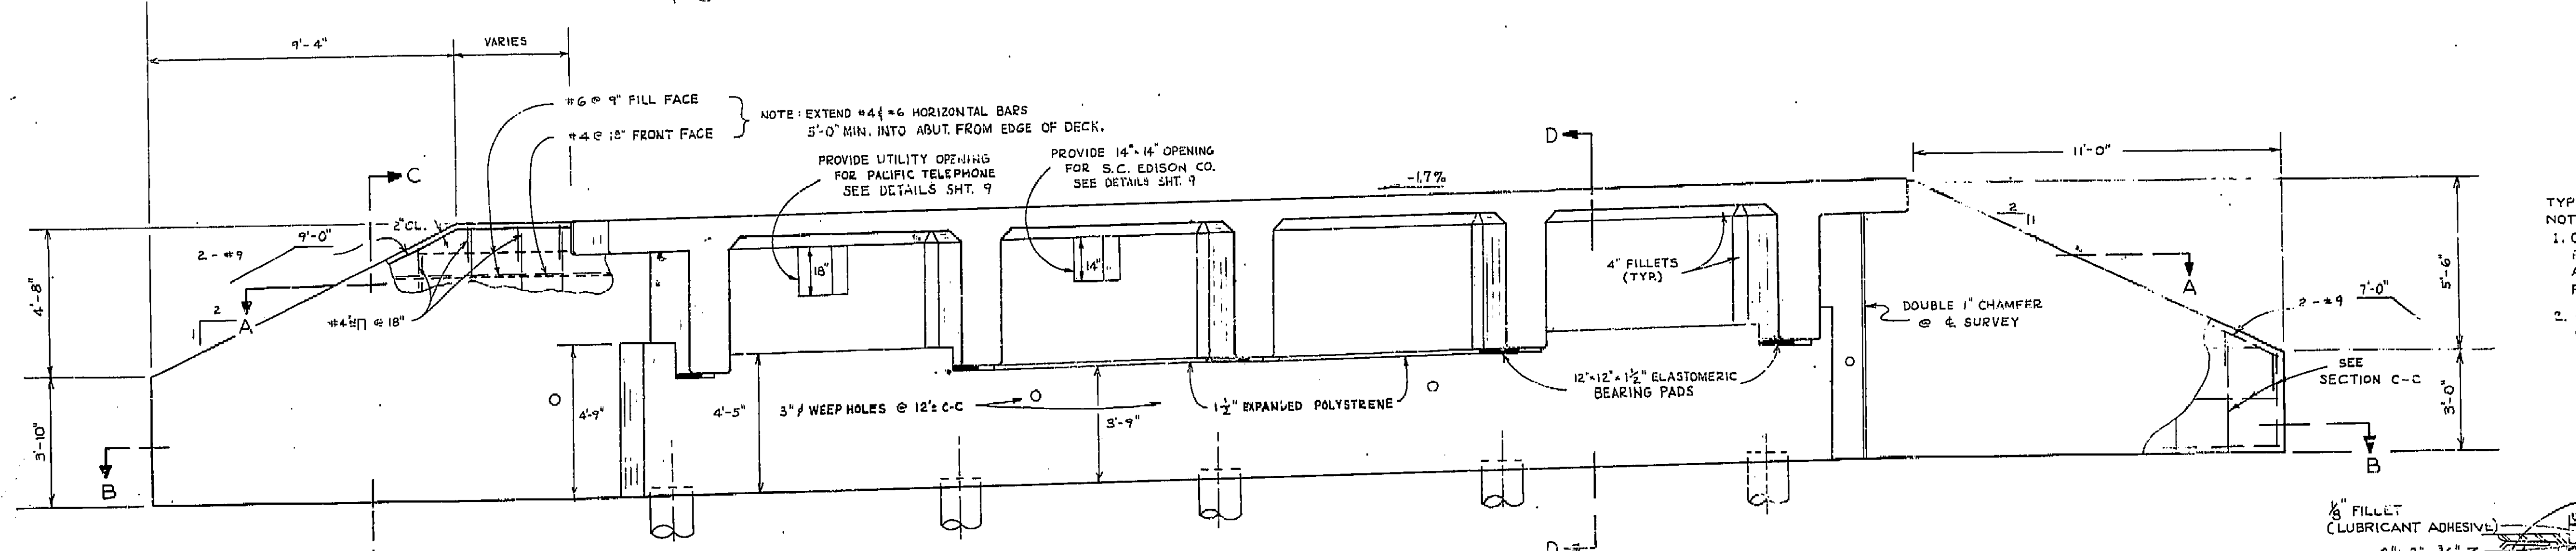

TYPE B-1 SEAL  
NOTES:

1. GROOVE WIDTH SHALL BE AS RECOMMENDED BY THE JOINT SEAL MANUFACTURER AND AS SPECIFIED IN THE SPECIAL PROVISIONS.
2. GROOVE DEPTH SHALL BE EQUAL TO OR GREATER THAN THE DEPTH OF SEAL MEASURED ALONG CONTACT SURFACE, WHEN COMPLETED TO MINIMUM WIDTH POSITION, FIG. 3.

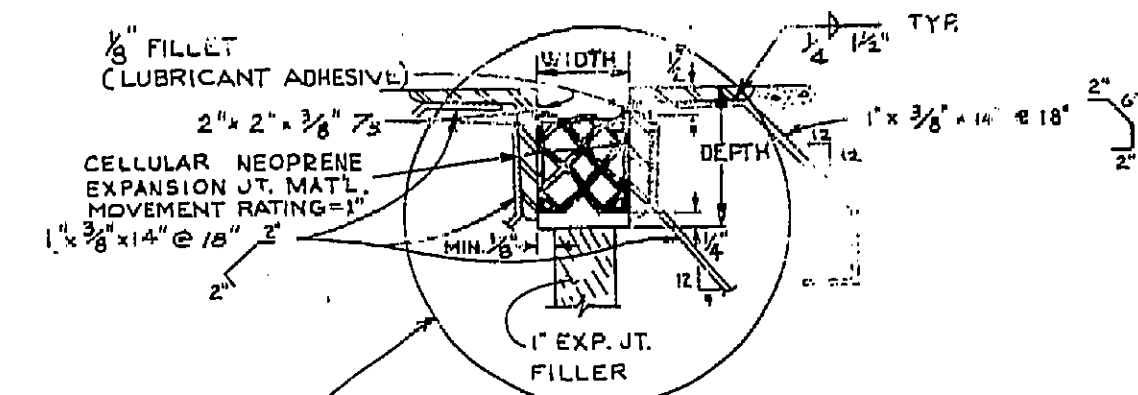


TYPE B1  
SEAL


**AS BUILT PLANS**  
Contract No. UNKNOWN  
Date Completed \_\_\_\_\_  
Document No. 7000 8277

**ELEVATION**  
SCALE  $3/8" = 1'-0"$


NOTE : ABUTMENT #6 SHOWN, ABUTMENT #1 SIMILAR

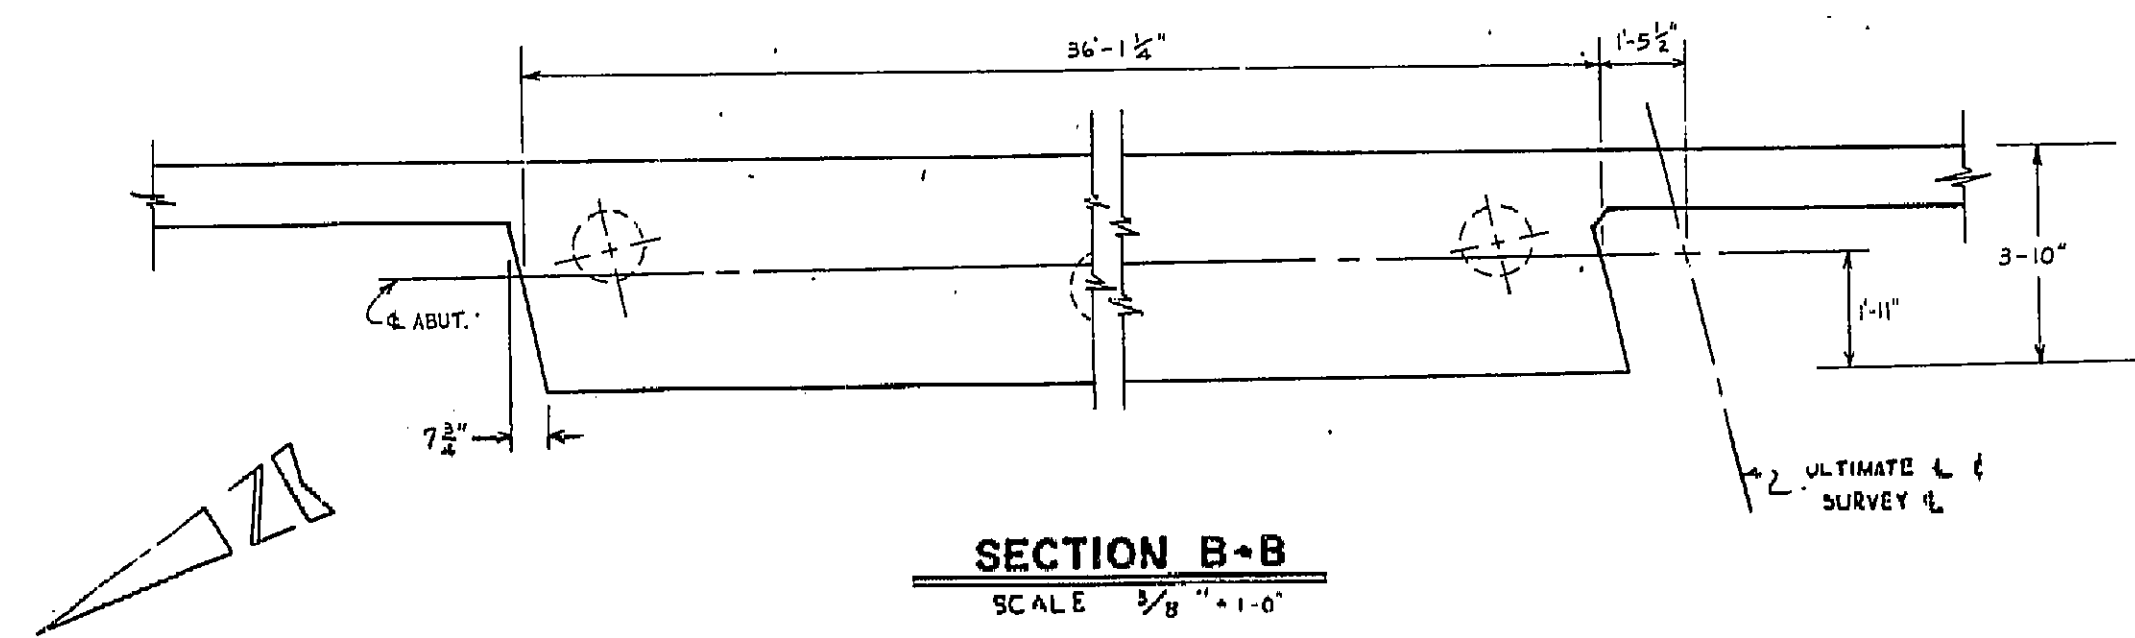

**SECTION B-B**  
SCALE 5/8" = 1'-0"

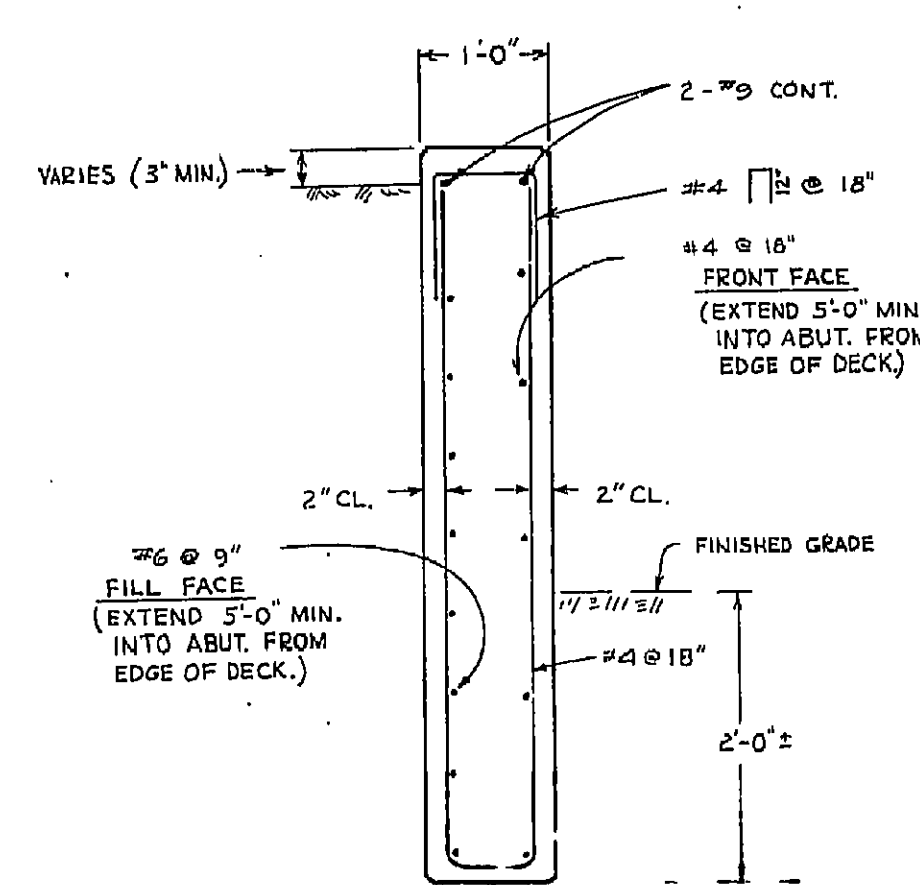

**SECTION C-C**  
SCALE: 1" = 10'

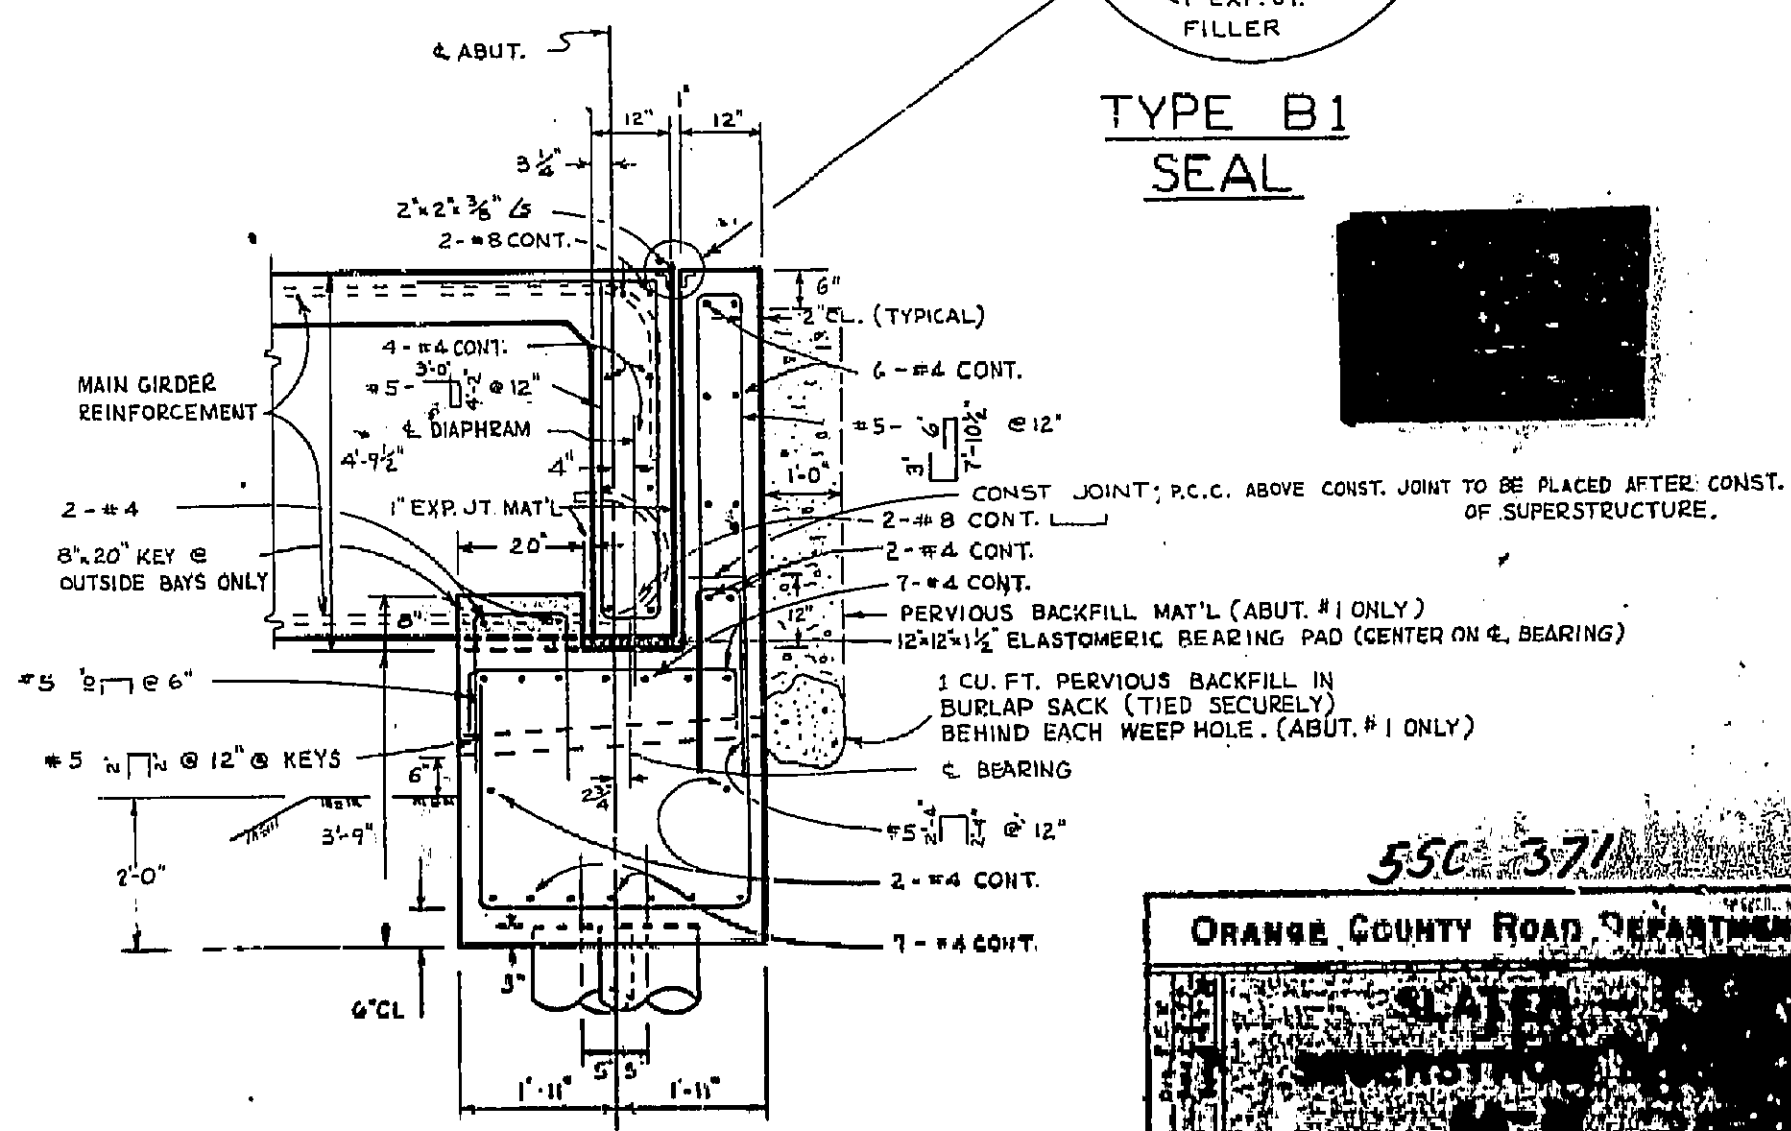

**SECTION D-D**  
SCALE 1/2"=1'-0"


550 3711  
ORANGE COUNTY ROAD DEPARTMENT  
SLATED  
SHERBORN  
FALLS

DR. 12 (1/359)


I HEREBY CERTIFY THAT THIS IS A TRUE AND ACCURATE COPY OF THE ABOVE DOCUMENT TAKEN UNDER MY DIRECTION AND CONTROL ON THIS DATE IN SACRAMENTO, CALIFORNIA PURSUANT TO AUTHORIZATION BY THE DIRECTOR OF TRANSPORTATION.

DATE 10/10/79 SIGNATURE Joseph M. Costa TITLE Supervisor of Airfreight




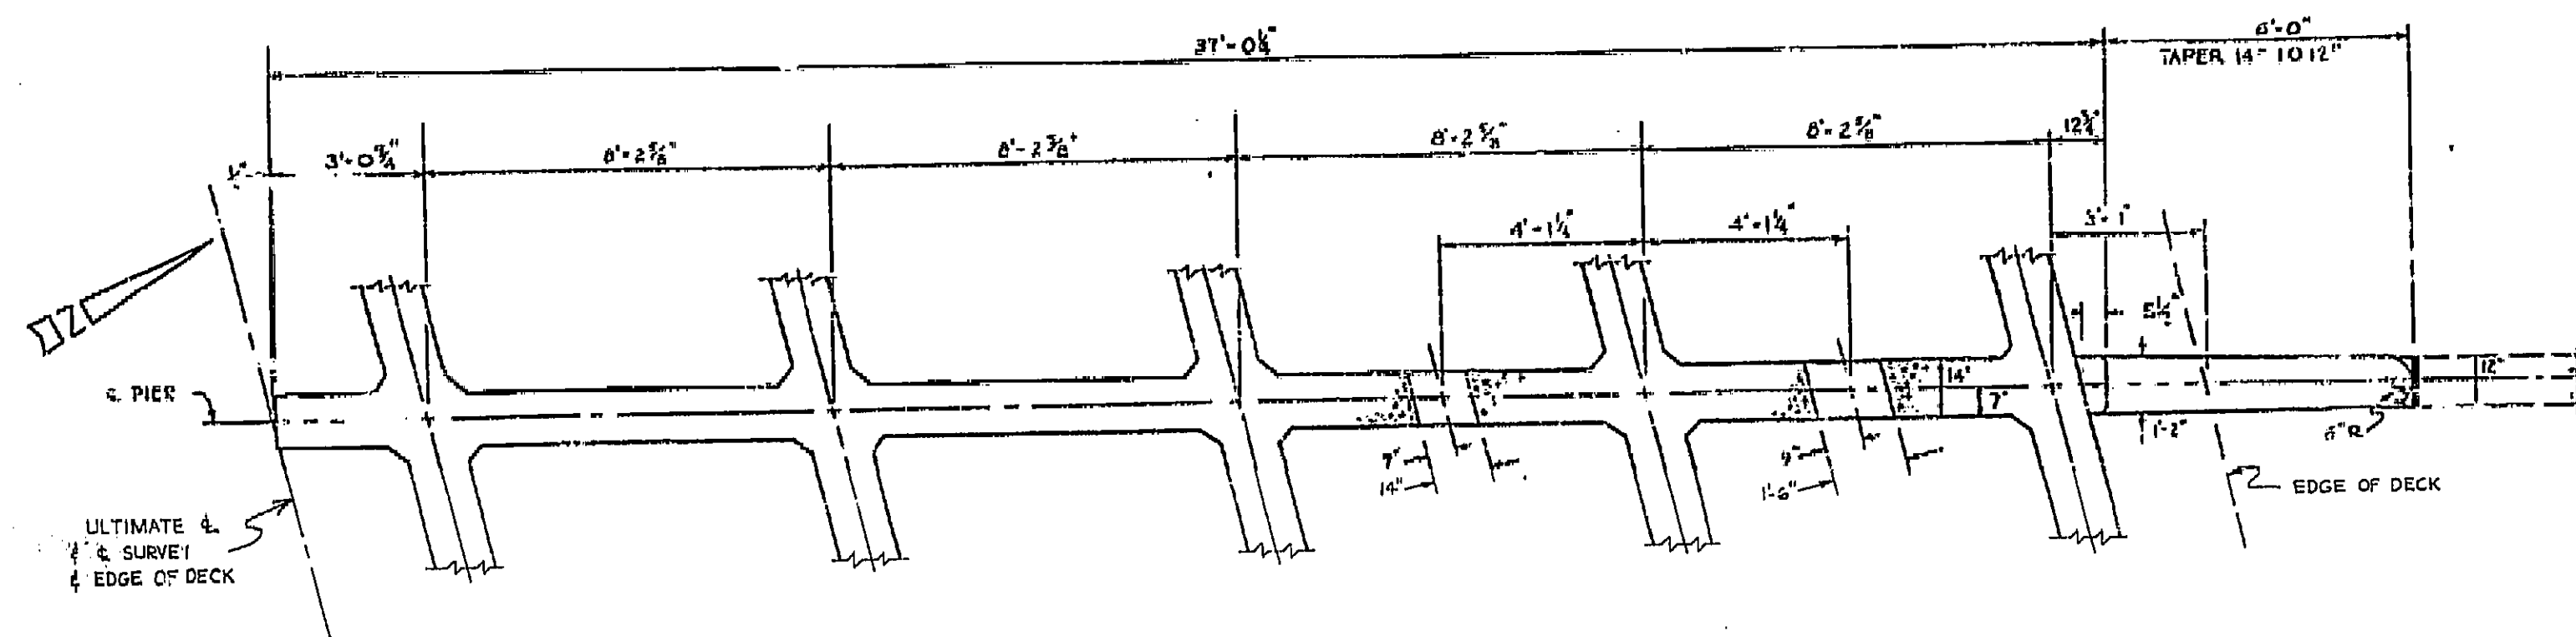

SECTION A-A  
SCALE 3/8" = 1'-0"

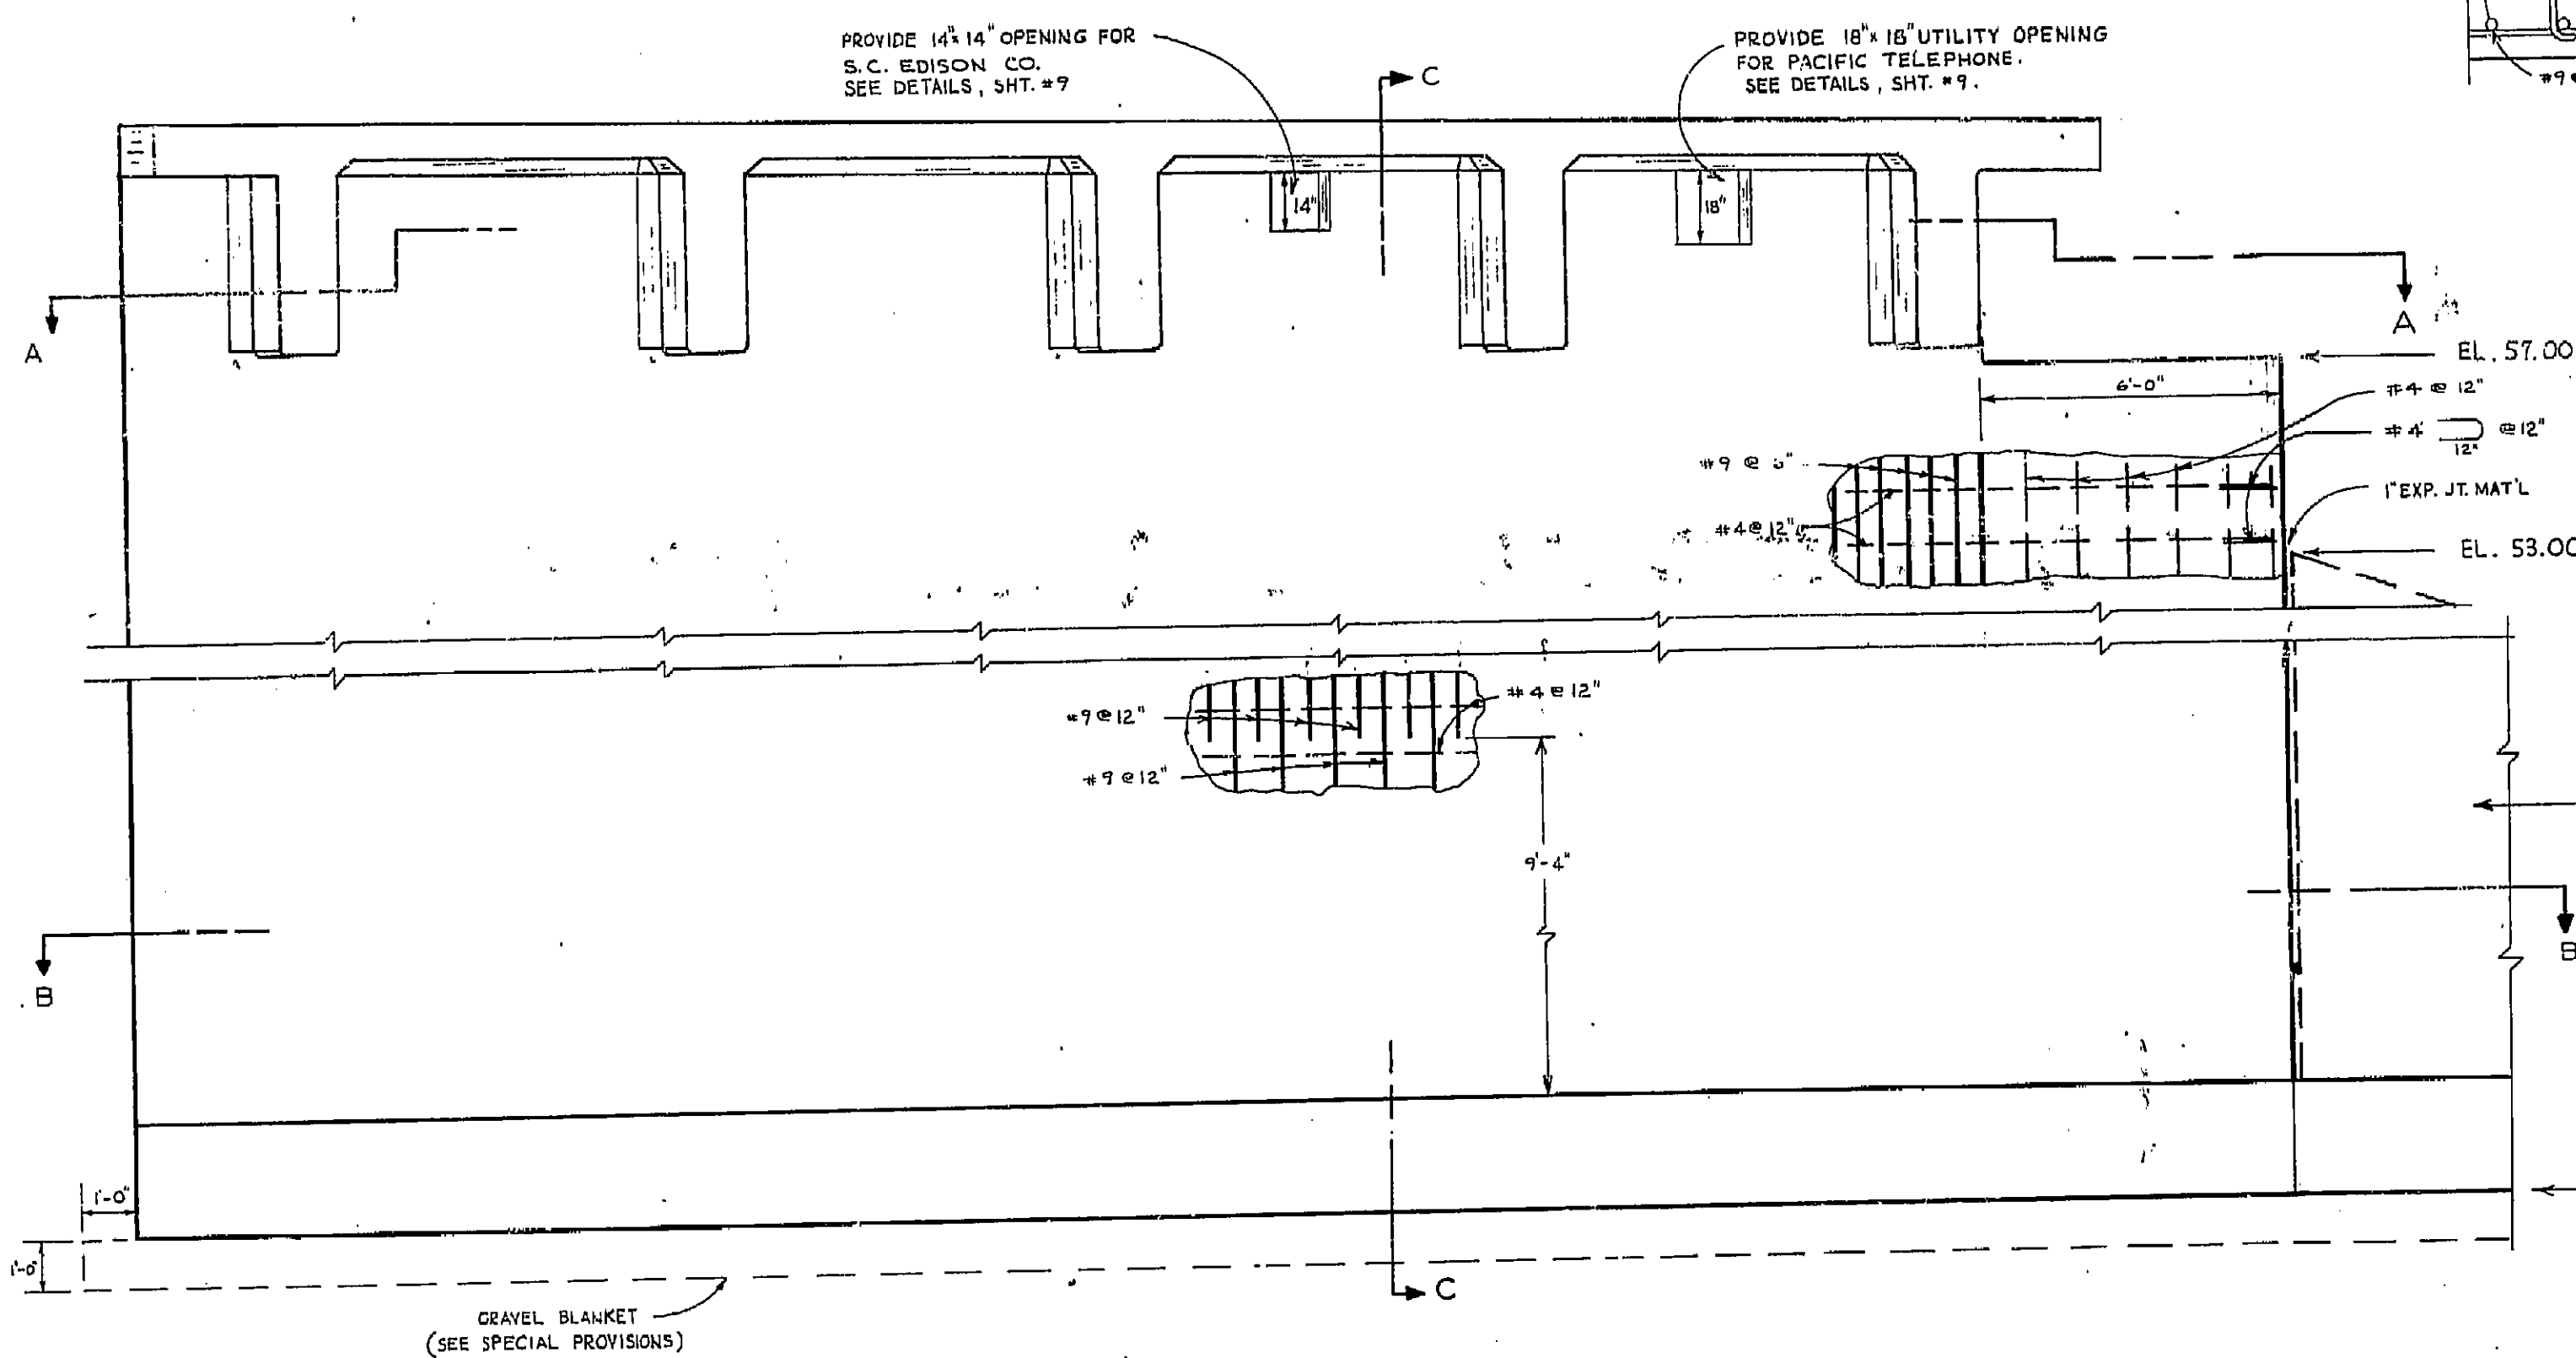


ELEVATION  
SCALE 3/8" = 1'-0"

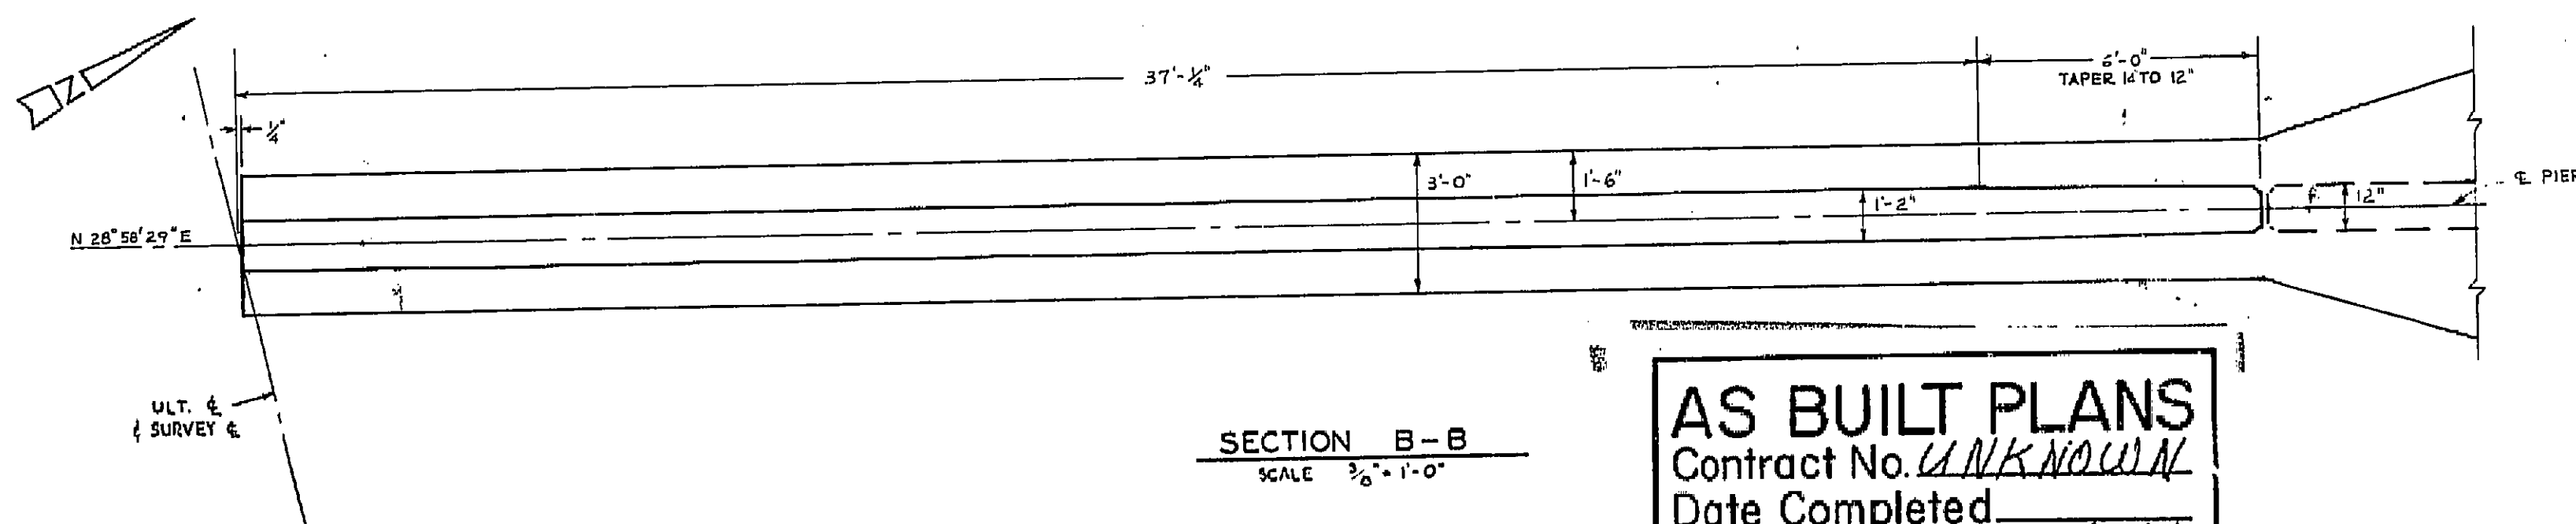


SECTION B-B  
SCALE 3/8" = 1'-0"


**AS BUILT PLANS**  
Contract No. UNKNOWN  
Date Completed 10/10/77  
Document No. 7000 8277

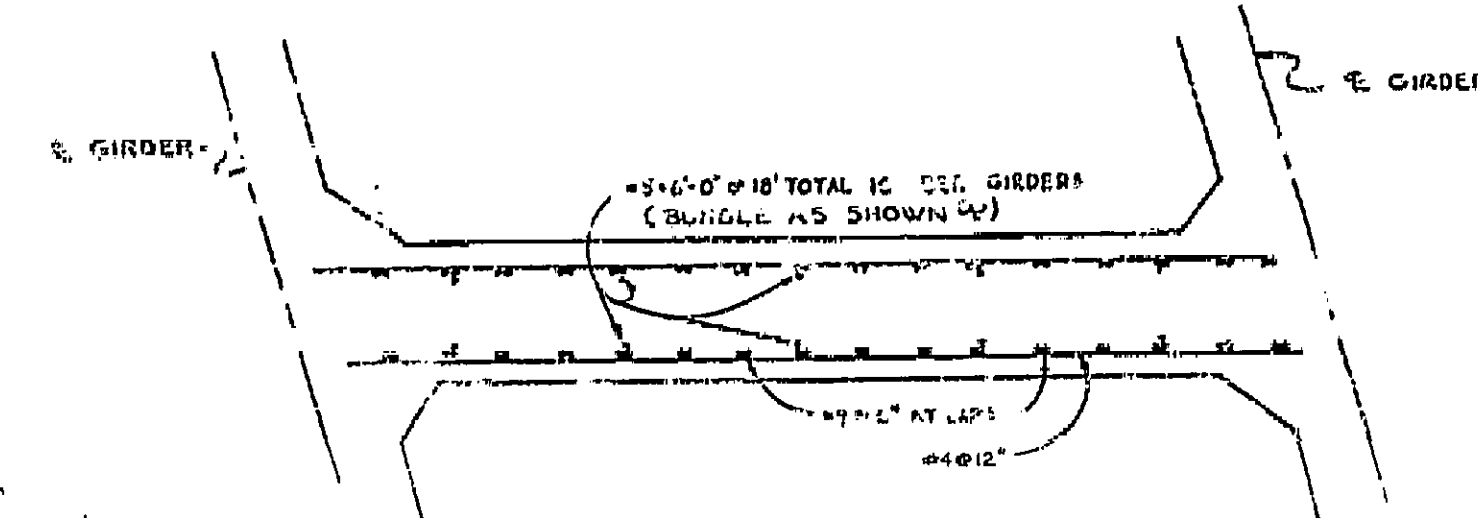

SECTION D-D  
SCALE 3/4" = 1'-0"

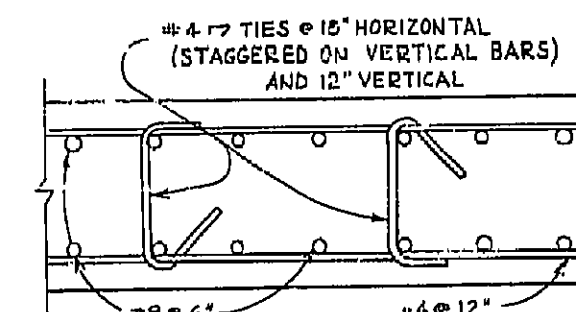

SECTION E-E  
SCALE 1" = 1'-0"

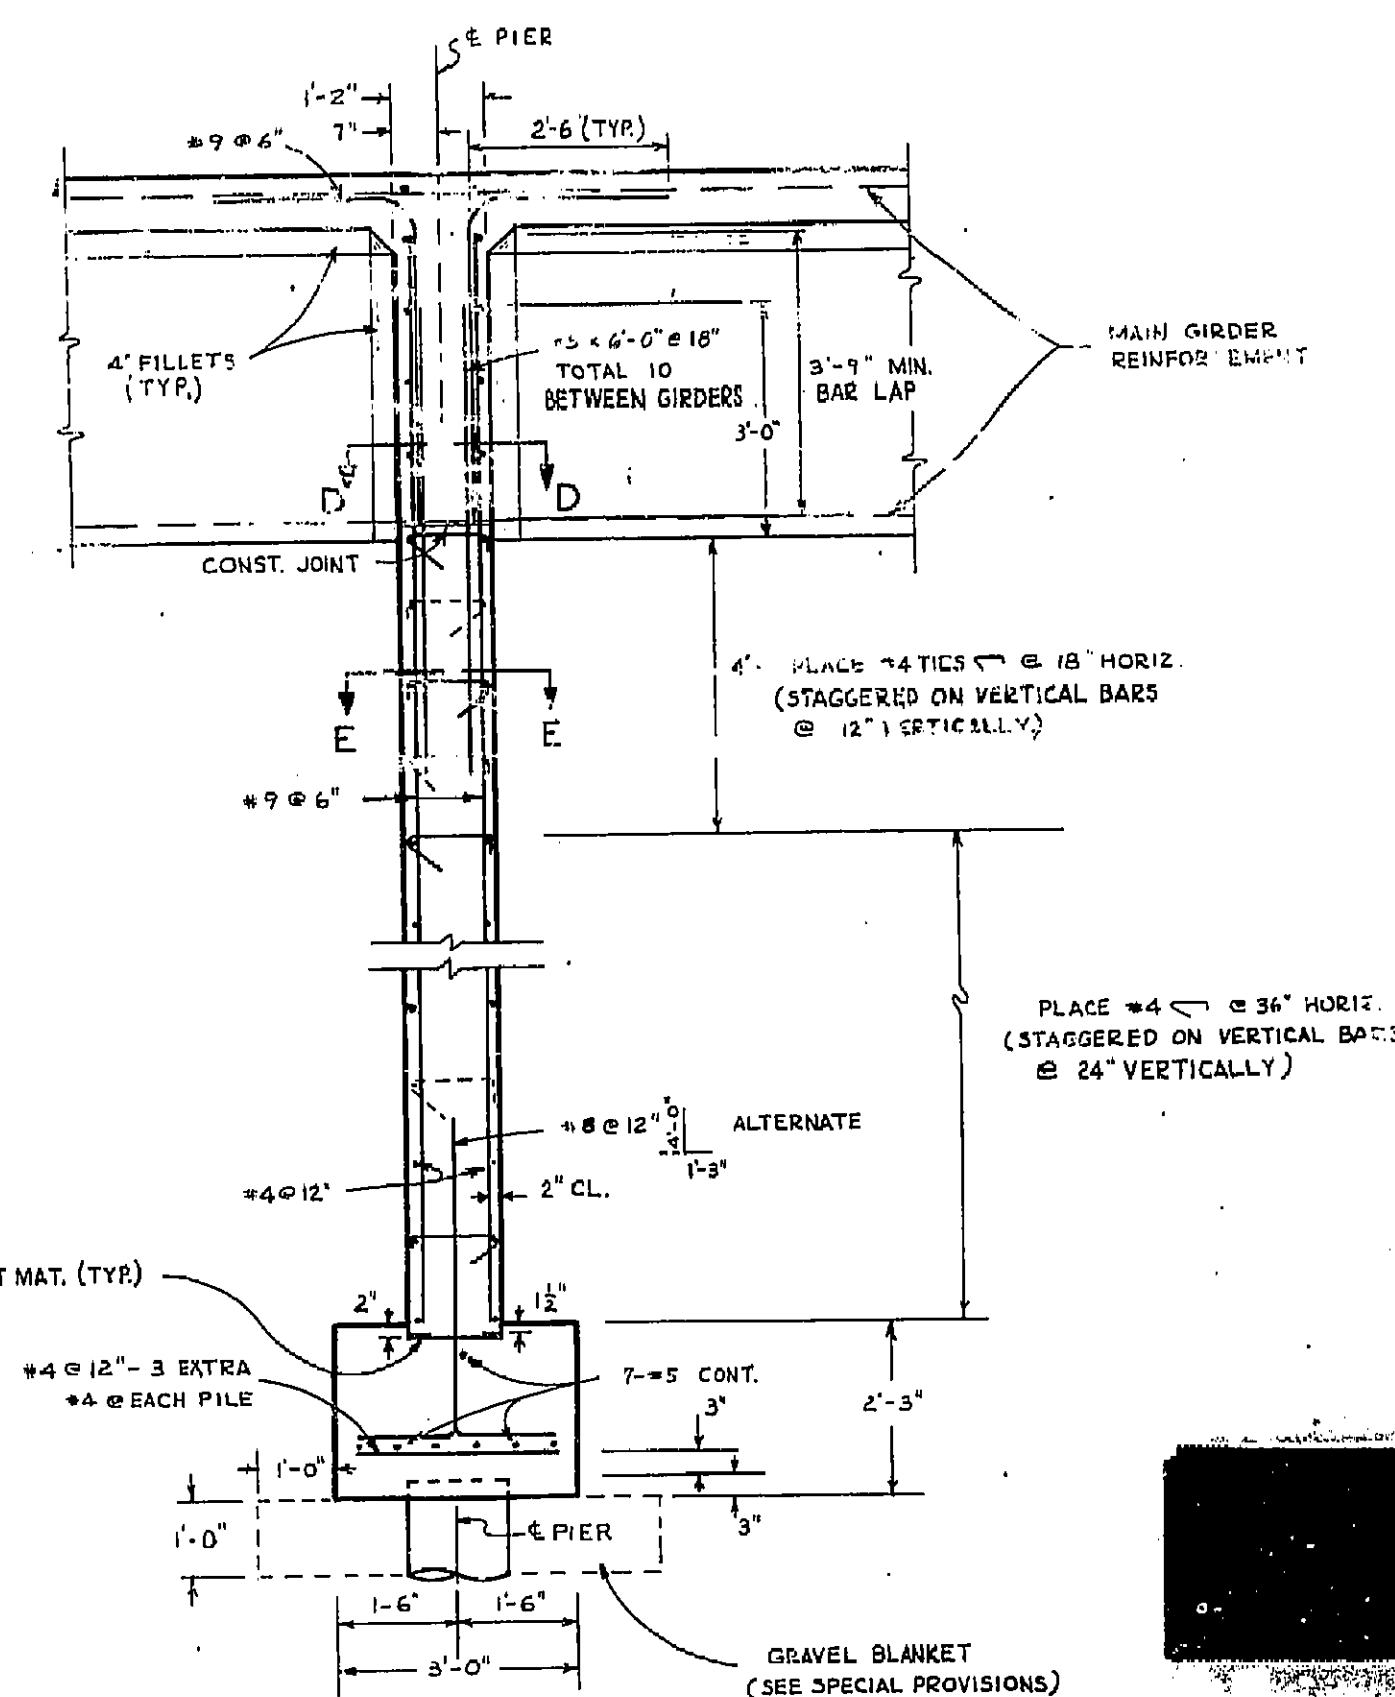

SECTION C-C  
SCALE 1/2" = 1'-0"

55C-371

ORANGE COUNTY ROAD DEPARTMENT

SLATER -  
SEGERSTROM BRIDGE  
SA-31

PIER DETAILS


AS SHOWN

DR.12 (11359) 5


I HEREBY CERTIFY THAT THIS IS A TRUE AND ACCURATE COPY OF THE ABOVE DOCUMENT TAKEN UNDER MY DIRECTION AND CONTROL ON THIS DATE IN SACRAMENTO, CALIFORNIA PURSUANT TO AUTHORIZATION BY THE DIRECTOR OF TRANSPORTATION.

Date 10/10/77 Signature [Signature] Title Supervisor of Planning



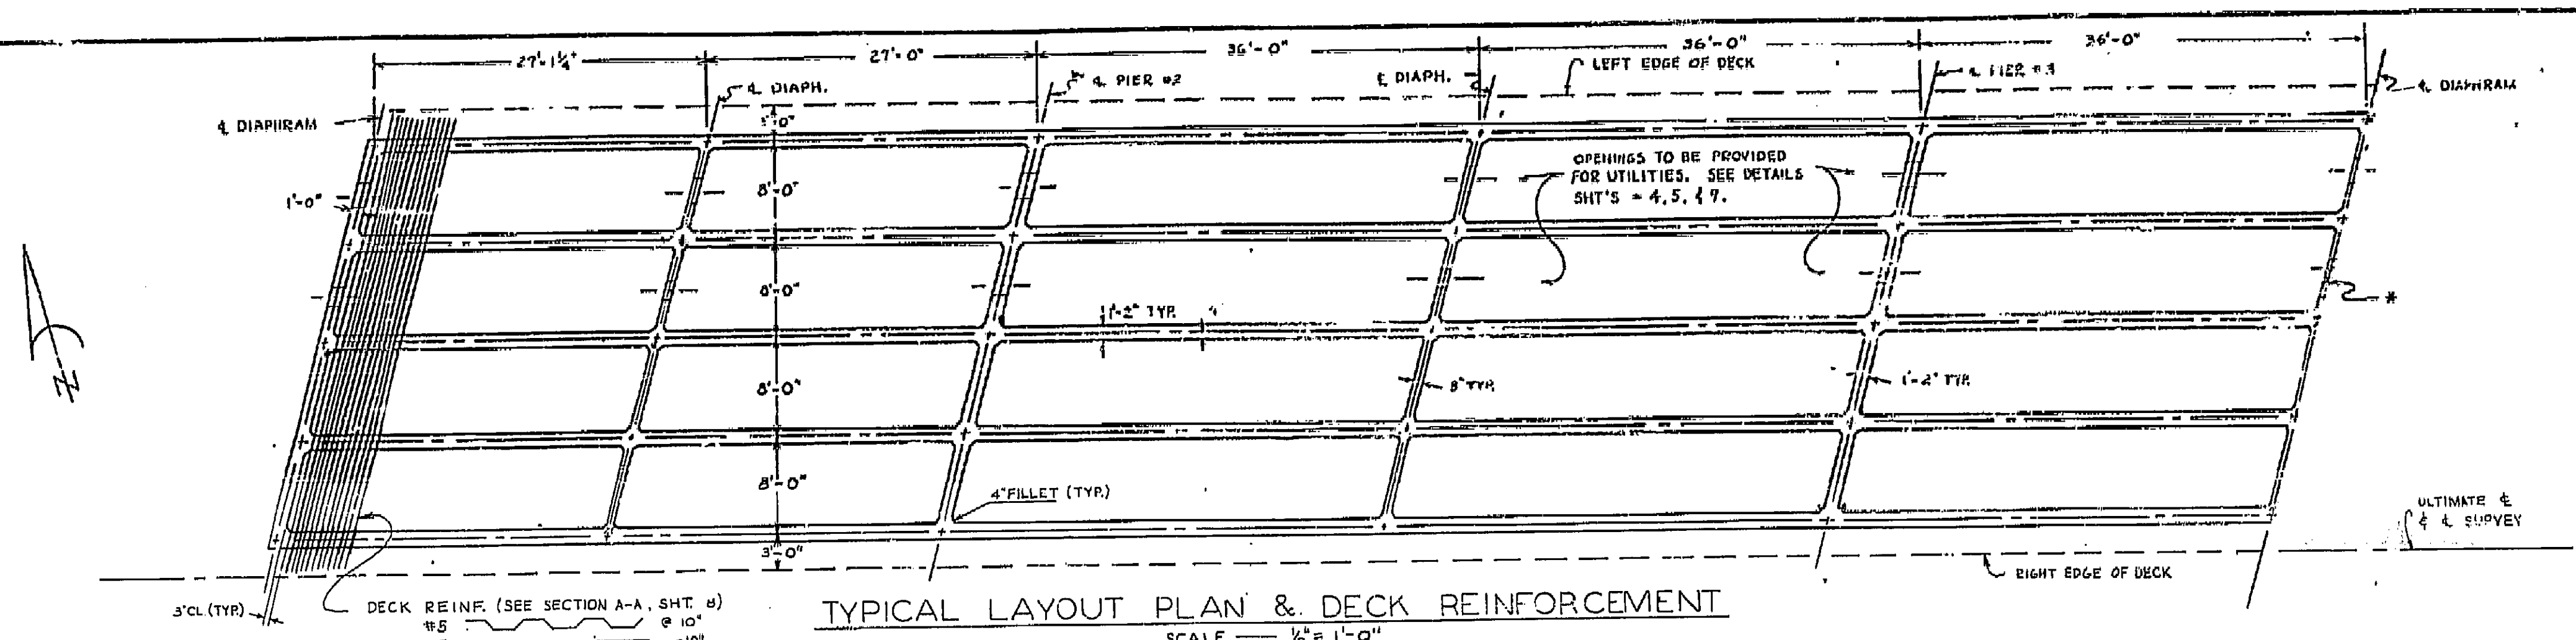


TYPICAL LAYOUT PLAN & DECK REINFORCEMENT  
SCALE  $\frac{1}{8}'' = 1'-0''$   
W'LY HALF SHOWN E'LY HALF SYMMETRICAL.

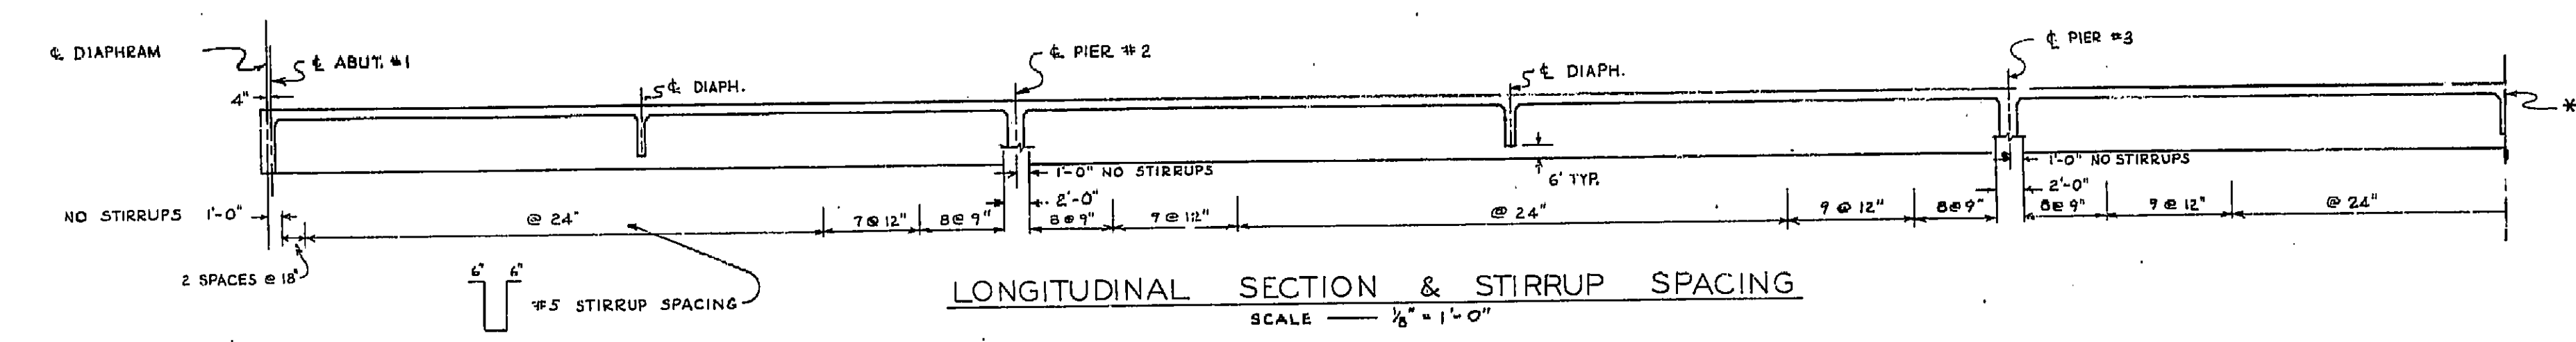


LONGITUDINAL SECTION & STIRRUP SPACING  
SCALE  $\frac{1}{8}'' = 1'-0''$


LINE OF SYMMETRY &  
OF DIAPHRAGM

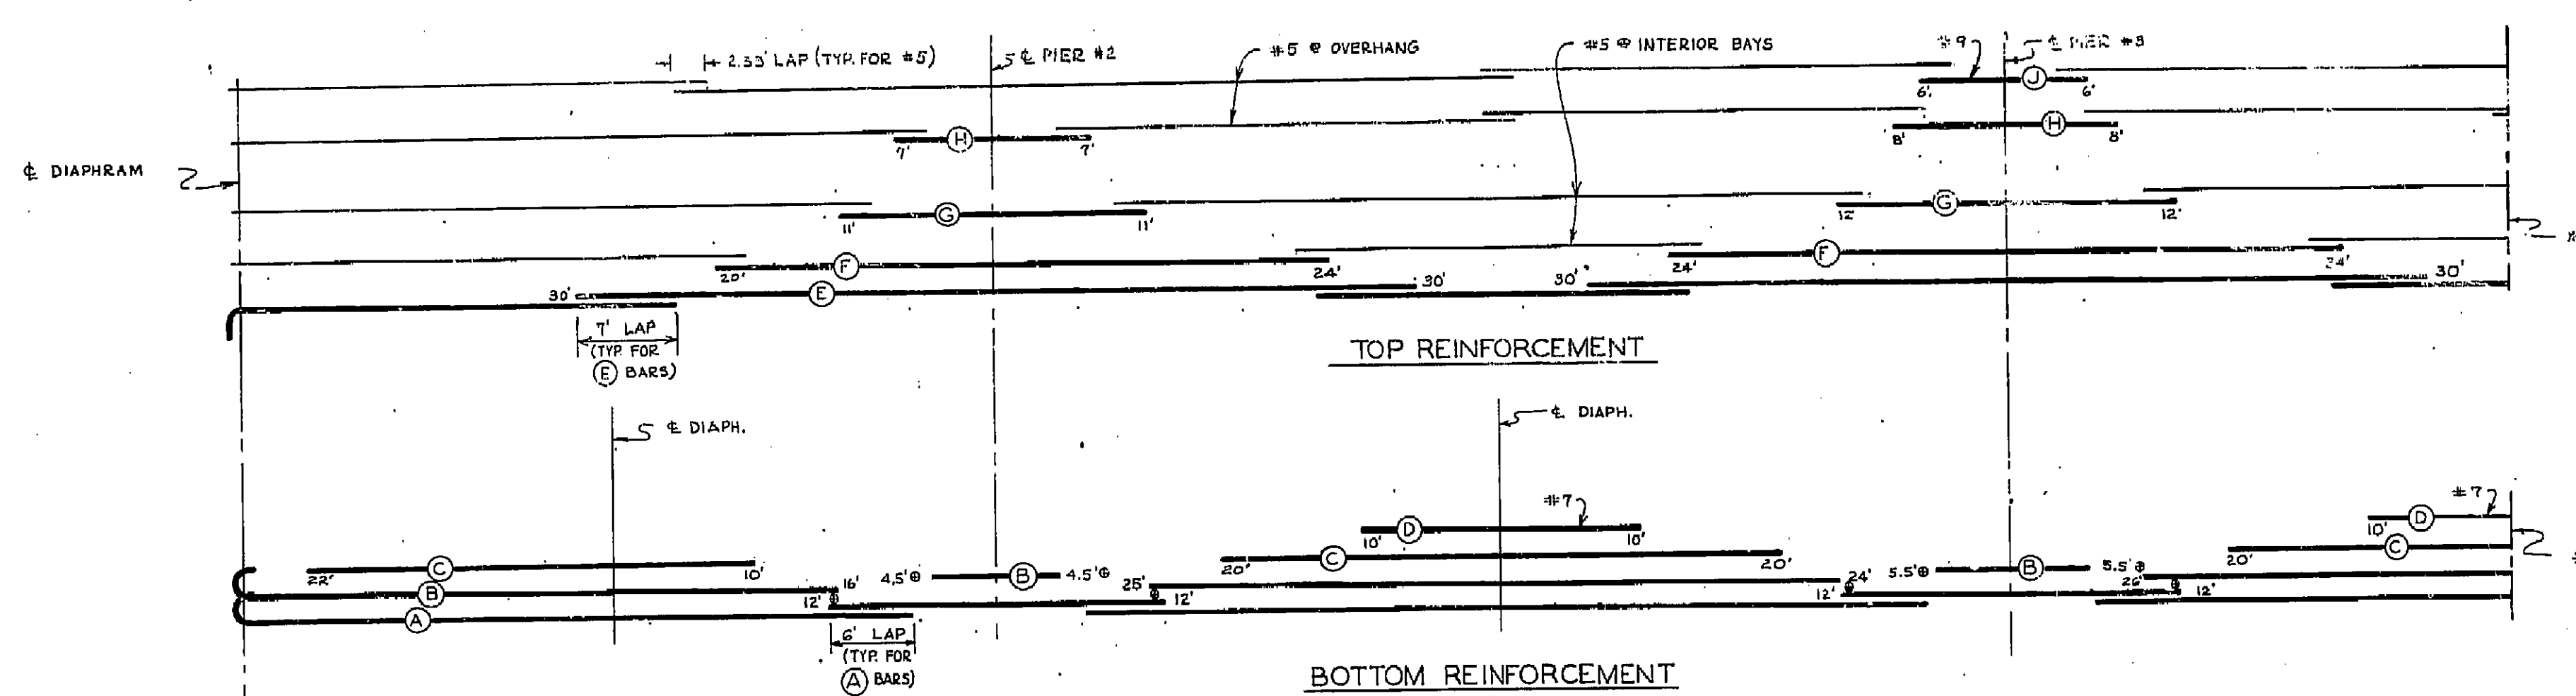

GIRDER REINFORCEMENT  
SCALE  $\frac{1}{8}'' = 1'-0''$

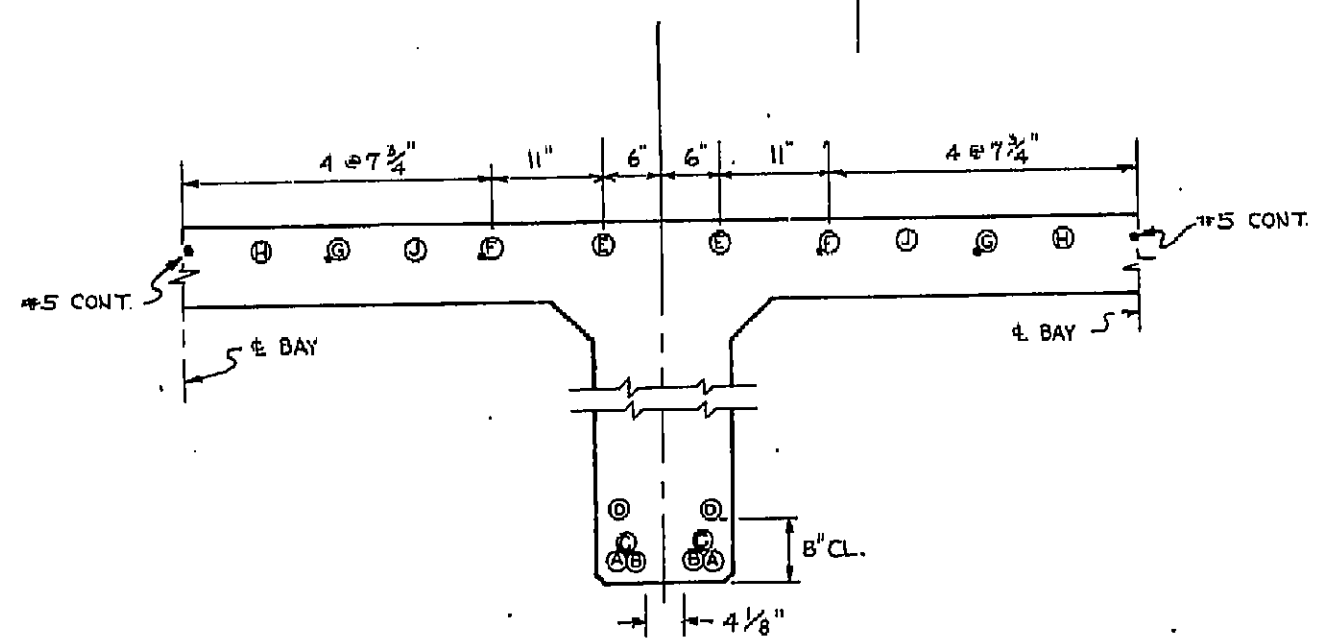


INTERIOR GIRDER REINFORCEMENT  
PLACING DIAGRAM

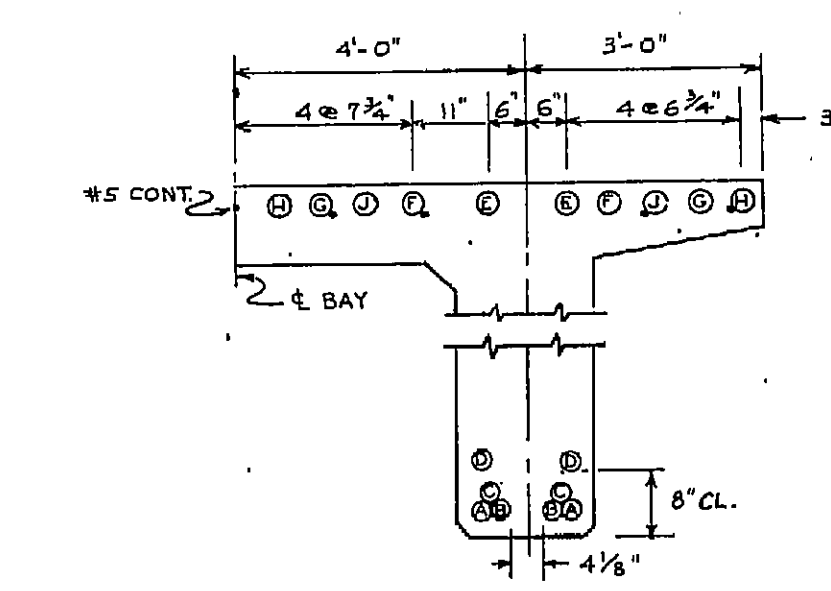

EXTERIOR GIRDER REINFORCEMENT  
PLACING DIAGRAM

- NOTES:
- 1) ALL MAIN GIRDER REINFORCEMENT IS #11 BARS EXCEPT AS NOTED.
  - 2) DIM. AT END OF BARS ARE FROM CENTERLINE OF DIAPHRAGM (BOT. REINFORCEMENT) AND CENTERLINE OF PIERS (TOP REINFORCEMENT), EXCEPT AS NOTED.
  - 3) FOR ADDITIONAL REINFORCEMENT IN SLAB OVER INTERMEDIATE DIAPHRAGMS SEE SHEET # 9.
  - 4) THIS BOT. REINFORCEMENT BAR IS DIM. FROM CENTERLINE OF PIER.
  - 5) GIRDER REINFORCEMENT SHOWN ABOVE SHALL BE PLACED AS SHOWN IN THE PLACING DIAGRAMS.

AS BUILT  
Control No. 2244-1111  
Date Completed  
Document No. 1000-8277



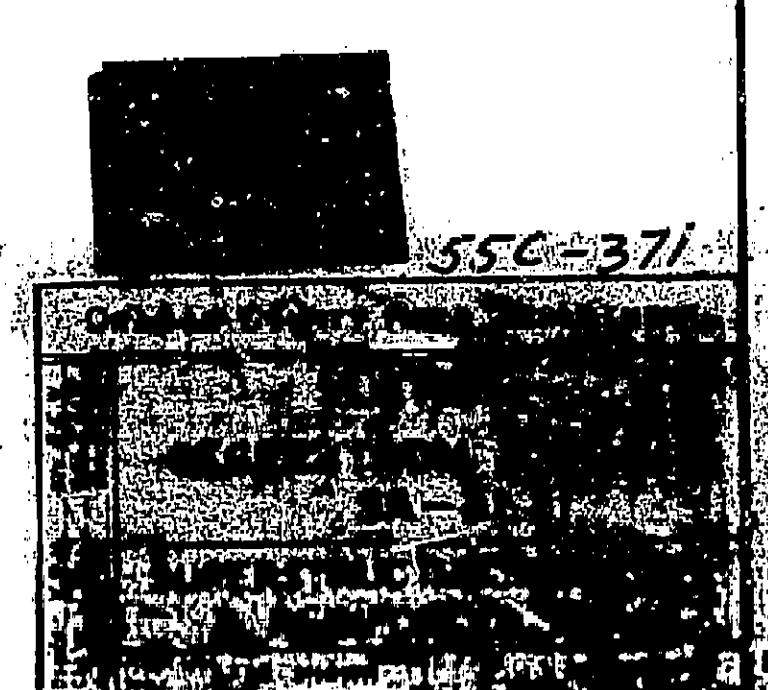


DR. 12 (11359)

I HEREBY CERTIFY THAT THIS IS A TRUE AND ACCURATE COPY OF THE ABOVE DOCUMENT TAKEN UNDER MY DIRECTION AND CONTROL ON THIS DATE IN SACRAMENTO, CALIFORNIA PURSUANT TO AUTHORIZATION BY THE DIRECTOR OF TRANSPORTATION.

DATE 10/10/79 BY Joseph M. Smith SUPERVISOR OF HIGHWAYS



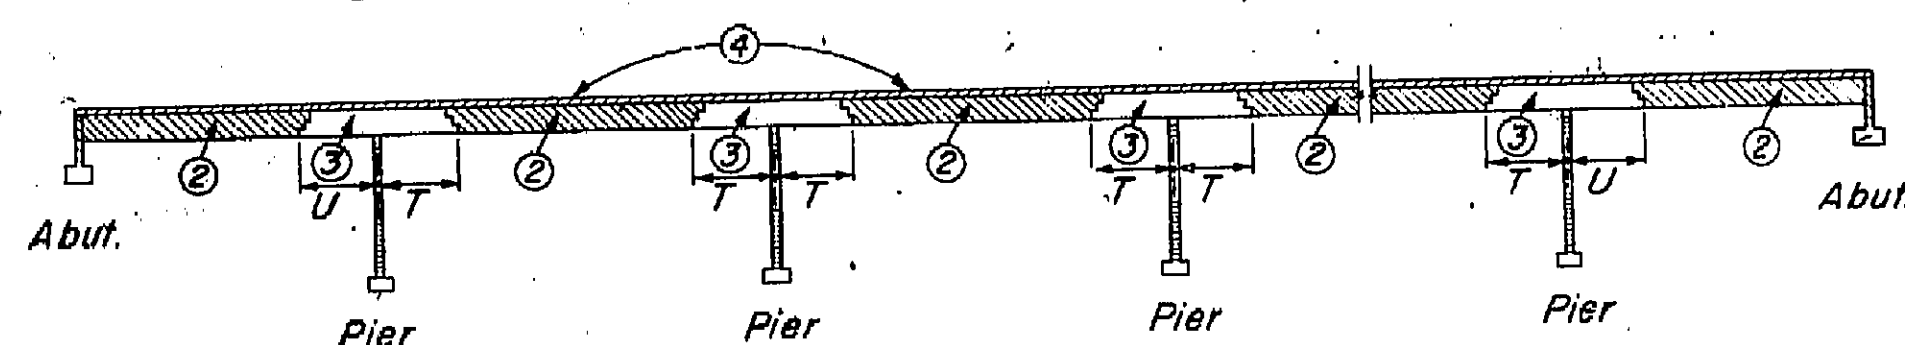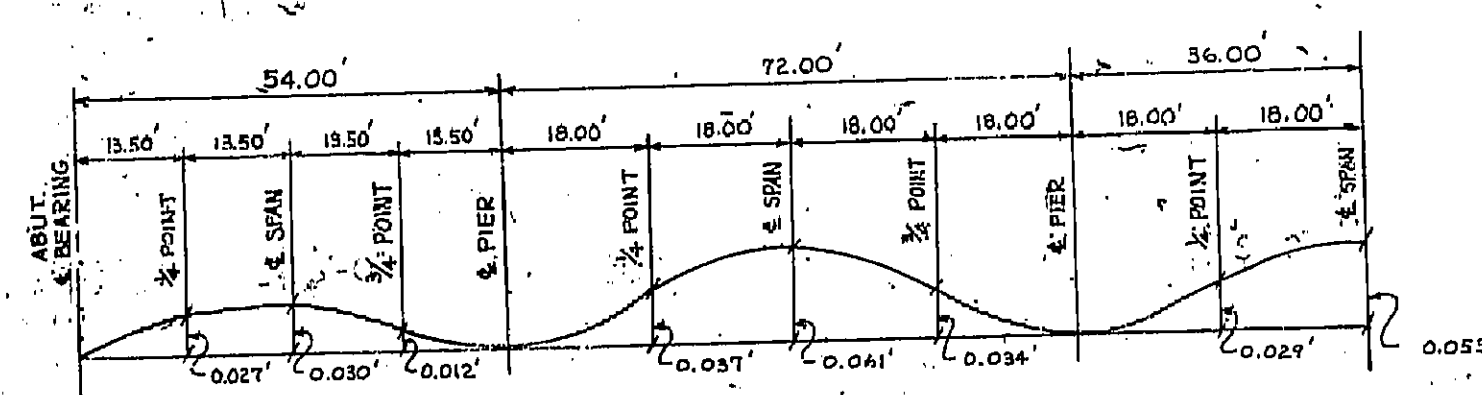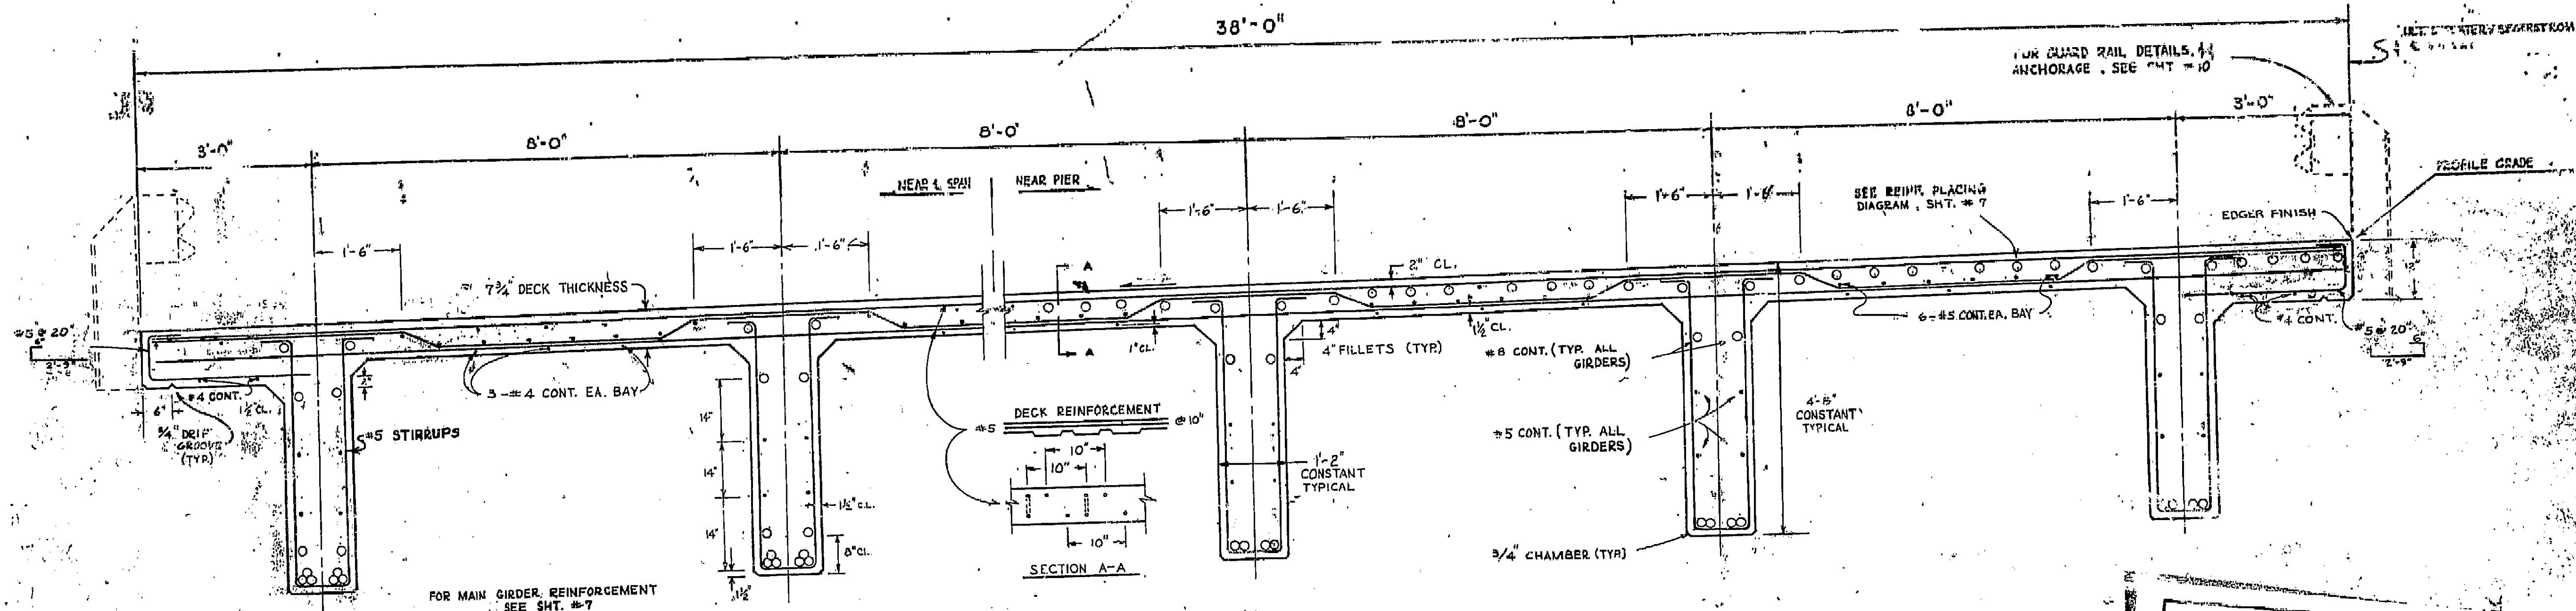

### TEE BEAM SUPERSTRUCTURE PLACING DIAGRAM

Numbers (2) and (3) indicate sequence of placing girder stem concrete. (3) may be placed simultaneously with (2) when approved by the Engineer, and provided that the (2) sections are placed in both adjoining spans.

Top slab concrete (4) shall be placed separately from (2) and (3). (4) may be placed continuously or in parts as approved by the Engineer.

$T = 1/5$  span length

$U = 1/4$  span length

For any deviation from the above the contractor shall submit a diagram to the Engineer.

### TYPICAL SECTION

SCALE:  $3/4" = 1'-0"$

**AS BUILT PLANS**  
Contract No. 44K-1004  
Date Completed 10/00  
Document No. 8271

### GENERAL NOTES

#### SPECIFICATIONS:

Design: A.A.S.H.O. dated 1971 with subsequent revisions, and Calif. Division of Highways Bridge Planning and Design manual.

Construction: Standard Specifications, Division of Highways, Calif. dated Jan. 1973 and the special provisions.

LIVE LOADING: HS20-44 and Alternative

#### UNIT STRESSES:

Reinforcing Steel:  $f_t$  tension = 24,000 p.s.i.; 20,000 p.s.i. in slab and web reinforcement.

Concrete:  $f_c = 1,300$  p.s.i.,  $f'_c = 3250$  p.s.i. = 28 days.  
 $n = 10$   
 $v_c = 90$  p.s.i.

PILE LOADING: Type: Class 70

CONCRETE: Class "A" using type II portland cement

556-371

ORANGE COUNTY ROAD DEPARTMENT

SLATER-SEGERSTROM BRIDGE

SA-31

TYPICAL SECTION


AS SHOWN

DR. 12 (11359)

I HEREBY CERTIFY THAT THIS IS A TRUE AND ACCURATE COPY OF THE ABOVE DOCUMENT TAKEN UNDER MY DIRECTION AND CONTROL ON THIS DATE IN SACRAMENTO, CALIFORNIA PURSUANT TO AUTHORIZATION BY THE DIRECTOR OF TRANSPORTATION.

DATE 10/10/77 BY Joseph M. Costa TITLE Supervisor of Highways





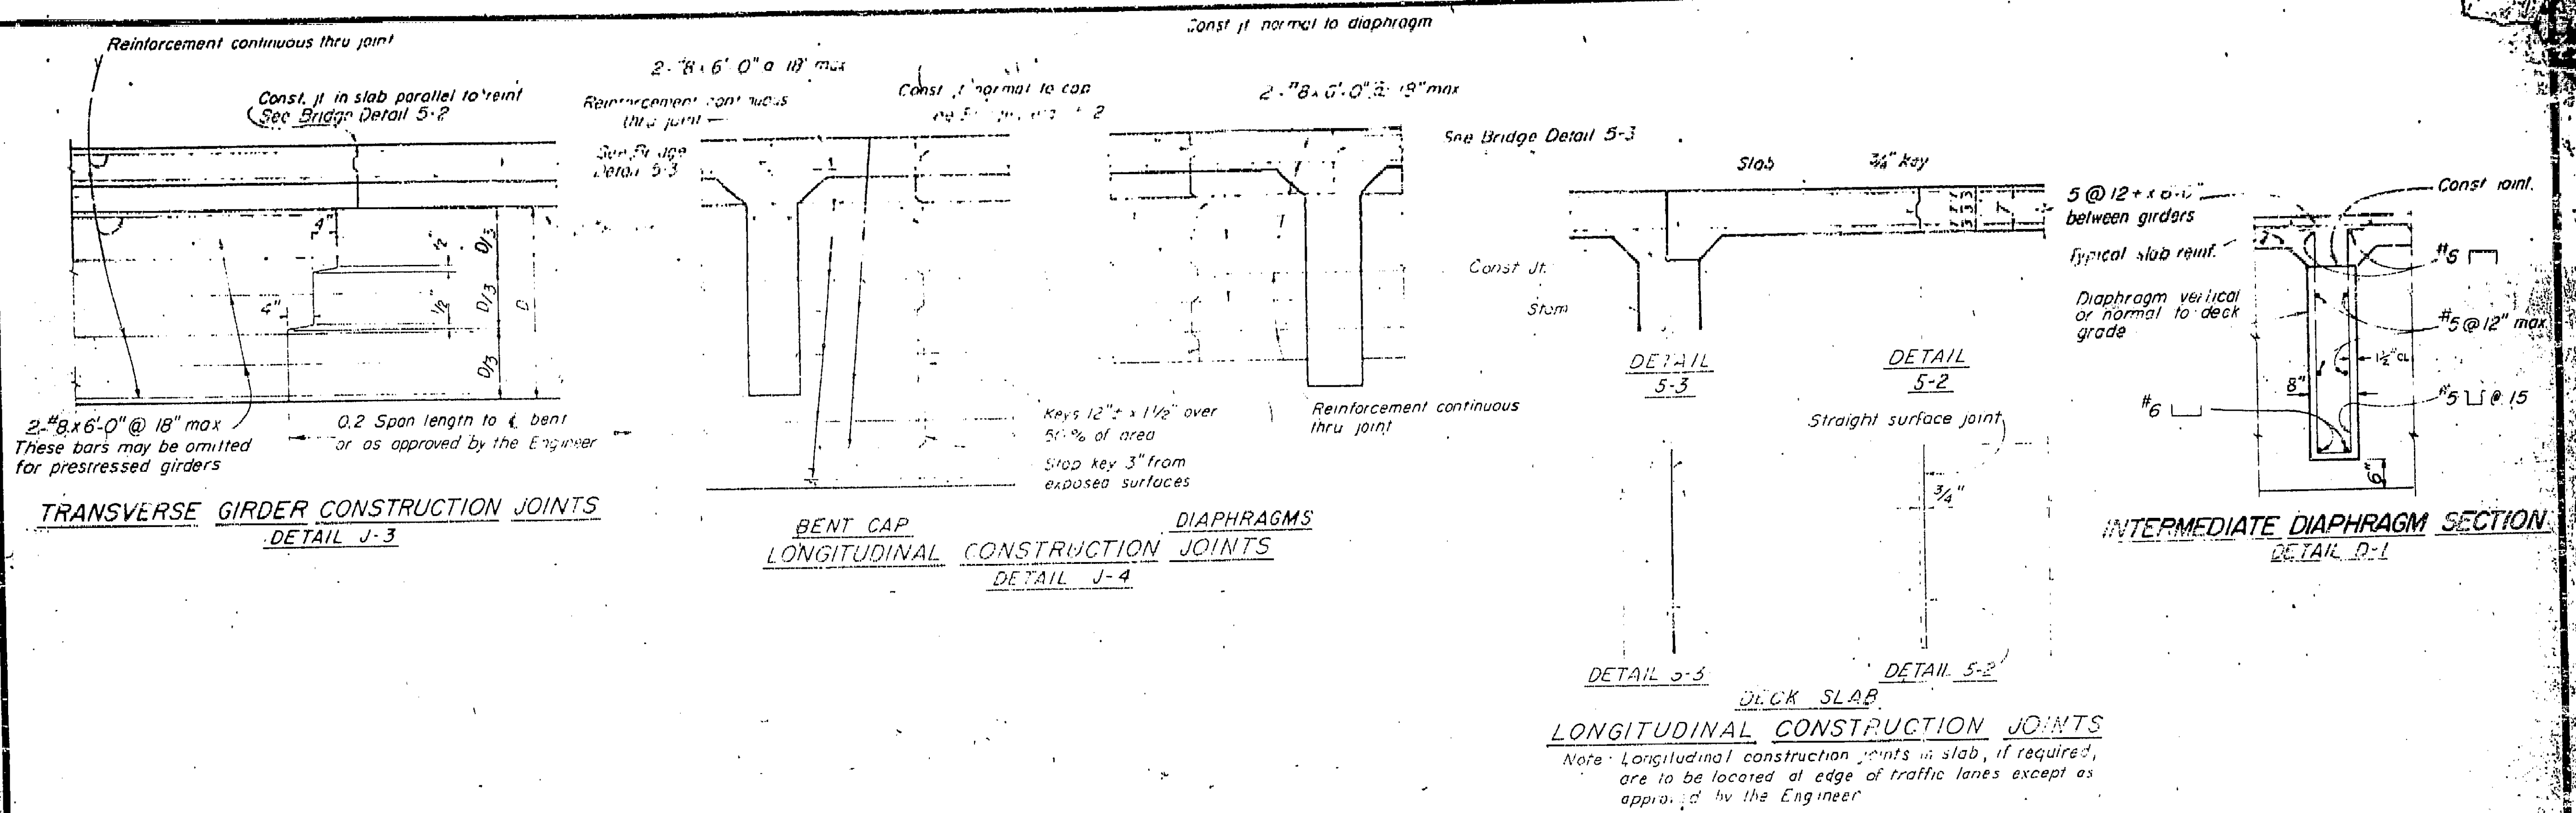

**AS BUILT PLANS**  
 Contract No. UNKNOWN  
 Date Completed 10/10/79  
 Document No. 1000 8277

**NOTES**

- (1) As reinforcement detailed to be shown in location to reinforcement shown on other detail.
- (2) Shading are same size as of agent shown on other detail.

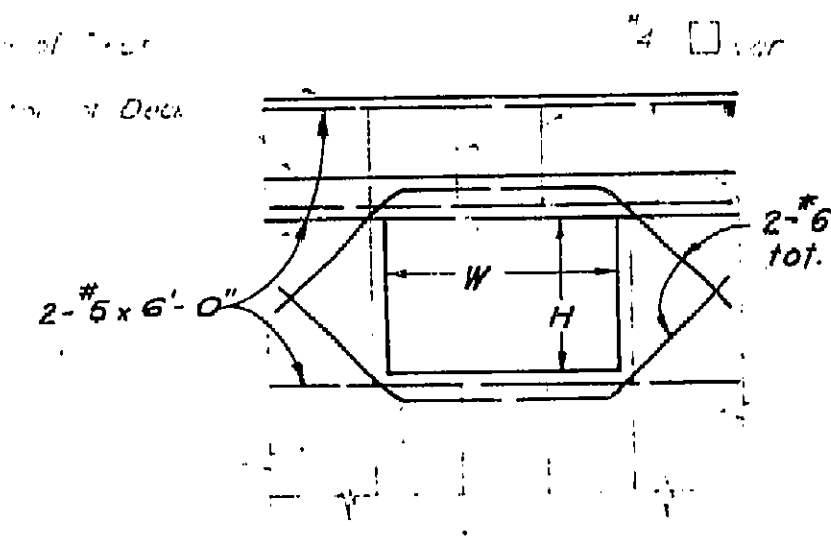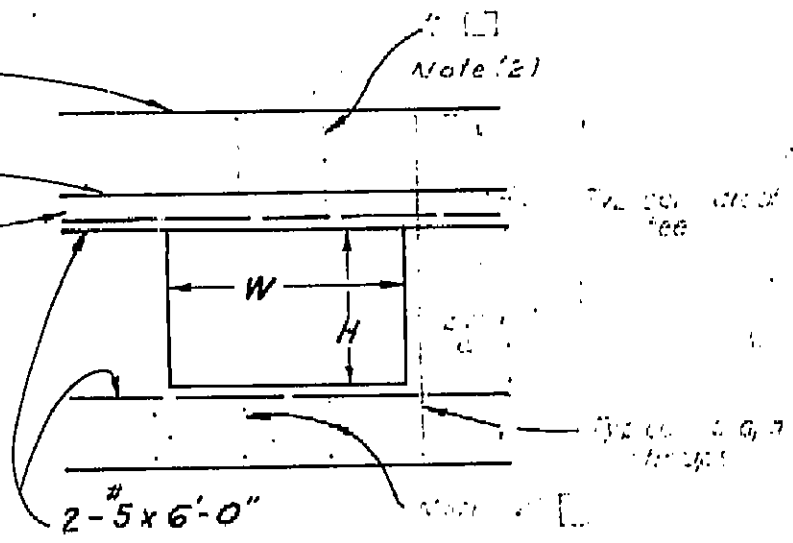

**OPENING DETAILS**

55C-371

ORANGE COUNTY ROAD DEPARTMENT

SLATER-  
SEGERSTROM BRIDGE  
SA-31  
MISCELLANEOUS DETAILS  
TEEL BEAM


NO SCALE

SHEET 6 OF 18

DR. 12 (11359)



I HEREBY CERTIFY THAT THIS IS A TRUE AND ACCURATE COPY OF THE ABOVE DOCUMENT TAKEN UNDER MY DIRECTION AND CONTROL ON THIS DATE IN SACRAMENTO, CALIFORNIA PURSUANT TO AUTHORIZATION BY THE DIRECTOR OF TRANSPORTATION.

Date: 10/10/79 Signature: [Signature] Title: Supervisor of Highways

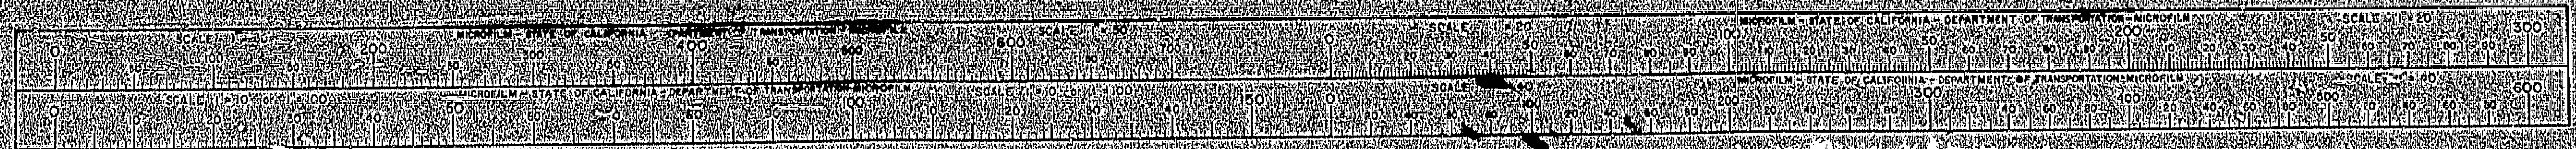

# SLATER-SEGERSTROM BRIDGE

**AS BUILT PLANS**  
 Contract No. 2-111-1111  
 Date Completed 11/11/11  
 Document No. 1111-1111

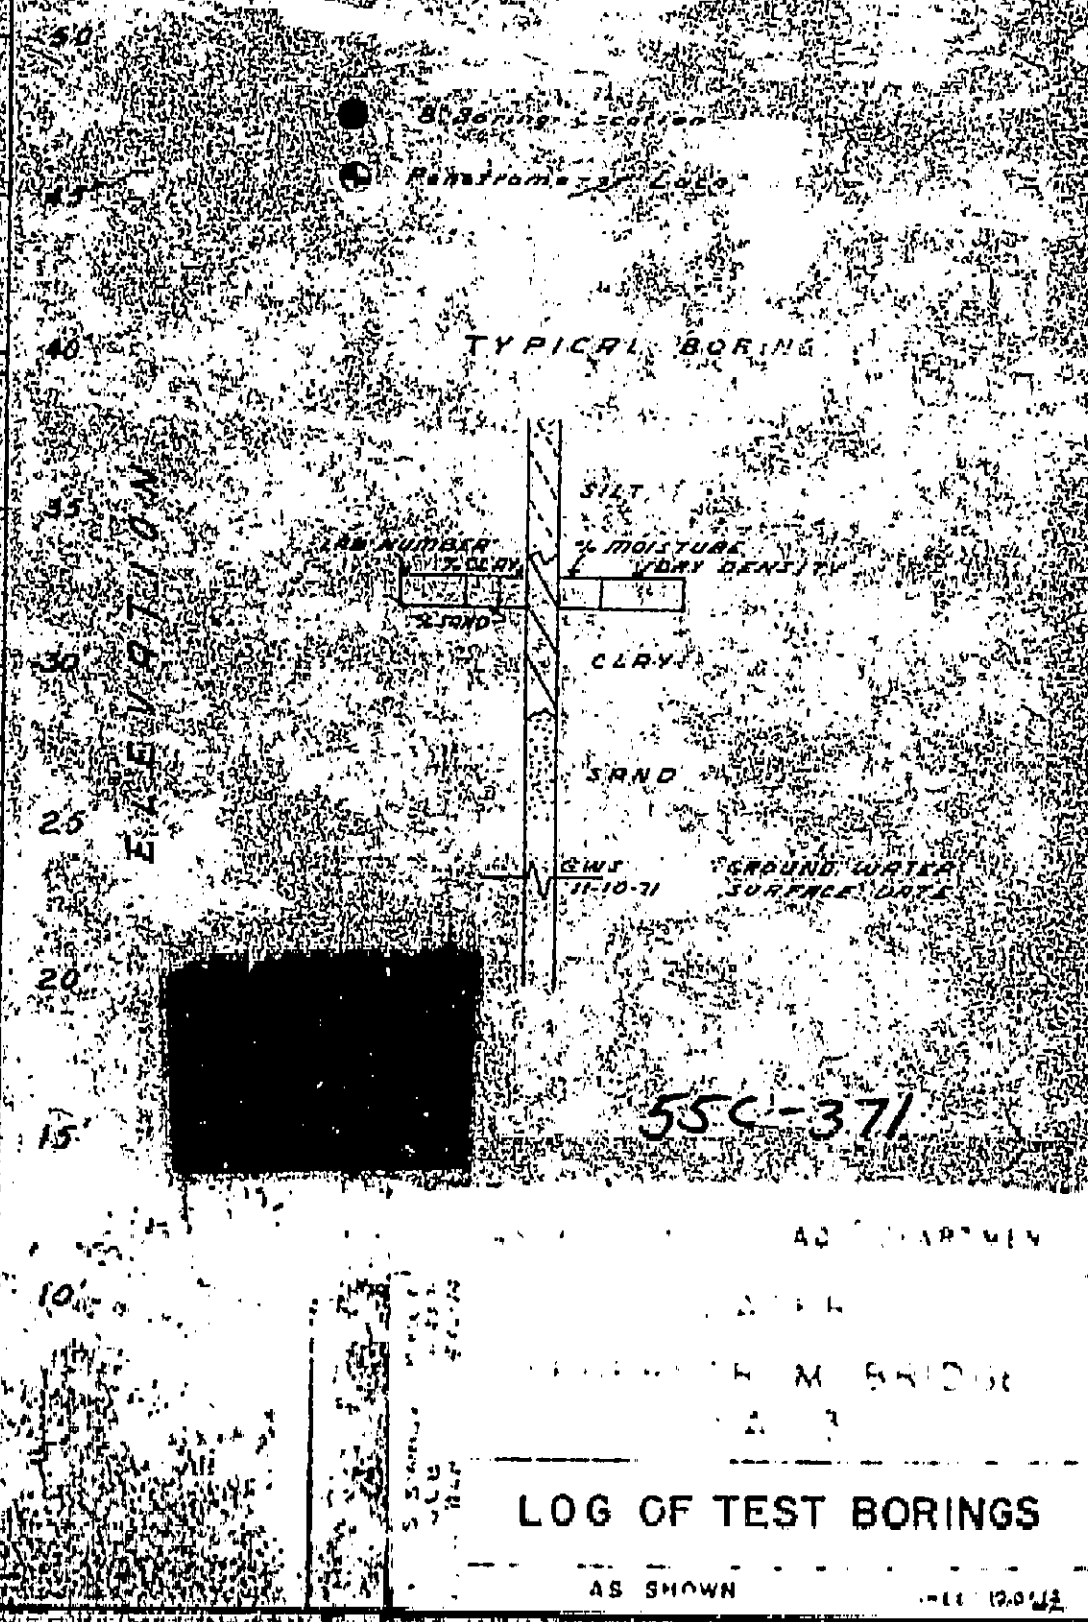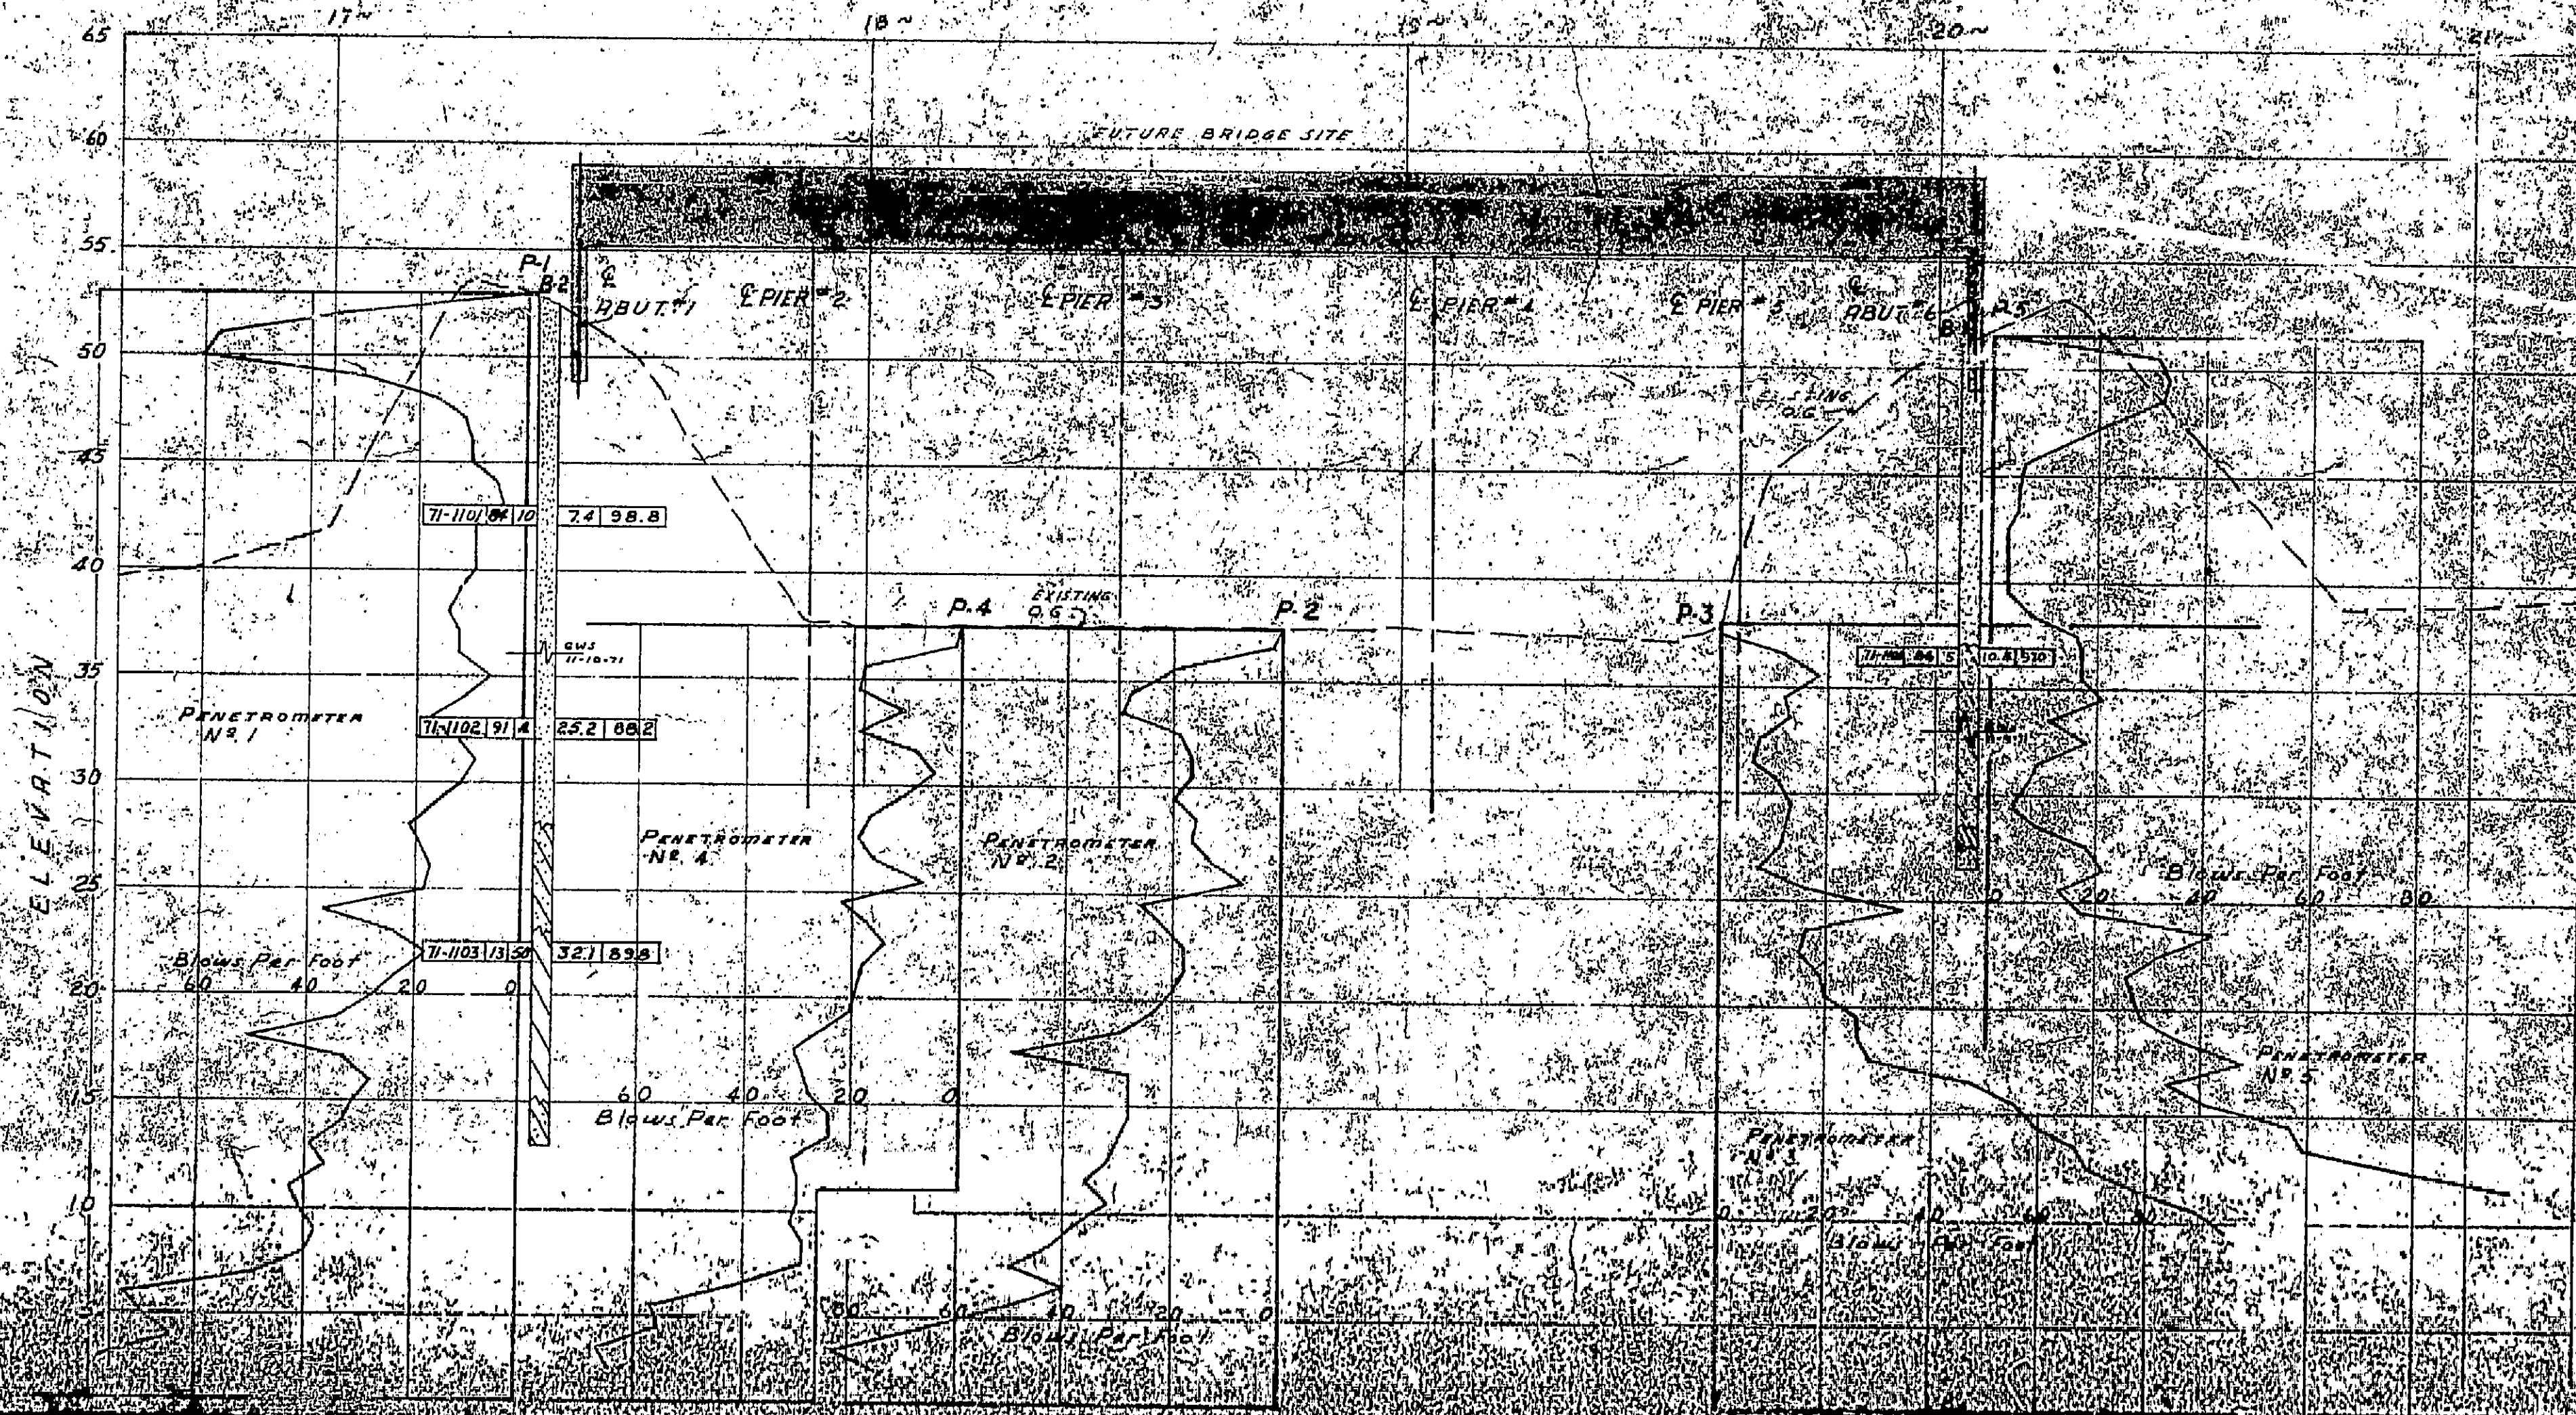

AS SHOWN 11/11/11

11/11/11

11/11/11

11/11/11


11/11/11

11/11/11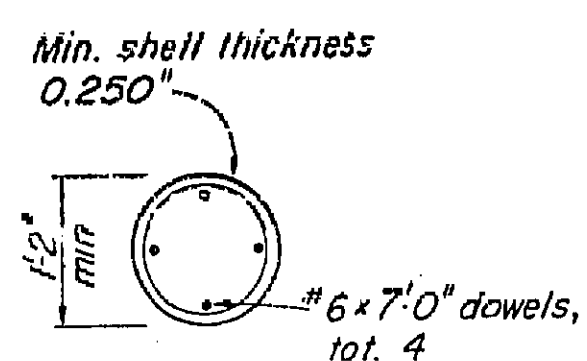


SECTION U-U

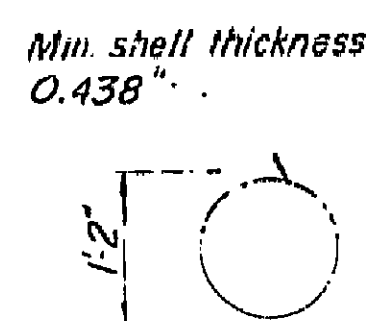

SECTION W-W

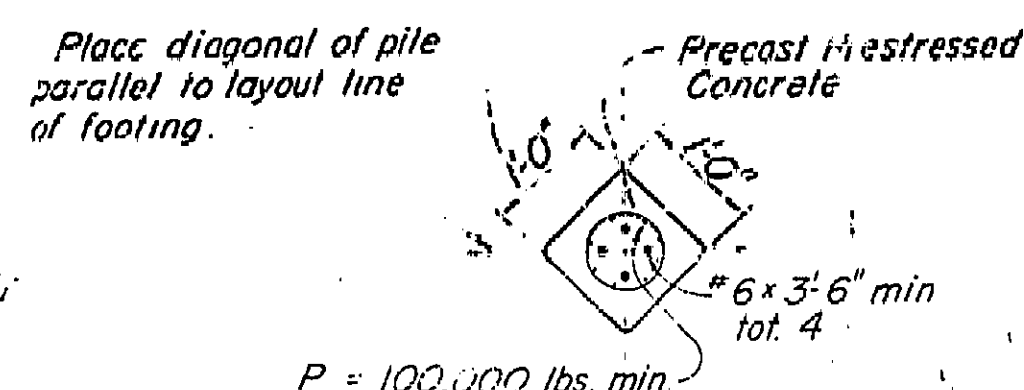


SECTION X-X

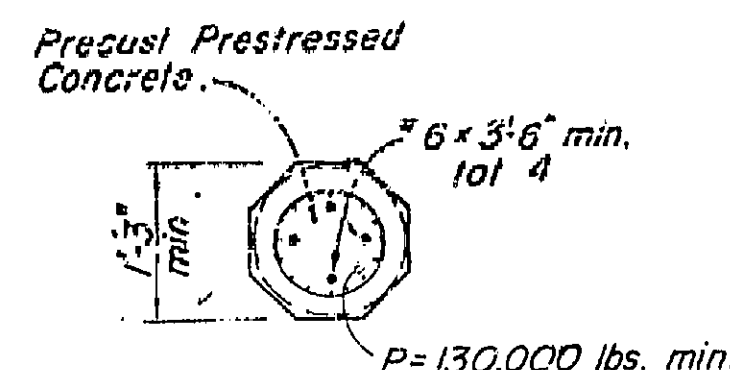

SECTION Y-Y




SECTION Z-Z

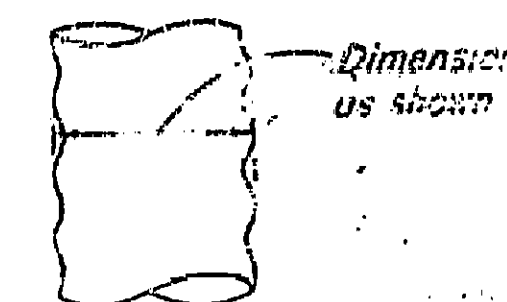


CORRUGATED ALTERNATIVE "Z"


NOTE:  
When Alternative "U" is driven with mandrel, shell thickness may be reduced to 0.134.

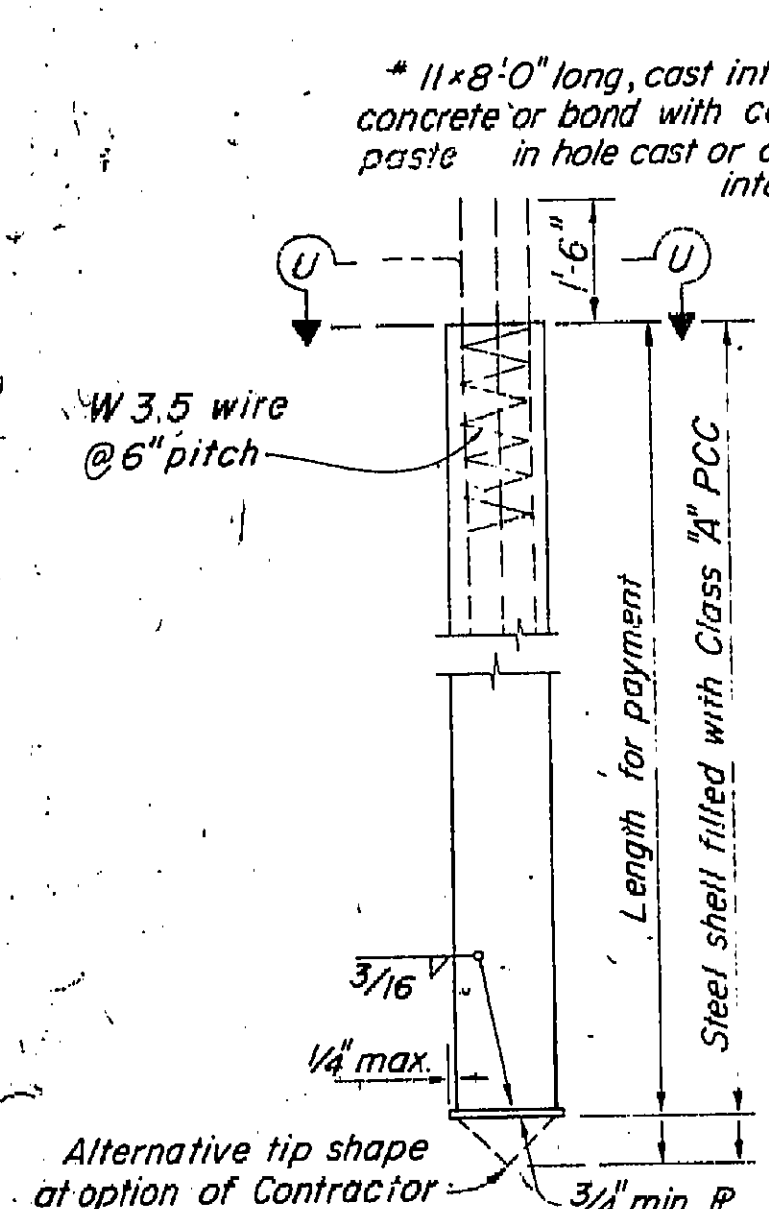


ALTERNATIVE "U"

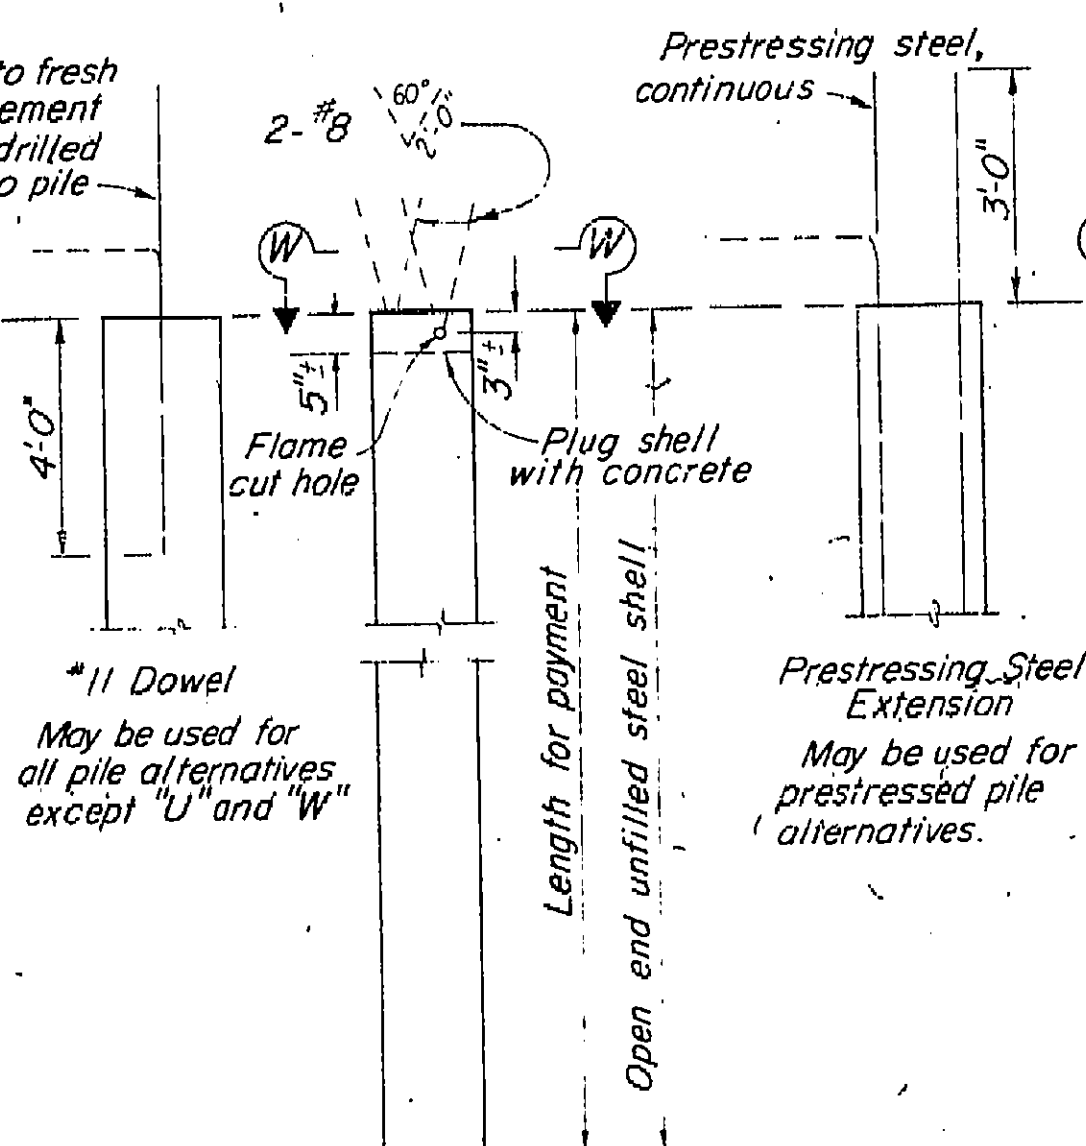


ALTERNATIVE "W"

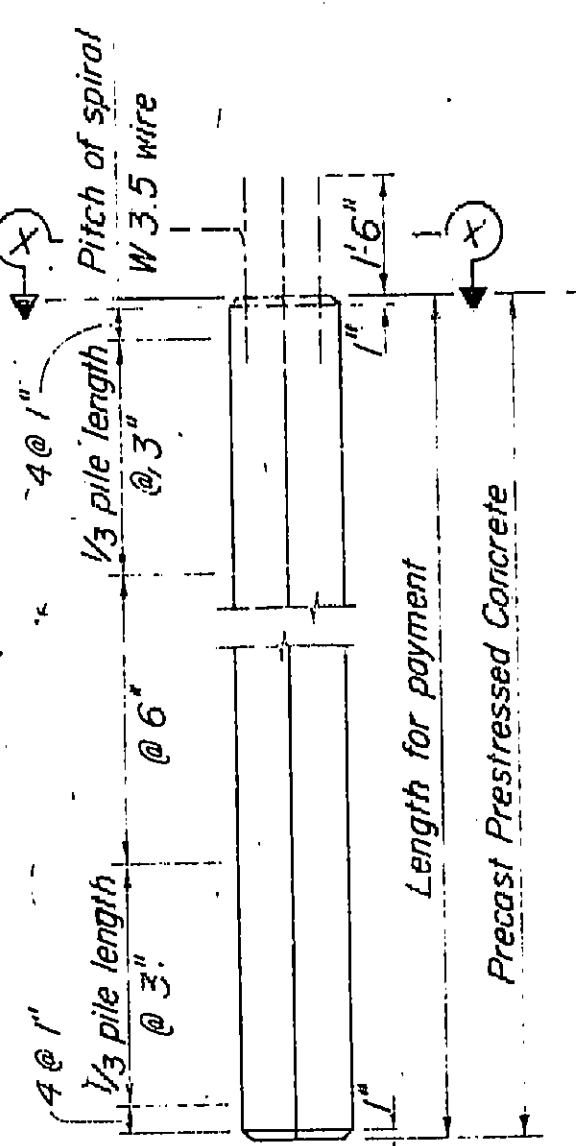

ALTERNATIVE "X"

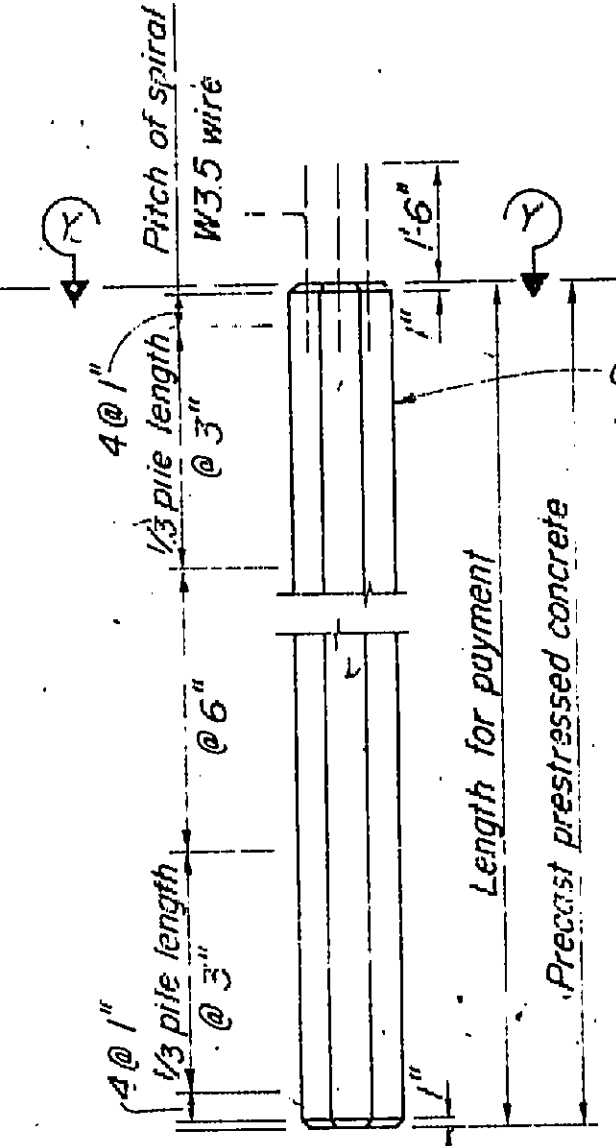

ALTERNATIVE "Y"

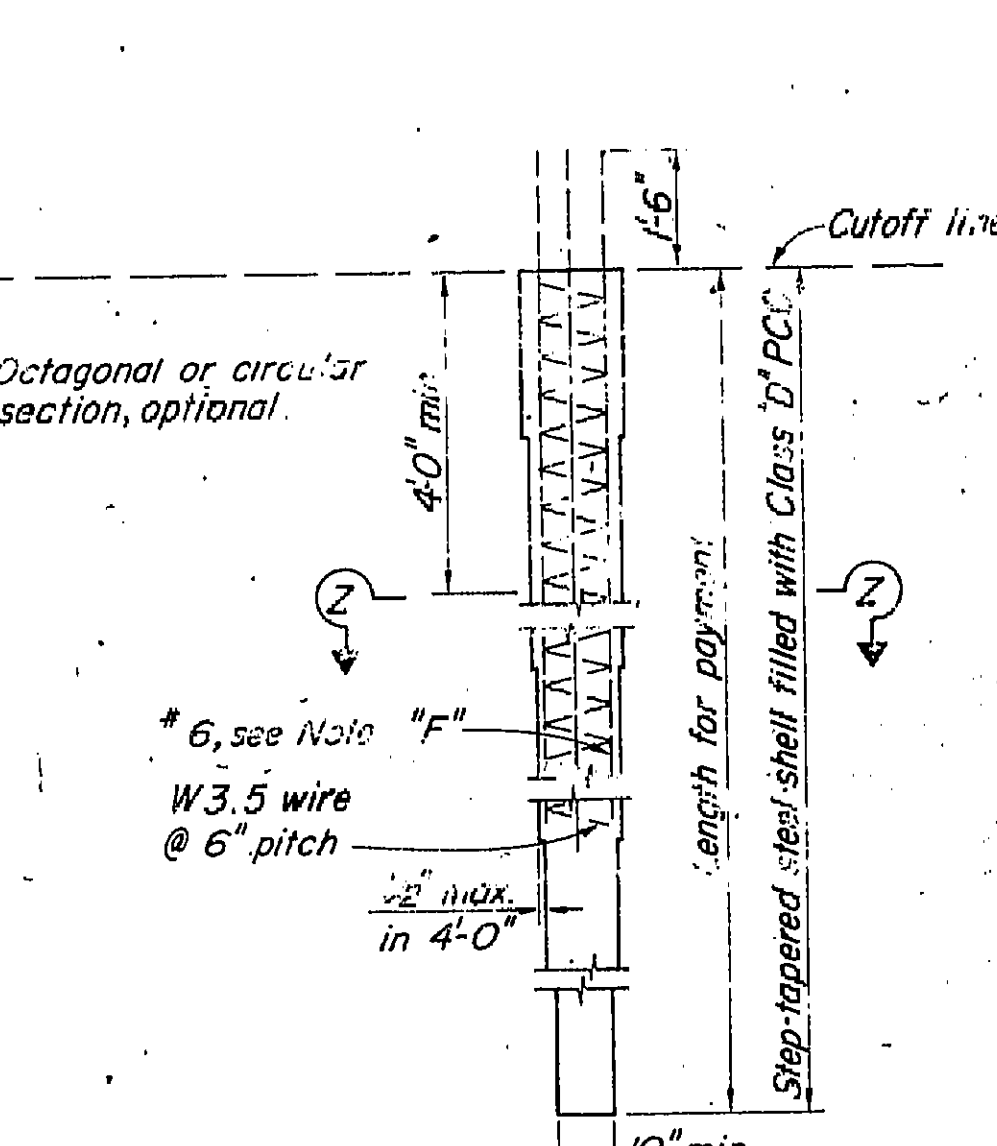

ALTERNATIVE "Z"

A 10" minimum diameter pipe extension (thickness = 0.250" min.) may be used at the tip of Alternative "Z" when taper is 30° or more in length.

AS BUILT PLANS  
Contract No. UNKNOWN  
Date Completed 7/10/77  
Document No. 7000 8277

PRECAST PRESTRESSED PILES:

P = Prestressing Force (After losses)  
If section used is larger than the min. section shown, then "P" shall provide 700 psi min.  
Concrete strength:  $f'_c$  @ 28 days = 6,000 psi (Alternative "X")  
5,000 psi (Alternative "Y")

All dowels or bars extending into slab or footing having a depth less than 2'-0" shall be hooked.

NOTE: "F"

- In ALTERNATIVE "Z" the No. 6 bars shall extend to:
- Bottom of pile for bridges over water courses.
  - 12'-0" below the lowest of the following for bridges not over water courses.
    - Bottom of footing.
    - Top of final ground surface.
    - Top of original ground surface when holes are drilled through embankment constructed by Contractor.
    - Bottom of pre-drilled holes greater than pile diameter.

DESIGN LOADING = 70 TONS


556-371

ORANGE COUNTY ROAD DEPARTMENT  
SLATER  
SEGERSTROM BRIDGE  
SA-31  
PILING DETAILS

DR-12 (1135)

I HEREBY CERTIFY THAT THIS IS A TRUE AND ACCURATE COPY OF THE ABOVE DOCUMENT TAKEN UNDER MY SUPERVISION AND CONTROL ON THIS DATE IN SACRAMENTO, CALIFORNIA PURSUANT TO AUTHORIZATION BY THE DIRECTOR OF TRANSPORTATION  
10/10/79  
Supervisor of Highways



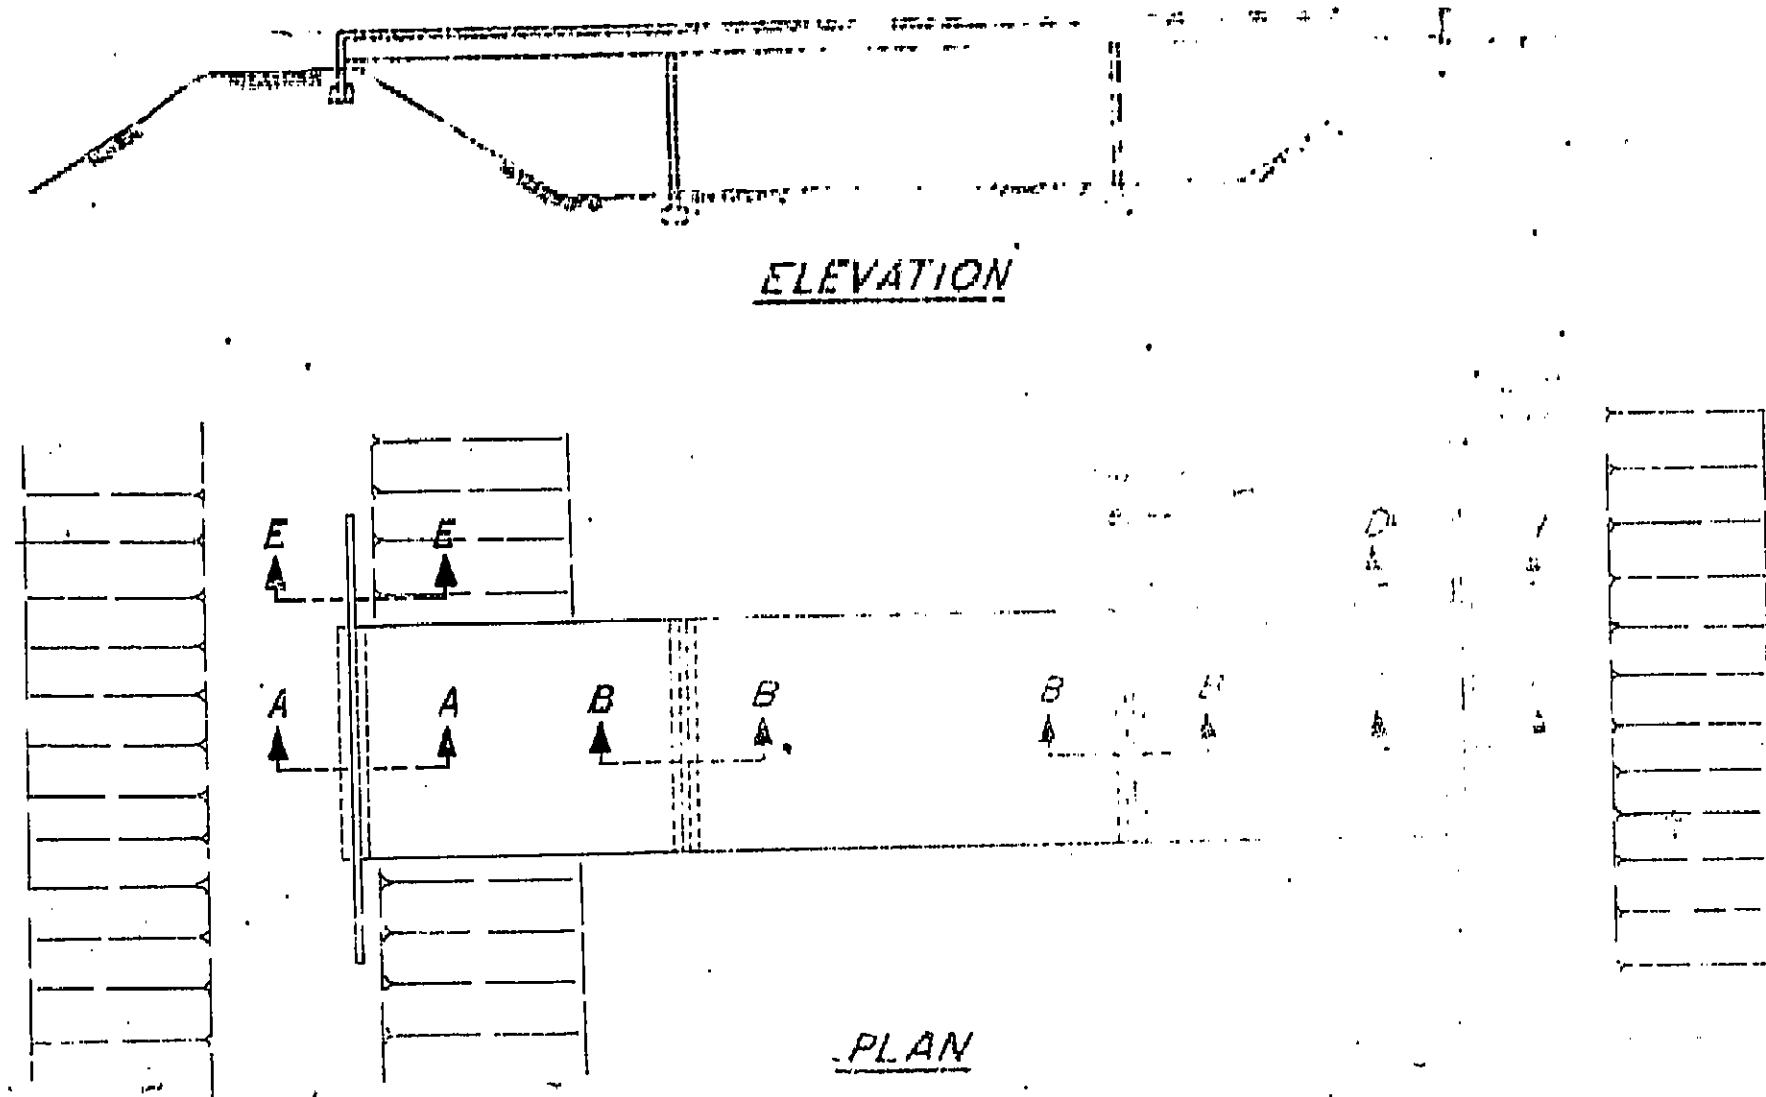

EXCAVATION

BACKFILL

SECTION A-A  
ABUTMENT #1

BACKFILL

SECTION C-C  
ABUTMENT #6

EXCAVATION

BACKFILL


SECTION E-E  
WINGWALLS @ ABUTMENT #1

BACKFILL


SECTION D-D  
WINGWALLS @ ABUTMENT #6

LEGEND  
STRUCTURE EXCAVATION  
STRUCTURE BACKFILL  
4" x 4" x 1/2" x 1/2"

STRUCTURE EXCAVATION &  
BACKFILL DETAILS

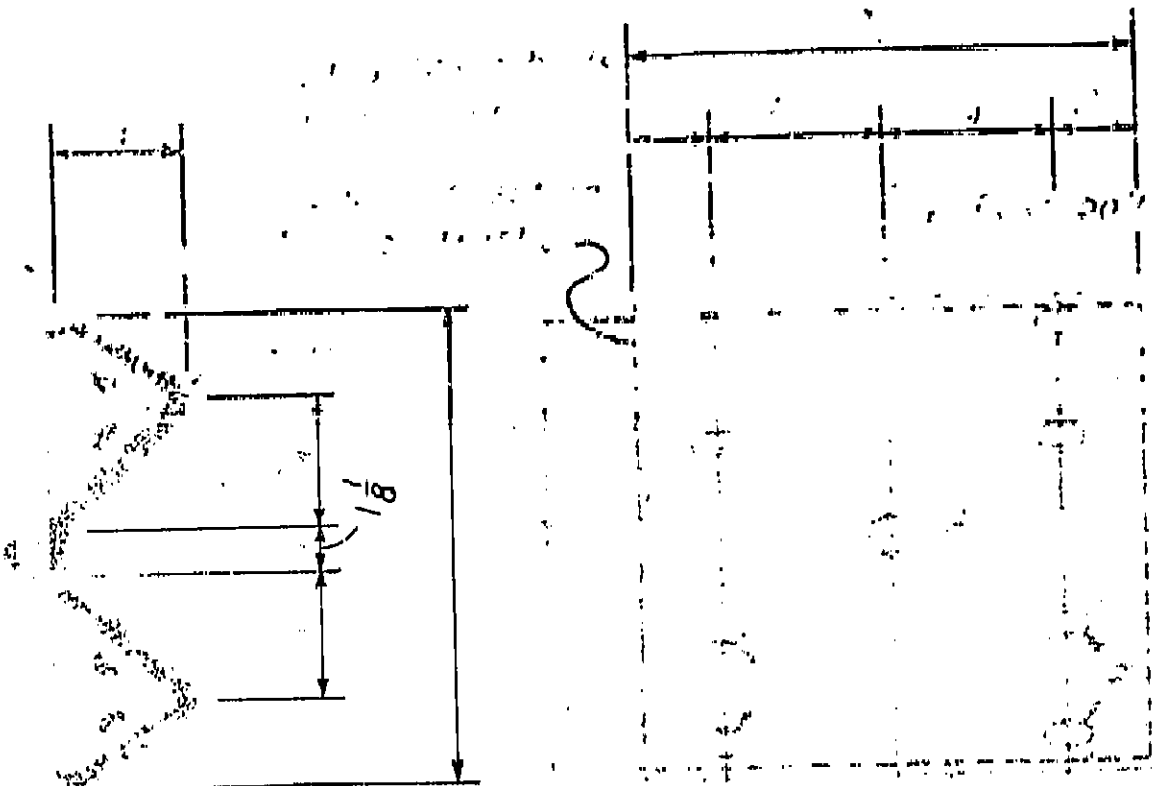

Note: 8"x8"x1'-2" Block not shown.

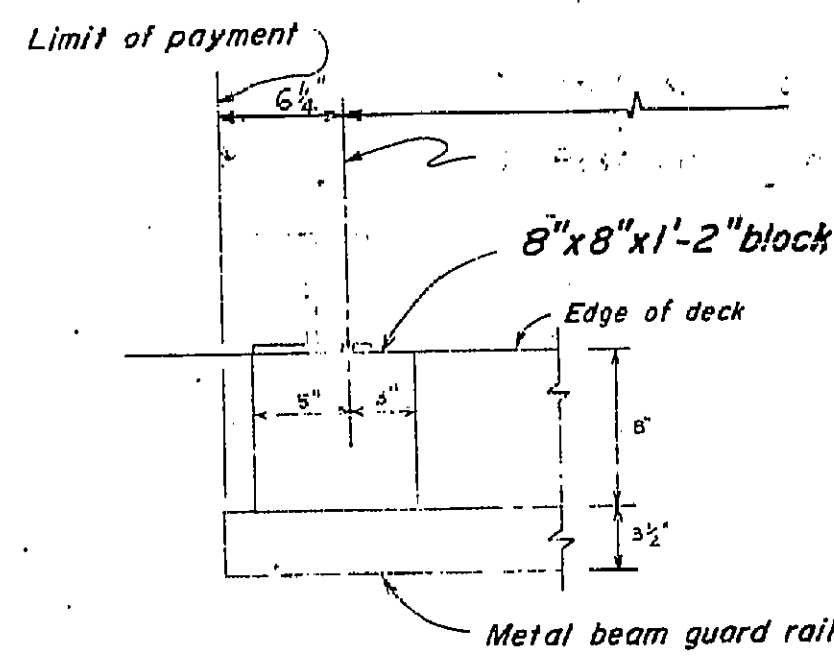


PLAN

Notes

At rail splice nearest expansion joint in bridge deck, slot holes in movable section of rail to allow same amount of movement as is provided in bridge deck. Place 1/2" asbestos sheet packing between rail elements. Adjust bolts to provide sliding fit and set threads.

Posts shall be vertical. Contractor to provide galvanized metal shims to align posts. Galvanize rail assembly after fabrication. Space posts to provide 1'-6" min. clear between expansion joints and E of post.

Stud bolt nuts shall be torqued to 175 ft-lbs. Anchor bolt nuts shall be wrench tight.

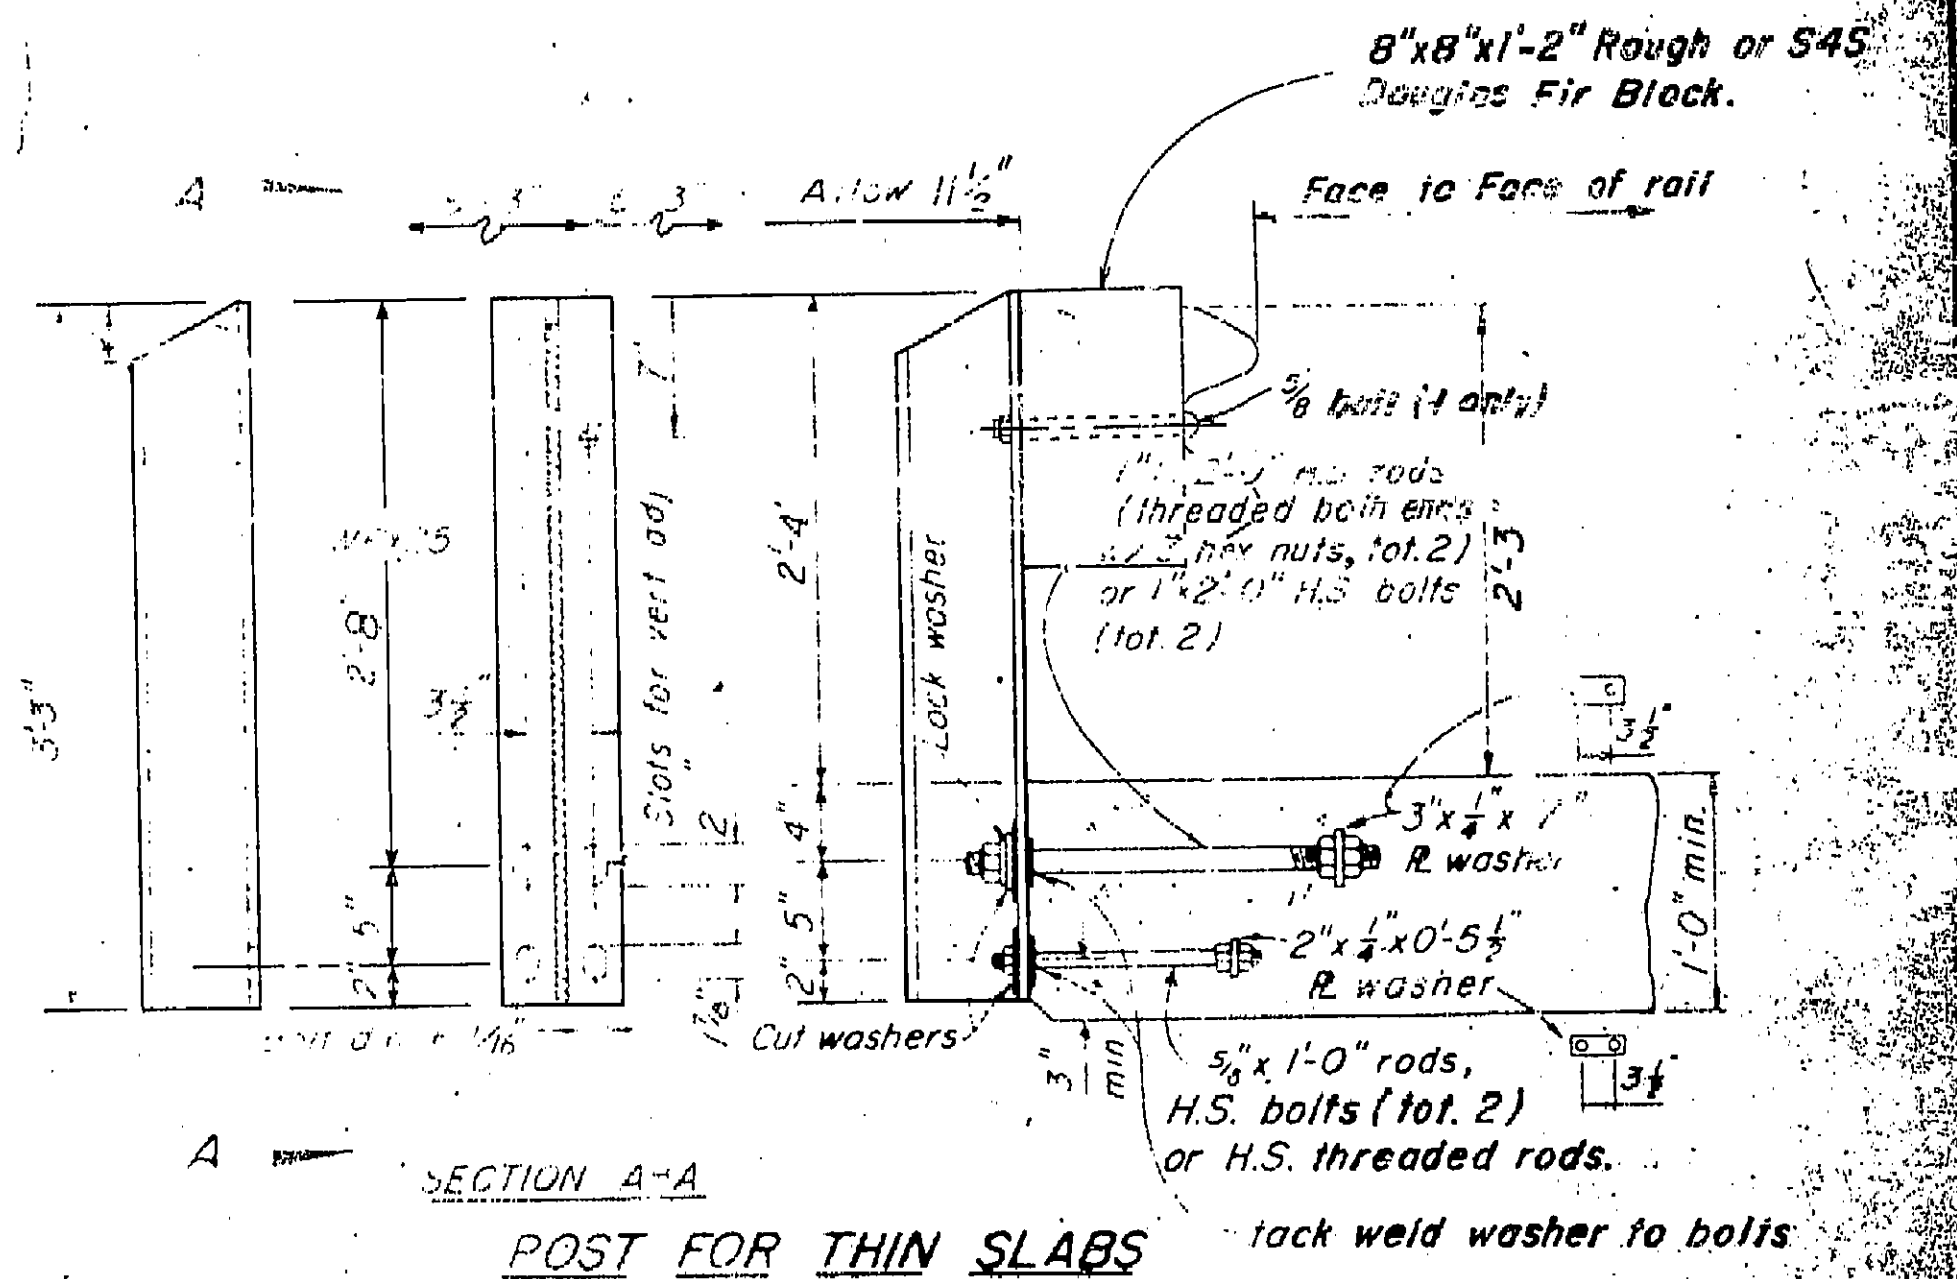

SECTION A-A

POST FOR THIN SLABS

AS BUILT PLANS  
Contract No. UNKNOWN  
Date Completed  
Document No. 7000 8277


METAL BEAM GUARD RAIL DETAILS

55C-371  
ORANGE COUNTY ROAD DEPARTMENT  
SLATER  
SEGERSTROM BRIDGE  
SA-31  
GUARD RAIL - STRUCTURE  
EX & BACKFILL DETAILS  
SHEET 10 OF 14

DR. 12 (11359)


I HEREBY CERTIFY THAT THIS IS A TRUE AND ACCURATE COPY OF THE ABOVE DOCUMENT TAKEN UNDER MY DIRECTION AND CONTROL ON THIS DATE IN SACRAMENTO, CALIFORNIA PURSUANT TO AUTHORIZATION BY THE DIRECTOR OF TRANSPORTATION.  
DATE 10/10/99 SIGNATURE [Signature] SUPERVISOR OF HIGHWAYS



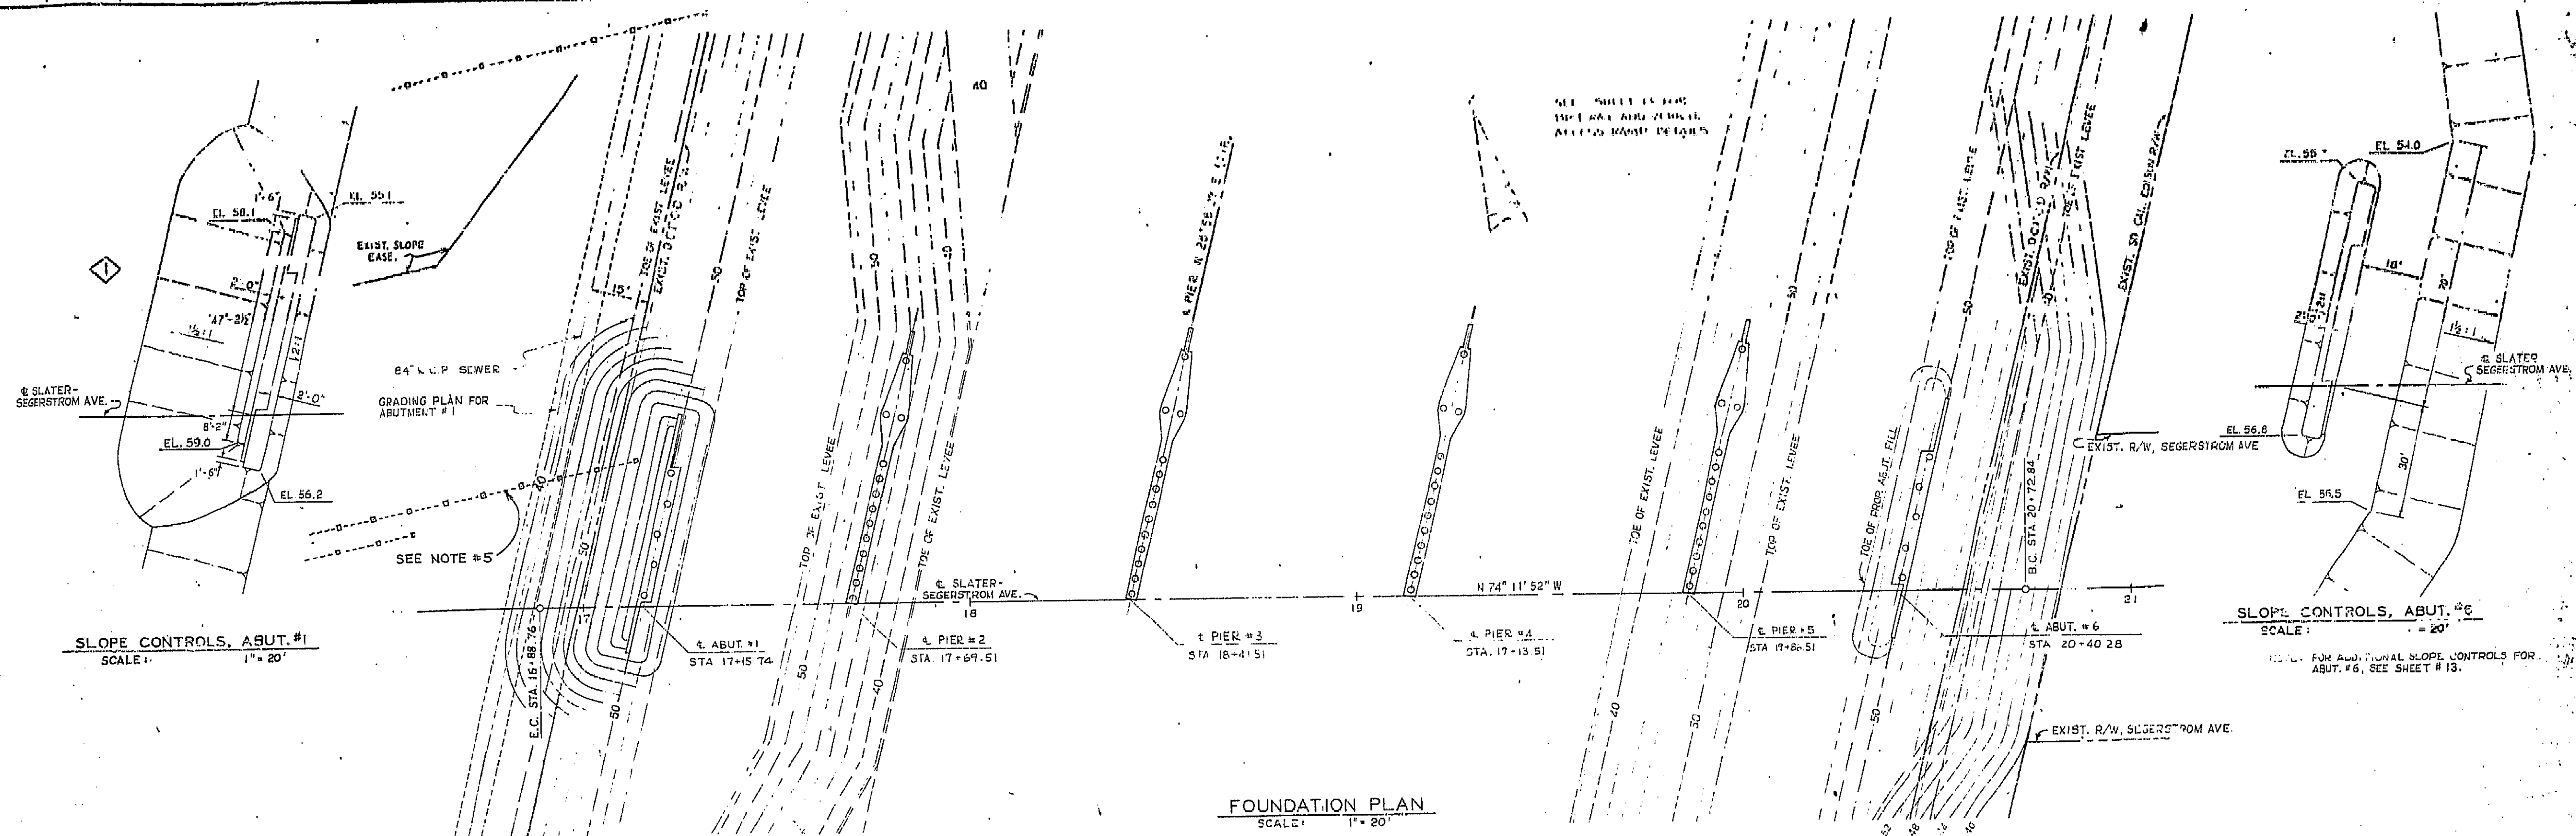

#### NOTES:

1. PILE TYPE: CLASS 70 CONCRETE PILE
2. EXISTING CONTOURS SHOWN ARE APPROXIMATE ONLY.
3. ALL ABUTMENT PILES SHALL BE PREDRILLED TO ELEVATION 44.00
4. CONTRACTOR SHALL CONSTRUCT TEMPORARY ACCESS ROAD TO MAINTAIN THROUGH ACCESS ALONG LEVEE.
5. REMOVE EXISTING TIMBER RAIL FENCING AS REQUIRED TO CONSTRUCT LEVEE EMBANKMENT. REPLACE EXISTING FENCING AS SOON AS PRACTICAL TO JOIN NEW EMBANKMENT SIMILAR TO EXISTING FENCE JOIN. SALVAGE EXCESS FENCING AND DELIVER TO RIDING STABLES.

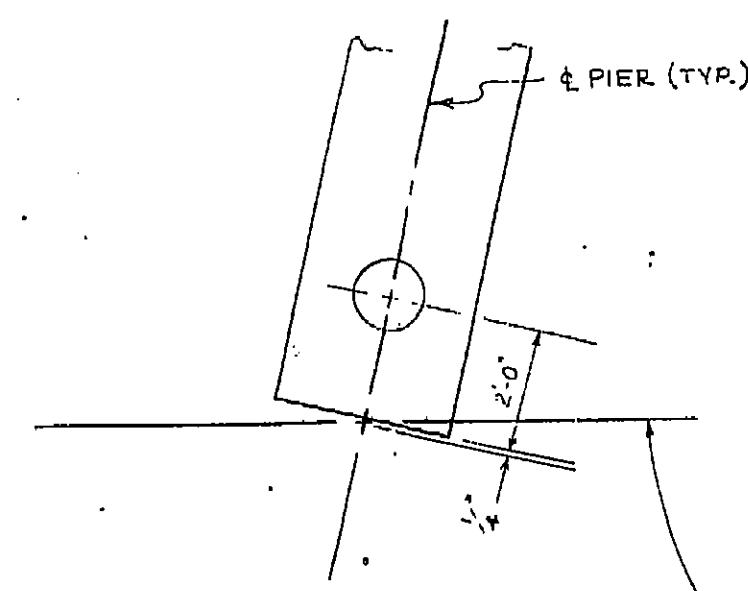

DETAIL "A"

| PILE DATA         |           |           |          |
|-------------------|-----------|-----------|----------|
| ABUT. OR PIER NO. | PILE NO.  | PILE TYPE | PILE TIP |
| ABUT. #1          | PILE #1   | ALL PILES | 4.00     |
| ABUT. #1          | PILE #2   | ALL PILES | 4.00     |
| ABUT. #1          | PILE #3   | ALL PILES | 4.00     |
| ABUT. #1          | PILE #4   | ALL PILES | 4.00     |
| ABUT. #1          | PILE #5   | ALL PILES | 4.00     |
| PIER #2           | ALL PILES | ALL PILES | 4.00     |
| PIER #3           | ALL PILES | ALL PILES | 4.00     |
| PIER #4           | ALL PILES | ALL PILES | 4.00     |
| PIER #5           | ALL PILES | ALL PILES | 4.00     |
| ABUT. #6          | PILE #58  | ALL PILES | 10.00    |
| ABUT. #6          | PILE #59  | ALL PILES | 10.00    |
| ABUT. #6          | PILE #60  | ALL PILES | 10.00    |
| ABUT. #6          | PILE #61  | ALL PILES | 10.00    |
| ABUT. #6          | PILE #62  | ALL PILES | 10.00    |

\* PILES ARE NUMBERED BEGINNING WITH THE PILE NEAREST THE CENTERLINE OF SLATER-SEGERSTROM AVE. AND PROGRESSING NORTHERLY UPSTREAM BEGINNING WITH ABUTMENT #1 AND PROGRESSING FROM WEST TO EAST.

**AS BUILT PLANS**  
 Contract No. 55C-371  
 Date Completed 10/10/77  
 Document No. 1000 82277


6-10-74 SLOPE CONTROLS AT ABUTMENT #1 CHANGED.

55C-371  
 ORANGE COUNTY ROAD DEPARTMENT  
 SLATER-SEGERSTROM BRIDGE  
 SA-31  
 FOUNDATION PLAN  
 SHEET 1 OF 1

I HEREBY CERTIFY THAT THIS IS A TRUE AND CORRECT COPY OF THE ABOVE DOCUMENT TAKEN UNDER MY DIRECTION AND CONTROL ON THIS DATE IN SACRAMENTO, CALIFORNIA PURSUANT TO AUTHORIZATION BY THE DIRECTOR OF TRANSPORTATION.  
 DATE 10/10/77 BY [Signature] TITLE [Signature]  
 SUPERVISOR OF HIGHWAYS






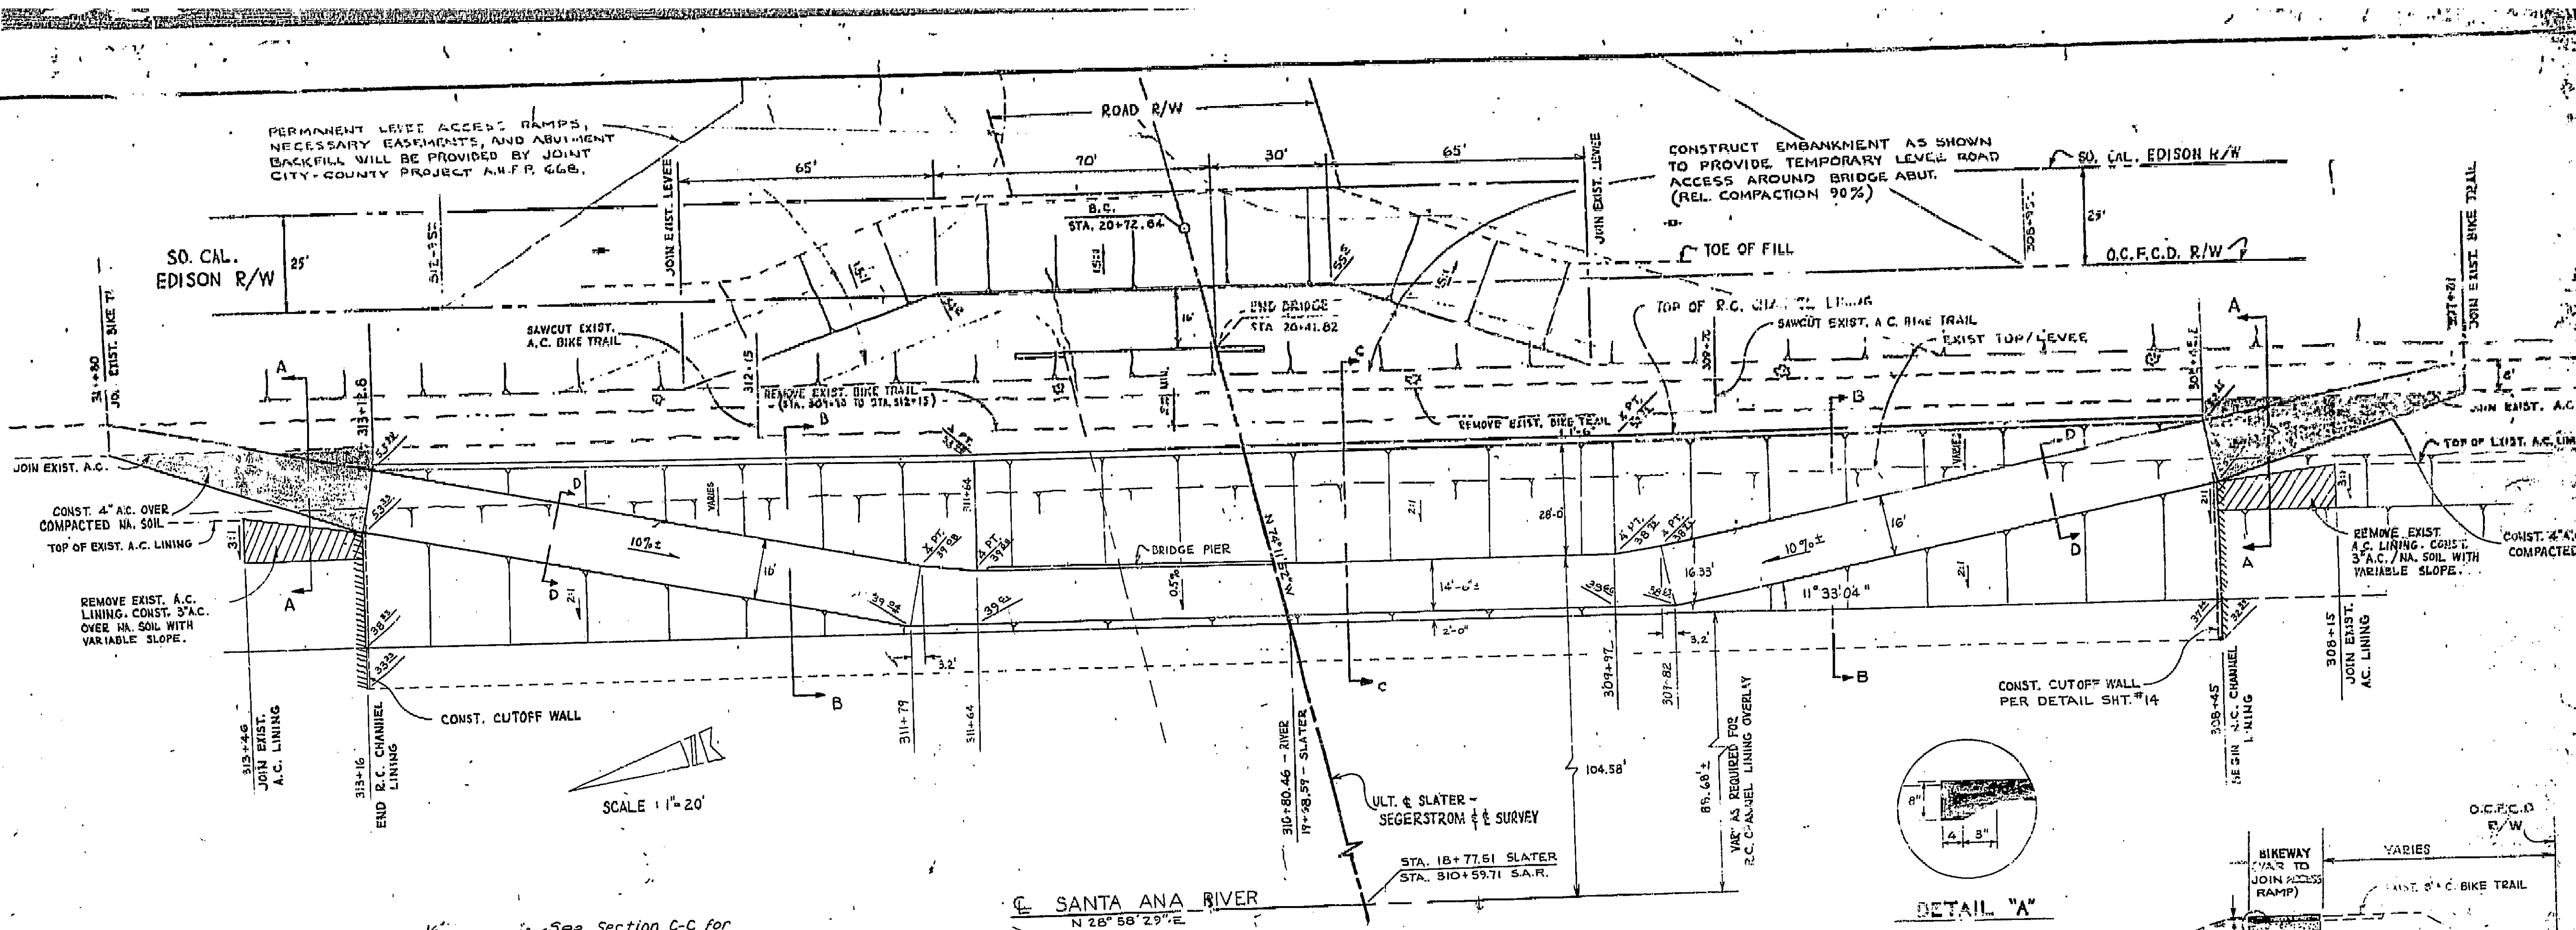


**PLAN  
EAST LEVEE ACCESS RAMPS**

SCALE: 1" = 20'

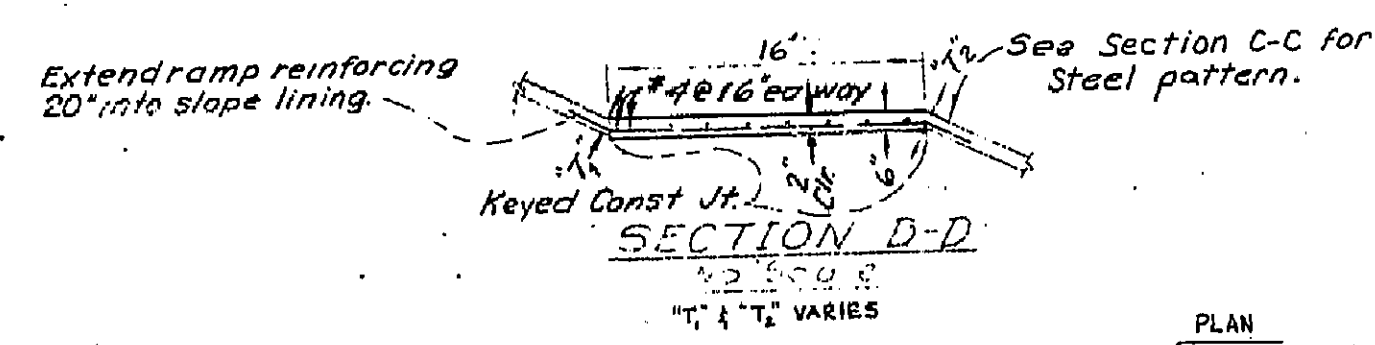

**AS BUILT PLANS**  
Contract No. UNKNOWN  
Date Completed             
Document No. 7000 8277


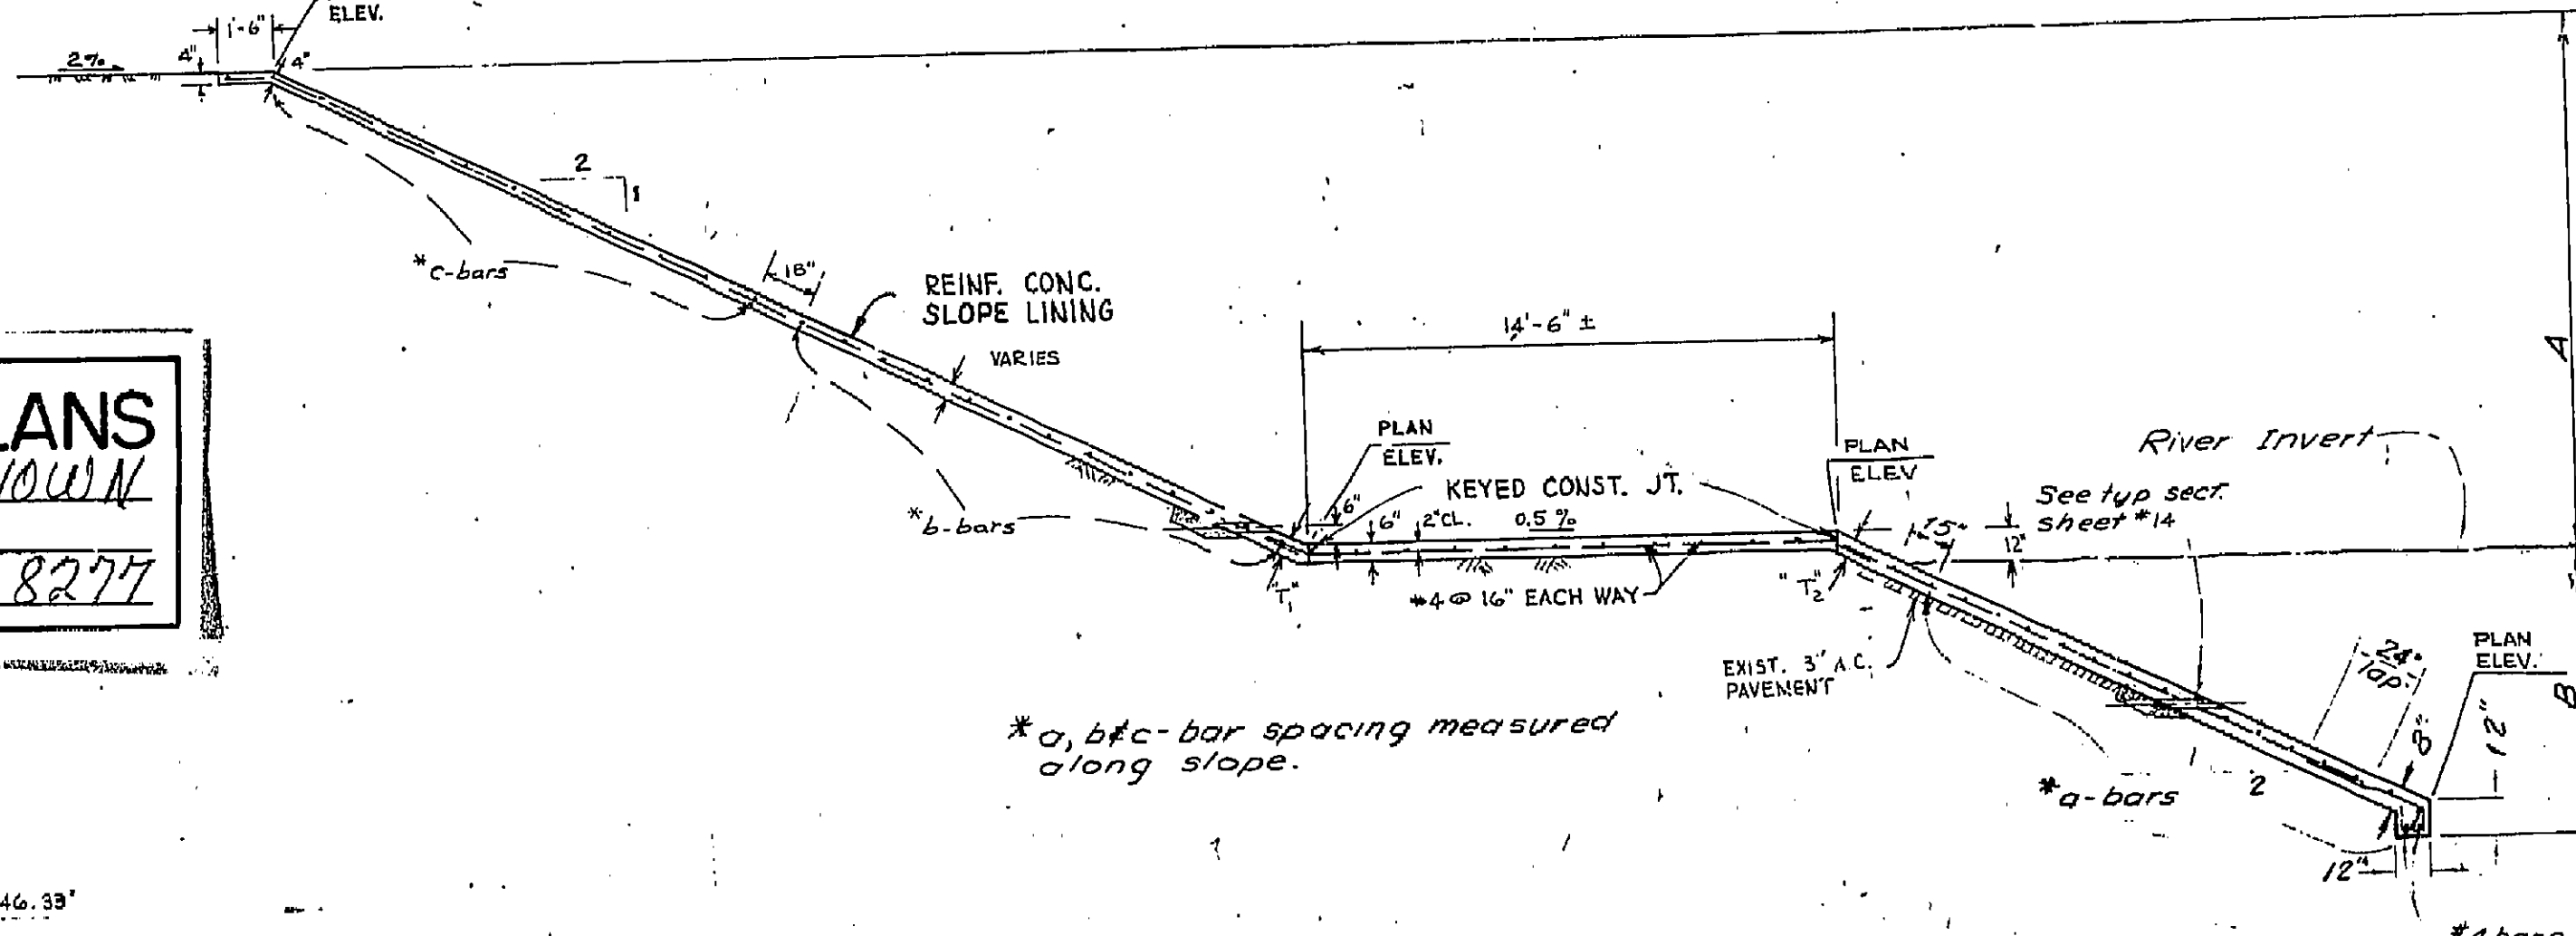


**SECTION C-C**

SCALE: 1/4" = 1'-0"

TABLE 1 - DATA

| Station to Station | A     | B    | a-bars        | b-bars        | c-bars       |
|--------------------|-------|------|---------------|---------------|--------------|
| 30B+45 - 313+16    | 15.00 | 6.00 | 18 - #4 @ 12" | 12 - #4 @ 12" | 9 - #4 @ 12" |

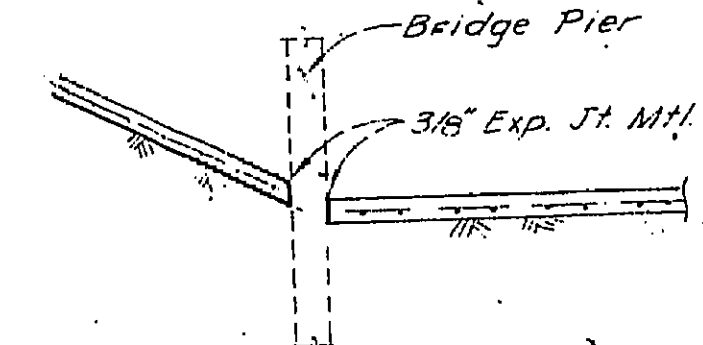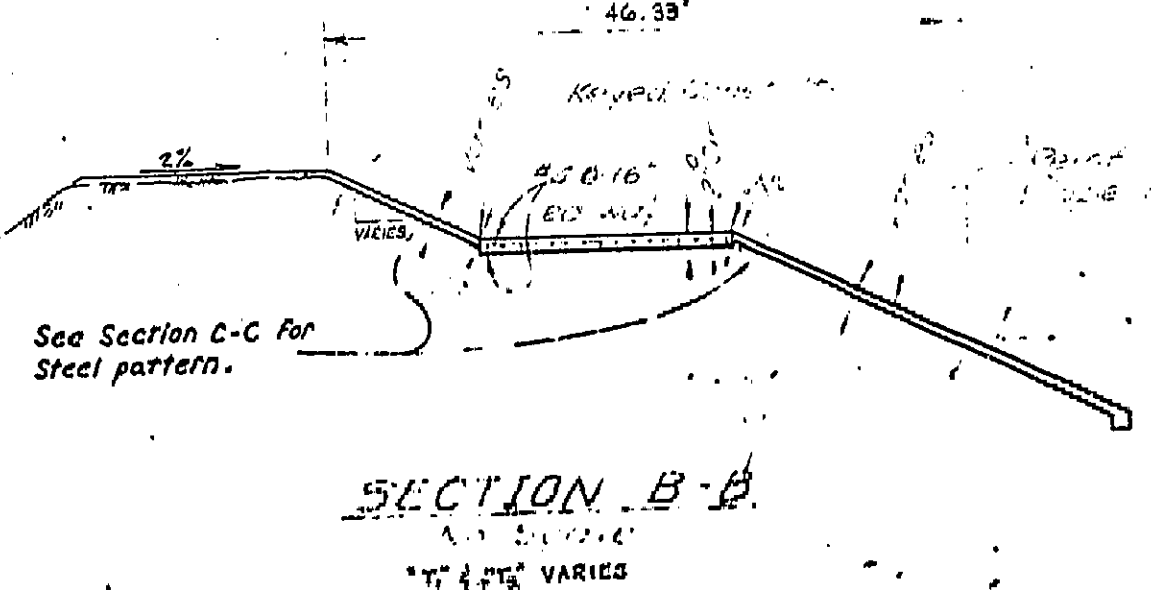

**TYPICAL SECTION  
BRIDGE PIER DETAIL**

No Scale

55C-371  
ORANGE COUNTY ROAD DEPARTMENT  
SLATER -  
SEGERSTROM - BRIDGE  
SA-31  
EAST LEVEE  
ACCESS RAMPS DETAIL

I HEREBY CERTIFY THAT THIS IS A TRUE AND ACCURATE COPY OF THE ABOVE DOCUMENT TAKEN UNDER MY DIRECTION AND CONTROL ON THIS DATE IN SACRAMENTO, CALIFORNIA PURSUANT TO AUTHORIZATION BY THE DIRECTOR OF TRANSPORTATION.  
Date: 10/10/79 By: Joseph M. Galt Title: Supervisor of Mapping

