
Bridge Inspection Records Information System

The requested documents have been generated by the BIRIS.

The documents provided are considered confidential and may only be released outside of the department of transportation upon proper execution of the confidentiality agreement.

State of California
Department of Transportation

**Division of Maintenance
Structures Maintenance & Investigations**



DEPARTMENT OF TRANSPORTATION
Structure Maintenance & Investigations

Bridge Number : 55C0529R
Facility Carried: E/B LGNA HILLS DR
Location : 400' E/O MOULTON PKWY
City : LAGUNA HILLS
Inspection Date : 11-JUN-02

Bridge Inspection Report

Inspection Type

Routine ☒ Group A ☐ Underwater ☐ Special ☐ Other ☐

Name : ALISO CREEK

CONSTRUCTION INFORMATION

Year Built : 1985
Year Widened : N/A
Length (m) : 59.1

Skew (degrees): 27
No. of Joints : 0
No. of Hinges : 0

Description of Structure : Continuous 3-span CIP/PS concrete box girder (6 cells) with RC 2-column bents and RC open end diaphragm abutments, all supported upon steel piles.

Span Configuration : (W) 16.2 m, 24.1 m, 17.4 m (E) c/c

LOAD CAPACITY AND RATINGS

Design Live Load : MS - 18 OR HS - 20

Inventory Rating : 32.6 metric tons

Calculation Method : LOAD FACTOR

Operating Rating : 99.9 metric tons

Calculation Method : LOAD FACTOR

Permit Rating : PPPPP

Posting Load : Type 3 N/A english tons Type 3S2 N/A english tons Type 3-3 N/A english tons

DESCRIPTION ON STRUCTURE

Bridge width : (S) 0.3 m br, 1.5 m sw, 10.7 m, 0.3 m cu, 0.3 m br (N)

Total Width : 13.1 m

Net Width : 10.70 m

No. of Lanes : 2

Rail Description : Concrete

Rail Code : 0000

Min. Vertical Clearance : Unimpaired

DESCRIPTION UNDER STRUCTURE

Channel Description : Natural earth trapezoidal with grouted rock slopes thru the site.

REVISIONS

Rail Ratings:

(New): 0000

(Old): 1000

The southerly barrier consists of a lower concrete parapet (not to current standards) and an upper timber railing.

CONDITION OF STRUCTURE

The structure is in good condition.

SCOUR

Approximately 0.3 m of the pile cap for the westerly abutment is exposed at various locations. Water from the weep holes is eroding the uncompacted soil.

MISCELLANEOUS

Vehicular parking is at the northeast quadrant.

ELEMENT LEVEL INSPECTION RATINGS

F#	Elem No.	Element Description	Env	Total Units Quantity	Qty in each Condition State				
					St. 1	St. 2	St. 3	St. 4	St. 5
01 12		Concrete Deck - Bare	2	610 sq.m.	610	0	0	0	0
01 104		P/S Conc Closed Web/Box Girder	2	59 m.	59	0	0	0	0
01 205		Reinforced Conc Column or Pile Extension	2	4 ea.	4	0	0	0	0

Bridge No.: 55C0529R

Location: 400' E/O MOULTON PKWY

Inspection Date: 11-JUN-02

F#	Elem No.	Element Description	ENV	Total Units Quantity	Qty in each Condition State				
					St. 1	St. 2	St. 3	St. 4	St. 5
01	210	Reinforced Conc Pier Wall	2	30m.	30	0	0	0	0
01	215	Reinforced Conc Abutment	2	30m.	30	0	0	0	0
01	225	Unpainted Steel Submerged Pile	2	64 ea.	64	0	0	0	0
01	302	Compression Joint Seal	2	28m.	28	0	0	0	0
01	331	Reinforced Conc Bridge Railing	2	71m.	71	0	0	0	0
01	335	Other Bridge Railing	2	71m.	71	0	0	0	0

WORK RECOMMENDATIONS - NONE

Inspected By : M. Ogata

M. Ogata
Registered Civil Engineer



CC : TMRut
City of Laguna Hills

Bridge No.: 55C0529R

Location: 400' E/O MOULTON PKWY

Inspection Date: 11-JUN-02

STRUCTURE INVENTORY AND APPRAISAL REPORT

***** IDENTIFICATION *****

(1) STATE NAME - CALIFORNIA 069
 (8) STRUCTURE NUMBER 55C0529R
 (5) INVENTORY ROUTE(ON/UNDER) - ON 1 50 0M274N
 (2) HIGHWAY AGENCY DISTRICT 12
 (3) COUNTY CODE 059 (4) PLACE CODE 39220
 (6) FEATURE INTERSECTED - ALISO CREEK
 (7) FACILITY CARRIED - E/B LGNA HILLS DR
 (9) LOCATION - 400' E/O MOULTON PKWY
 (11) MILEPOINT/KILOMETERPOINT 0
 (12) BASE HIGHWAY NETWORK - NOT ON NET 0
 (13) LRS INVENTORY ROUTE & SUBROUTE
 (16) LATITUDE 33 DEG 35 MIN 34 SEC
 (17) LONGITUDE 117 DEG 42 MIN 43 SEC
 (98) BORDER BRIDGE STATE CODE % SHARE %
 (99) BORDER BRIDGE STRUCTURE NUMBER

***** STRUCTURE TYPE AND MATERIAL *****

(43) STRUCTURE TYPE MAIN: MATERIAL - PRSTR CONC CONT
 TYPE - BOX BEAM OR GDR - MULTIPLE CODE 6 05
 (44) STRUCTURE TYPE APPR: MATERIAL -
 TYPE - CODE
 (45) NUMBER OF SPANS IN MAIN UNIT 3
 (46) NUMBER OF APPROACH SPANS 0
 (107) DECK STRUCTURE TYPE - CIP CONCRETE CODE 1
 (108) WEARING SURFACE / PROTECTIVE SYSTEM:
 A) TYPE OF WEARING SURFACE - CONCRETE CODE 1
 B) TYPE OF MEMBRANE - NONE CODE 0
 C) TYPE OF DECK PROTECTION - NONE CODE 0

***** AGE AND SERVICE *****

(27) YEAR BUILT 1985
 (106) YEAR RECONSTRUCTED 0000
 (42) TYPE OF SERVICE: ON - HIGHWAY-PEDESTRIAN 5
 UNDER - WATERWAY 5
 (28) LANES: ON STRUCTURE 02 UNDER STRUCTURE
 (29) AVERAGE DAILY TRAFFIC 3000
 (30) YEAR OF ADT 1998 (109) TRUCK ADT 1%
 (19) BYPASS, DETOUR LENGTH 2 KM

***** GEOMETRIC DATA *****

(48) LENGTH OF MAXIMUM SPAN 24.1 M
 (49) STRUCTURE LENGTH 59.1 M
 (50) CURB OR SIDEWALK: LEFT 1.5 M RIGHT .3 M
 (51) BRIDGE ROADWAY WIDTH CURB TO CURB 10.7 M
 (52) DECK WIDTH OUT TO OUT 13.1 M
 (32) APPROACH ROADWAY WIDTH (W/SHOULDERS) 10.7 M
 (33) BRIDGE MEDIAN - NO MEDIAN 0
 (34) SKEW 27 DEG (35) STRUCTURE FLARED NO
 (10) INVENTORY ROUTE MIN VERT CLEAR 99.99 M
 (47) INVENTORY ROUTE TOTAL HORIZ CLEAR 10.7 M
 (53) MIN VERT CLEAR OVER BRIDGE RDWY 99.99 M
 (54) MIN VERT UNDERCLEAR REF - NOT H/RR 0 M
 (55) MIN LAT UNDERCLEAR RT REF - NOT H/RR 0 M
 (56) MIN LAT UNDERCLEAR LT 0 M

***** NAVIGATION DATA *****

(38) NAVIGATION CONTROL - NOT APPLICABLE CODE N
 (111) PIER PROTECTION - NOT REQUIRED CODE 1
 (39) NAVIGATION VERTICAL CLEARANCE 0 M
 (116) VERT-LIFT BRIDGE NAV MIN VERT CLEAR 0 M
 (40) NAVIGATION HORIZONTAL CLEARANCE 0

***** SUFFICIENCY RATING = 95.7 *****

STATUS =

HEALTH INDEX = 100

***** CLASSIFICATION ***** CODE

(112) NBIS BRIDGE LENGTH - YES Y
 (104) HIGHWAY SYSTEM - NOT ON NHS 0
 (26) FUNCTIONAL CLASS - MINOR ARTERIAL URBAN 16
 (100) DEFENSE HIGHWAY - NOT STRAHNET 0
 (101) PARALLEL STRUCTURE - LEFT STRUCTURE L
 (102) DIRECTION OF TRAFFIC - 1 WAY 1
 (103) TEMPORARY STRUCTURE -
 (105) FEDERAL LANDS HIGHWAY - NOT APPLICABLE 0
 (110) DESIGNATED NATIONAL NETWORK - NOT ON NET 0
 (20) TOLL - ON FREE ROAD 3
 (21) MAINTAIN - CITY OR MUNICIPAL HIGHWAY AGENCY 4
 (22) OWNER - CITY OR MUNICIPAL HIGHWAY AGENCY 4
 (37) HISTORICAL SIGNIFICANCE - NOT ELIGIBLE 5

***** CONDITION ***** CODE

(58) DECK 7
 (59) SUPERSTRUCTURE 8
 (60) SUBSTRUCTURE 7
 (61) CHANNEL & CHANNEL PROTECTION 8
 (62) CULVERTS N

***** LOAD RATING AND POSTING ***** CODE

(31) DESIGN LOAD - MS - 18 OR HS - 20 5
 (63) OPERATING RATING METHOD - LOAD FACTOR 1
 (64) OPERATING RATING - 99.9
 (65) INVENTORY RATING METHOD - LOAD FACTOR 1
 (66) INVENTORY RATING - 32.6
 (70) BRIDGE POSTING - Equal to or above legal loads 5
 (41) STRUCTURE OPEN, POSTED OR CLOSED - A
 DESCRIPTION - OPEN, NO RESTRICTION

***** APPRAISAL ***** CODE

(67) STRUCTURAL EVALUATION 7
 (68) DECK GEOMETRY 5
 (69) UNDERCLEARANCES, VERTICAL & HORIZONTAL N
 (71) WATER ADEQUACY 9
 (72) APPROACH ROADWAY ALIGNMENT 8
 (36) TRAFFIC SAFETY FEATURES 0000
 (113) SCOUR CRITICAL BRIDGES 8

***** PROPOSED IMPROVEMENTS *****

(75) TYPE OF WORK - CODE
 (76) LENGTH OF STRUCTURE IMPROVEMENT M
 (94) BRIDGE IMPROVEMENT COST
 (95) ROADWAY IMPROVEMENT COST
 (96) TOTAL PROJECT COST
 (97) YEAR OF IMPROVEMENT COST ESTIMATE
 (114) FUTURE ADT 3500
 (115) YEAR OF FUTURE ADT 2010

***** INSPECTIONS *****

(90) INSPECTION DATE 06/02 (91) FREQUENCY 24 MO
 (92) CRITICAL FEATURE INSPECTION: (93) CFI DATE
 A) FRACTURE CRIT DETAIL - NO -1 MO A)
 B) UNDERWATER INSP - NO -1 MO B)
 C) OTHER SPECIAL INSP - NO -1 MO C)

AUG - 5 2002



DEPARTMENT OF TRANSPORTATION
Structure Maintenance & Investigations

Bridge Number 55C0529R
Facility Carried E/B LGNA HILLS DR
Location 400' E/O MOULTON PKWY
City LAGUNA HILLS
Inspection Date 28-SEP-01

Bridge Inspection Report

Inspection Type
Routine ☐ Group A ☐ Underwater ☐ Special ☐ Other ☒

Name ALISO CREEK

CONSTRUCTION INFORMATION

Year Built 1985 Skew (degrees) 27
Year Widened N/A No of Joints 0
Length (m) 59.1 No of Hinges 0

Description of Structure Continuous 3-span CIP/PS concrete box girder (6 cells) with RC 2-column bents and RC open end diaphragm abutments all supported upon steel piles

Span Configuration (W) 16.2 m 24.1 m 17.4 m (E) c/c

LOAD CAPACITY AND RATINGS

Design Live Load MS - 18 OP HS - 20
Inventory Rating 72.6 metric tons Calculation Method LOAD FACTOR
Operating Rating 99.9 metric tons Calculation Method LOAD FACTOR
Permit Rating PPPPP
Posting Load Type 3 N/A english tons Type 3S2 N/A english tons Type 3-3 N/A english tons

DESCRIPTION ON STRUCTURE

Bridge width (S) 0.3 m br 1.5 m sw 10.7 m 0.3 m cu 0.3 m br (N)
Total Width 13.1 m Net Width 10.70 m No of Lanes 2
Rail Description Concrete Rail Code 1000
Min Vertical Clearance Unimpaired

DESCRIPTION UNDER STRUCTURE

Channel Description Natural earth trapezoidal with grouted rock slopes thru the site

REVISIONS

City (New) Laguna Hills (Old) Unincorporated
The Bridge Inspection Reports were previously sent to the County of Orange All future reports will be sent to the City of Laguna Hills

CONDITION OF STRUCTURE

The structure is in good condition

SCOUR

Approximately 0.3 m of the pile cap for the westerly abutment is exposed at various locations Water from the weep holes is eroding the uncompacted soil

MISCELLANEOUS

Vehicular parking is at the northeast quadrant

ELEMENT LEVEL INSPECTION RATINGS									
F#	Element Description	Env	Total Units Quantity	St 1	St 2	St 3	St 4	St 5	
01 12	Concrete Deck - Bare	2	610 sq m	610	0	0	0	0	0
01 104	P/S Conc Closed Web/Box Girder	2	59 m	59	0	0	0	0	0
01 205	Reinforced Conc Column or Pile Extension	2	4 ea	4	0	0	0	0	0
01 210	Reinforced Conc Pier Wall	2	30 m	30	0	0	0	0	0

Bridge No 55C0529R Location 400' E/O MOULTON PKWY

Inspection Date 28-SEP-01

F#	Element Description No	Env	Total Units Quantity	Qty in each Condition State				
				St 1	St 2	St 3	St 4	St 5
01 215	Reinforced Conc Abutment	2	30m	30	0	0	0	0
01 225	Unpainted Steel Submerged Pile	2	64 ea	64	0	0	0	0
01 302	Compression Joint Seal	2	28m	28	0	0	0	0
01 331	Reinforced Conc Bridge Railing	2	142m	142	0	0	0	0

WORK RECOMMENDATIONS - NONE

Inspected By M Ogata

M. Ogata
 Registered Civil Engineer



CC TMRut
 City of Laguna Hills
 Orange County

Bridge No 55C0529R Location 400' E/O MOULTON PKWY Inspection Date 28-SEP-01

STRUCTURE INVENTORY AND APPRAISAL REPORT

***** IDENTIFICATION *****

(1) STATE NAME - CALIFORNIA 069
 (8) STRUCTURE NUMBER 55C0529R
 (5) INVENTORY ROUTE (ON/UNDER) ON 1 50 0M274N
 (2) HIGHWAY AGENCY DISTRICT 12
 (3) COUNTY CODE 059 (4) PLACE CODE 39220
 (6) FEATURE INTERSECTED ALISO CREEK
 (7) FACILITY CARRIED - E/B LGNA HILLS DR
 (9) LOCATION 400 E/O MOULTON PKWY
 (11) MILEPOINT/KILOMETERPOINT 0
 (12) BASE HIGHWAY NETWORK NOT ON NET 0
 (13) LRS INVENTORY ROUTE & SUBROUTE
 (16) LATITUDE 33 DEG 35 MIN 34 SEC
 (17) LONGITUDE 117 DEG 42 MIN 43 SEC
 (98) BORDER BRIDGE STATE CODE & SHAPE &
 (99) BOPDEF BRIDGE STRUCTURE NUMBER

***** STRUCTURE TYPE AND MATERIAL *****

(43) STRUCTURE TYPE MAIN MATERIAL PRSIF CONC CONT
 TYPE BOX BEAM OR GDR MULTIPLE CODE 6 05
 (44) STRUCTURE TYPE APPR MATERIAL
 TYPE - CODE
 (45) NUMBER OF SPANS IN MAIN UNIT 3
 (46) NUMBER OF APPROACH SPANS 0
 (107) DECK STRUCTURE TYPE CIP CONCRETE CODE 1
 (108) WEARING SURFACE / PROTECTIVE SYSTEM
 A) TYPE OF WEARING SURFACE CONCPETE CODE 1
 B) TYPE OF MEMBRANE NONE CODE 0
 C) TYPE OF DECK PROTECTION NCNE CODE 0

***** AGE AND SERVICE *****

(27) YEAR BUILT 1985
 (106) YEAR RECONSTRUCTED 0000
 (42) TYPE OF SERVICE ON HIGHWAY PEDESTRIAN 5
 UNDEP WATERWAY 5
 (28) LANES ON STRUCTURE 02 UNDER STRUCTURE
 (29) AVERAGE DAILY TRAFFIC 3000
 (30) YEAR OF ADT 1998 (109) TRUCKY ADT 1%
 (19) BYPASS DETOUR LENGTH 2 KM

***** GEOMETRIC DATA *****

(48) LENGTH OF MAXIMUM SPAN 24 1 M
 (49) STRUCTURE LENGTH 59 1 M
 (50) CURB OR SIDEWALK LEFT 1 5 M RIGHT 3 M
 (51) BRIDGE ROADWAY WIDTH CURB TO CURB 10 7 M
 (52) DECK WIDTH OUT TO OUT 13 1 M
 (32) APPROACH ROADWAY WIDTH (W/SHOULDERS) 10 7 M
 (33) BRIDGE MEDIAN NO MEDIAN 0
 (34) SKEW 27 DEG (35) STRUCTURE FLARED NO
 (10) INVENTORY ROUTE MIN VERT CLEAR 99 99 M
 (47) INVENTORY ROUTE TOTAL HORIZ CLEAR 10 7 M
 (53) MIN VERT CLEAR OVER BRIDGE RDWY 99 99 M
 (54) MIN VERT UNDERCLEAR REF - NOT H/RR 0 M
 (55) MIN LAT UNDERCLEAR RT REF - NOT H/RR 0 M
 (56) MIN LAT UNDERCLEAR LT 0 M

***** NAVIGATION DATA *****

(38) NAVIGATION CONTROL - NOT APPLICABLE CODE N
 (111) PIER PROTECTION - NOT REQUIRED CODE 1
 (39) NAVIGATION VERTICAL CLEARANCE 0 M
 (116) VERT LIFT BRIDGE NAV MIN VERT CLEAR 0 M
 (40) NAVIGATION HORIZONTAL CLEARANCE 0

***** SUFFICIENCY RATING = 96 7 *****

STATUS =

HEALTH INDEX = 100

***** CLASSIFICATION ***** CODE

(112) NBIS BRIDGE LENGTH YES Y
 (104) HIGHWAY SYSTEM - NOT ON NHS 0
 (26) FUNCTIONAL CLASS MINOR ARTERIAL URBAN 16
 (100) DEFENSE HIGHWAY NOT STRAHNET 0
 (101) PARALLEL STRUCTURE LEFT STRUCTURE L
 (102) DIRECTION OF TRAFFIC 1 WAY 1
 (103) TEMPORARY STRUCTURE
 (105) FEDERAL LANDS HIGHWAY NOT APPLICABLE 0
 (110) DESIGNATED NATIONAL NETWORK - NOT ON NET 0
 (20) TOLL - ON FREE ROAD 3
 (21) MAINTAIN - CITY OR MUNICIPAL HIGHWAY AGENCY 4
 (22) OWNER - CITY OR MUNICIPAL HIGHWAY AGENCY 4
 (57) HISTORICAL SIGNIFICANCE NOT ELIGIBLE 5

***** CONDITION ***** CODE

(58) DECK 7
 (59) SUPERSTRUCTURE 8
 (60) SUBSTRUCTURE 7
 (61) CHANNEL & CHANNEL PROTECTION 8
 (62) CULVERTS N

***** LOAD RATING AND POSTING ***** CODE

(31) DESIGN LOAD MS 18 OR HS - 20 5
 (63) OPERATING RATING METHOD LOAD FACTOR 1
 (64) OPERATING RATING 99 9
 (65) INVENTORY RATING METHOD LOAD FACTOR 1
 (66) INVENTORY RATING 32 6
 (70) BRIDGE POSTING Equal to or above legal loads 5
 (41) STRUCTURE OPEN POSTED OR CLOSED A
 DESCRIPTION OPEN NO RESTRICTION

***** APPRAISAL ***** CODE

(67) STRUCTURAL EVALUATION 7
 (68) DECK GEOMETRY 5
 (69) UNDERCLEARANCES VERTICAL & HORIZONTAL N
 (71) WATER ADEQUACY 9
 (72) APPROACH ROADWAY ALIGNMENT 8
 (36) TRAFFIC SAFETY FEATURES 1000
 (113) SCOUR CRITICAL BRIDGES 8

***** PROPOSED IMPROVEMENTS *****

(75) TYPE OF WORK - CODE
 (76) LENGTH OF STRUCTURE IMPROVEMENT M
 (94) BRIDGE IMPROVEMENT COST
 (95) ROADWAY IMPROVEMENT COST
 (96) TOTAL PROJECT COST
 (97) YEAR OF IMPROVEMENT COST ESTIMATE
 (114) FUTURE ADT 3500
 (115) YEAR OF FUTURE ADT 2010

***** INSPECTIONS *****

(90) INSPECTION DATE 07/01 (91) FREQUENCY 24 MO
 (92) CRITICAL FEATURE INSPECTION (93) CFI DATE
 A) FRACTURE CRIT DETAIL - NO -1 MO A)
 B) UNDERWATER INSP NO -1 MO B)
 C) OTHER SPECIAL INSP NO -1 MO C)



DEPARTMENT OF TRANSPORTATION
Structure Maintenance & Investigations

Bridge Number : 55C0529R
Facility Carried: E/B LGNA HILLS DR
Location : 400' E/O MOULTON PKWY
City :
Inspection Date : 16-JUL-01

Inspection Type

Routine ☒ Group A ☐ Underwater ☐ Special ☐ Other ☐

Bridge Inspection Report

Name : ALISO CREEK

CONSTRUCTION INFORMATION

Year Built : 1985
Year Widened : N/A
Length (m) : 59.1

Skew (degrees): 27
No. of Joints : 0
No. of Hinges : 0

Description of Structure : Continuous 3-span CIP/PS concrete box girder (6 cells) with RC 2-column bents and RC open end diaphragm abutments, all supported upon steel piles.

Span Configuration : (W) 16.2 m, 24.1 m, 17.4 m (E) c/c

LOAD CAPACITY AND RATINGS

Design Live Load : MS - 18 OR HS - 20

Inventory Rating : 32.6 metric tons

Operating Rating : 99.9 metric tons

Permit Rating : PPPPP

Posting Load : Type 3 N/A english tons Type 3S2 N/A english tons Type 3-3 N/A english tons

Calculation Method : LOAD FACTOR

Calculation Method : LOAD FACTOR

DESCRIPTION ON STRUCTURE

Bridge width : (S) 0.3 m br, 1.5 m sw, 10.7 m, 0.3 m cu, 0.3 m br (N)

Total Width : 13.1 m

Net Width : 10.70 m

No. of Lanes : 2

Rail Description : Concrete

Rail Code : 1000

Min. Vertical Clearance : Unimpaired

DESCRIPTION UNDER STRUCTURE

Channel Description : Natural earth trapezoidal with grouted rock slopes thru the site.

CONDITION OF STRUCTURE

The structure is in good condition.

SCOUR

Approximately 0.3 m of the pile cap for the westerly abutment is exposed at various locations. Water from the weep holes is eroding the uncompacted soil.

MISCELLANEOUS

Vehicular parking is at the northeast quadrant.

ELEMENT LEVEL INSPECTION RATINGS									
F#	Elem	Element Description	Env	Total Units	Qty in each Condition State				
	No.			Quantity	St. 1	St. 2	St. 3	St. 4	St. 5
01 12		Concrete Deck - Bare	2	610 sq.m.	610	0	0	0	0
01 104		P/S Conc Closed Web/Box Girder	2	59 m.	59	0	0	0	0
01 205		Reinforced Conc Column or Pile Extension	2	4 ea.	4	0	0	0	0
01 210		Reinforced Conc Pier Wall	2	30 m.	30	0	0	0	0
01 215		Reinforced Conc Abutment	2	30 m.	30	0	0	0	0
01 225		Unpainted Steel Submerged Pile	2	64 ea.	64	0	0	0	0
01 302		Compression Joint Seal	2	28 m.	28	0	0	0	0
01 331		Reinforced Conc Bridge Railing	2	142 m.	142	0	0	0	0

WORK RECOMMENDATIONS - NONE

Printed on : 18-JUL-2001 08:52:58 AM

Bridge No.: 55C0529R Location: 400' E/O MOULTON PKWY

Inspection Date: 16-JUL-01

Inspected By : M. Ogata

M. Ogata
Registered Civil Engineer



CC : TMRut
Orange County

Bridge No.: 55C0529R Location: 400' E/O MOULTON PKWY Inspection Date: 16-JUL-01

STRUCTURE INVENTORY AND APPRAISAL REPORT

```

***** IDENTIFICATION *****
(1) STATE NAME - CALIFORNIA                                069
(8) STRUCTURE NUMBER                                      55C0529R
(5) INVENTORY ROUTE (ON/UNDER) - ON                        140 0M274N
(2) HIGHWAY AGENCY DISTRICT                                12
(3) COUNTY CODE 059 (4) PLACE CODE 00000
(6) FEATURE INTERSECTED - ALISO CREEK
(7) FACILITY CARRIED - E/B LGNA HILLS DR
(9) LOCATION - 400' E/O MOULTON PKWY
(11) MILEPOINT/KILOMETERPOINT                              0
(12) BASE HIGHWAY NETWORK - NOT ON NET                     0
(13) LRS INVENTORY ROUTE & SUBROUTE
(16) LATITUDE 33 DEG 35 MIN 34 SEC
(17) LONGITUDE 117 DEG 42 MIN 43 SEC
(98) BORDER BRIDGE STATE CODE % SHARE %
(99) BORDER BRIDGE STRUCTURE NUMBER

***** STRUCTURE TYPE AND MATERIAL *****
(43) STRUCTURE TYPE MAIN: MATERIAL - PRSTR CONC CONT
      TYPE - BOX BEAM OR GDR - MULTIPLE CODE 6 05
(44) STRUCTURE TYPE APPR: MATERIAL -
      TYPE - CODE
(45) NUMBER OF SPANS IN MAIN UNIT 3
(46) NUMBER OF APPROACH SPANS 0
(107) DECK STRUCTURE TYPE CIP CONCRETE CODE 1
(108) WEARING SURFACE / PROTECTIVE SYSTEM:
      A) TYPE OF WEARING SURFACE - CONCRETE CODE 1
      B) TYPE OF MEMBRANE - NONE CODE 0
      C) TYPE OF DECK PROTECTION - NONE CODE 0

***** AGE AND SERVICE *****
(27) YEAR BUILT 1985
(106) YEAR RECONSTRUCTED 0000
(42) TYPE OF SERVICE: ON - HIGHWAY-PEDESTRIAN 5
      UNDER - WATERWAY 5
(28) LANES: ON STRUCTURE 02 UNDER STRUCTURE
(29) AVERAGE DAILY TRAFFIC 3000
(30) YEAR OF ADT 1998 (109) TRUCK ADT 1%
(19) BYPASS, DETOUR LENGTH 2 KM

***** GEOMETRIC DATA *****
(48) LENGTH OF MAXIMUM SPAN 24.1 M
(49) STRUCTURE LENGTH 59.1 M
(50) CURB OR SIDEWALK: LEFT 1.5 M RIGHT .3 M
(51) BRIDGE ROADWAY WIDTH CURB TO CURB 10.7 M
(52) DECK WIDTH OUT TO OUT 13.1 M
(32) APPROACH ROADWAY WIDTH (W/SHOULDERS) 10.7 M
(33) BRIDGE MEDIAN - NO MEDIAN 0
(34) SKEW 27 DEG (35) STRUCTURE FLARED NO
(10) INVENTORY ROUTE MIN VERT CLEAR 99.99 M
(47) INVENTORY ROUTE TOTAL HORIZ CLEAR 10.7 M
(53) MIN VERT CLEAR OVER BRIDGE RDWY 99.99 M
(54) MIN VERT UNDERCLEAR REF - NOT H/RR 0 M
(55) MIN LAT UNDERCLEAR RT REF - NOT H/RR 0 M
(56) MIN LAT UNDERCLEAR LT 0 M

***** NAVIGATION DATA *****
(38) NAVIGATION CONTROL - NOT APPLICABLE CODE N
(111) PIER PROTECTION - NOT REQUIRED CODE 1
(39) NAVIGATION VERTICAL CLEARANCE 0 M
(116) VERT-LIFT BRIDGE NAV MIN VERT CLEAR 0 M
(40) NAVIGATION HORIZONTAL CLEARANCE 0

***** SUFFICIENCY RATING = 96.7
STATUS =
HEALTH INDEX = 100
***** CLASSIFICATION ***** CODE
(112) NBIS BRIDGE LENGTH - YES Y
(104) HIGHWAY SYSTEM - NOT ON NHS 0
(26) FUNCTIONAL CLASS - MINOR ARTERIAL URBAN 16
(100) DEFENSE HIGHWAY - NOT STRAHNET 0
(101) PARALLEL STRUCTURE - LEFT STRUCTURE L
(102) DIRECTION OF TRAFFIC - 1 WAY 1
(103) TEMPORARY STRUCTURE -
(105) FEDERAL LANDS HIGHWAY - NOT APPLICABLE 0
(110) DESIGNATED NATIONAL NETWORK - NOT ON NET 0
(20) TOLL - ON FREE ROAD 3
(21) MAINTAIN - COUNTY HIGHWAY AGENCY 2
(22) OWNER - COUNTY HIGHWAY AGENCY 2
(37) HISTORICAL SIGNIFICANCE - NOT ELIGIBLE 5

***** CONDITION ***** CODE
(58) DECK 7
(59) SUPERSTRUCTURE 8
(60) SUBSTRUCTURE 7
(61) CHANNEL & CHANNEL PROTECTION 8
(62) CULVERTS N

***** LOAD RATING AND POSTING ***** CODE
(31) DESIGN LOAD - MS - 18 OR HS - 20 5
(63) OPERATING RATING METHOD - LOAD FACTOR 1
(64) OPERATING RATING - 99.9
(65) INVENTORY RATING METHOD - LOAD FACTOR 1
(66) INVENTORY RATING - 32.6
(70) BRIDGE POSTING - Equal to or above legal loads 5
(41) STRUCTURE OPEN, POSTED OR CLOSED - A
      DESCRIPTION - OPEN, NO RESTRICTION

***** APPRAISAL ***** CODE
(67) STRUCTURAL EVALUATION 7
(68) DECK GEOMETRY 5
(69) UNDERCLEARANCES, VERTICAL & HORIZONTAL N
(71) WATER ADEQUACY 9
(72) APPROACH ROADWAY ALIGNMENT 8
(36) TRAFFIC SAFETY FEATURES 1000
(113) SCOUR CRITICAL BRIDGES 6

***** PROPOSED IMPROVEMENTS *****
(75) TYPE OF WORK - CODE
(76) LENGTH OF STRUCTURE IMPROVEMENT M
(94) BRIDGE IMPROVEMENT COST
(95) ROADWAY IMPROVEMENT COST
(96) TOTAL PROJECT COST
(97) YEAR OF IMPROVEMENT COST ESTIMATE
(114) FUTURE ADT 3500
(115) YEAR OF FUTURE ADT 2010

***** INSPECTIONS *****
(90) INSPECTION DATE 07/01 (91) FREQUENCY 24 MO
(92) CRITICAL FEATURE INSPECTION: (93) CFI DATE
      A) FRACTURE CRIT DETAIL - NO -1 MO A)
      B) UNDERWATER INSP - NO -1 MO B)
      C) OTHER SPECIAL INSP - NO -1 MO C)

```

Bridge Number 55C-529 R

TYPE OF INVESTIGATION/REPORT	
BIENNIAL <u>X</u>	DAMAGE <u> </u>
CATEGORY A <u> </u>	OTHER <u> </u>
UNDERWATER <u> </u>	OFFICE <u> </u>

Location 12 - Ora - FAU M274-CR
Dist.-Co.-Rte.-City

Date of Investigation August 1, 1996

Name ALISO CREEK (Laguna Hills Drive eastbound, 400' east of
Moulton Parkway)

CONDITION RATINGS:

Element Level Inspection (ELI) form attached.

Channel & Channel Protection

8


CONDITION OF STRUCTURE:

- A. Concrete deck has light longitudinal cracks in its entirety.
- B. Concrete shear key of east abutment has spalled.

WORK RECOMMENDED:

Repair spall in concrete shear key of the east abutment.

By M. Hadi Behrooj *MHB*
G. P. Balinghasay
G. P. Balinghasay

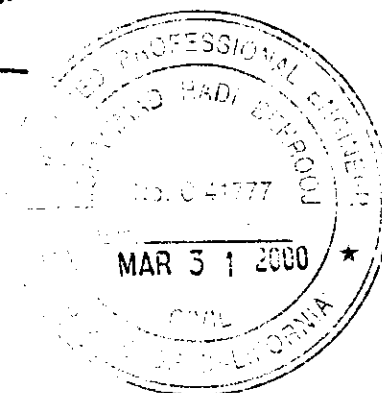

GPB:cd
cc: TMRut
Orange County

INFORMATION ONLY - NOT FOR UPDATE

SCOUR CRITICAL..... NO
GROUP A INVESTIGATION..... NO
FRACTURE CRITICAL..... NO
ELIGIBLE FOR RAIL UPGRADE.. NO
UNDERWATER INVESTIGATION... NO

DISTRICT	12
COUNTY	ORA
ROUTE	
POSTMILE	
NAME	

[illegible]

BY:

Bridge Number 55C-529 R

Location 12 - Ora - FAU M274-CR
Dist.-Co.-Rte.-City

Date of Investigation June 29, 1994

TYPE OF INVESTIGATION/REPORT

BIENNIAL	<u>X</u>	DAMAGE	___
CATEGORY A	___	OTHER	___
UNDERWATER	___	OFFICE	___

Name ALISO CREEK (Laguna Hills Drive eastbound, 400' east of Moulton Parkway)

CONDITION RATINGS:

Condition ratings of all bridge elements are shown on the PONTIS DATA FORM (Attachment A).

Channel & Channel Protection

(8)

SCOUR CRITICAL:

The scour rating of A-2 is appropriate.

CONDITION OF STRUCTURE:

There is light random cracks in various locations of concrete bridge deck. Otherwise the structure is in good condition.

WORK RECOMMENDED:

None.

M. H. Behrooj *MHB*

By

S. A. Zanganeh
S. A. Zanganeh

SAZ:cd

cc: CDHarris
Orange County
WLindsey



INFORMATION ONLY - NOT FOR UPDATE

BRIDGE NUMBER	FRAME	INSPECTION DATE
55C0529R	01	062994
1	9	11
8		16

SCOUR CRITICAL	NO
CATEGORY A	NO
FRACTURE CRITICAL	NO
ELIGIBLE FOR RAIL UPGRADE	NO
UNDERWATER INSPECTION	NO

DISTRICT	12
COUNTY	ORA
ROUTE	
POSTMILE	
NAME	

[illegible]

8Y:

827

SUPPLEMENTARY BRIDGE REPORT
DS-M19 (REV. 12/91)

Bridge Number 55C-529 R

Location 12 - Ora- FAU M274-CR
Dist.-Co.-Rte.-City

Date of Investigation June 10, 1992

TYPE OF INVESTIGATION/REPORT

BIENNIAL	<u>X</u>	DAMAGE	___
CATEGORY A	___	OTHER	___
UNDERWATER	___	OFFICE	___

Name ALISO CREEK (Laguna Hills Drive eastbound, 400' east of Moulton Parkway)

CONDITION RATINGS:

Deck	Superstructure	Substructure	Channel & Channel Protection	Culvert
<u>8</u>	<u>8</u>	<u>8</u>	<u>(8)</u>	<u>N</u>

CONDITION OF STRUCTURE:

Condition of the structure is good.

REVISIONS:

Condition Rating: Channel & Channel Protection - 8

(There is no deterioration in condition of channel banks from the previous report, the above rating change indicates the nature of the earth channel slopes to reflect more closely to the current Federal Coding Guide.)

Henry Ma

HM:cd
cc: INagai (2)
County of Orange



BRIDGE REPORT

DS-M58 (REV. 4/90)

14W23

Bridge No. 55C - 529 R

Location 12 - Ora - FAU M274-CR
Dist Co Rte City

REVISED ORIGINAL REPORT

Date of Investigation May 22, 1990

Name ALISO CREEK (Laguna Hills Drive eastbound, 400' east of
Moulton Parkway)

Lat. 33° - 35.4'N Long. 117° - 42.7'W

Custodian County of Orange Owner County of Orange

STRUCTURAL DATA AND HISTORY

Year Built 1985 By Orange County Contract No. Unknown

Designed by: Jack G. Raub Company Plans Avail. @ DOS

Description: 3 span continuous CIP PS concrete box girder (5 cells)
supported by RC column (2 each) bents (RC channel wall
between columns) and open end RC diaphragm abutments, all
on steel piles.

Spans (W) 53'; 79'; 57' (E)

Length 194' NBIS Bridge Length Yes Skew 27°± Right

Number Of Intermediate Joints: @Hinges N @Bents N

Maximum Column/Pier Height: (Less than 20') X (20'-29') (30' & Over)

Design Live Load HS20-44 & P-13 Design Method Unknown

DESCRIPTION - ON STRUCTURE

Bridge Width (S) 1'br; 5'sw; 35'; 1'cu; 1'br (N)

Total Width 43' Net Width 35' Lanes 2 Tracks None

Median None Rail Type Concrete parapet
with timber beam 1000

Vert. Clearance over deck Unimpaired Appr. Rdwy. Width 35'

Deck Type 1 Wearing Surface/Prot. Sys. 100 Concrete/None

Alignment R = 1800'

DESCRIPTION - UNDER STRUCTURE

Roadway Section None

Clearances: Road: Vert. Horiz. Lt. ; Rt.

Lanes Tracks

Facilities Crossed Aliso Creek (J01)

May 22, 1990

DESCRIPTION - HYDRAULICS

Channel Earth trapezoidal

Navigable: Yes ☐ No ☒ Clearances: Vert.

Horiz.

Pier/Abutment Protection (For Navigation) ☐

TRAFFIC INFORMATION

	DECK	YEAR	UNDER	YEAR
Average Daily Traffic & Year :	3,000	1989	N	
Average Daily Traffic (Future) :	3,500 Est	2010	N	
Average Daily Trucks (% OF ADT) :	1% Est		N	
Bypass Detour Length	1 mile		N	
Shell Route:	No		N	
Functional Classification :	14		N	
LOAD RATINGS:	Inventory	HS 20	Operating	HS 74
	Permit	PPPPP	Computation Method	Load Factor

CONDITION RATINGS:

Deck	8	Superstructure	8	Substructure	8
Channel & Channel Protection	9	Culvert	N	Widenable	Yes

APPRAISAL RATINGS:


Waterway Adequacy	9	Approach Roadway Alignment	8
-------------------	---	----------------------------	---

Date of Revisions

CONDITION OF STRUCTURE:

Condition of the structure is good.

Henry Ma

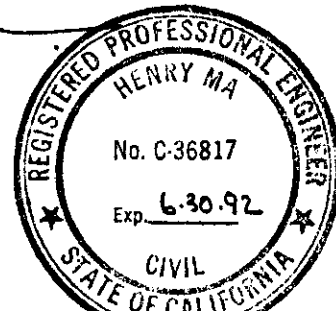

HM:ms

cc: INagai (2)
County of Orange

STATE OF CALIFORNIA
DEPARTMENT OF TRANSPORTATION
SUPPLEMENTARY BRIDGE REPORT
DS-M19 (REV. 2/75)

Bridge No. 55C-529 R

Location 7-Oran-FAU M274-CR
Dist - Co - Rte - PM - City

Date of Investigation May 18, 1988

Name ALISO CREEK (Laguna Hills Drive eastbound, 400' east of Moulton Parkway)

CONDITION RATING:

APPRAISAL RATING:

Deck 8 Superstructure 8 Substr. & Pipes 8 Overall 8

Channel & Channel Protection 7 Retaining Walls N

Widenable? Yes ☒ No ☐ Conditional ☐

Action Required by COUNTY Yes ☐ No ☒

REVISION:

Name: ALISO CREEK (Laguna Hills Drive eastbound, 400' east of Moulton Parkway)

Approach Roadway Width: 35'

CONDITION OF STRUCTURE:

The structure is in good condition.

RECOMMENDED POSTING:

None


WORK RECOMMENDED:

None.

HM/pht

cc: INagai (2)
Orange County (2)

Henry Ma

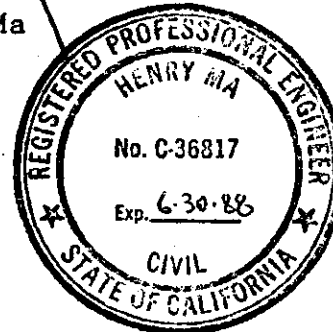

DIST 07 ROUTE CO RD COUNTY 55 C STRU. NO 0529R POSTMILE . RATING WID 4-FT 043.0 STRU TYPE CGB Q YR ORIG CONST 85 JUL. 14, 1986

	RATING FACTOR	PT	SPAN	ULT MOM CAP TOP IN COM	ULT MOM CAP BOT IN COM	POS HS20 MOMENT	NEG HS20 MOMENT	POS PURP MOMENT	NEG PURP MOMENT	DEAD LOAD MOMENT	SECONDARY MOMENT
INV	1.00	5	2	19211.0	0.0	2485.5	-469.7	4226.2	-615.5	2886.0	2494.1
OPER	3.73	5	2	19211.0	0.0	2485.5	-469.7	4226.2	-615.5	2886.0	2494.1
PURP	1.62	10	2	0.0	14741.8	330.4	-2013.0	514.1	-5001.0	-4485.0	2527.6

THE NUMBER OF AXLES ON THE TRUCK THAT CAUSES THE PURPLE RATING FACTOR IS 13.
FC = 0.0 FY = 0.
FS = 270. FPC = 4.00
PS PHI= 0.97

THE INVENTORY RATING POINT WAS SET BY PS CRITERIA

IF THE REPORTED ULTIMATE MOMENT CAPACITY IS 0, IT WAS DETERMINED NOT TO BE CRITICAL

- 2 ALISO CREEK - SOUTH BRIDGE (SHEEP HILLS ROAD)
- 3 CONT 3 SPAN CIP P/S BOX GIRDER W/NO ACWS

PPPPP

DIST 07 ROUTE 55 C COUNTY 55 C STRU. NO 0529R POSTMILE . RATING 043.0 WIL. H-FT STRU TYPE CGB Q YR ORIG CONST 85

JUL. 14, 1986

INFLUENCE LINE FOR CRITICAL INVENTORY RATING POINT SPAN 2 10TH POINT 5

MEM NO	LEFT	.1	.2	.3	.4	.5	.6	.7	.8	.9	RIGHT
1	0.0	-0.361	-0.700	-0.996	-1.225	-1.366	-1.398	-1.298	-1.044	-0.615	0.0
2	0.0	1.315	3.207	5.685	8.751	12.400	8.763	5.708	3.232	1.335	0.0
3	0.0	-0.673	-1.142	-1.419	-1.528	-1.493	-1.338	-1.088	-0.765	-0.395	0.0

THE CRITICAL OPERATING RATING POINT IS THE SAME AS THE CRITICAL INVENTORY RATING POINT

INFLUENCE LINE FOR CRITICAL PURPLE RATING POINT SPAN 2 10TH POINT 10

1	0.0	0.346	0.671	0.954	1.174	1.309	1.340	1.244	1.001	0.590	0.0
2	0.0	-1.225	-2.778	-4.440	-5.983	-7.179	-7.799	-7.615	-6.399	-3.922	0.0
3	0.0	-2.009	-3.406	-4.233	-4.558	-4.454	-3.993	-3.245	-2.282	-1.177	0.0

2 ALISO CREEK - SOUTH BRIDGE (SHEEP HILLS ROAD)
3 CONT 3 SPAN CIP P/S BOX GIRDER W/NO ACWS

Bridge No. 55C-529 R (E/B Rdwy)

Other No.

P.U.C. No.

Location 7-Ora-FAU M274-CR

Dist - Co - Rte - PM - City

Date of Investigation June 18, 1986

SEE REVISED
ORIGINAL REPORT

Name ALISO CREEK (Sheep Hills Road, 400' east of Moulton Parkway)

Lat. 33°-35.4'N Long. 117°-42.7'W

STRUCTURAL DATA AND HISTORY

Year Built 1985 By Orange County Contract No. Unknown

Date of Revisions

Designed by: B.D. ☐ Jack G. Raub Company Plans Avail. ☐ B.D.

Description: 3 span continuous CIP/PS concrete box girder (5 cells)
on column (2) bents and diaphragm abutments all
supported by steel piles. RC channel debris pier walls
between columns.

Spans 1 @ 53', 1 @ 79', 1 @ 57'

Length 194' Skew 27±° Rt. Design LL HS20-44 & P-13

Ratings: Inventory HS20/LF Operating HS 74.6/LF Permit PPPPP/LF

DESCRIPTION - ON STRUCTURE (Shell Rte.: Yes ☐ No ☒)

Bridge Width (S) 1'br, 5'sw, 35', 1'cu, 1'br (N)

Total Width 43' Lanes 2 Tracks 0

Median None Rail Type Concrete parapet and timber(1000)

Vert. Clearance over deck Unimpaired Appr. Rdwy. Width 82'

Wearing Surface None Deck Prot. Sys. None

Alignment R= 1800'

DESCRIPTION - UNDER STRUCTURE (Shell Rte.: Yes ☐ No ☒)

Roadway Section None

Clearances: Vert. Horiz.; Lt. Rt.

Lanes Tracks Pumpplant: None ☒ See Br. No.

Facilities Crossed Aliso Creek

cc:

DESCRIPTION - HYDRAULICS

Channel Unimproved natural sand and gravel trapezoidal

Navigable: Yes ☐ No ☒ Clearances: Vert. _____ Horiz. _____

MAINTENANCE

Custodian Orange County Owner Orange County

ORIGINAL CONDITION RATING

Deck	<u>8</u>
Superstructure	<u>8</u>
Substructure & Pipes	<u>8</u>
Channel & Channel Protection	<u>7</u>
Retaining Walls	<u>N</u>
Approach Rdwy. Alignment	<u>7</u>
Estimated Remaining Life	<u>50</u>

ORIGINAL APPRAISAL

Overall	<u>8</u>
Deck Geometry	<u>8</u>
Underclearances	Vert. <u>N</u>
	Horiz. <u>N</u>
Safe Load Capacity	<u>9</u>
Waterway Adequacy	<u>7</u>
Approach Rdwy. Alignment	<u>7</u>

Widenable? Yes ☒ No ☐ Conditional ☐

Average Daily Traffic & Year 500 (Est. 1986)

Bypass Detour Length 1 mile


Seismic Retrofit Not required

Action Required: Yes ☐ No ☒
 Posting Required: None ☒ Load ☐
 Speed ☐


LOAC CAPACITY: The inventory, operating and permit ratings shown were obtained through the "Frame Rate" program using the load factor (LF) method of analysis

CONDITION OF STRUCTURE: The structure is new and in good condition.

WORK RECOMMENDED: None

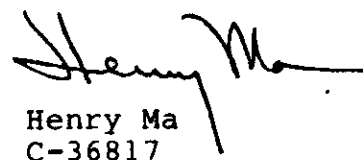
 Henry Ma
 C-36817

HM:pht
 cc: INagai (2)
 Orange County (2)

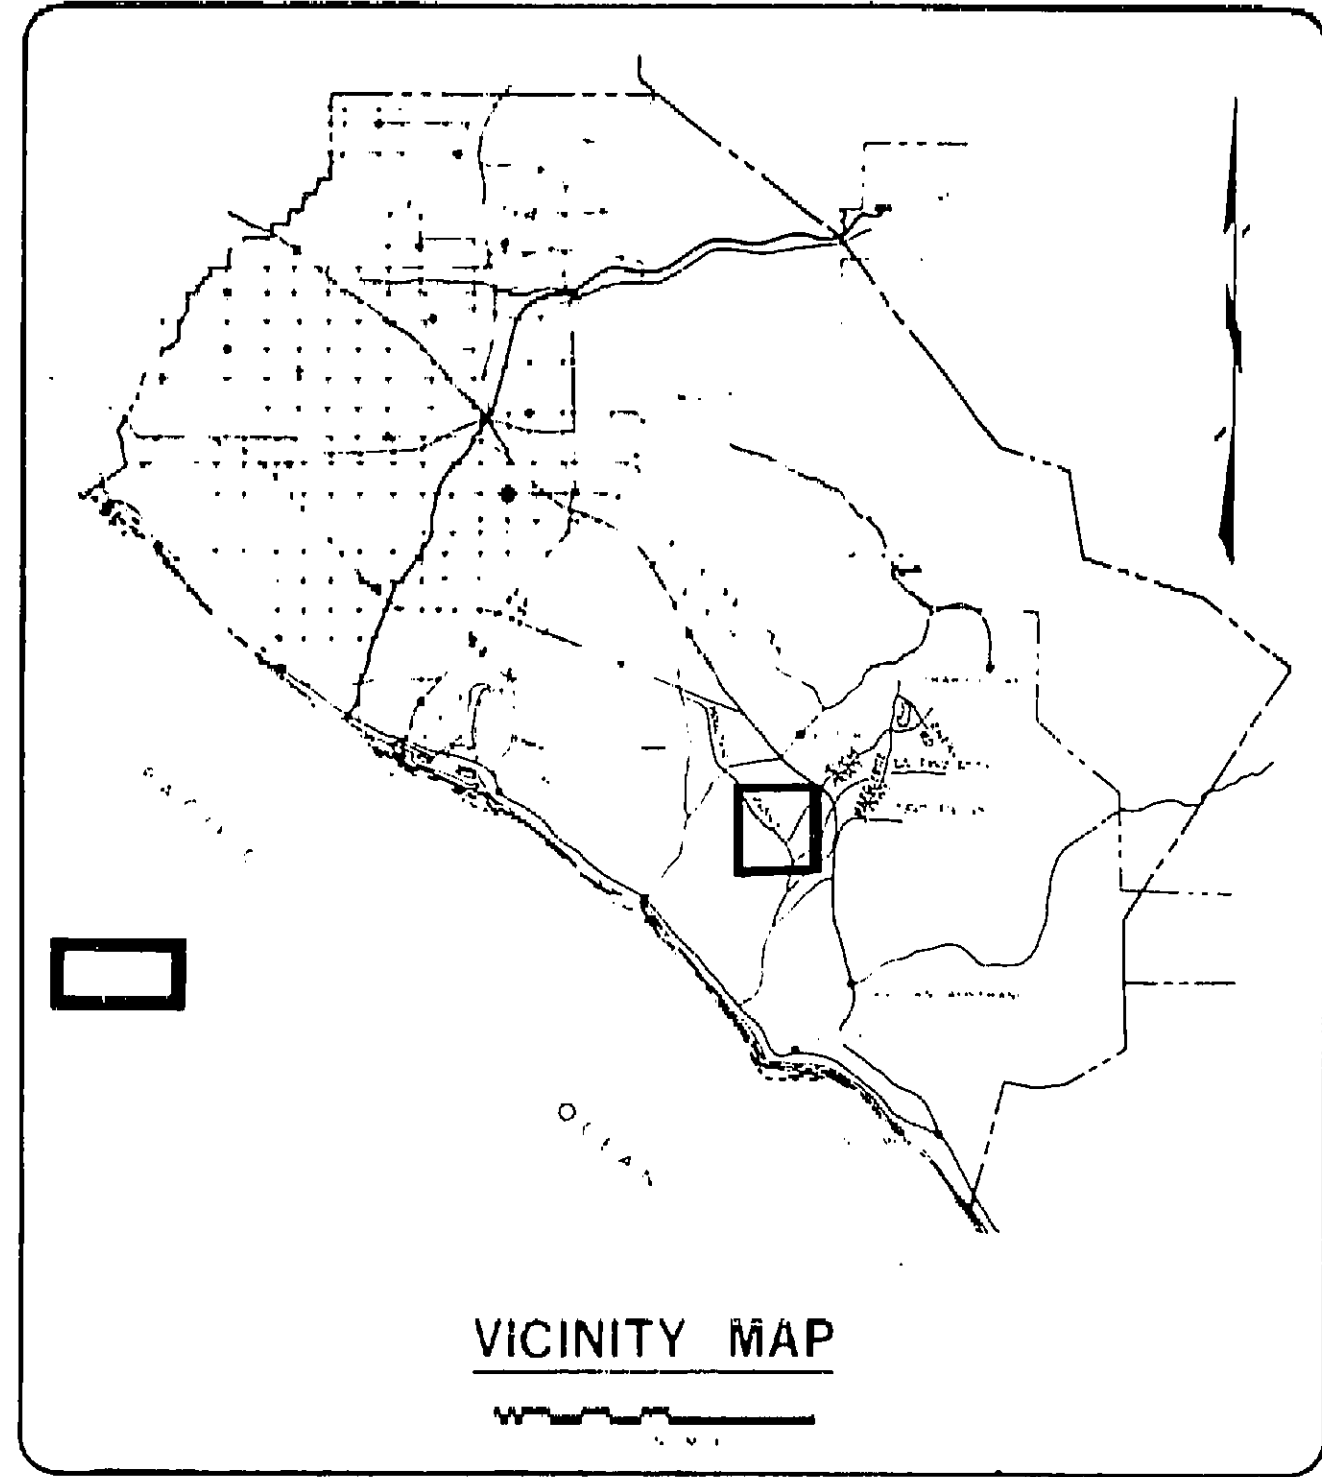

ORANGE COUNTY
ENVIRONMENTAL MANAGEMENT AGENCY

SANTA ANA, CALIFORNIA
M. STORM, DIRECTOR


PLANS FOR CONSTRUCTION OF
SHEEP HILLS ROAD BRIDGE
(SOUTH BRIDGE)

ACROSS ALISO CREEK
(CHANNEL NO. J01)

CONSTRUCTED AS PART OF TRACT 11392

PREPARED FOR MISSION VIEJO COMPANY
26137 LA PAZ ROAD • MISSION VIEJO, CALIF. 92691
714-837-6050

70 TON BENT PILE

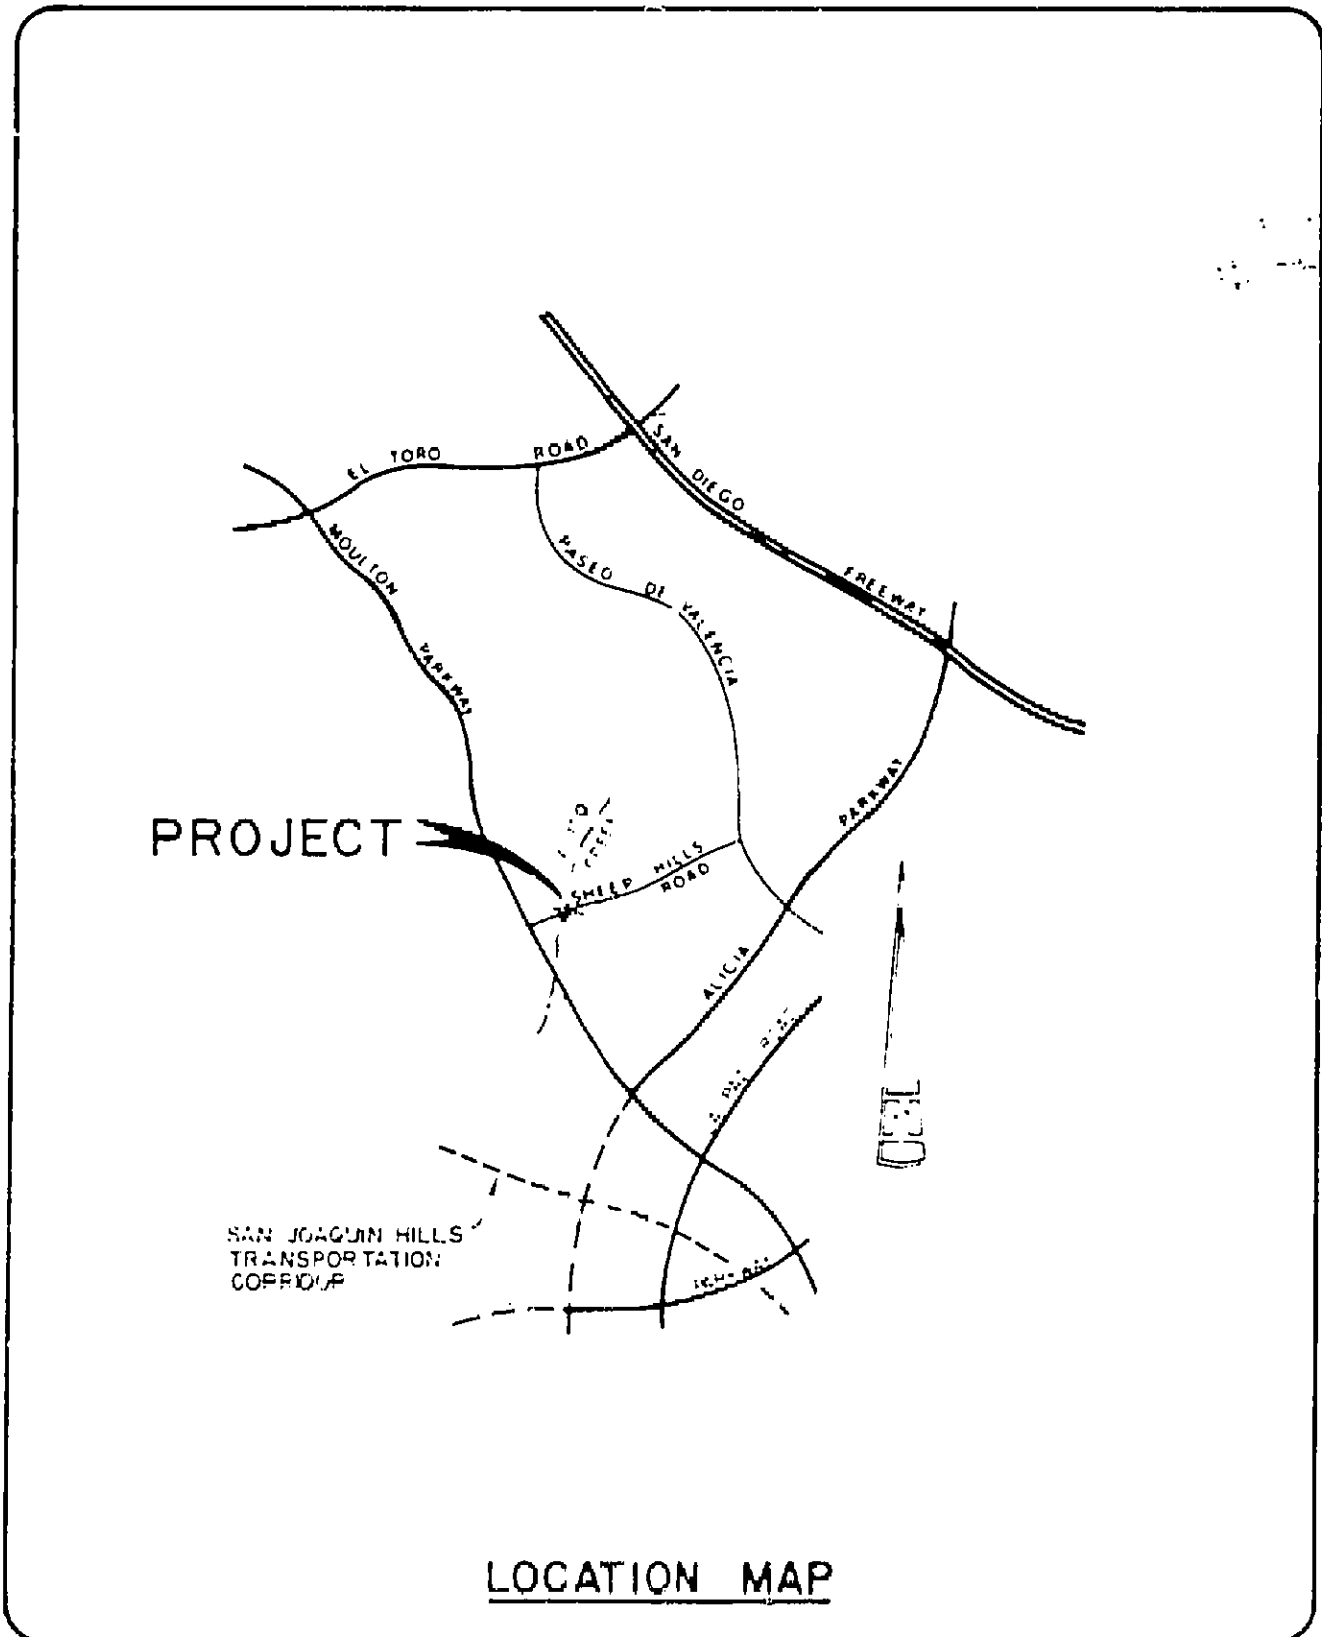

ALL UNDERGROUND UTILITIES OR STRUCTURES REPORTED BY THE OWNER OR OTHERS, AND THOSE SHOWN ON THE RECORDS EXAMINED, ARE INDICATED WITH THEIR APPROXIMATE LOCATION AND EXTENT. THE OWNER, BY ACCEPTING THESE PLANS OR PROCEEDING WITH IMPROVEMENTS PURSUANT THERETO, AGREES TO ASSUME LIABILITY AND TO HOLD UNDERSIGNED HARMLESS FOR ANY DAMAGES RESULTING FROM THE EXISTENCE OF UNDERGROUND UTILITIES OR STRUCTURES NOT REPORTED TO THE UNDERSIGNED, NOT INDICATED ON THE PUBLIC RECORDS EXAMINED, LOCATED AT VARIANCE WITH THOSE REPORTED OR SHOWN ON RECORDS EXAMINED. THE CONTRACTOR IS REQUIRED TO TAKE DUE PRECAUTIONARY MEASURES TO PROTECT THE UTILITIES OR STRUCTURES SHOWN AND ANY OTHER UTILITIES OR STRUCTURES FOUND AT THE SITE. IT SHALL BE THE CONTRACTOR'S RESPONSIBILITY TO NOTIFY THE OWNERS OF THE UTILITIES OR STRUCTURES CONCERNED BEFORE STARTING WORK.

CONTRACTOR AGREES THAT HE SHALL ASSUME SOLE AND COMPLETE RESPONSIBILITY FOR JOB SITE CONDITIONS DURING THE COURSE OF CONSTRUCTION OF THIS PROJECT, INCLUDING SAFETY OF ALL PERSONS AND PROPERTY. THAT THIS REQUIREMENT SHALL APPLY CONTINUOUSLY AND NOT BE LIMITED TO NORMAL WORKING HOURS, AND THAT THE CONTRACTOR SHALL DEFEND, INDEMNIFY AND HOLD THE OWNER, THE CONSULTING ENGINEER, AND THE COUNTY OF ORANGE HARMLESS FROM ANY AND ALL LIABILITY, REAL OR ALLEGED, IN CONNECTION WITH THE PERFORMANCE OF WORK ON THIS PROJECT, EXCEPTING FOR LIABILITY ARISING FROM THE SOLE NEGLIGENCE OF THE OWNER, THE CONSULTING ENGINEER, OR THE COUNTY OF ORANGE.

55C-529 R/L

ENGINEER


Jack G. Raub Company
Engineering & Planning

Michael P. W. [Signature]
V. [Signature]
M. [Signature]

EMA - REGULATION

APPROVED *Douglas M. [Signature]* 23796
DATE: 9-16-1985 RCE

THIS PLAN IS SIGNED BY E.M.A. / REGULATION FOR CONCEPT AND ADHERENCE TO COUNTY STANDARDS AND REQUIREMENTS ONLY. E.M.A. / REGULATION IS NOT RESPONSIBLE FOR DESIGN, ASSUMPTIONS, OR ACCURACY.

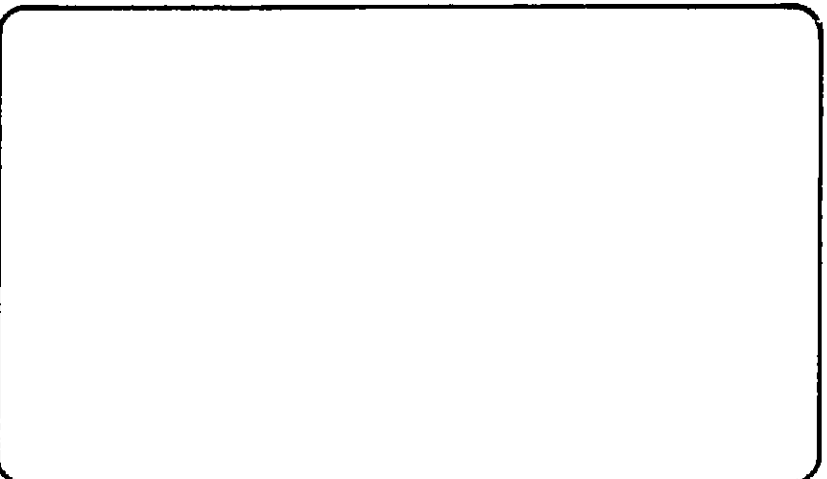

INDEX OF SHEETS	
SHEET	DESCRIPTION
1.	TITLE SHEET
2.	STREET IMPROVEMENT PLAN
3.	TRAFFIC STRIPING AND SIGNING PLAN
4.	GENERAL PLAN
5.	ABUTMENT 1 - PLAN & ELEVATION
6.	ABUTMENT 4 - PLAN & ELEVATION
7.	ABUTMENT SECTIONS & DETAILS
8.	WINGWALLS SECTIONS & DETAILS
9.	PIER 2 - PLAN & ELEVATION
10.	PIER 3 - PLAN & ELEVATION
11.	PIER SECTIONS & DETAILS
12.	DEBRIS WALL & MASONRY SECTION
13.	TYPICAL SECTION, DECK REINFORCEMENT
14.	GIRDER LAYOUT & PROFILE
15.	MISCELLANEOUS DETAILS
16.	MISCELLANEOUS DETAILS
17.	BORING LOG

UTILITY	PHONE NO.
SOUTHERN CALIFORNIA EDISON CO	859-5243
SOUTHERN CALIFORNIA GAS CO	634-3122
PACIFIC BELL	966-6286
MOULTON NIGUEL WATER DISTRICT	643-2584
COUNTY OF ORANGE E. M. A.	834-3488
TRI-CITIES MUNICIPAL WATER DISTRICT	496-1377
UNDERGROUND SERVICE ALERT	800-422-4133

BENCH MARK

3X 28 70

O C S ALUMINUM CAP LOCATED NORTHWEST ALONG MOULTON PARKWAY FROM THE INTERSECTION OF LA PAZ ROAD TO THE CONCRETE BRIDGE (NO. AL-15 1988) CROSSING OF ALISO CREEK 13 FEET EAST OF THE CENTER LINE OF THE PARKWAY, 18 FEET SOUTHWEST OF POWER POLE NUMBER 1874920E IN THE NE PART OF THE BRIDGE, 15 FEET SOUTH OF THE NORTH END OF CONCRETE RETAINING WALL, 1 FOOT WEST OF THE EAST EDGE OF THE BRIDGE, 1 FOOT NORTH OF EXPANSION JOINT AND LEVEL WITH THE BRIDGE DECK. LEV 1970 - ADJ. 1970 ELE. 279842


BASIS OF BEARING






THE BEARINGS SHOWN HEREON ARE BASED ON THE CENTERLINE OF MOULTON PARKWAY AS SHOWN ON THE TR 11392, MM 497/25-31 OF THE ORANGE COUNTY, CALIFORNIA BEING N 28° 14' 47" W

REVISIONS			
NO.	DESCRIPTION	SHT.	APPROVED DATE

DWG. NO. AL-15A

SHEET 1 OF 17

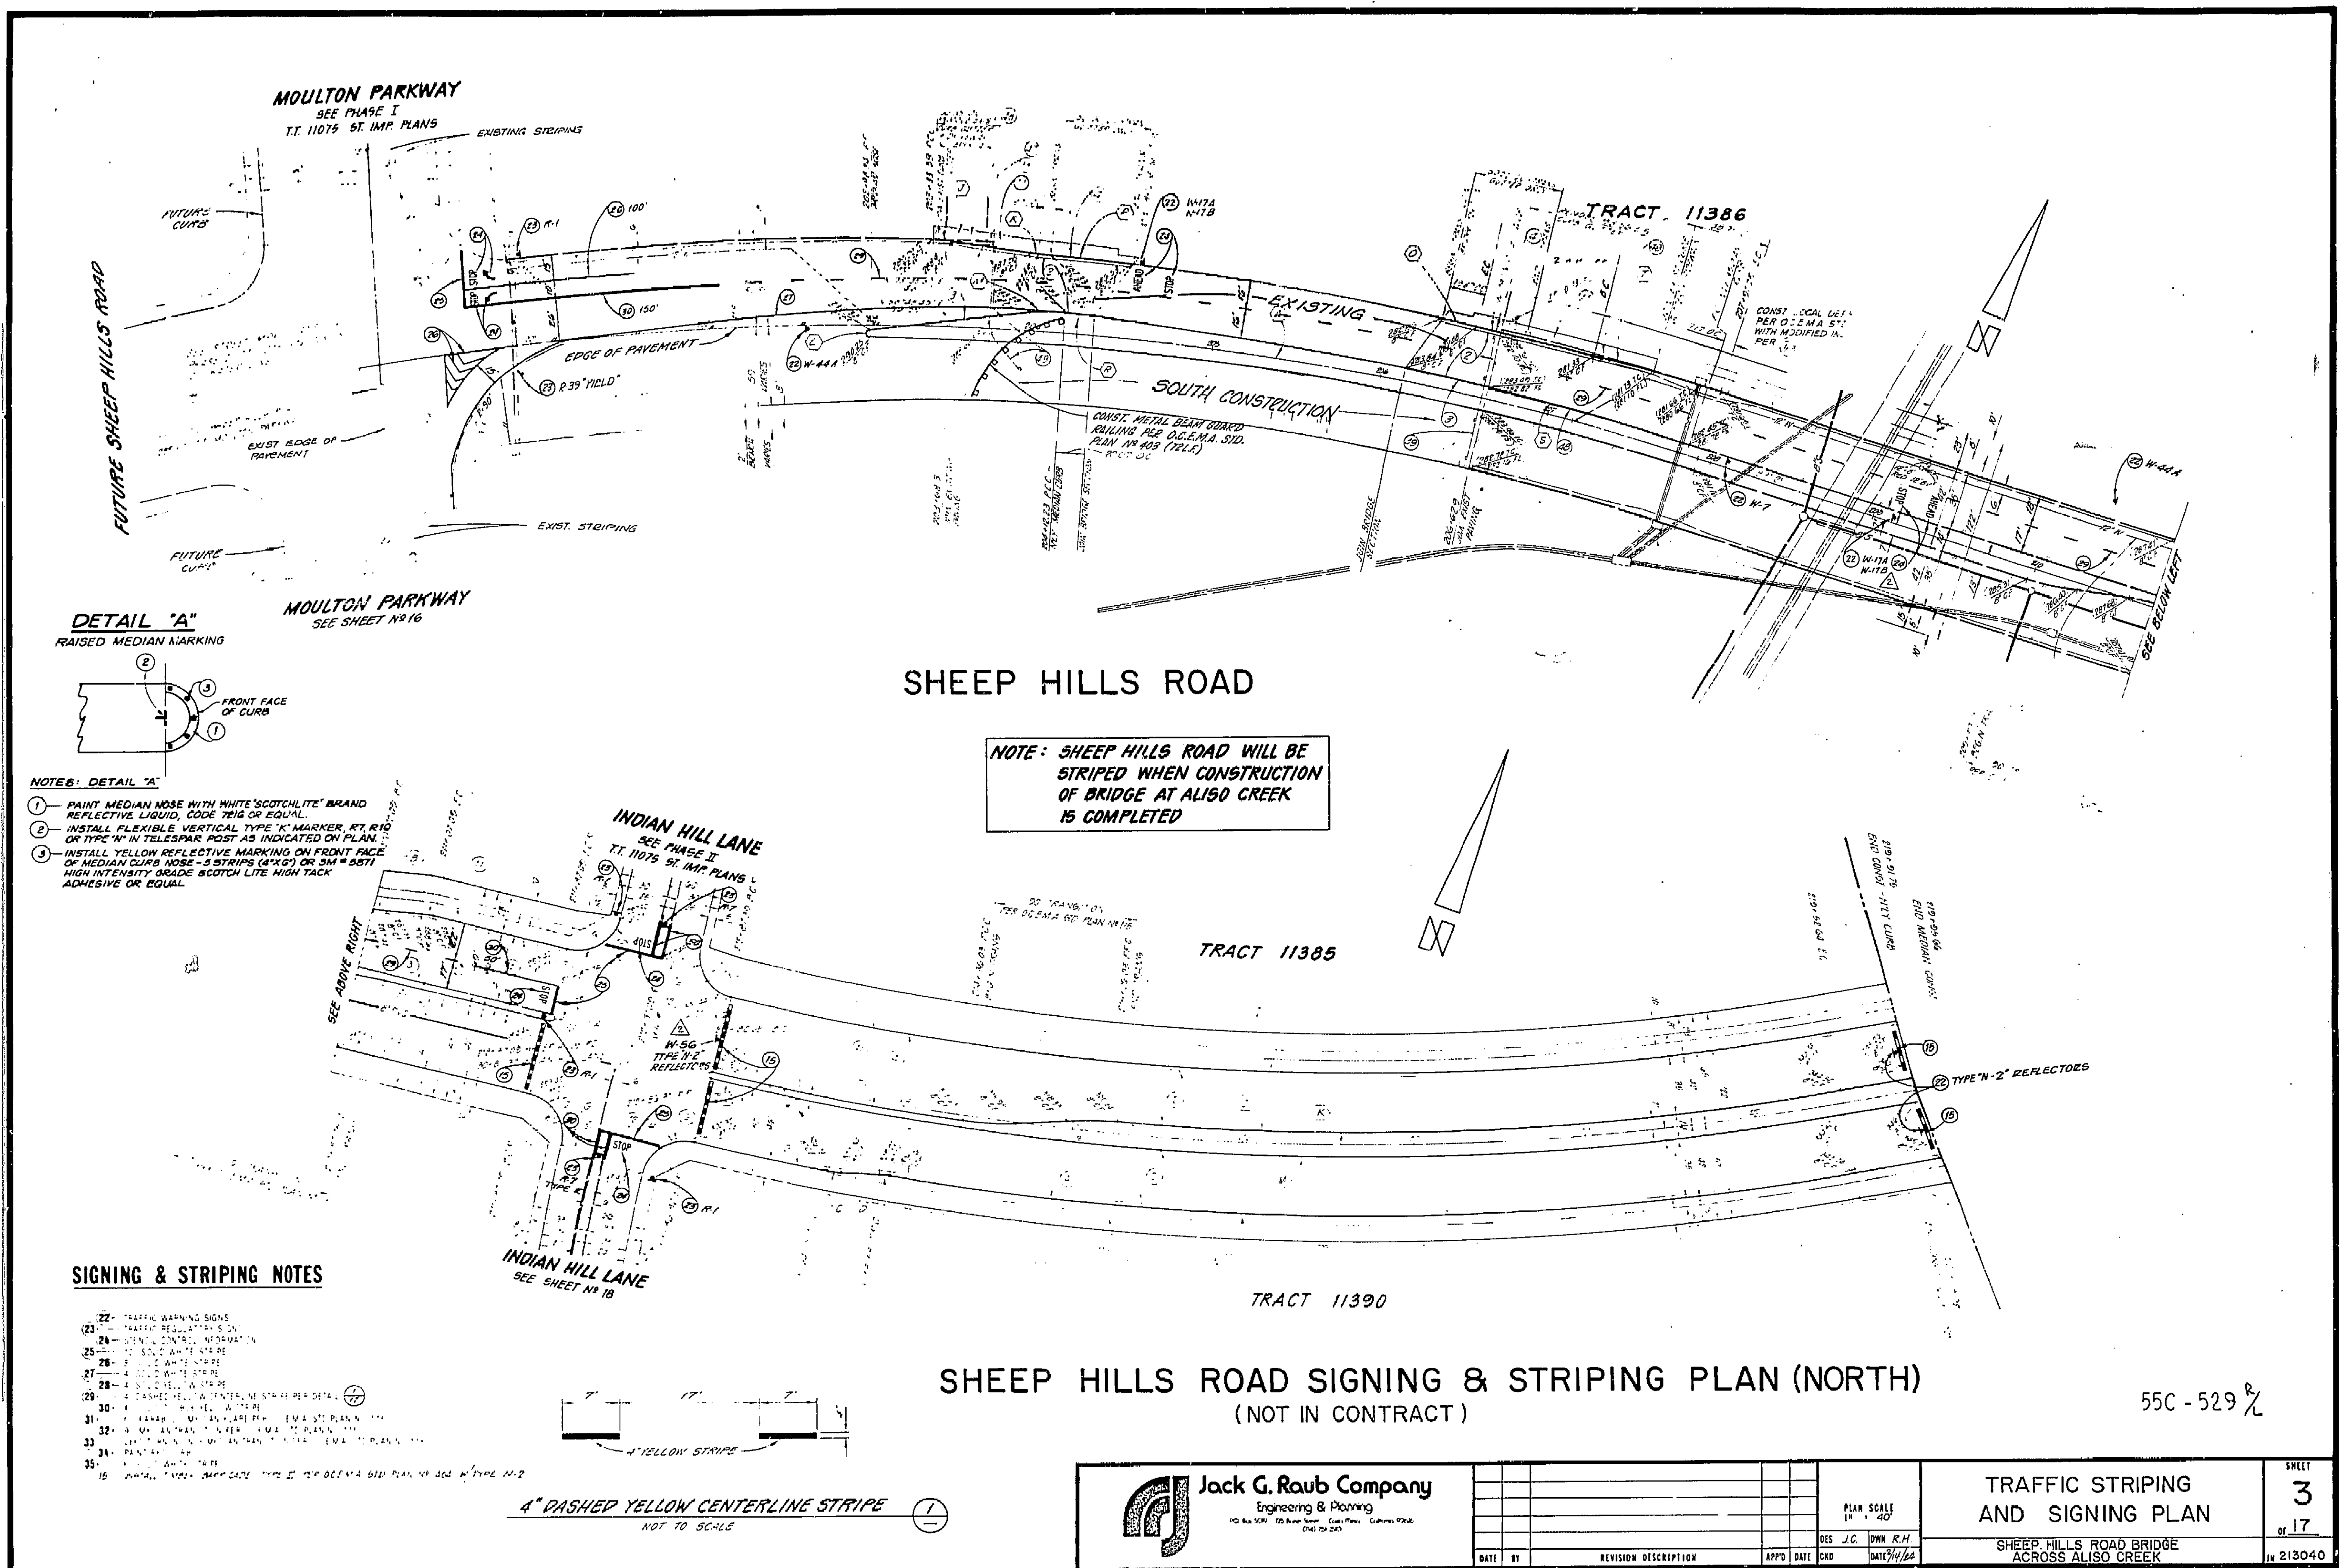

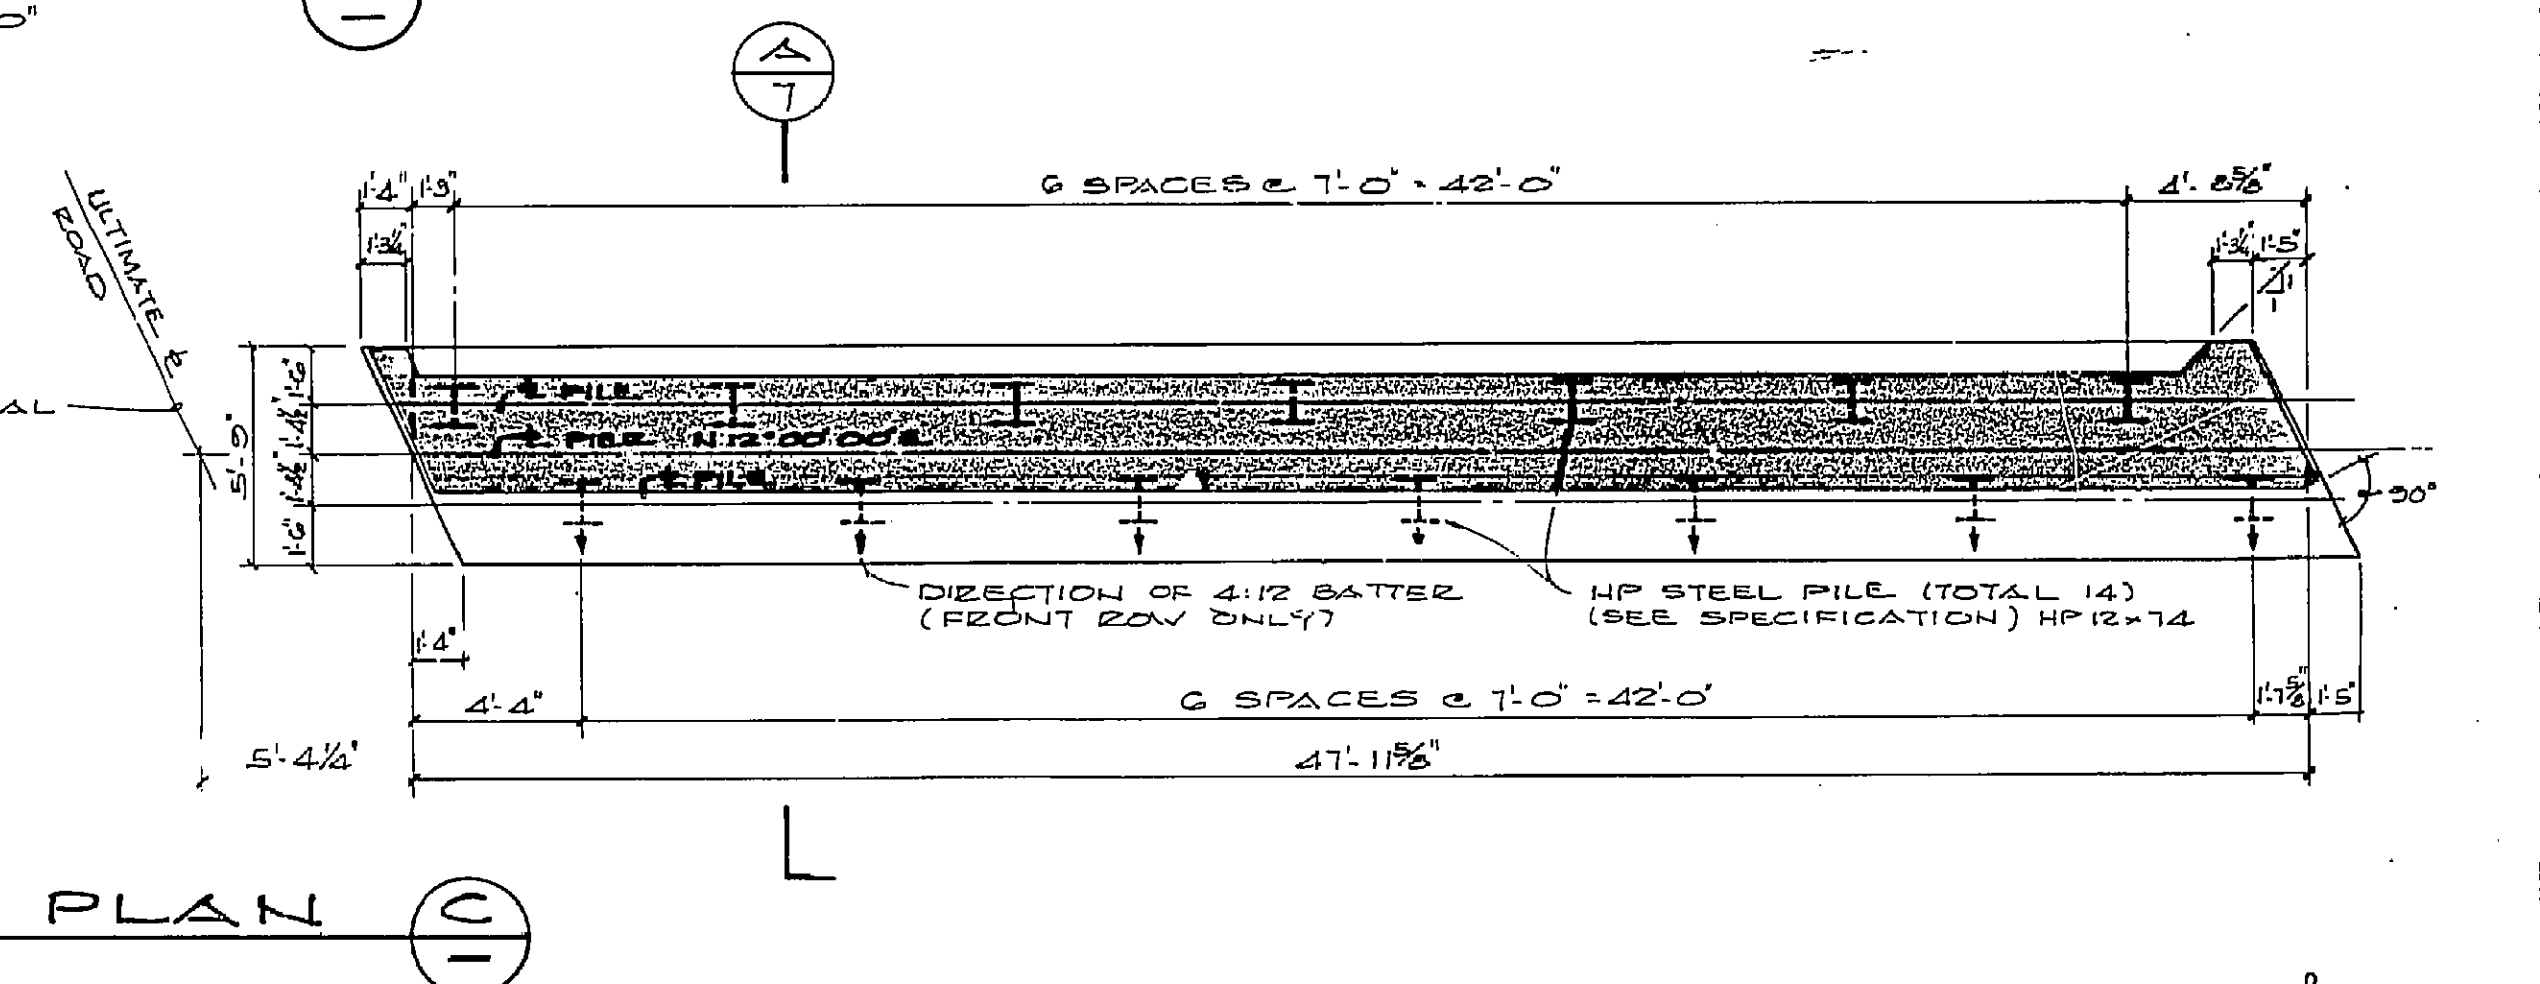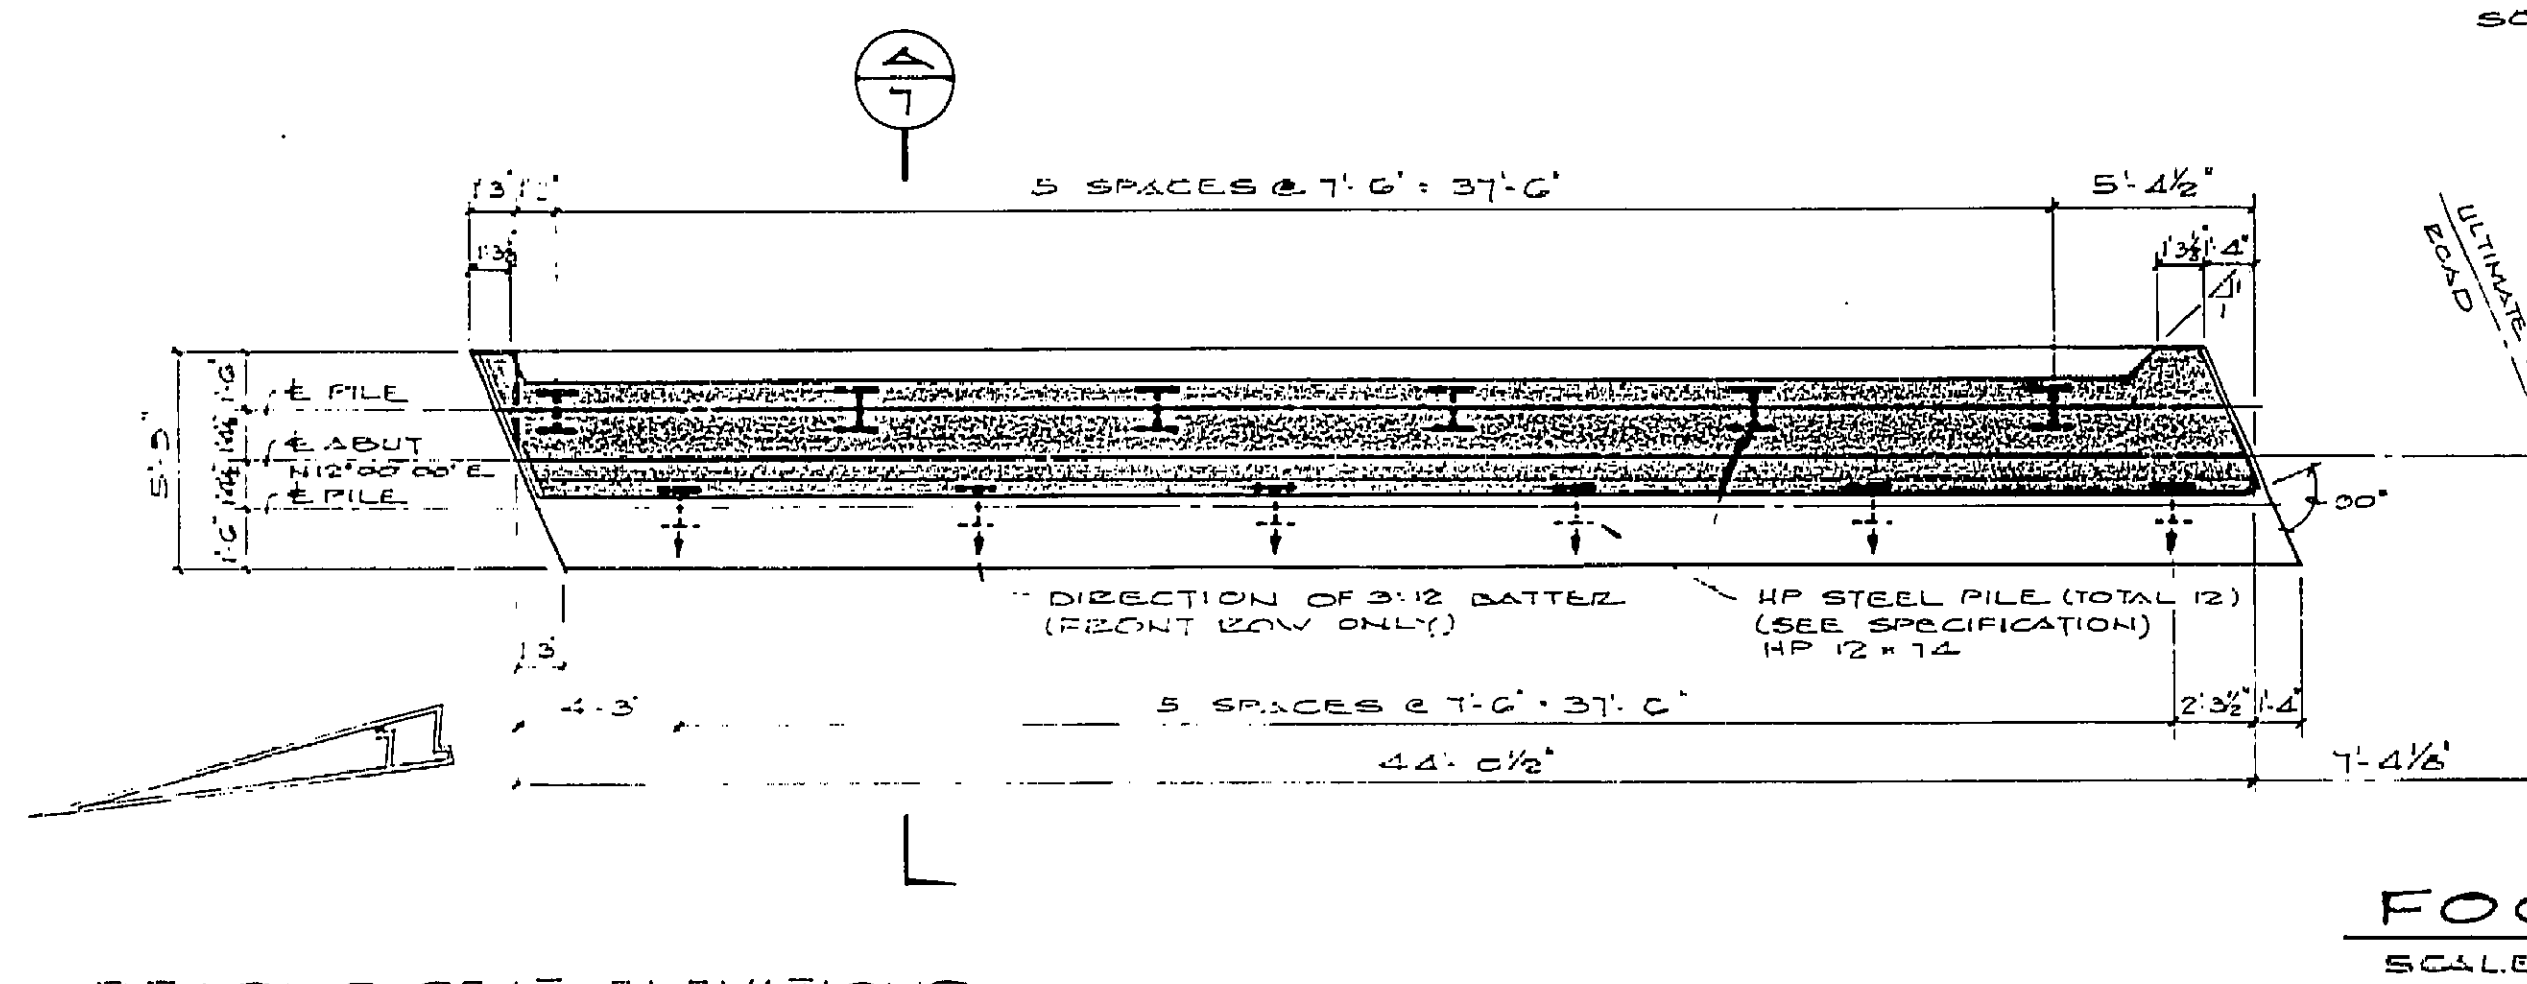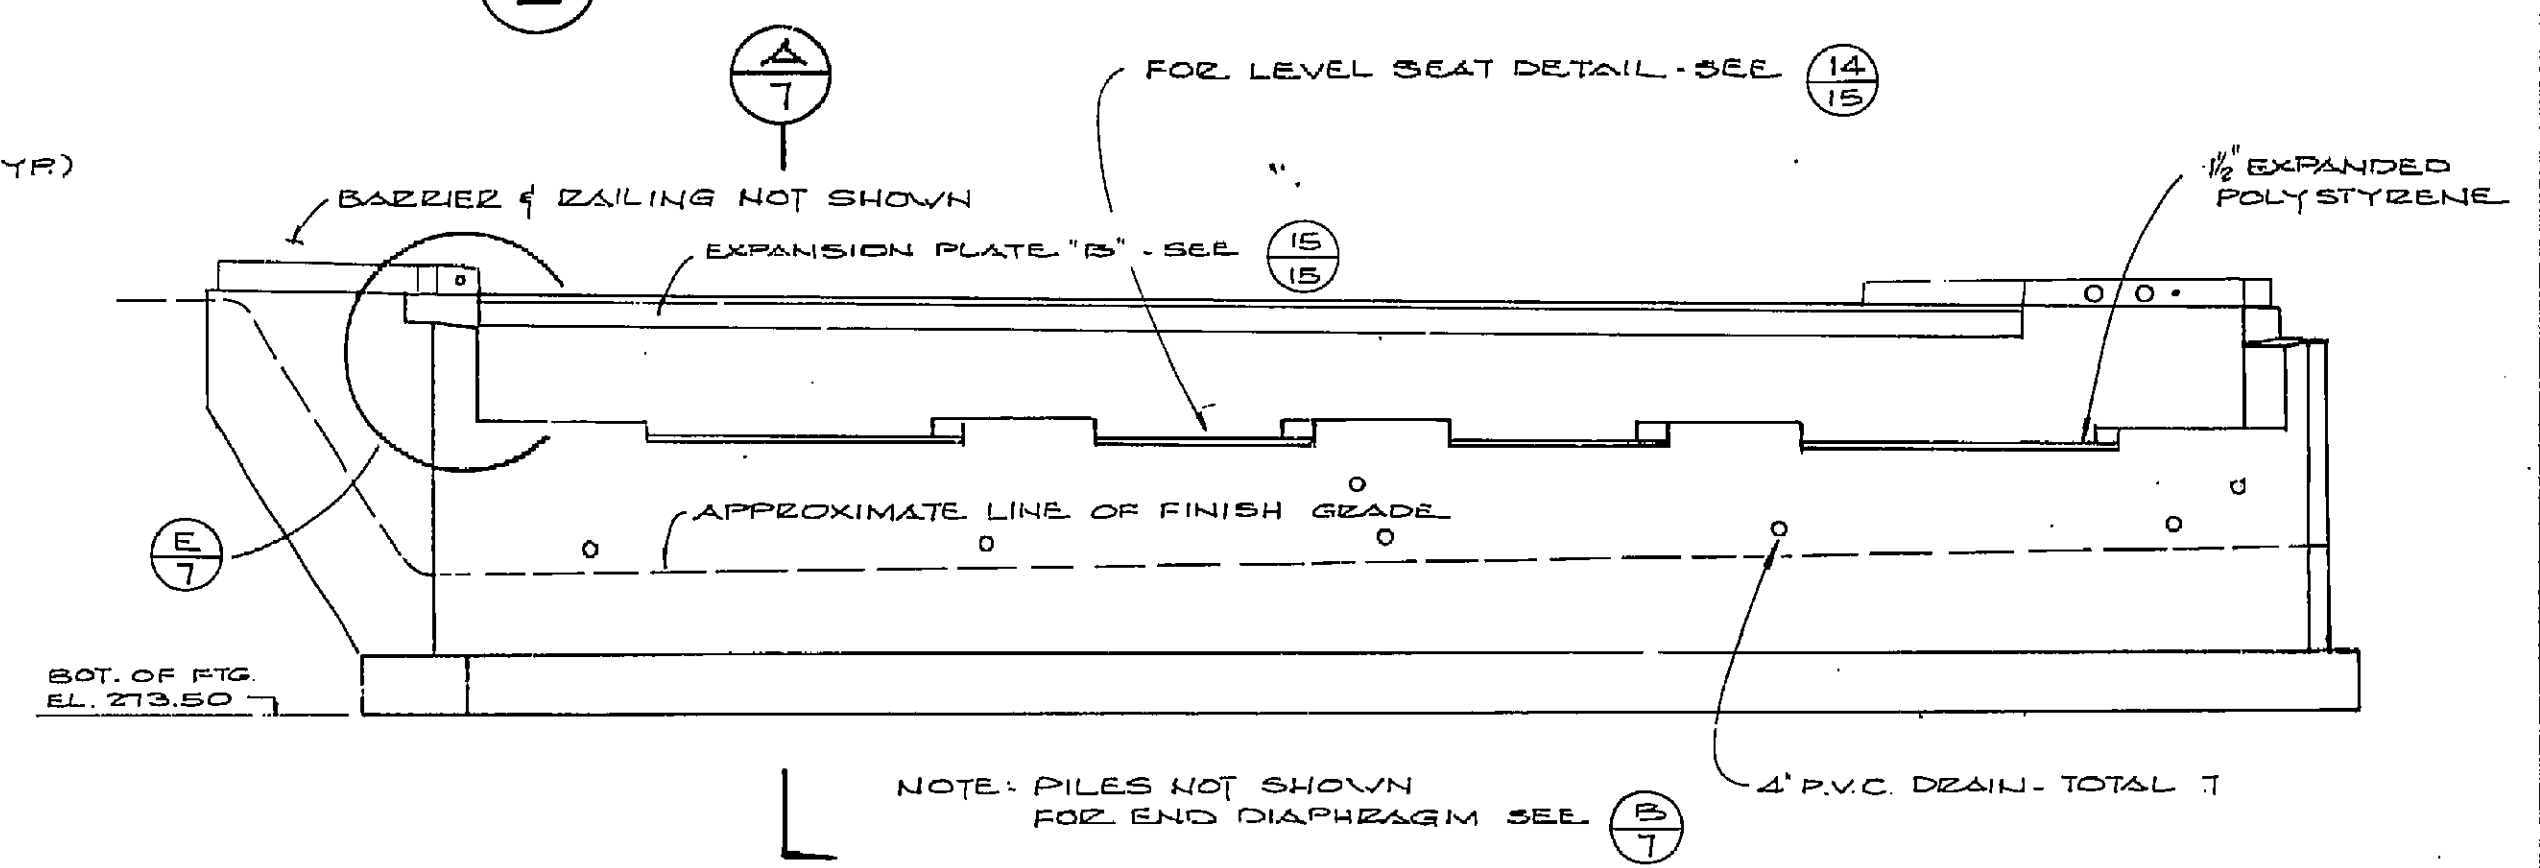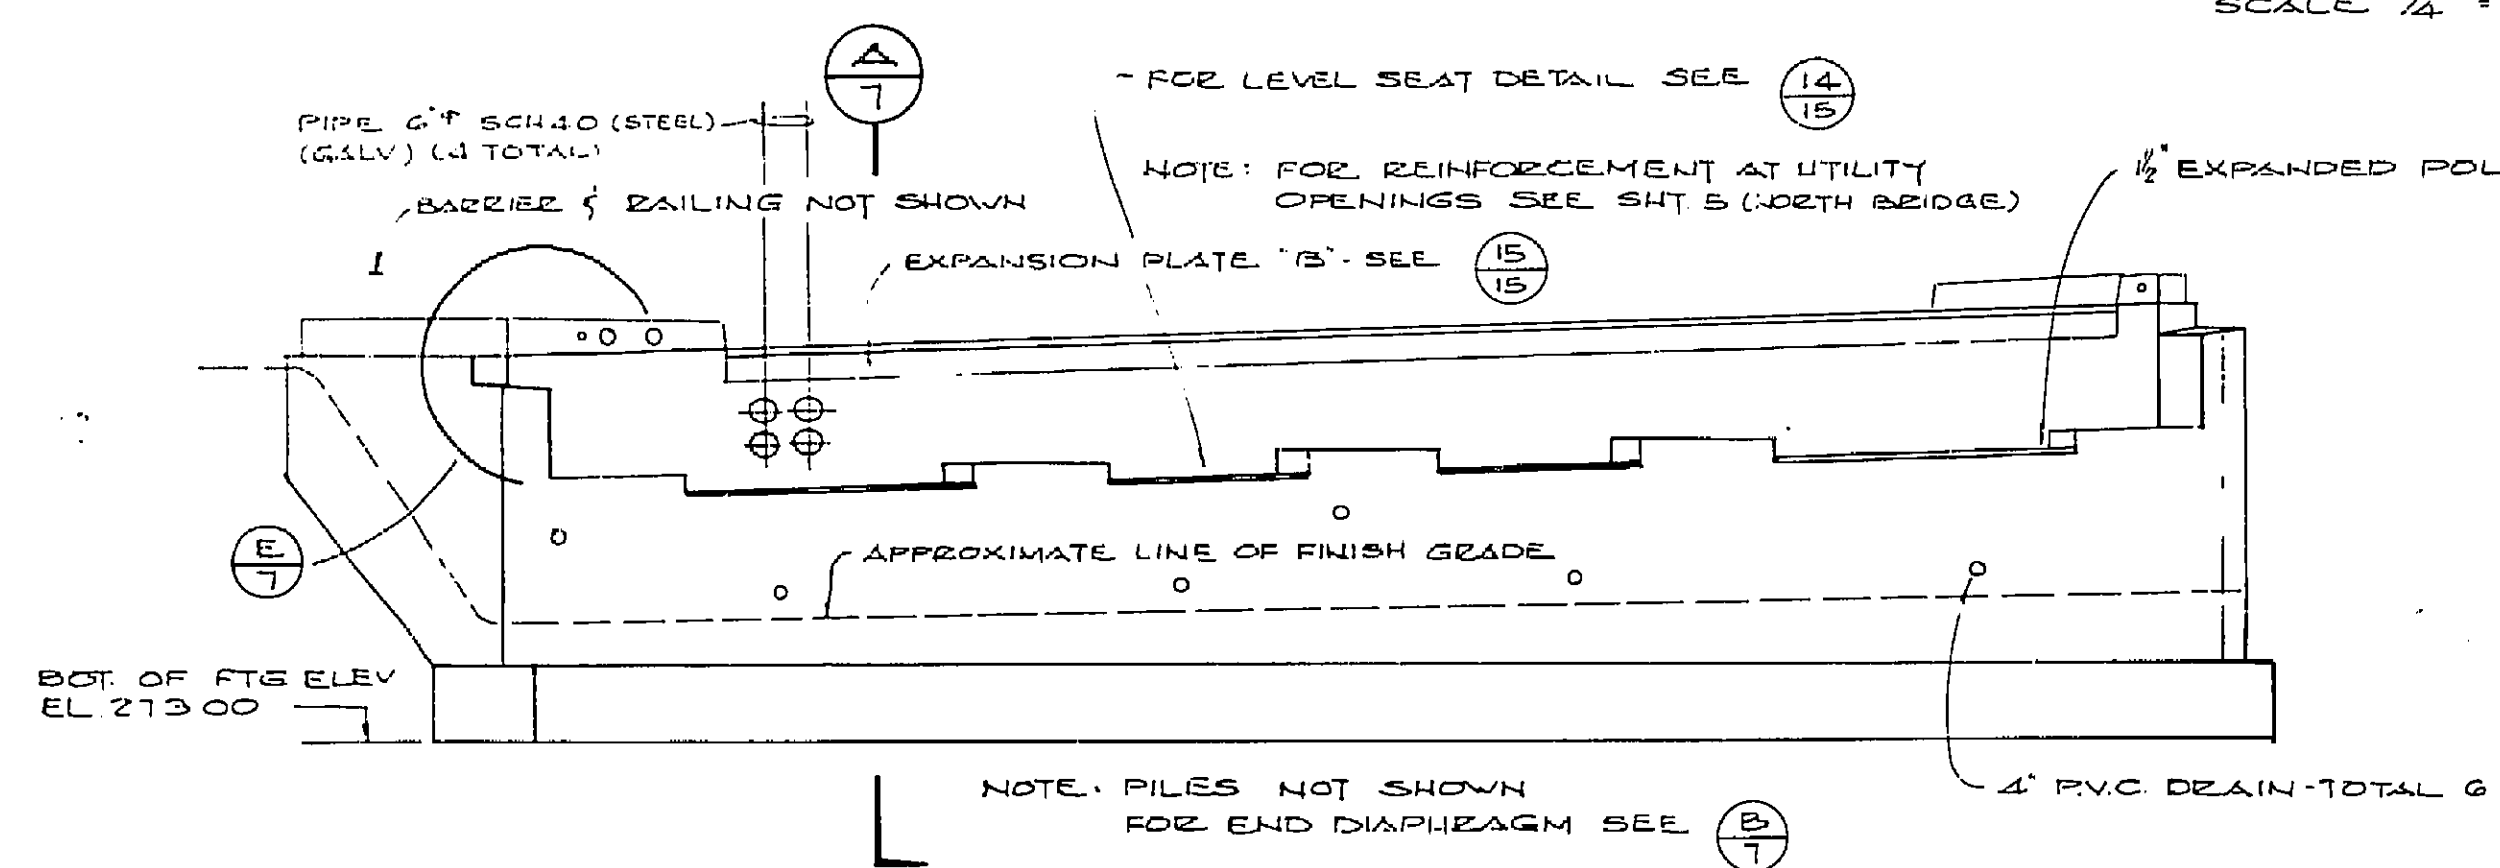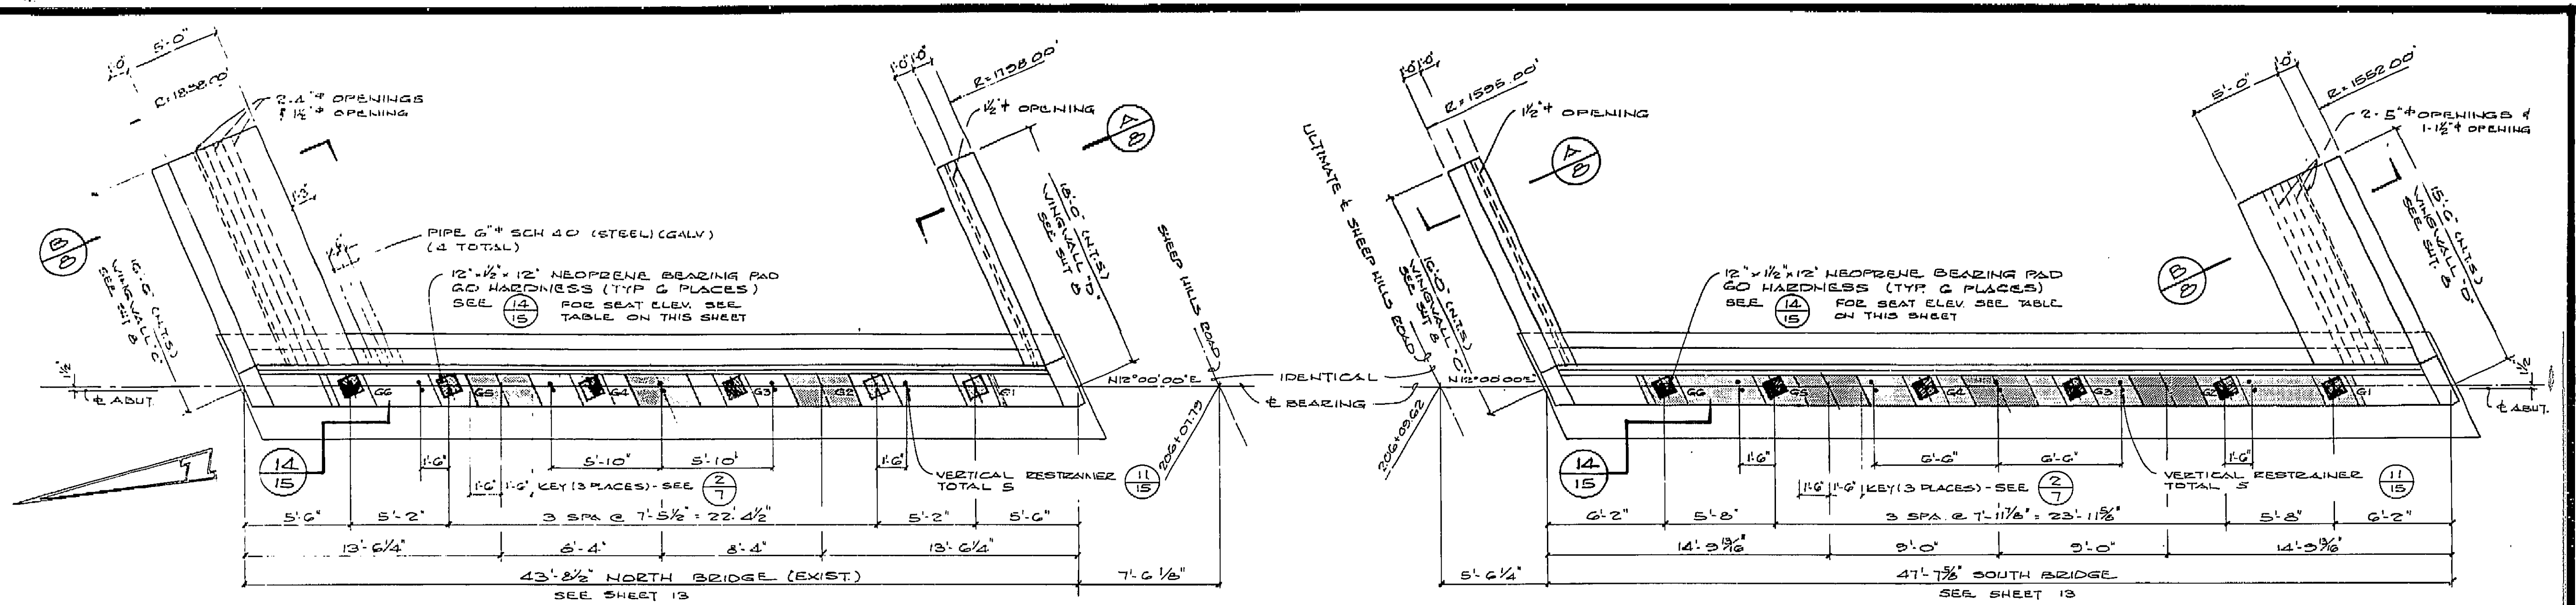

BEARING SEAT ELEVATIONS

ABUTMENT 4	BRIDGE	BEARING SEAT ELEVATION
1	240.00	240.00
2	240.00	240.00
Jack G. Raub Company
Engineering & Planning
213040

DATE	BY	REVISION DESCRIPTION	APPRO	DATE

ABUTMENT 4
PLAN & ELEVATION
SHEEP HILLS ROAD BRIDGE
ACROSS ALISO CREEK


6
OF 17
213040

1-6-88
Donald Blackford
MICROFILM SERVICES

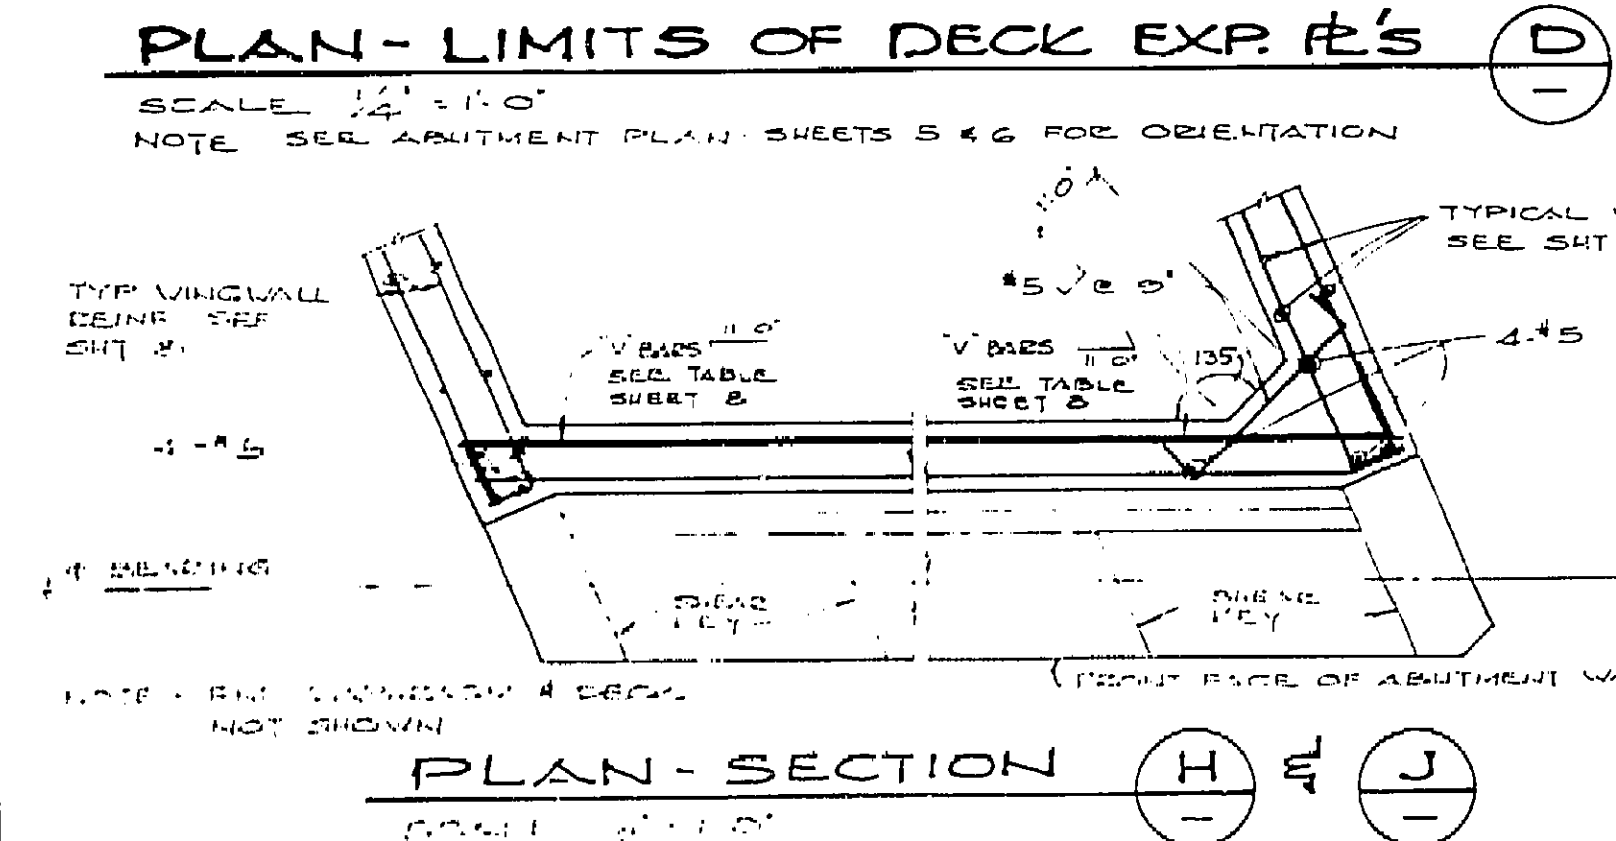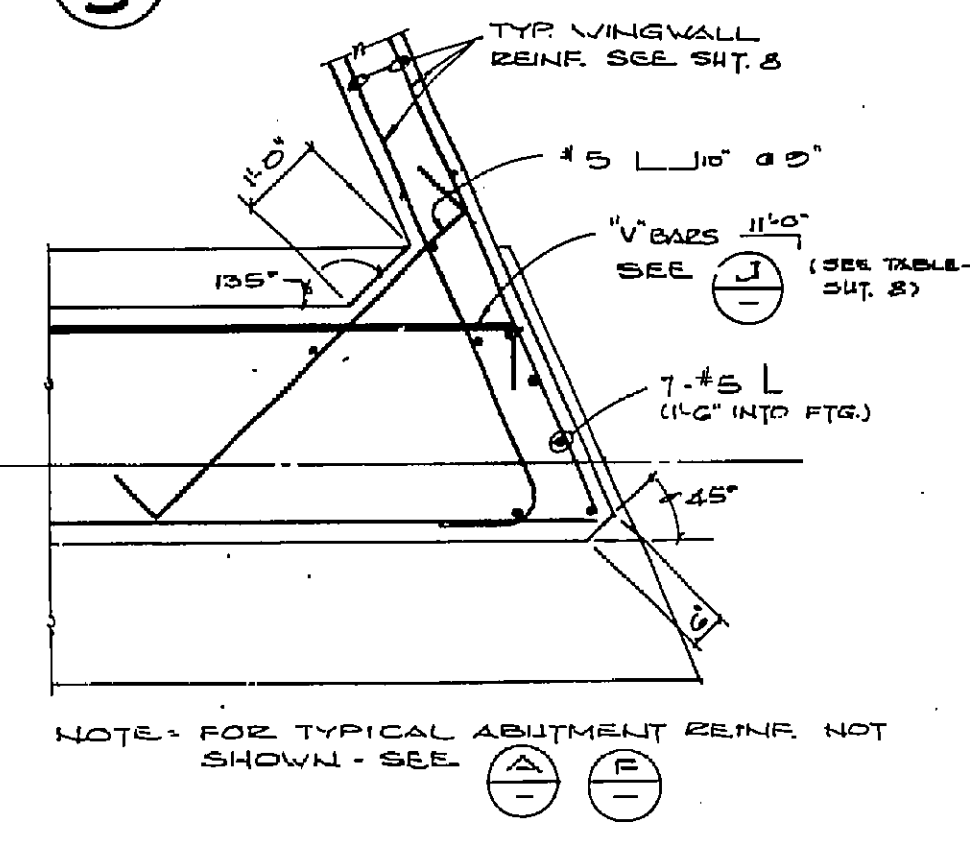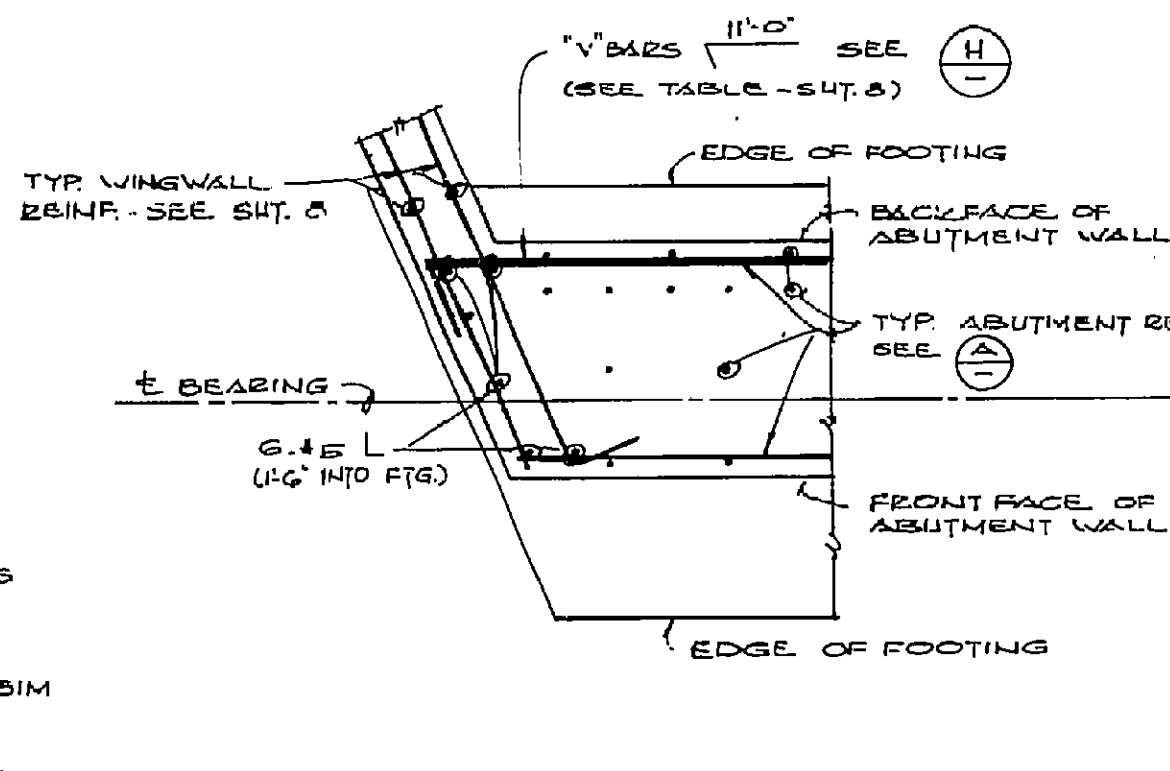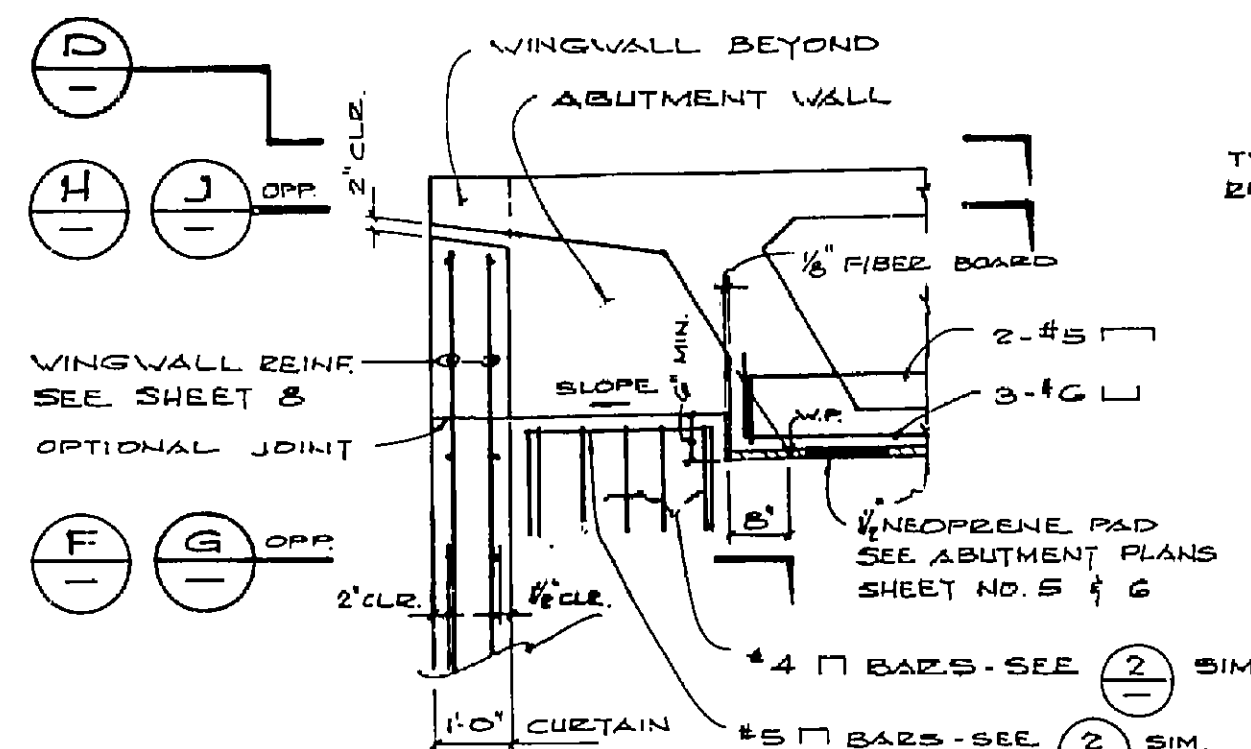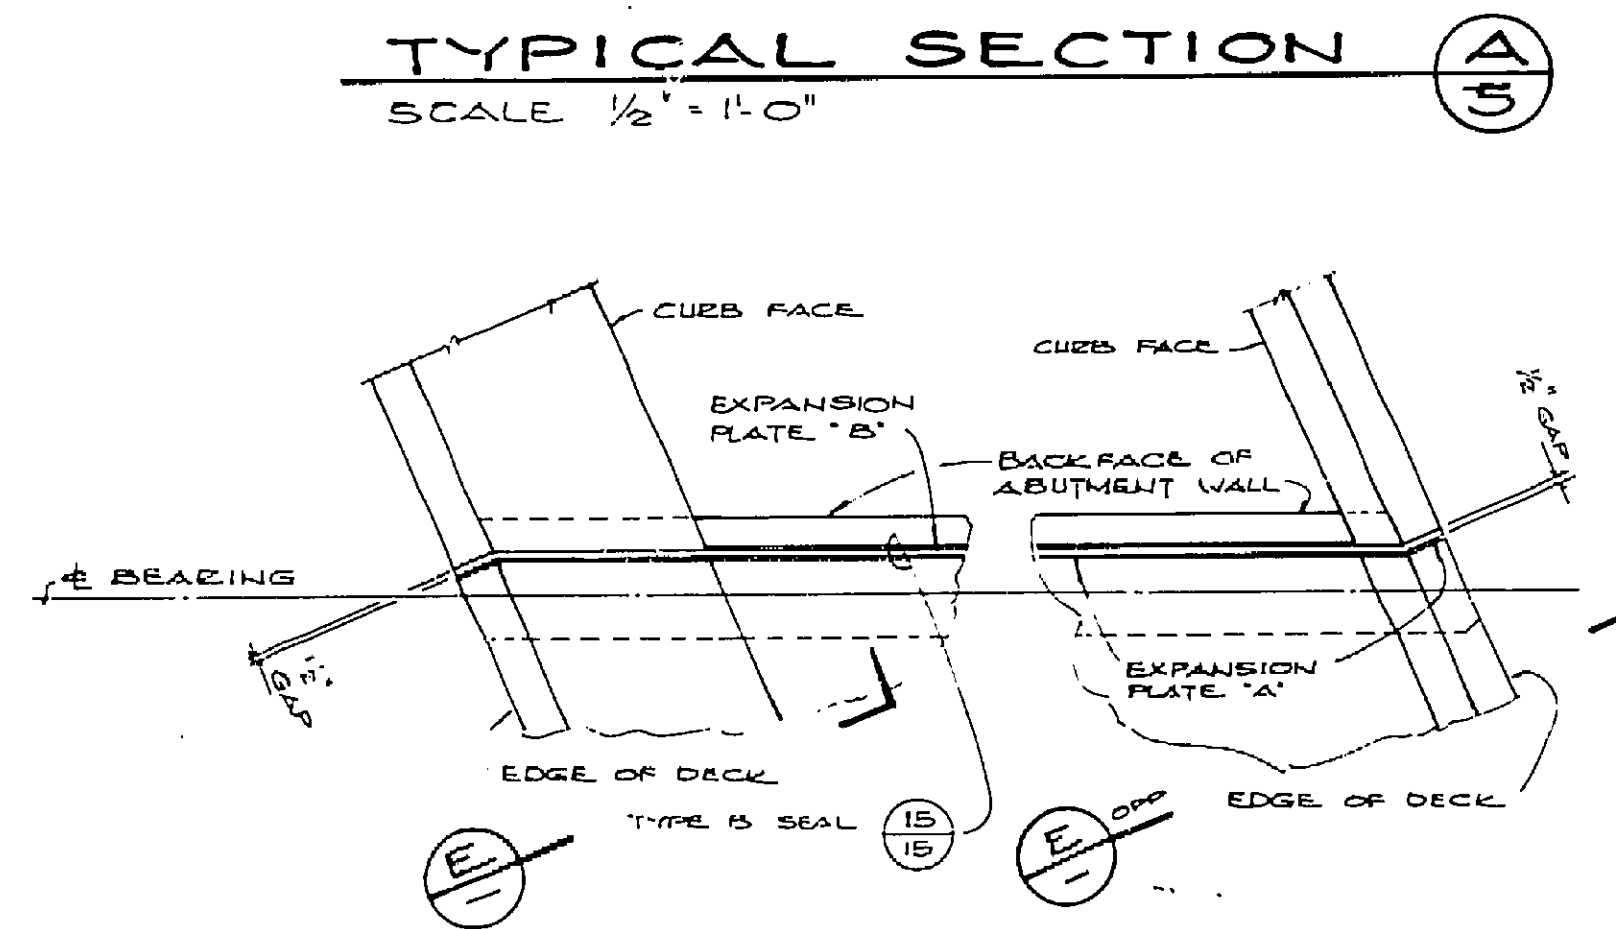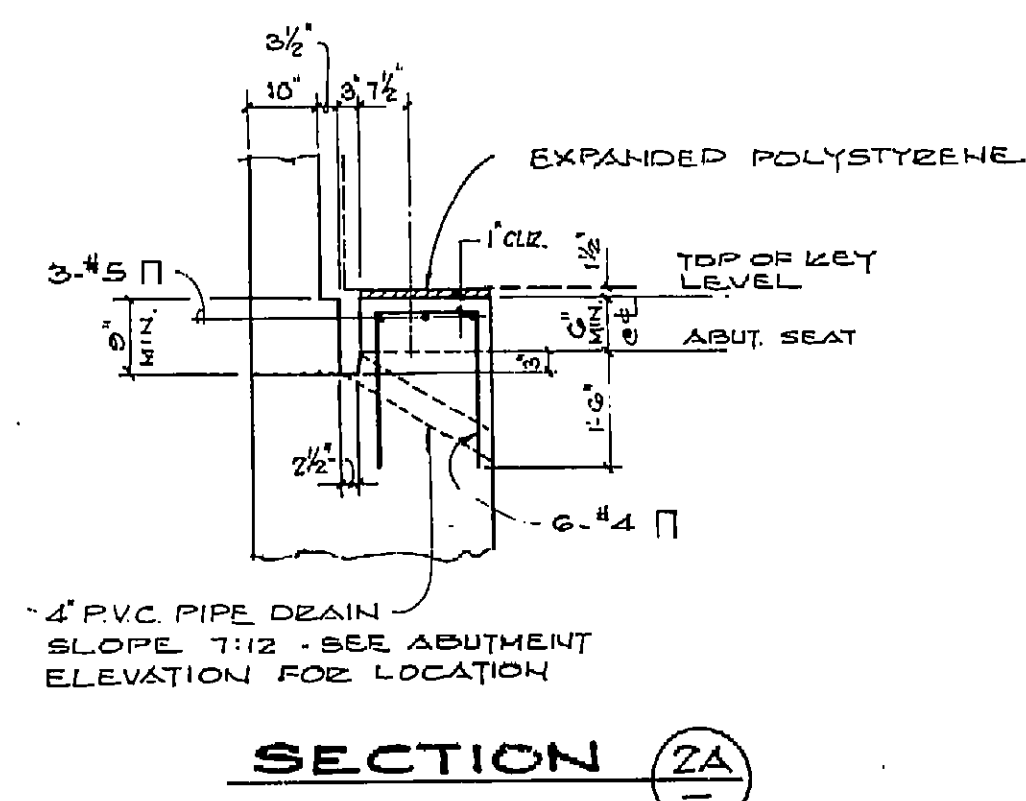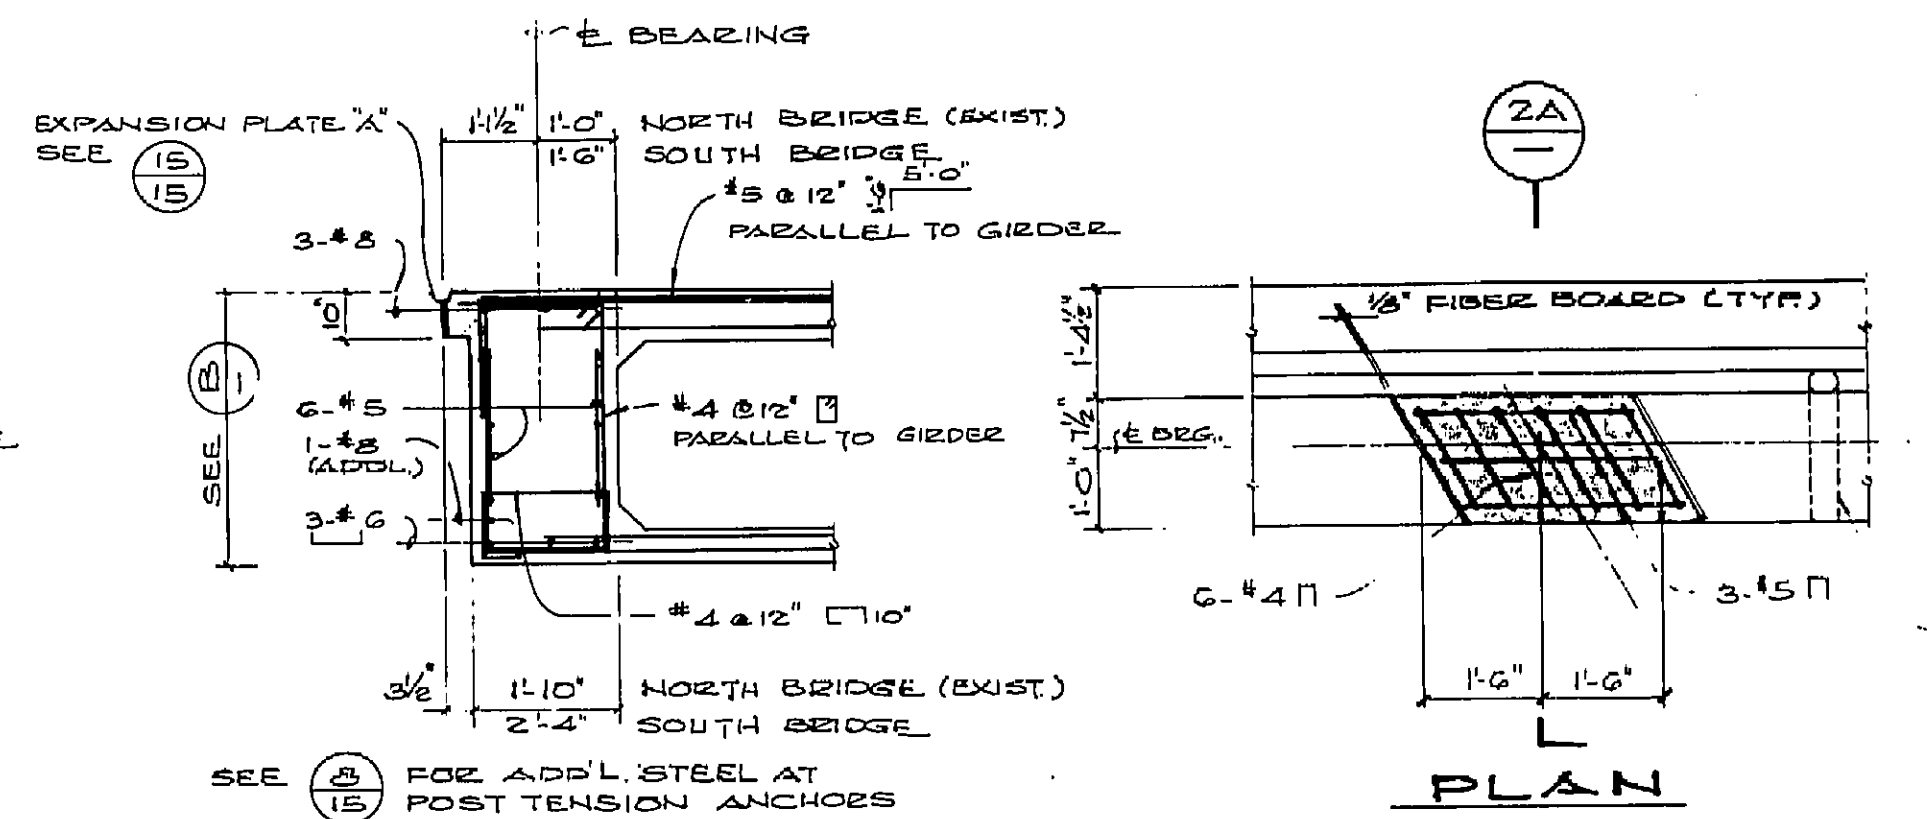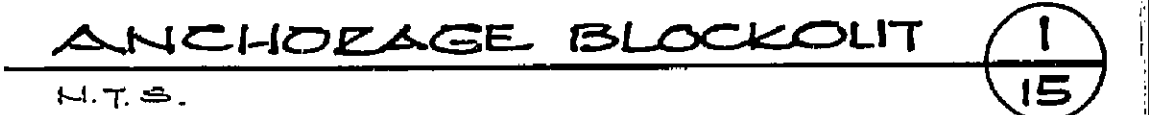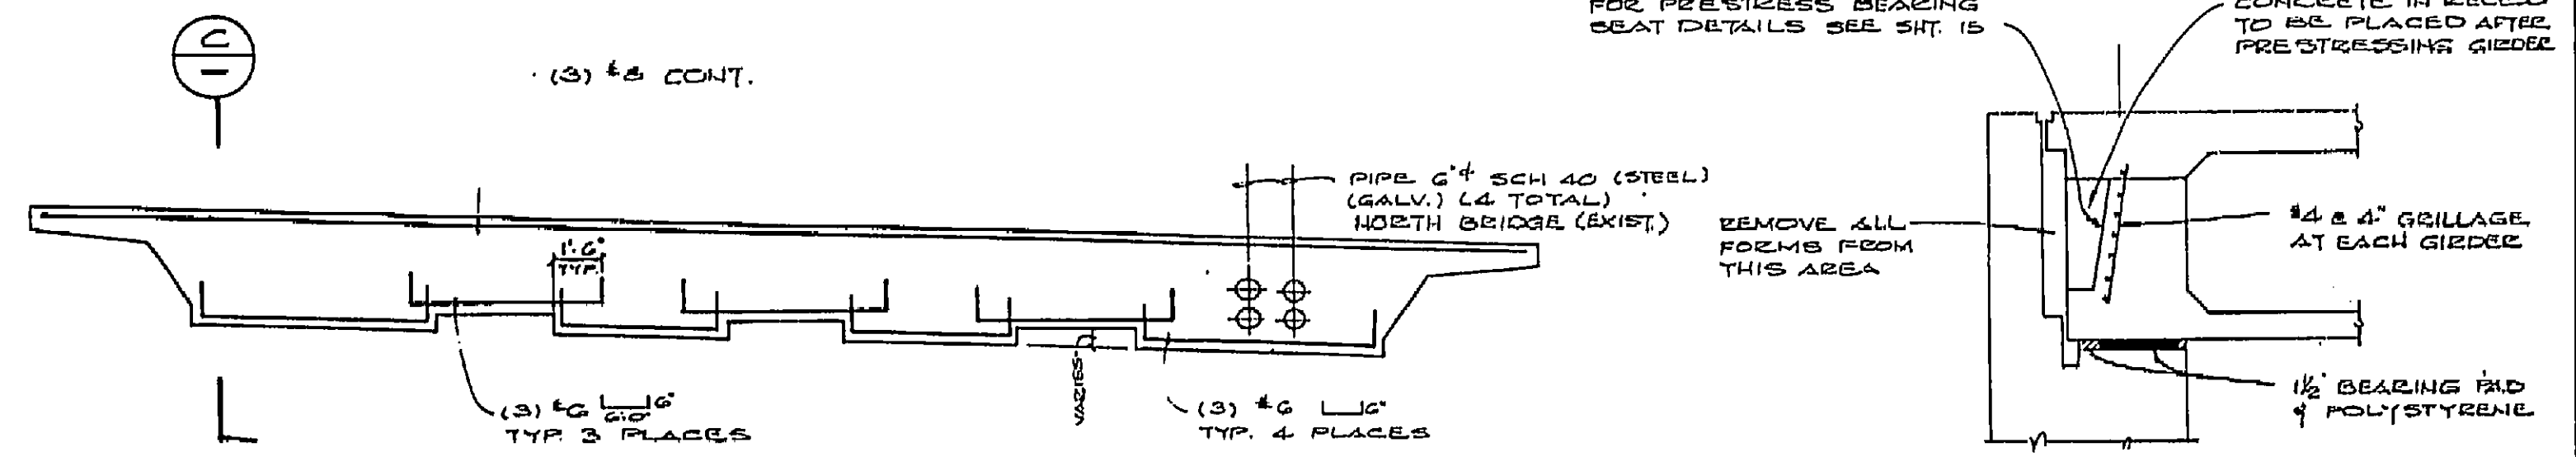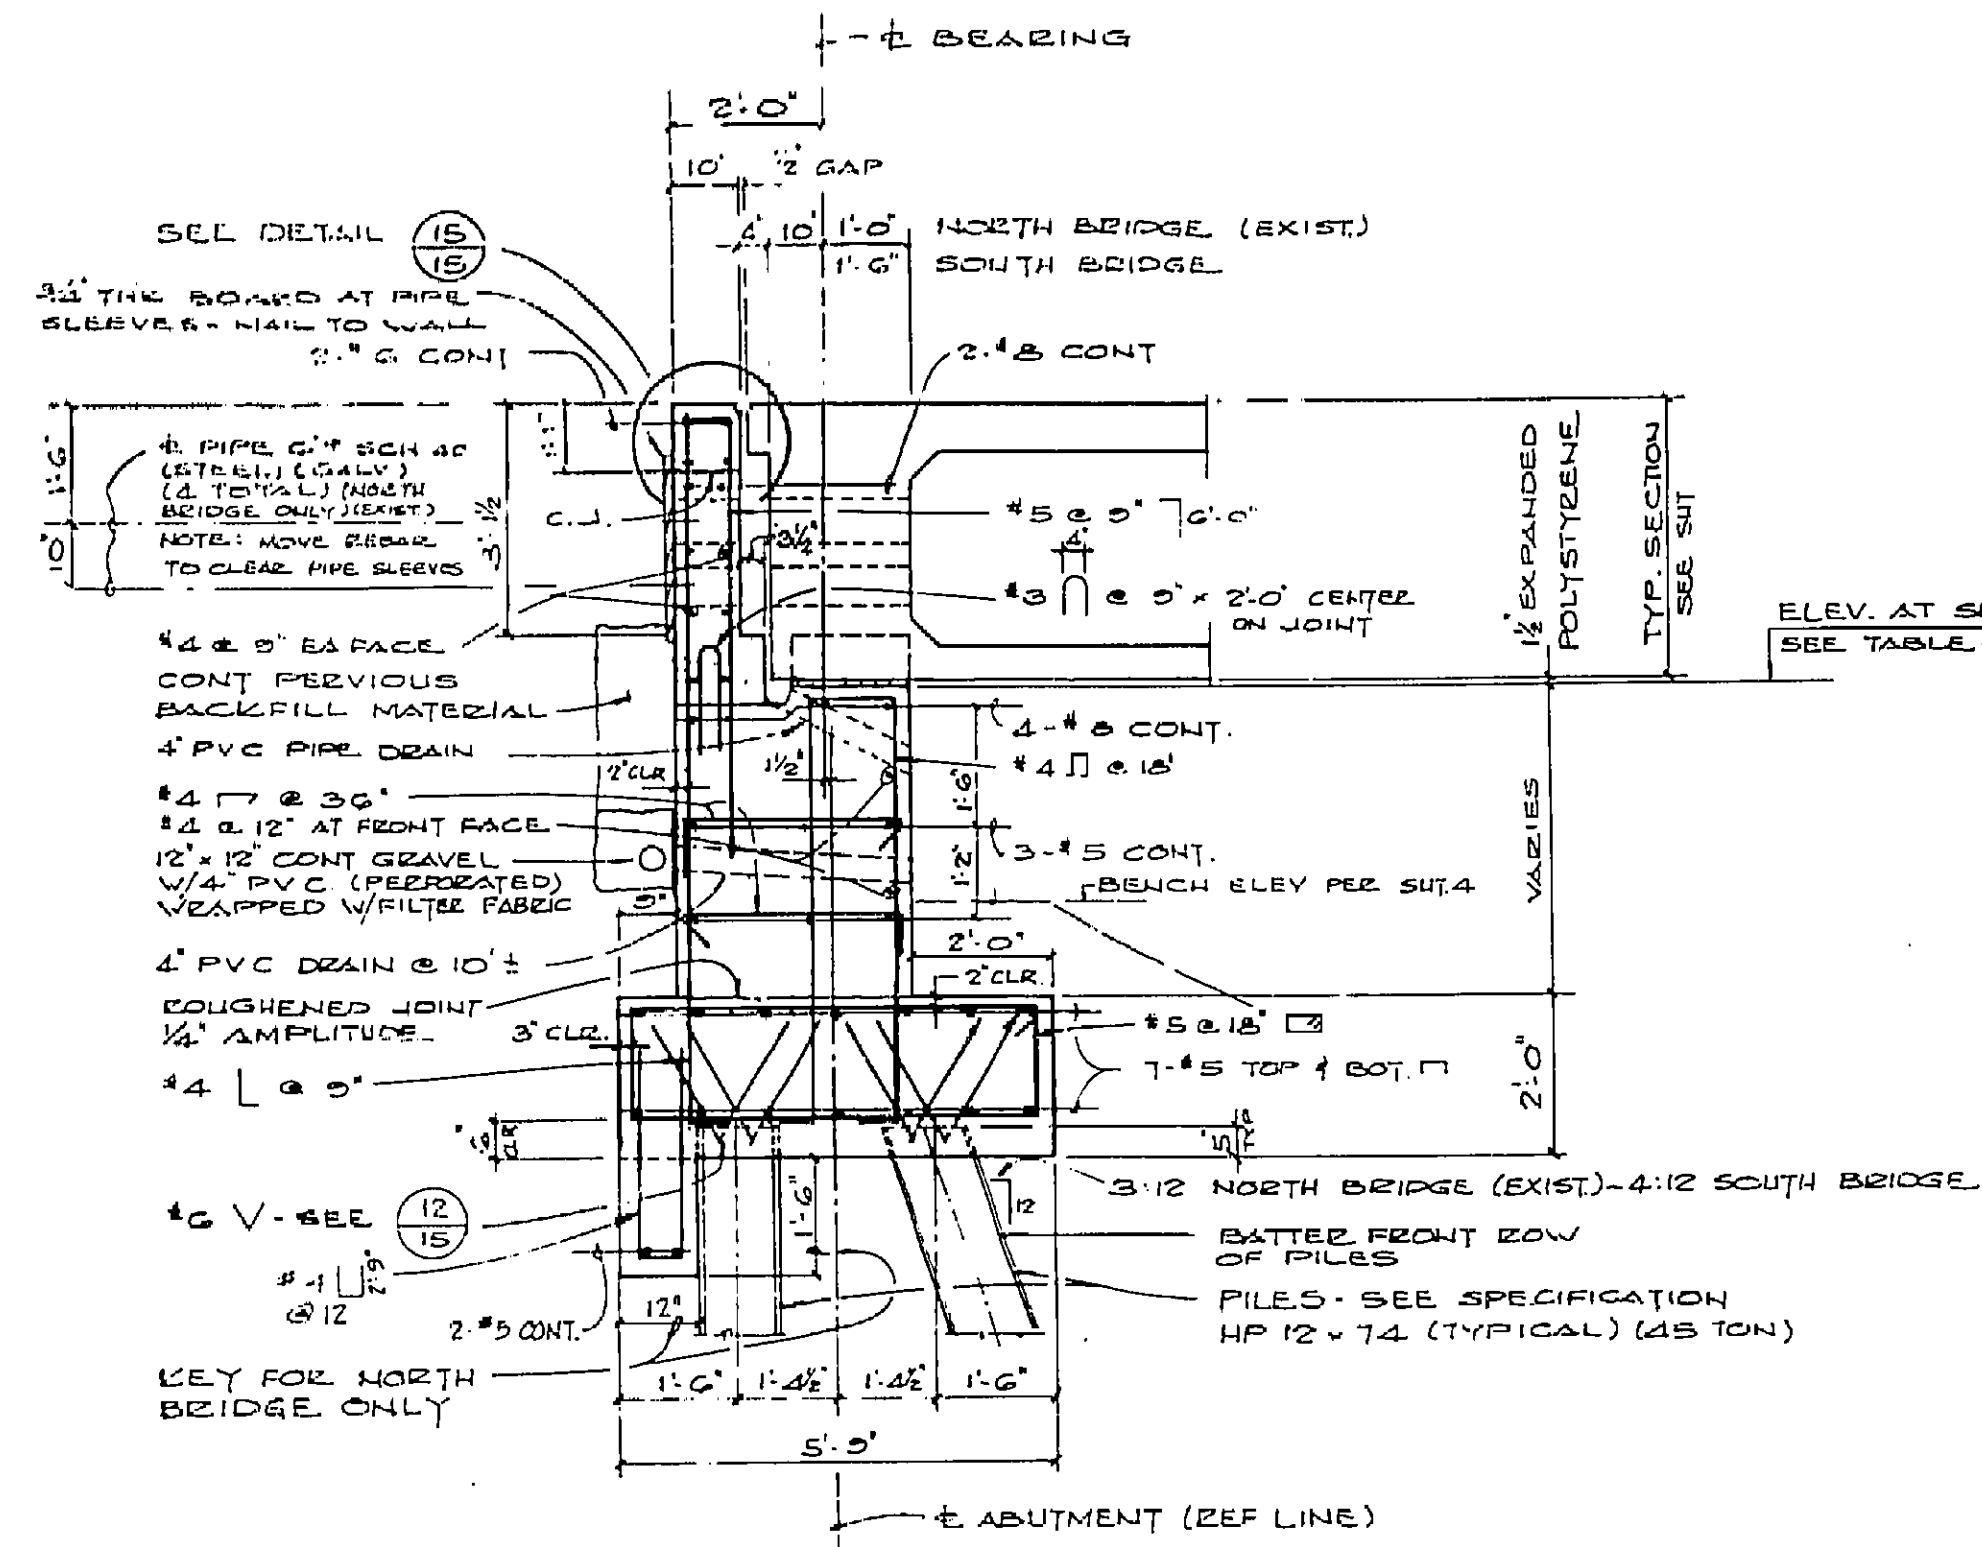


Jack C. Raub Company Engineering & Planning 1000 N. 10th Street, Suite 100, San Jose, CA 95128		PLAN SCALE DES. J.C. R. DWN T.U. CHK. M.D.C. DATE 7/14/88	ABUTMENT SECTIONS & DETAILS SHEEP HILLS ROAD BRIDGE ACROSS ALISO CREEK	SHEET 7 OF 17 IN 213040
---	--	---	---	---


55C-529%

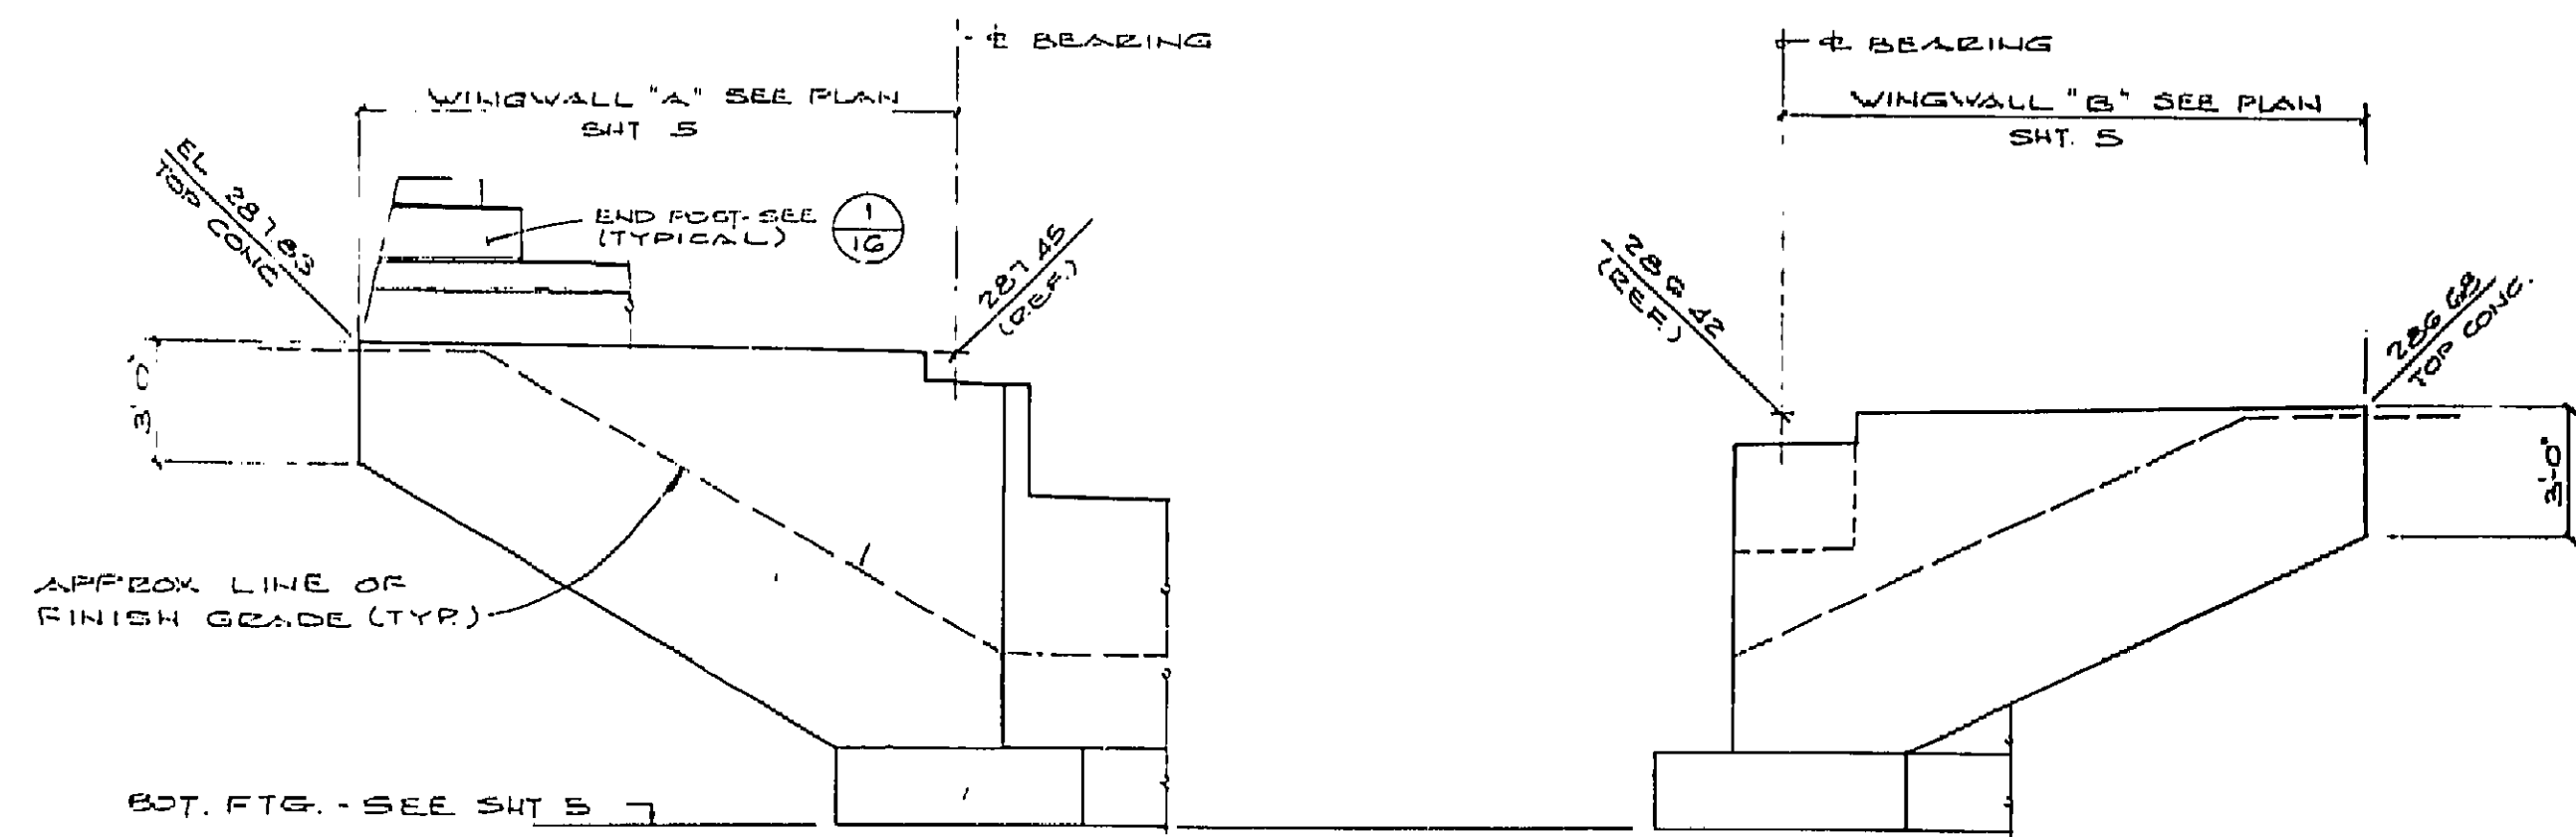


NORTH BRIDGE - ABUTMENT 1
SCALE 1/4" = 1'-0"

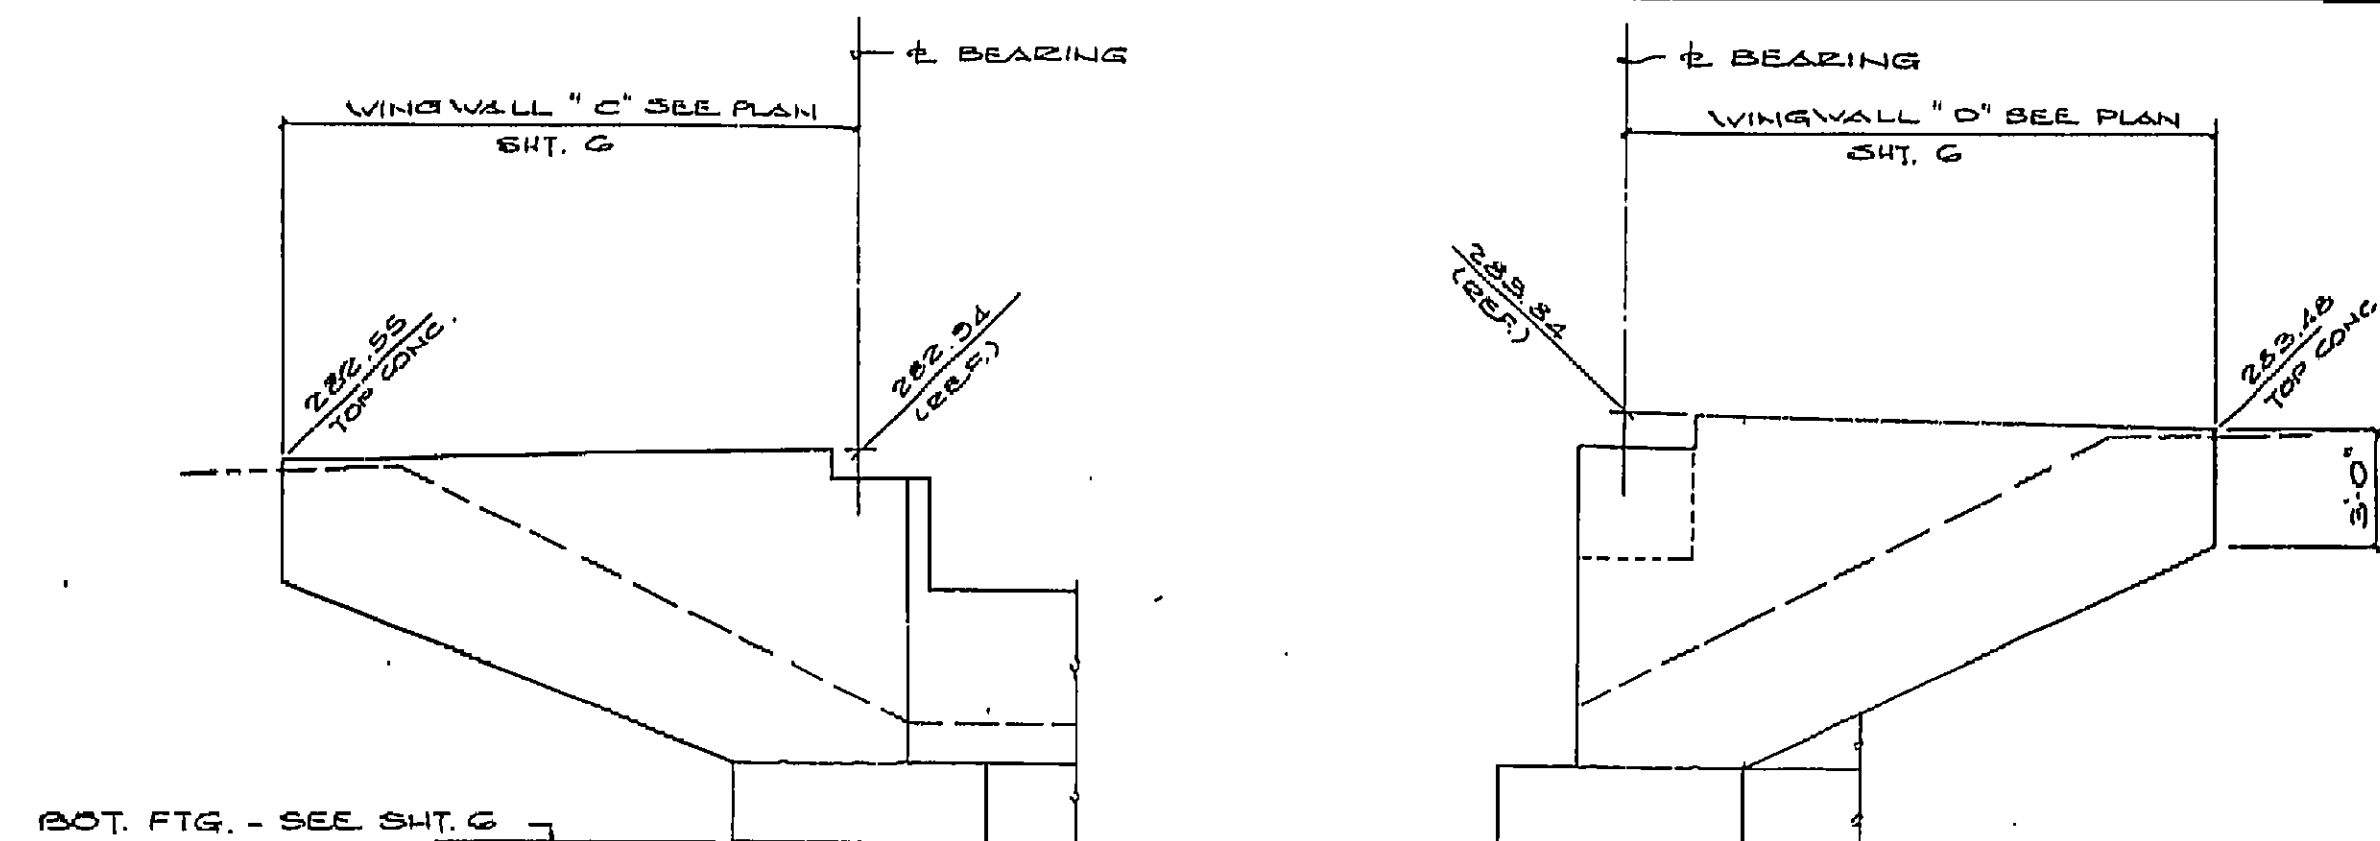


NORTH BRIDGE - ABUTMENT 4
SCALE 1/4" = 1'-0"

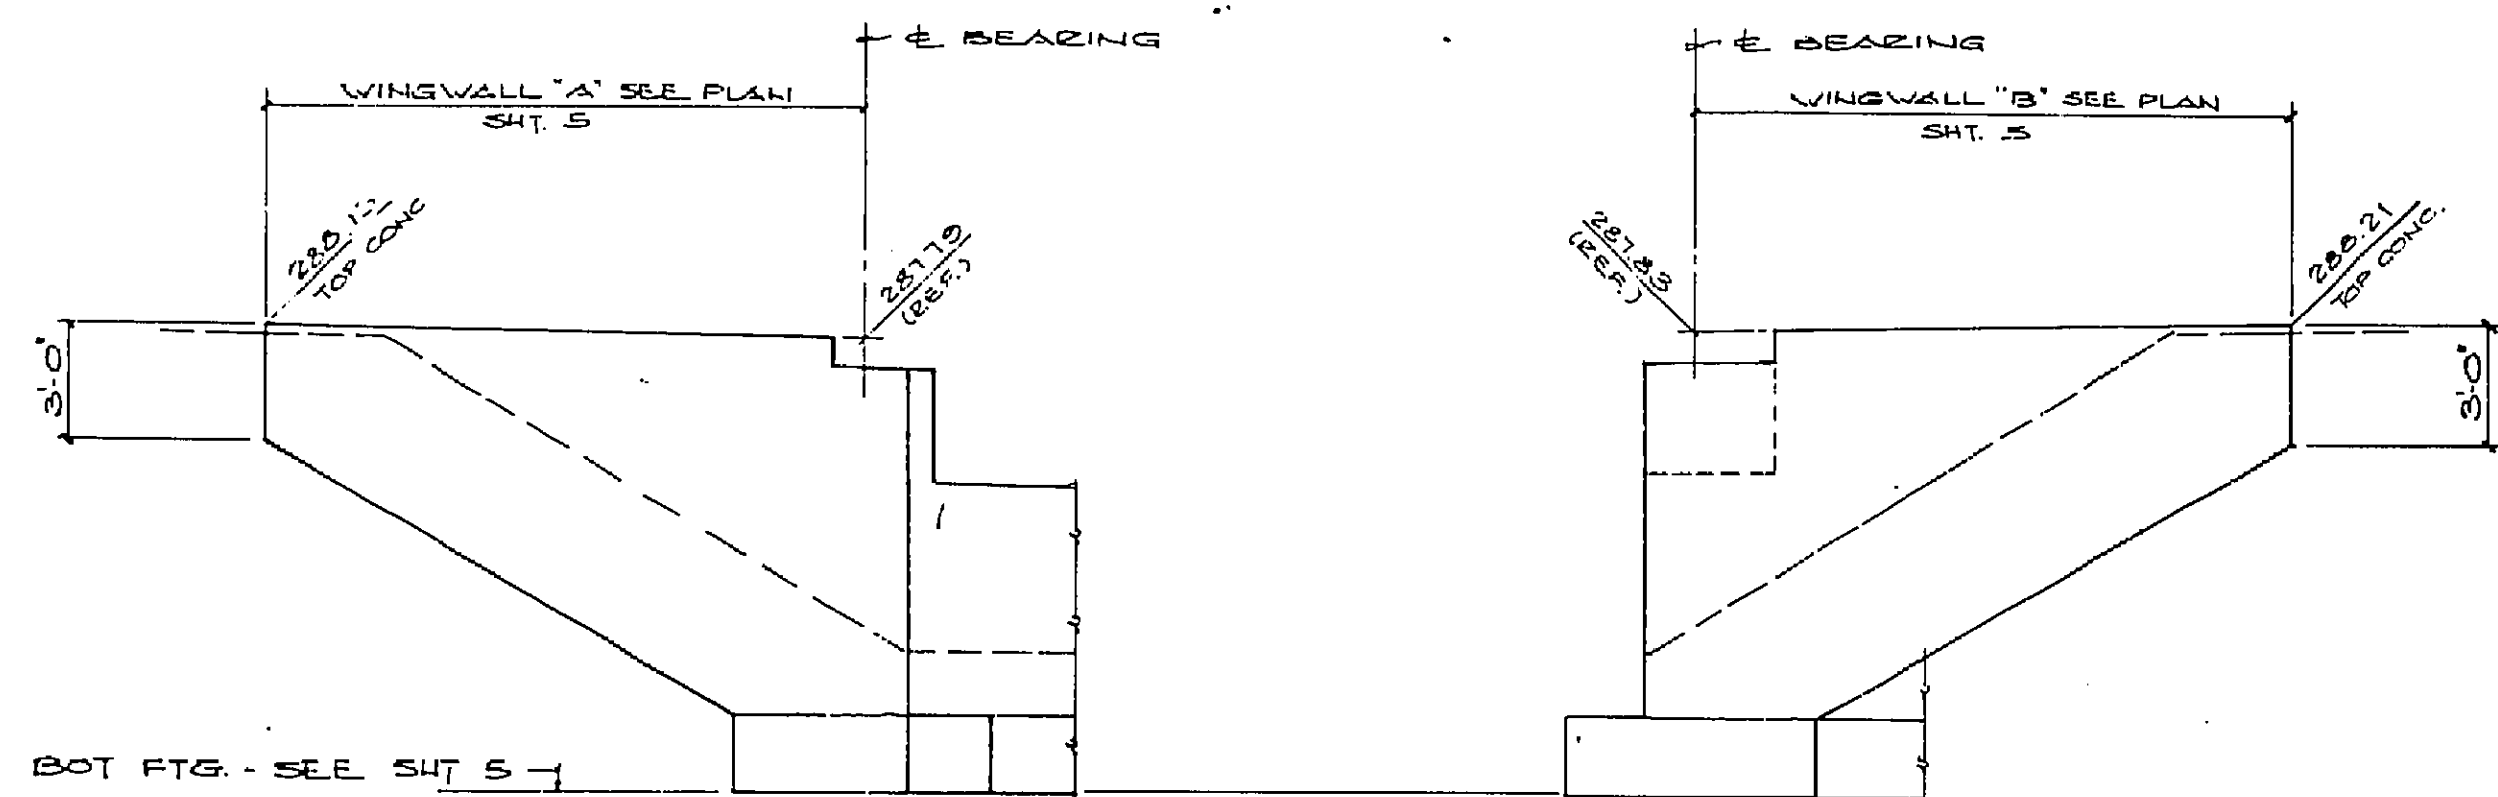

SOUTH BRIDGE - ABUTMENT 1
SCALE 1/4" = 1'-0"

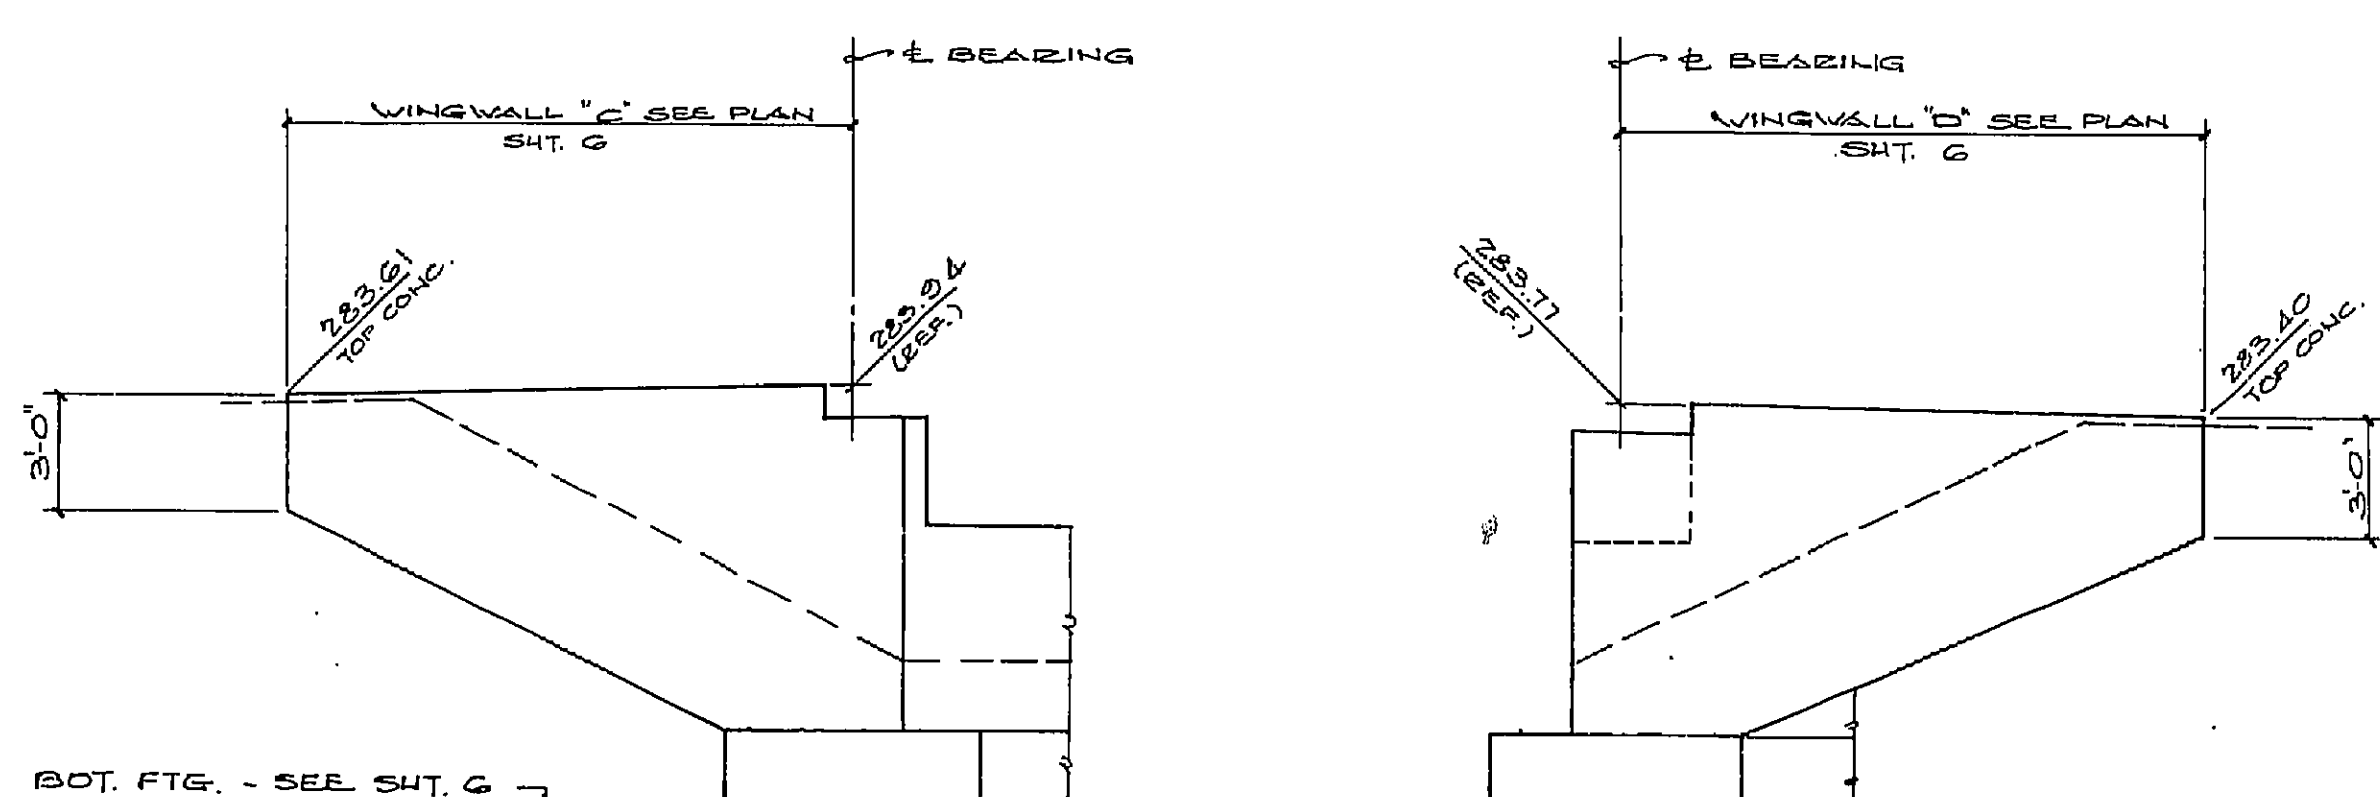

SOUTH BRIDGE - ABUTMENT 4
SCALE 1/4" = 1'-0"

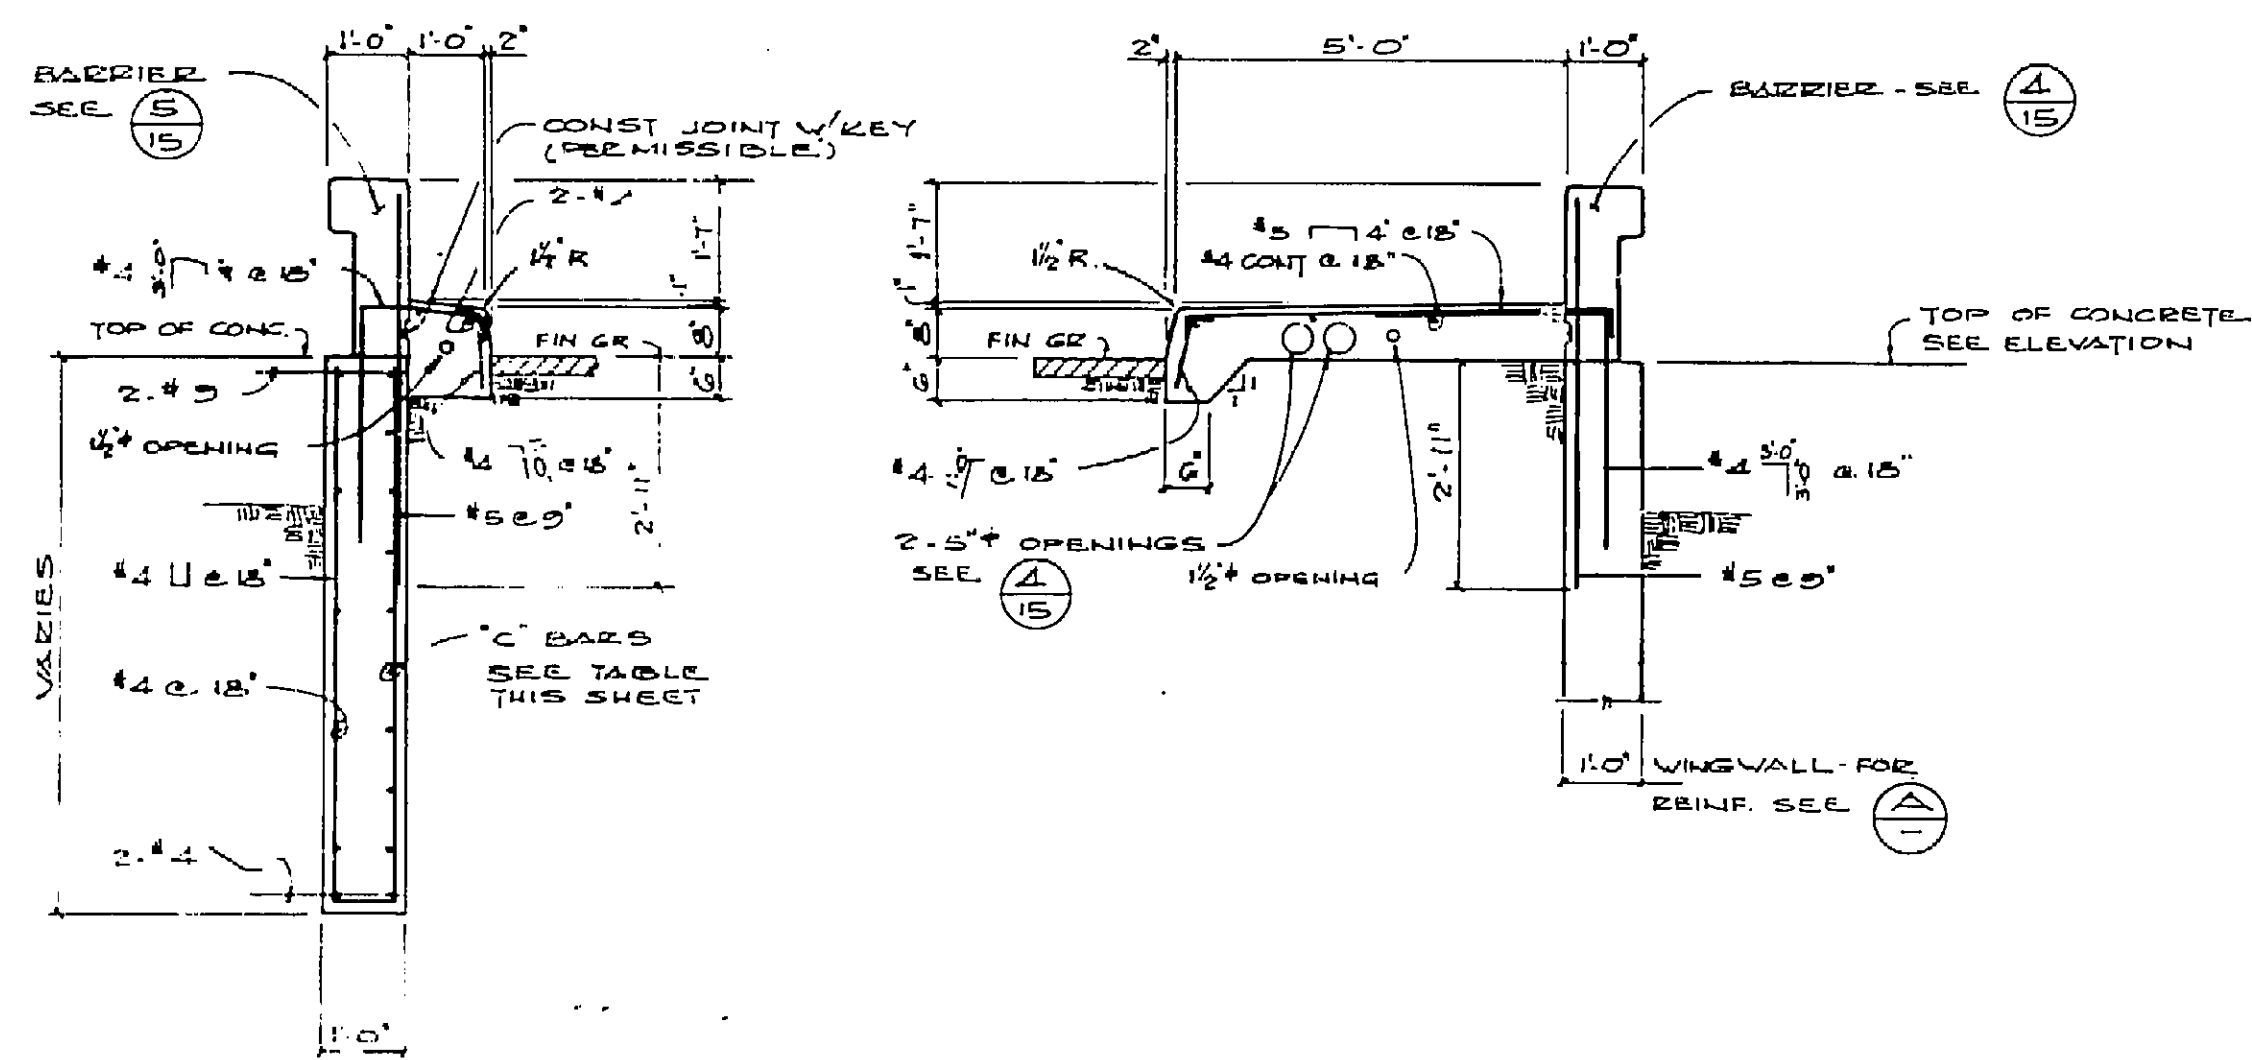

SECTION A
SCALE 1/2" = 1'-0"


SECTION B
SCALE 1/2" = 1'-0"

NORTH BRIDGE (EXIST.)		
WINGWALL	"C" BARS	"V" BARS
"A"	#8 @ 2'	#5 @ 2'
"B"	#6 @ 2'	#4 @ 2'
"C"	#7 @ 2'	#4 @ 2'
"D"	#7 @ 2'	#4 @ 2'

SOUTH BRIDGE		
WINGWALL	"C" BARS	"V" BARS
"A"	#8 @ 2'	#5 @ 2'
"B"	#8 @ 2'	#5 @ 2'
"C"	#7 @ 2'	#4 @ 2'
"D"	#7 @ 2'	#4 @ 2'

NOTE: FOR LOCATION OF "V" BARS
SEE SHEET 7

REINF. SCHEDULE

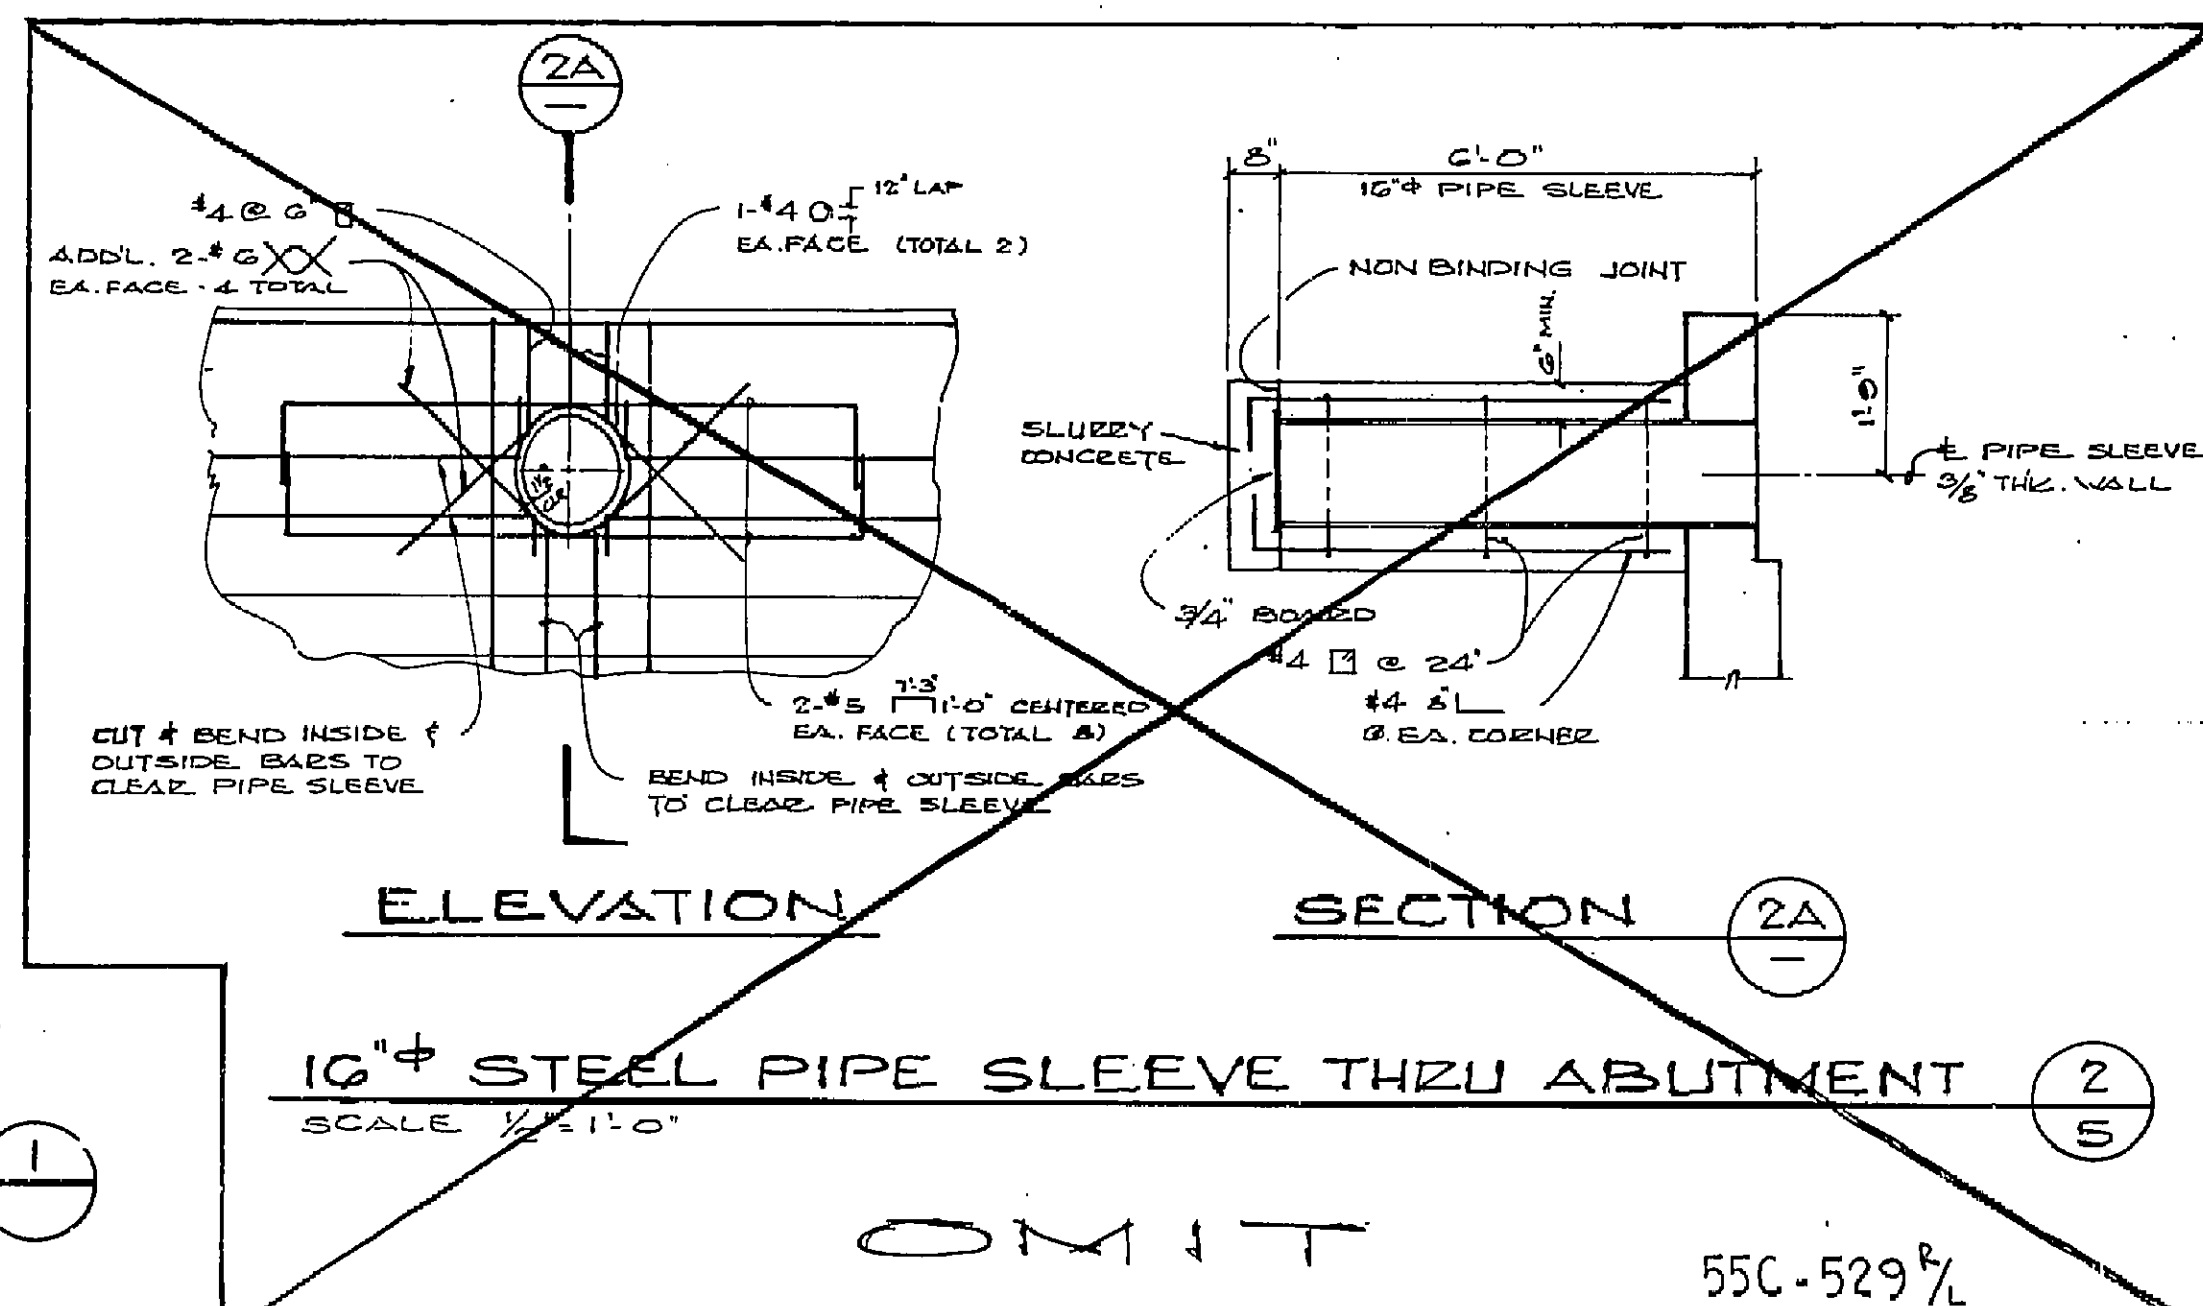

ELEVATION

SECTION 2A

10" STEEL PIPE SLEEVE THRU ABUTMENT
SCALE 1/2" = 1'-0"

OMIT

55C-529%






DATE	BY	REVISION DESCRIPTION	APPD	DATE

WINGWALLS SECTIONS & DETAILS	
DES. J.G.R.	DWN. T.L.
CHK. M.D.C.	DATE 3/4/64

SHEET
8

SHEEP HILLS ROAD BRIDGE
ACROSS ALISO CREEK

IN 213040

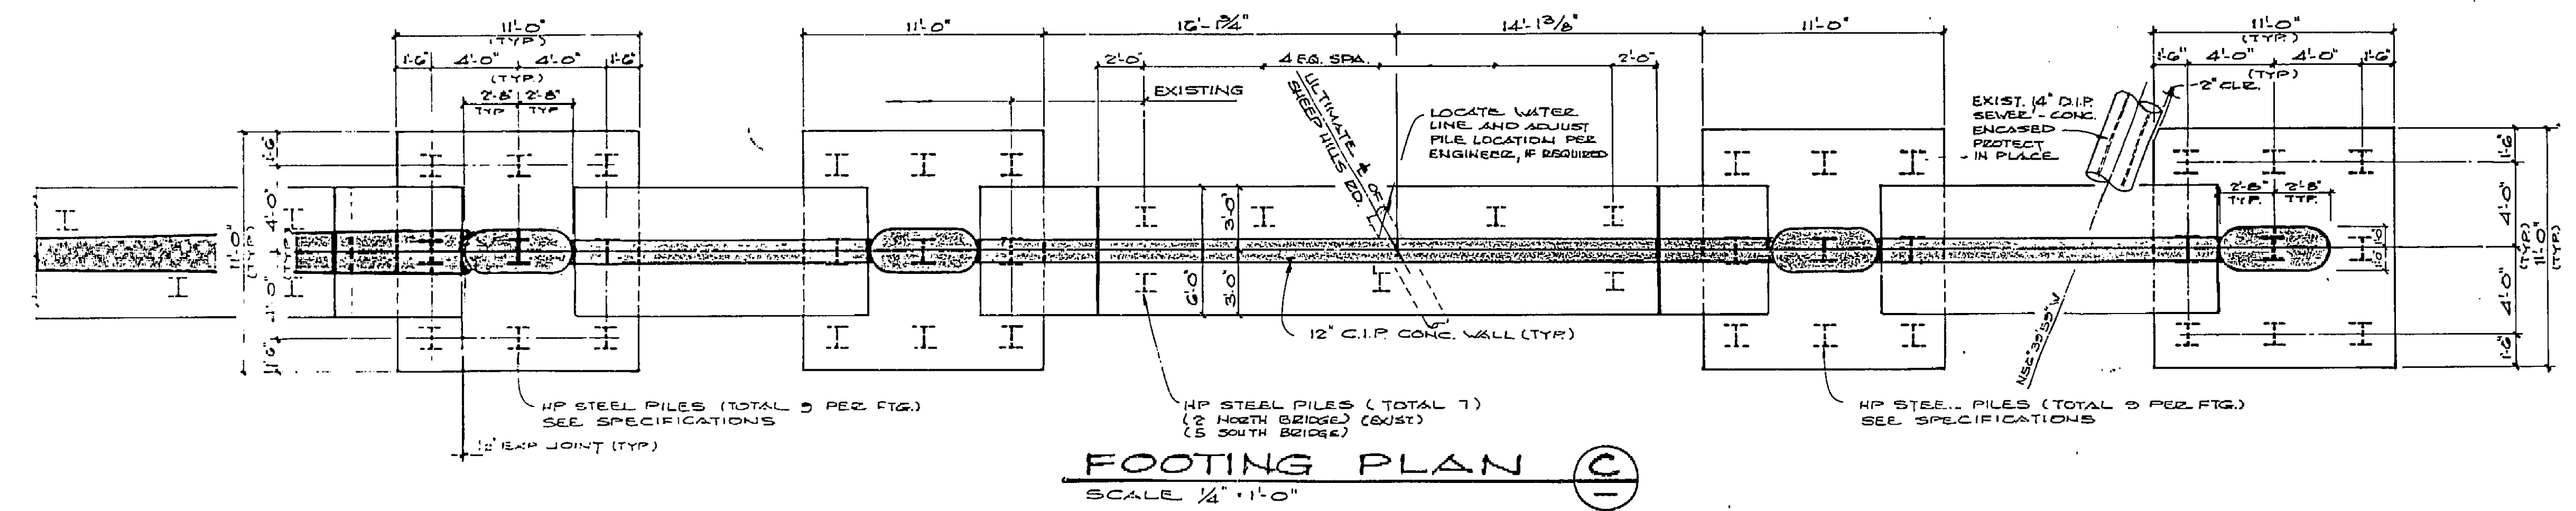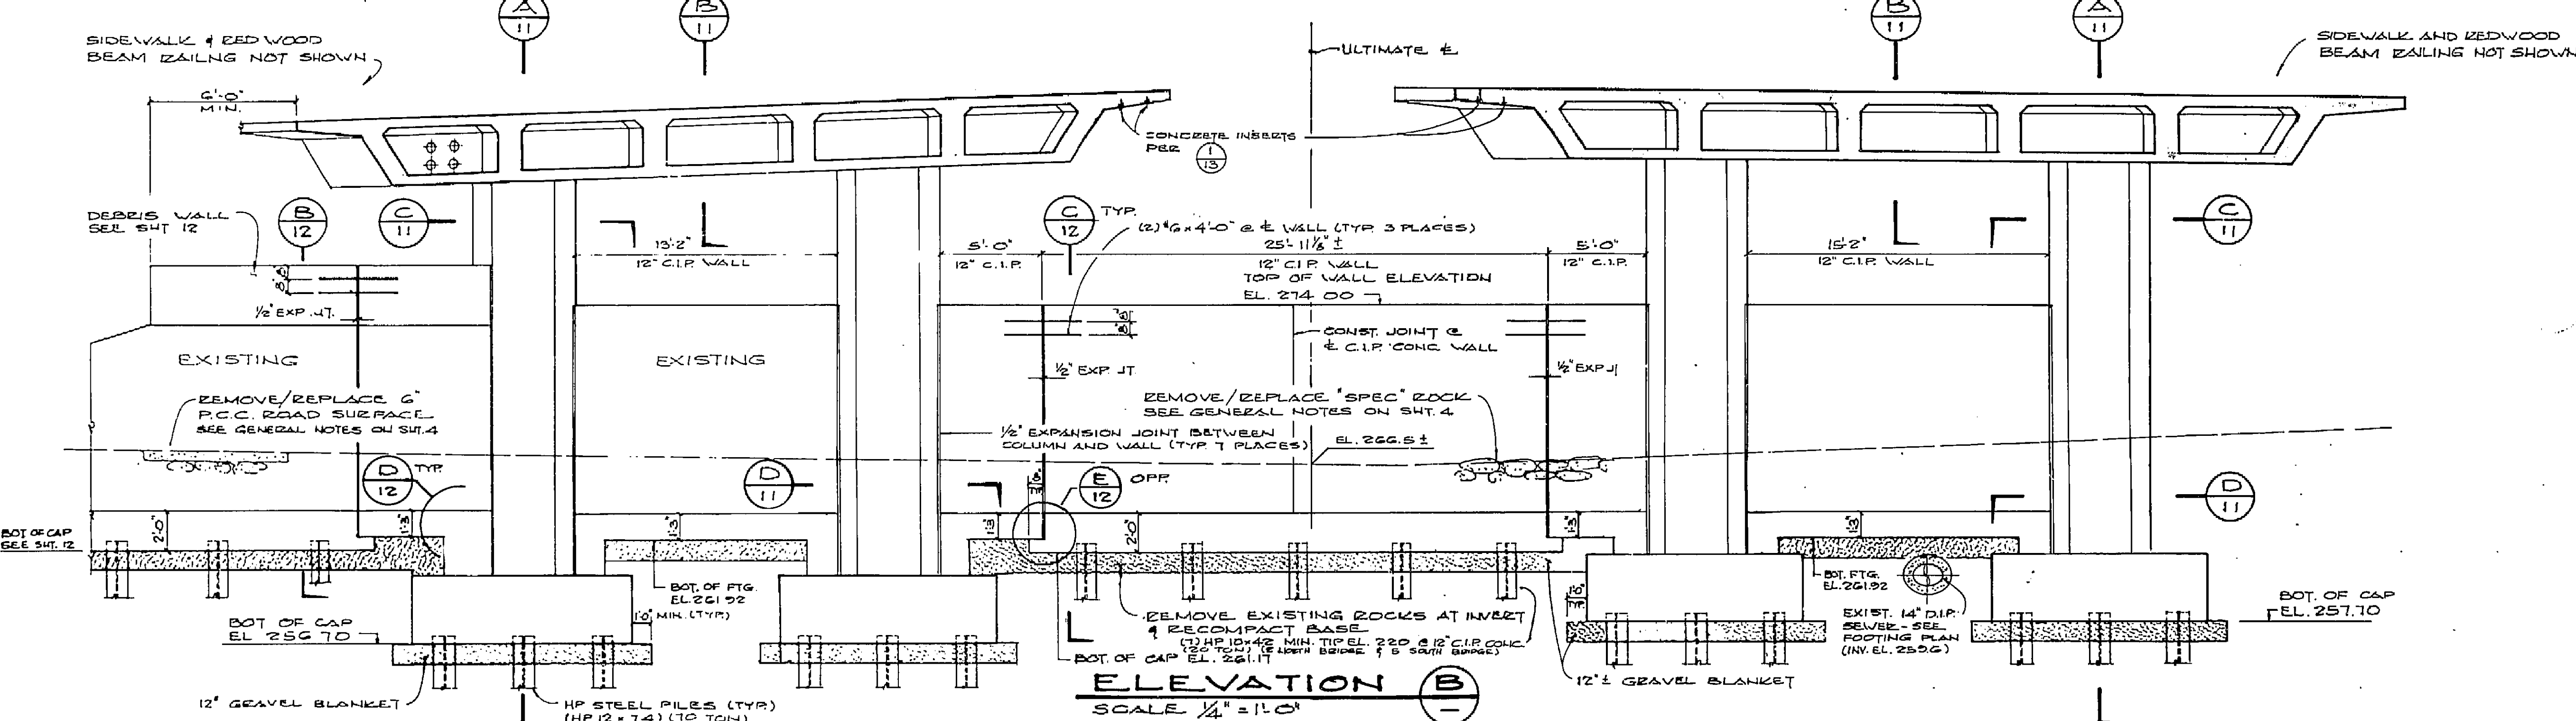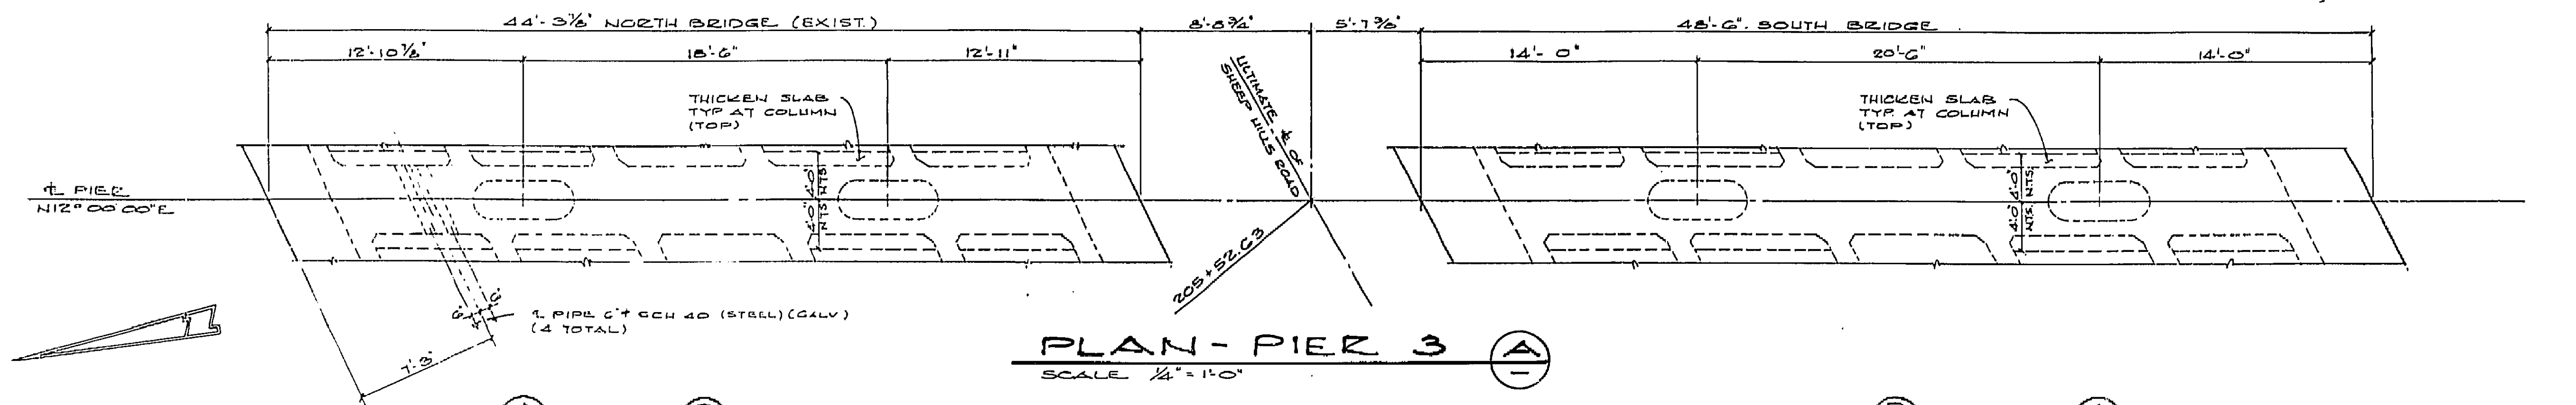

Jack G. Raub Company
Engineering & Planning
2000 S. 10th Street, Suite 100, Phoenix, AZ 85001

REVISION		DATE	BY	DESCRIPTION

PLAN SCALE

DES. J.L. / DWN. T.L.

DATE: 10/1/84 / 10/1/84

PIER 3
PLAN & ELEVATION


SHEEP HILL'S ROAD BRIDGE
ACROSS ALISO CREEK

SHEET
10
OF
17

213040

55C-529 1/2

11-6-88
Donald Blackford
MICHIGAN

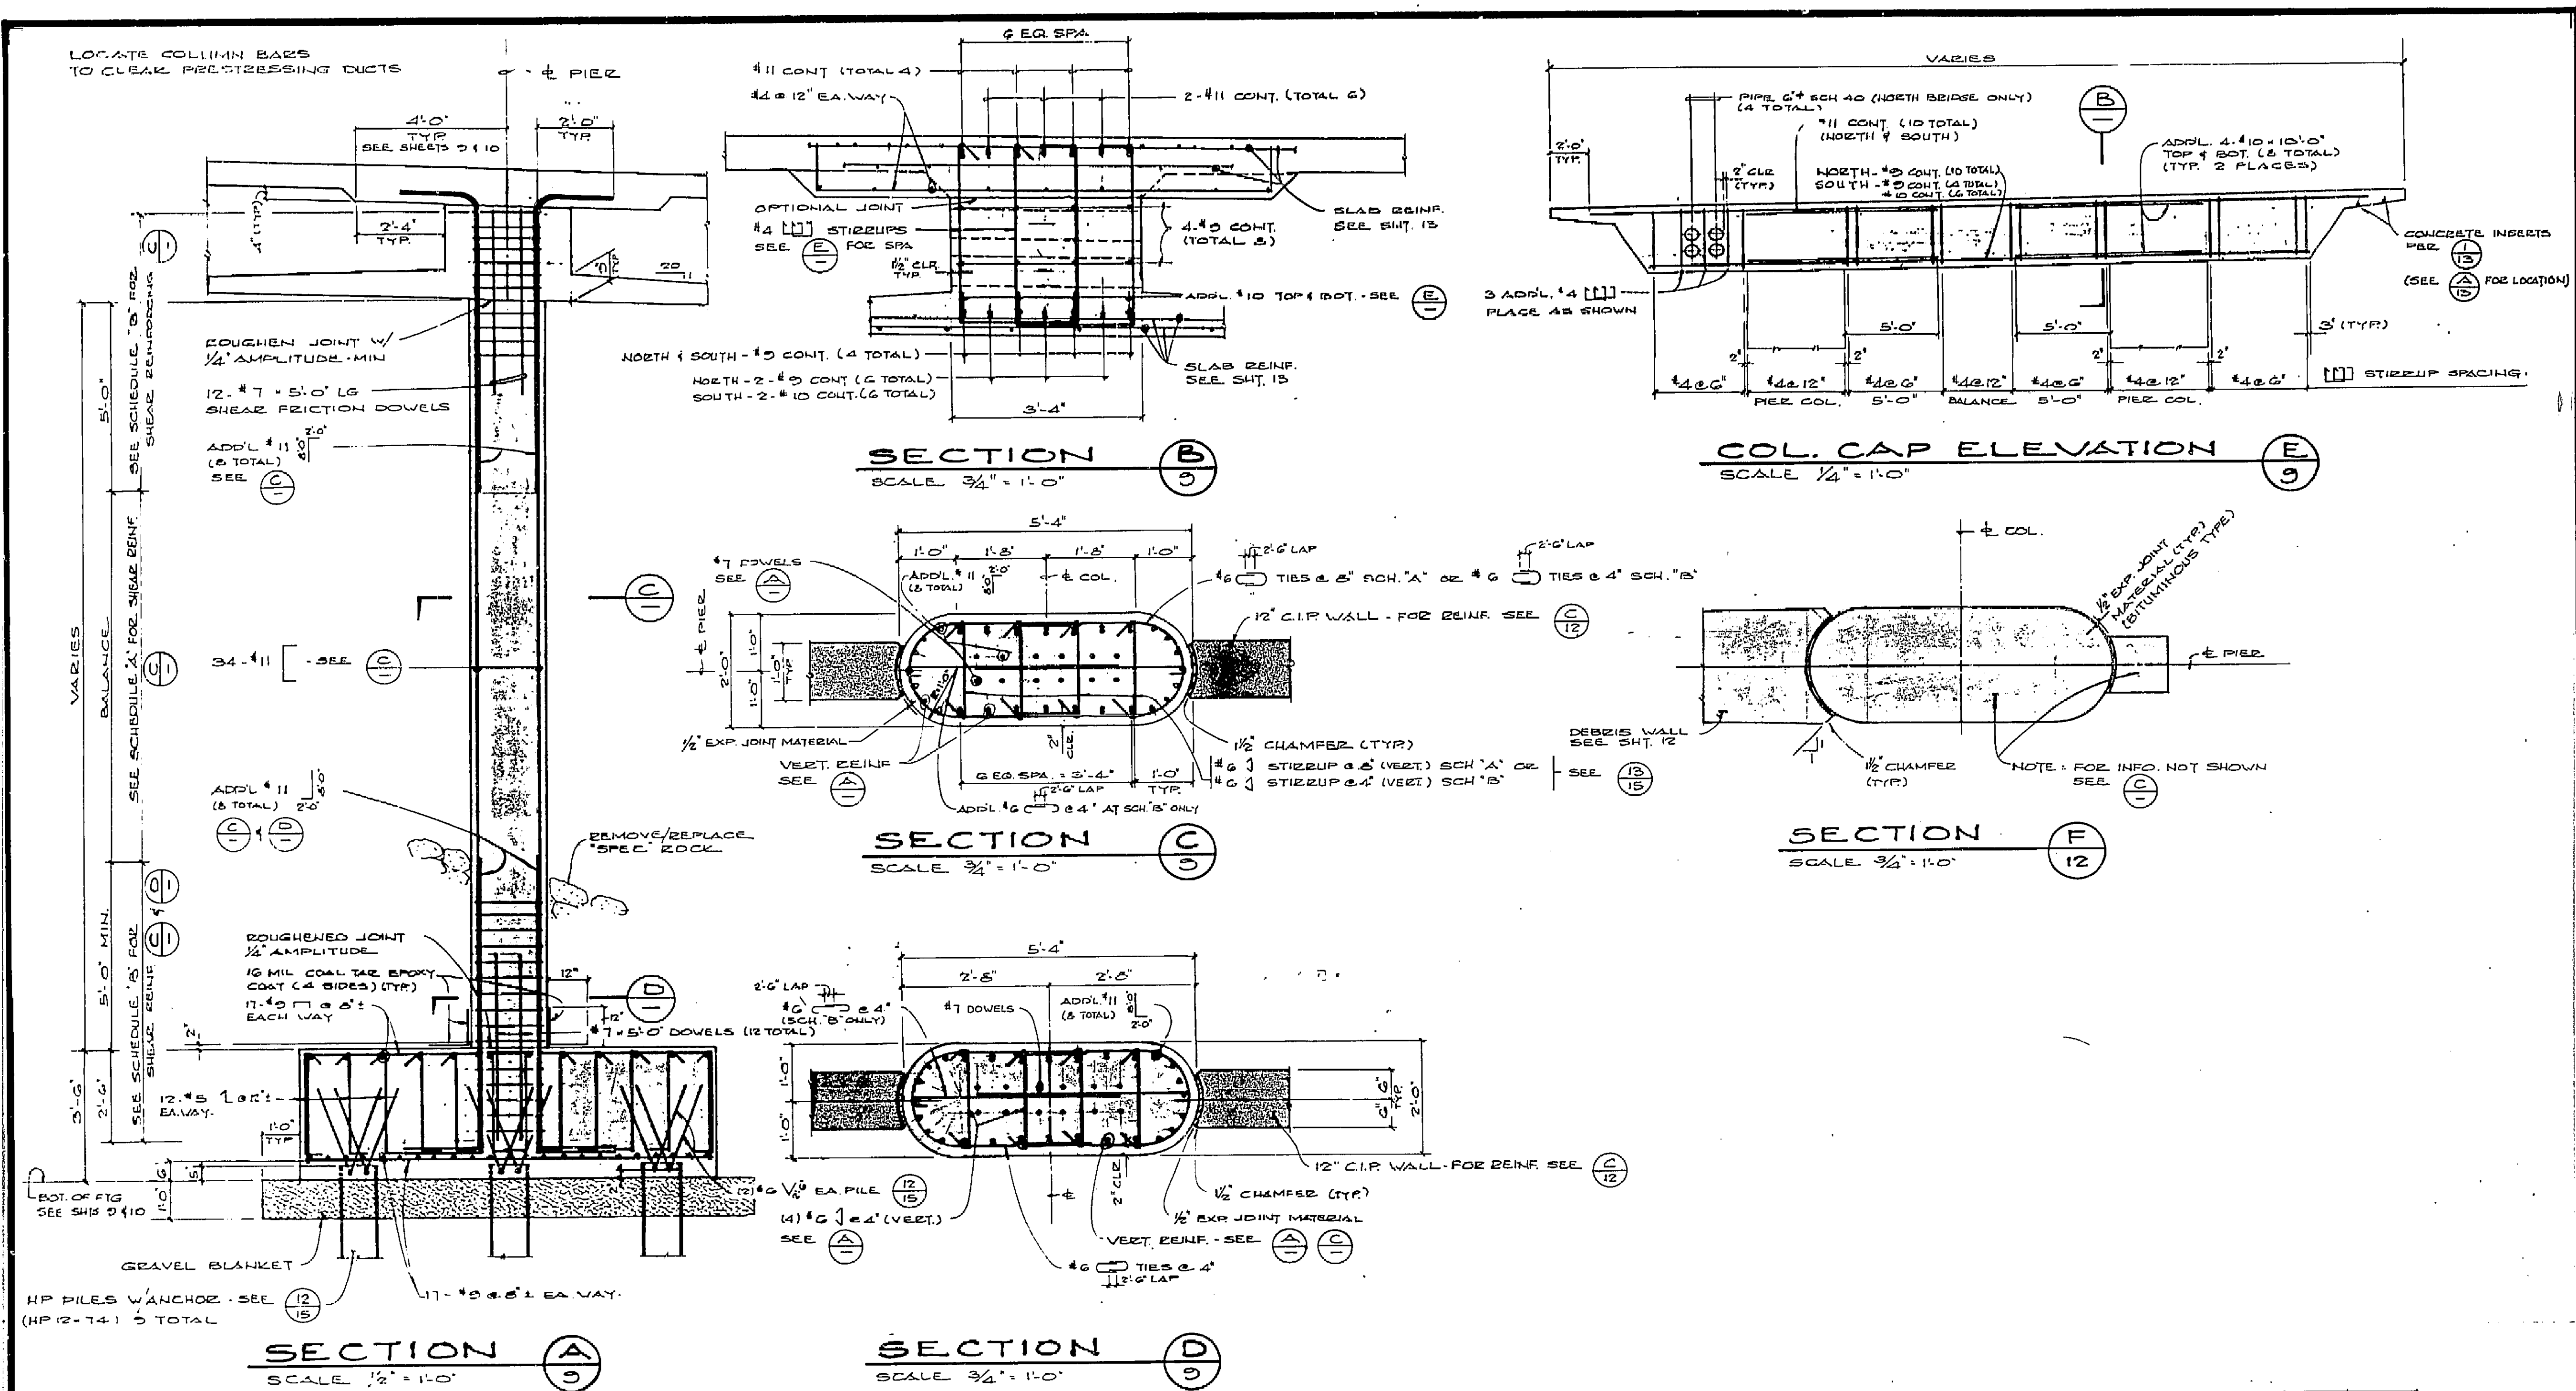

DESIGN PILE DATA (HP 12 X 74)					AS-BUILT PILE DRIVING DATA				
LOCATION	PILE CUT-OFF	PILE TIP ELEVATION	PILE LENGTH	AVERAGE AS-BUILT PILE	PILE DRIVER MAKE AND MODEL	DRIVING ACTION	RATED ENERGY	RAIN WEIGHT	MAXIMUM STROKE
ABUTMENT 1	277.40	220.00	57.40	50.11	KOBE K-22	DIESEL HAMMER	APPROX. 45,000 FT-LB	N/A	9.43 FEET
PIER 2	258.70	200.00	58.70	35.63					
PIER 3	257.10	200.00	57.10	31.46					
ABUTMENT 4	273.40	215.00	58.40	53.67					

DESIGN PILE DATA (HP 10 X 42)					AS-BUILT PILE DRIVING DATA				
LOCATION	PILE CUT-OFF	PILE TIP ELEVATION	PILE LENGTH	AVERAGE AS-BUILT PILE	PILE DRIVER MAKE AND MODEL	DRIVING ACTION	RATED ENERGY	RAIN WEIGHT	MAXIMUM STROKE
PIER 2 DEBRIS WALL	260.30	225.00	35.30	34.58	KOBE K-22	DIESEL HAMMER	APPROX. 45,000 FT-LBS.	N/A	9.43 FEET
PIER 2 DIVIDER WALL	262.00	225.00	37.00	40.98					
PIER 3 DEBRIS WALL	261.75	220.00	41.75	39.31					
PIER 3 DIVIDER WALL	261.75	220.00	41.75	41.79					

DESIGN PILE DATA (HP 10 X 42)					AS-BUILT PILE DRIVING DATA				
LOCATION	PILE CUT-OFF	PILE TIP ELEVATION	PILE LENGTH	AVERAGE AS-BUILT PILE	PILE DRIVER MAKE AND MODEL	DRIVING ACTION	RATED ENERGY	RAIN WEIGHT	MAXIMUM STROKE
PIER 2 DEBRIS WALL	260.30	225.00	35.30	34.58	KOBE K-22	DIESEL HAMMER	APPROX. 45,000 FT-LBS.	N/A	9.43 FEET
PIER 2 DIVIDER WALL	262.00	225.00	37.00	40.98					
PIER 3 DEBRIS WALL	261.75	220.00	41.75	39.31					
PIER 3 DIVIDER WALL	261.75	220.00	41.75	41.79					

DESIGN PILE DATA (HP 10 X 42)					AS-BUILT PILE DRIVING DATA				
LOCATION	PILE CUT-OFF	PILE TIP ELEVATION	PILE LENGTH	AVERAGE AS-BUILT PILE	PILE DRIVER MAKE AND MODEL	DRIVING ACTION	RATED ENERGY	RAIN WEIGHT	MAXIMUM STROKE
PIER 2 DEBRIS WALL	260.30	225.00	35.30	34.58	KOBE K-22	DIESEL HAMMER	APPROX. 45,000 FT-LBS.	N/A	9.43 FEET
PIER 2 DIVIDER WALL	262.00	225.00	37.00	4					

CONST. JOINT NORMAL TO FIBER CAST HAMMERBAG

2" x 6" x 6" MIN. VERT. AT EA. FACE

SEE ③

KEYS 12" x 1/2" OVER 50% OF AREA

REINFC. CONTINUOUS THRU JOINT

± GIRDER

BENT CAP

DIAPHRAGM

REINFORCEMENT CONTINUOUS THRU JOINT

CONST. JOINT IN SLAB ③

SEE ③

0.2 SPAN LENGTH TO ± PIER OR AS APPROVED BY THE ENGINEER

2-#8 x 6'-0" x 18" MAX. VERT. EA. FACE

CONSTRUCTION JOINT

3/4"

STEM

TOP OR BOT. SLAB

DECK PLACING NOTES:
THE CONTRACTOR SHALL SUBMIT A DECK PLACING SCHEDULE, WHICH WILL BE SUBJECT TO THE REVIEW OF THE ENGINEER.
UNLESS SHOWN OTHERWISE ON THE PLANS, THE FOLLOWING CONDITIONS SHALL BE PROVIDED FOR:
1- TRANSVERSE JOINTS MAY BE LOCATED AT ABOUT 1/4 POINT OF SPAN, BETWEEN STEMS.
2- LONGITUDINAL JOINTS SHALL BE LOCATED AT THE EDGE OF A TRAFFIC LANE, UNLESS OTHERWISE PERMITTED BY THE ENGINEER.
3- REINFORCING STEEL SHALL BE CONTINUOUS THRU ALL CONSTRUCTION JOINTS.

1'-0" 5'-0"

1" CHAMFER (TYP)

#4 10" x 15"

#4 CONT. TOTAL 6

#5 2'-0" x 15"

#5 1'-0" x 15"

1/2" OPNG.

1'-0" MIN.

2'-0" x 1'-0" x 15"

#4 7'-0" x 15"

OPTIONAL CONST. JOINT

#4 CONT. 15" ± TOTAL 4

2-5" ± OPENING (FUTURE UTILITIES)
OPENINGS TO BE SEALED AT ENDS

#4 10" x 15"

#4 CONT. TOTAL 6

#5 2'-0" x 15"

#5 1'-0" x 15"

1" CHAMFER (TYP)

#4 7'-0" x 15"

OPTIONAL CONST. JOINT

1/2" ± OPENING

#4 10" x 15"

LONG. CONST. JOINT ①

SINGLE OR COMMON BEARING #5

CABLE SHALL NOT VARY MORE THAN 2" FROM A PERPENDICULAR TO THE FL.

START FLARE TO BEARING #5

LOW POINT OF CABLE PATH (C.G.)

NOTE: SUFFICIENT POINTS TO BE SHOWN ON TENDON PROFILE TO PLACE DUCTS ACCURATELY

FLARE 3'-0"

6'-0" x 8'-0" TIE ON EACH DUCT

DUCTS

GIRDER WEB REINFC. SEE SHIT 14

#4 DUCT TIES

± BEARING

GRILLAGE #4B4 EACH WAY

RECESS TO BE FILLED WITH CONC. (TYPICAL)

#4 1/2" x 12"

INTERIOR STEM

DIAPHRAGM REINFC. CONT. OR BENT AS REQUIRED

EXTERIOR STEM

GRILLAGE #4B4 EACH WAY

ANCHORAGE BLOCKOUT. SEE ①

3" MIN. CLR. (EXCEPT 1/2" MIN. NEAR ANCHORAGE)

1" MIN. CLR.

3" O.D. OR LESS 3" O.D. TO 4 1/2" O.D.

NOTES:
1- DUCT PATTERNS SHOWN ARE FOR 12" WIDE GIRDER STEM. FOR OTHER WIDTHS THE MINIMUM CLEARANCE MUST BE MAINTAINED.
2- GIRDER STIRRUPS MUST BE BENT TO FIT THE DUCT SIZE USED, OR 1" OR 1 1/2" STIRRUPS MAY BE USED. A REINFORCING BAR MUST BE PLACED INSIDE OF EACH STIRRUP HOOK OR 90° BEND.

5" DIA. VENT (OR 12" DIA.)
1/2" DRIP GROOVE

NOTE:
5" DIA. VENT IN LOWER SLAB (OR 12" DIA.) MINIMUM OF 2 VENTS PER SPAN IN EACH BAY BETWEEN GIRDERS. ONE VENT TO BE LOCATED AT LOW POINT OF SPAN AND OTHER VENT TO BE LOCATED AT OPPOSITE END OF SPAN & 1'-0" FROM FACE OF ABUTMENT OR PIER.

BEARING & P.S. PATH ⑥

U-BOLT CLIPS (TOTAL 2)

± END DIAPHRAGM

#11 x 2'-0" ± TOP & BOT

6" CLR

1/2" HARDBOARD

BOT DIAPHRAGM

POLYSTYRENE

TOP OF ABUTMENT

1" EXPANDED POLYSTYRENE

3" CLR

PAINT WITH METAL SPRAY NO. 402

#6 1/2" (TOTAL 2)

60°

BOT PILE CAP

GRAVEL BLANKET

FLAME CUT 2" ± HOLES

HP STEEL PILE

HOOK AROUND HORIZ. AND VERT. BARS

1" CLR. (MIN.)

FACE OF CONC.

2" CLR.

135° BEND WITH 10" TAIL

± GIRDER & BEARING PAD

± BEARING

± ABUTMENT (REF. LINE)

12" x 1/2" x 1'-0" ELASTOMERIC BEARING PAD

1/2" THK BEARING PAD

1/2" EXPANDED POLYSTYRENE

PLAN

SECTION A

SEAT ELEVATION. SEE TABLES, SHEETS 5 & 6

TYPE B SEAL ME-3/4" PER CALTRANS STD. BG-21
NO WATERSTOP REQUIRED

EXPANSION PLATE 15" x 1/2" x 5"

1/2" x 6" STUD BOLTS @ 12" EA. ROW

CONST. JOINT (REQUIRED)

NOTES:
1- THE LENGTH OF EXPANSION PLATES "A" SHALL BE FULL WIDTH OF DECK AT EACH ABUTMENT. EXPANSION PLATES "B" SHALL BE BETWEEN CURB FACES.
2- 1/2" STUD BOLTS SHALL BE FULL PENETRATION BUT WELD WELDED TO THE PLATES. BOLTS SHALL BE STAGGERED.
3- ALL ASSEMBLIES TO BE GALVANIZED AFTER FABRICATION

VERTICAL RESTRAINER ⑪

PILE ANCHOR ⑫

TIE BAR DETAIL ⑬

ELASTOMERIC PAD ⑭

EXPANSION PLATES ⑮

Jack G. Raub Company

Engineering & Planning

213040

DATE	BY	REVISION	DESCRIPTION	APPROV	DATE

PLAN SCALE

MISCELLANEOUS DETAILS

SHEET 15 OF 17

JN 213040

55C-529 1/2

1

2

3

1

2

3

1

2

3

1

2

3




96

97

98

99

100

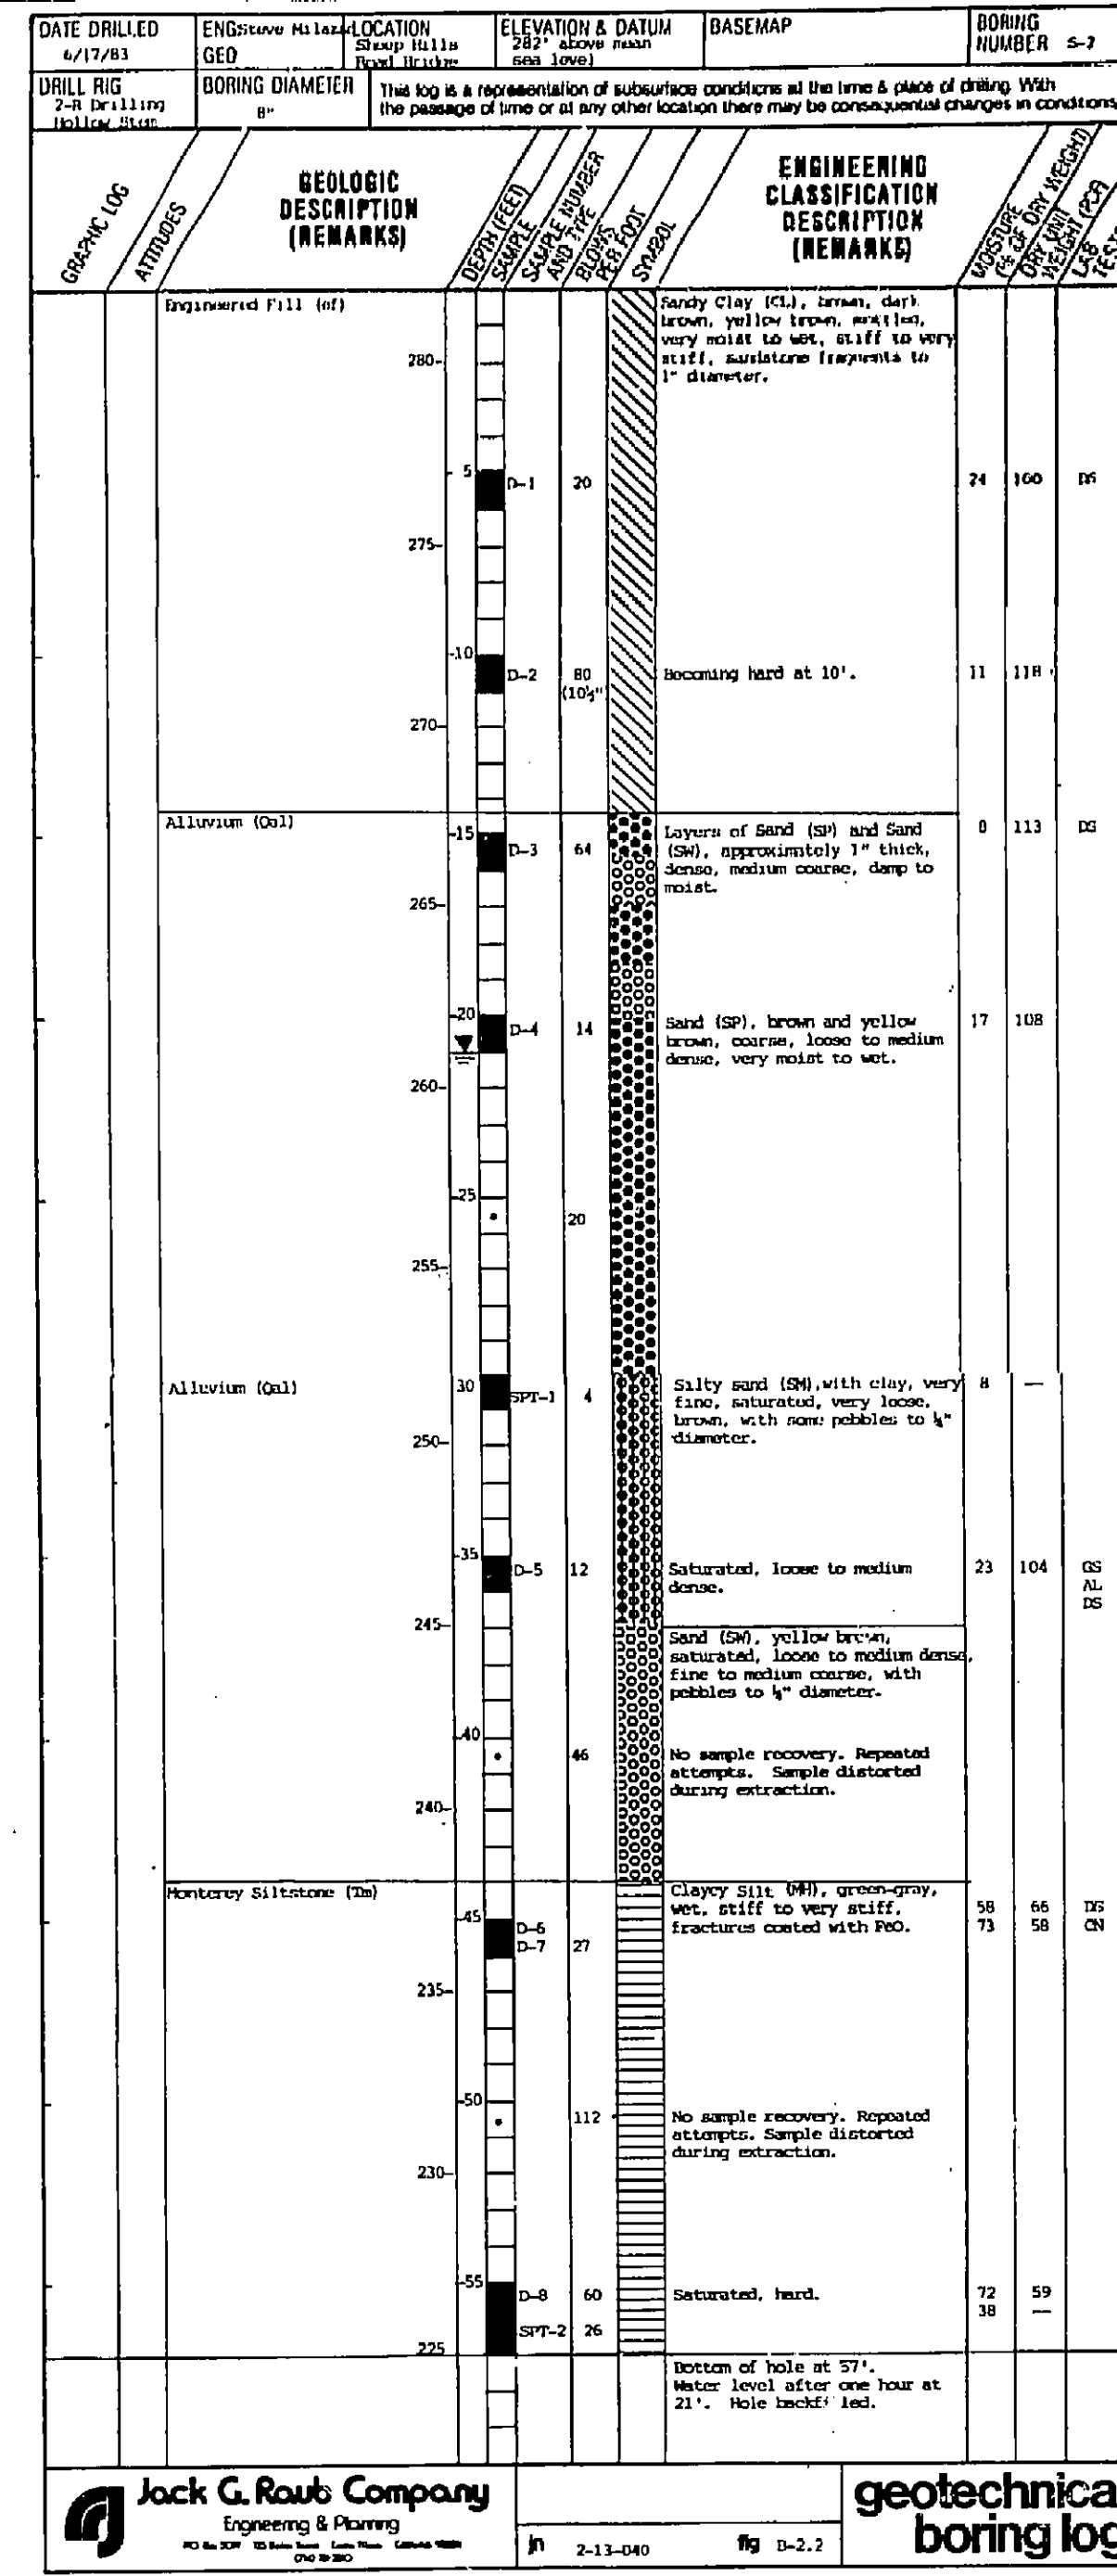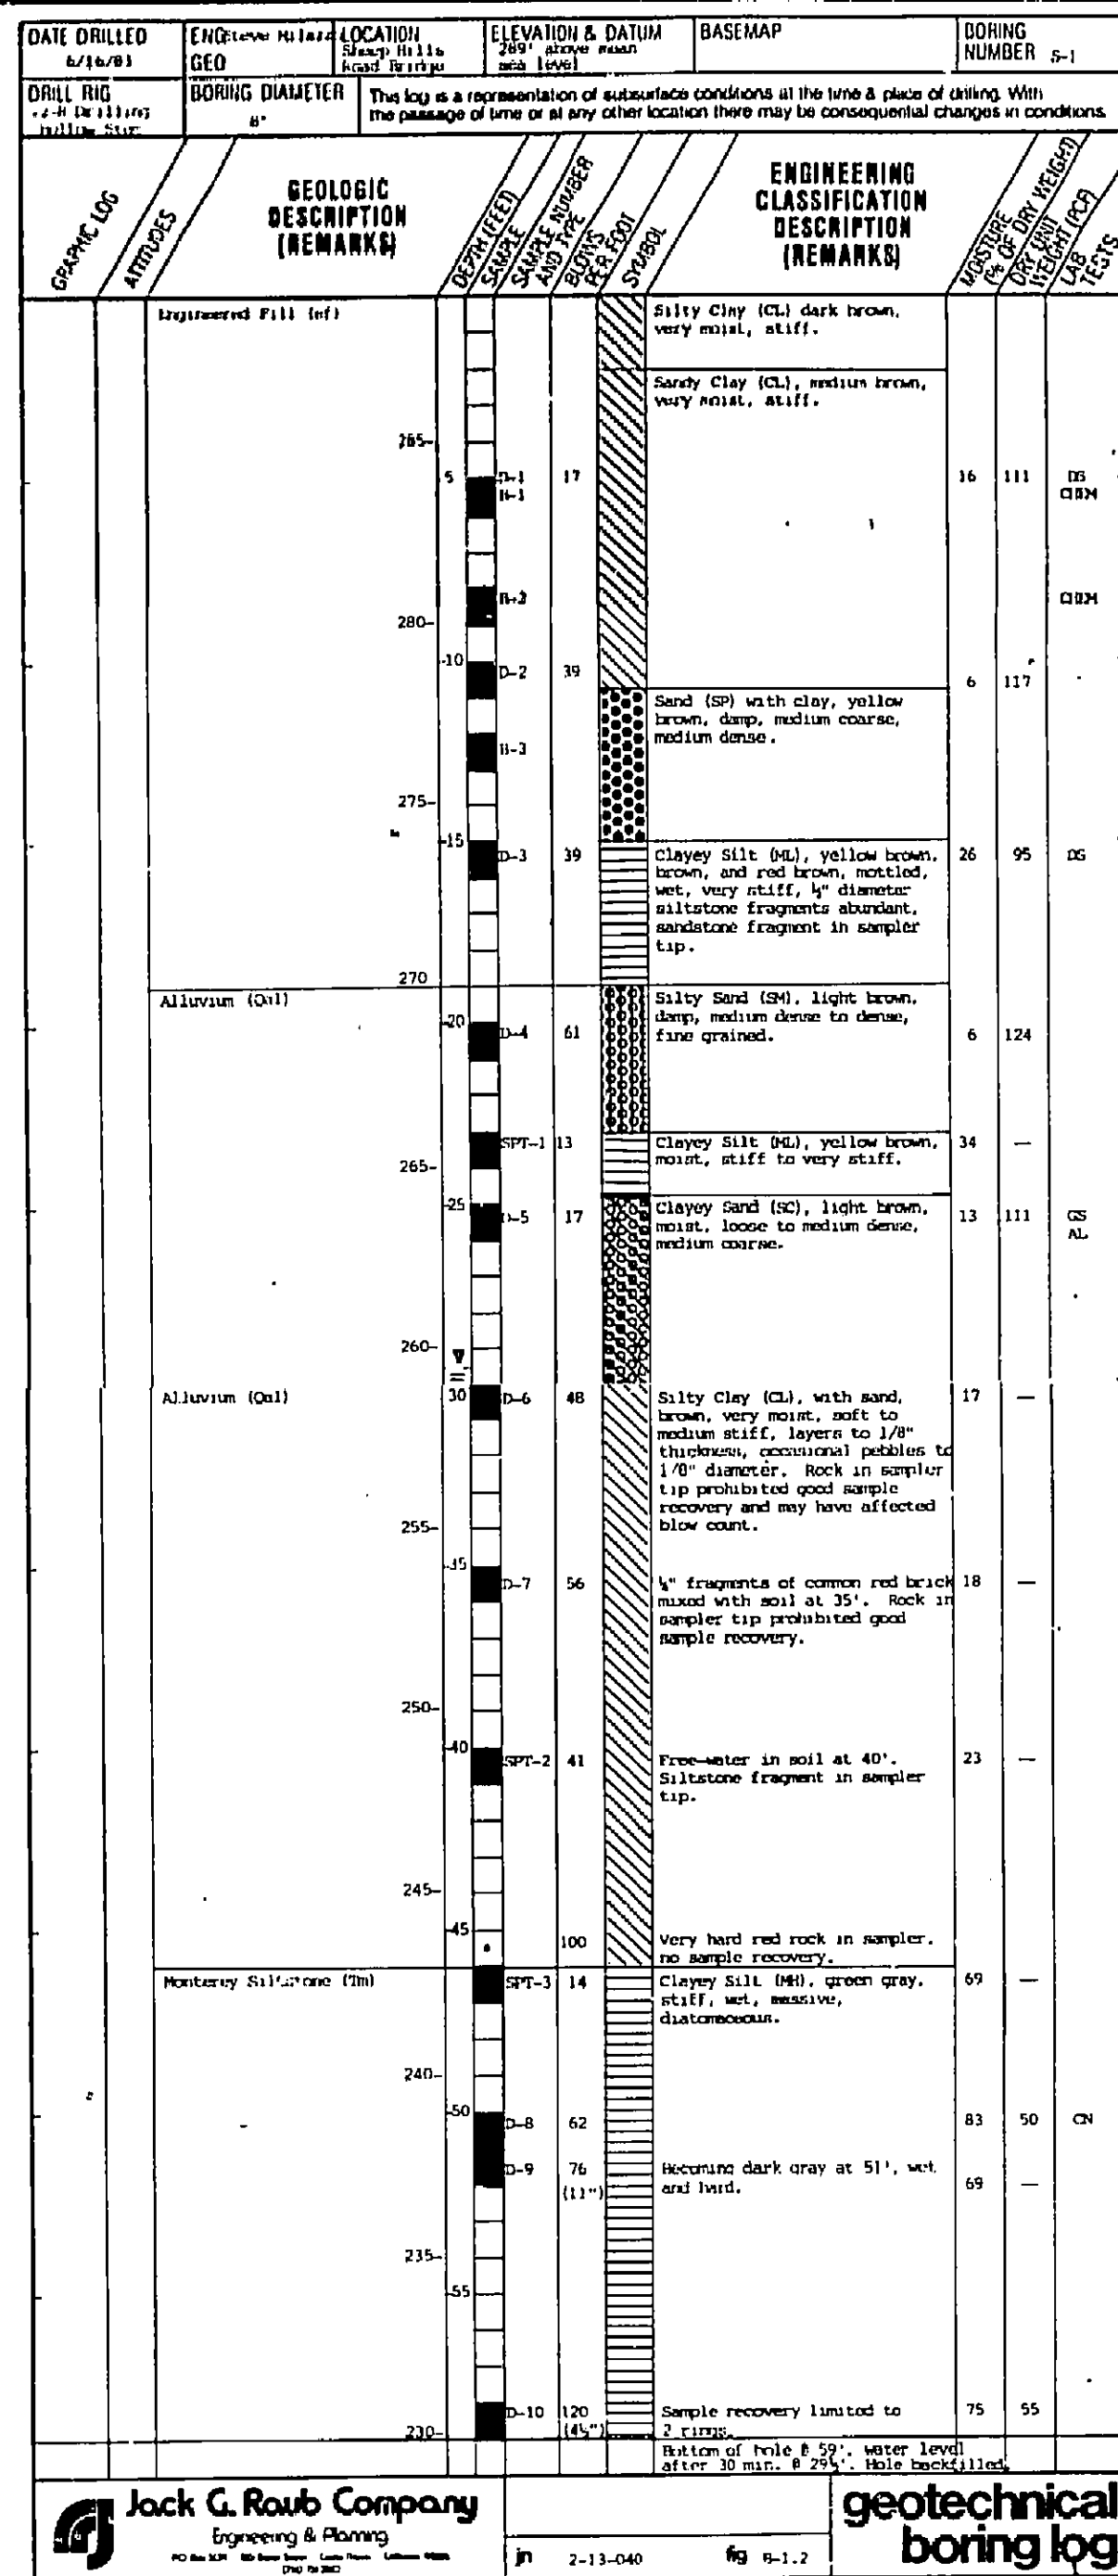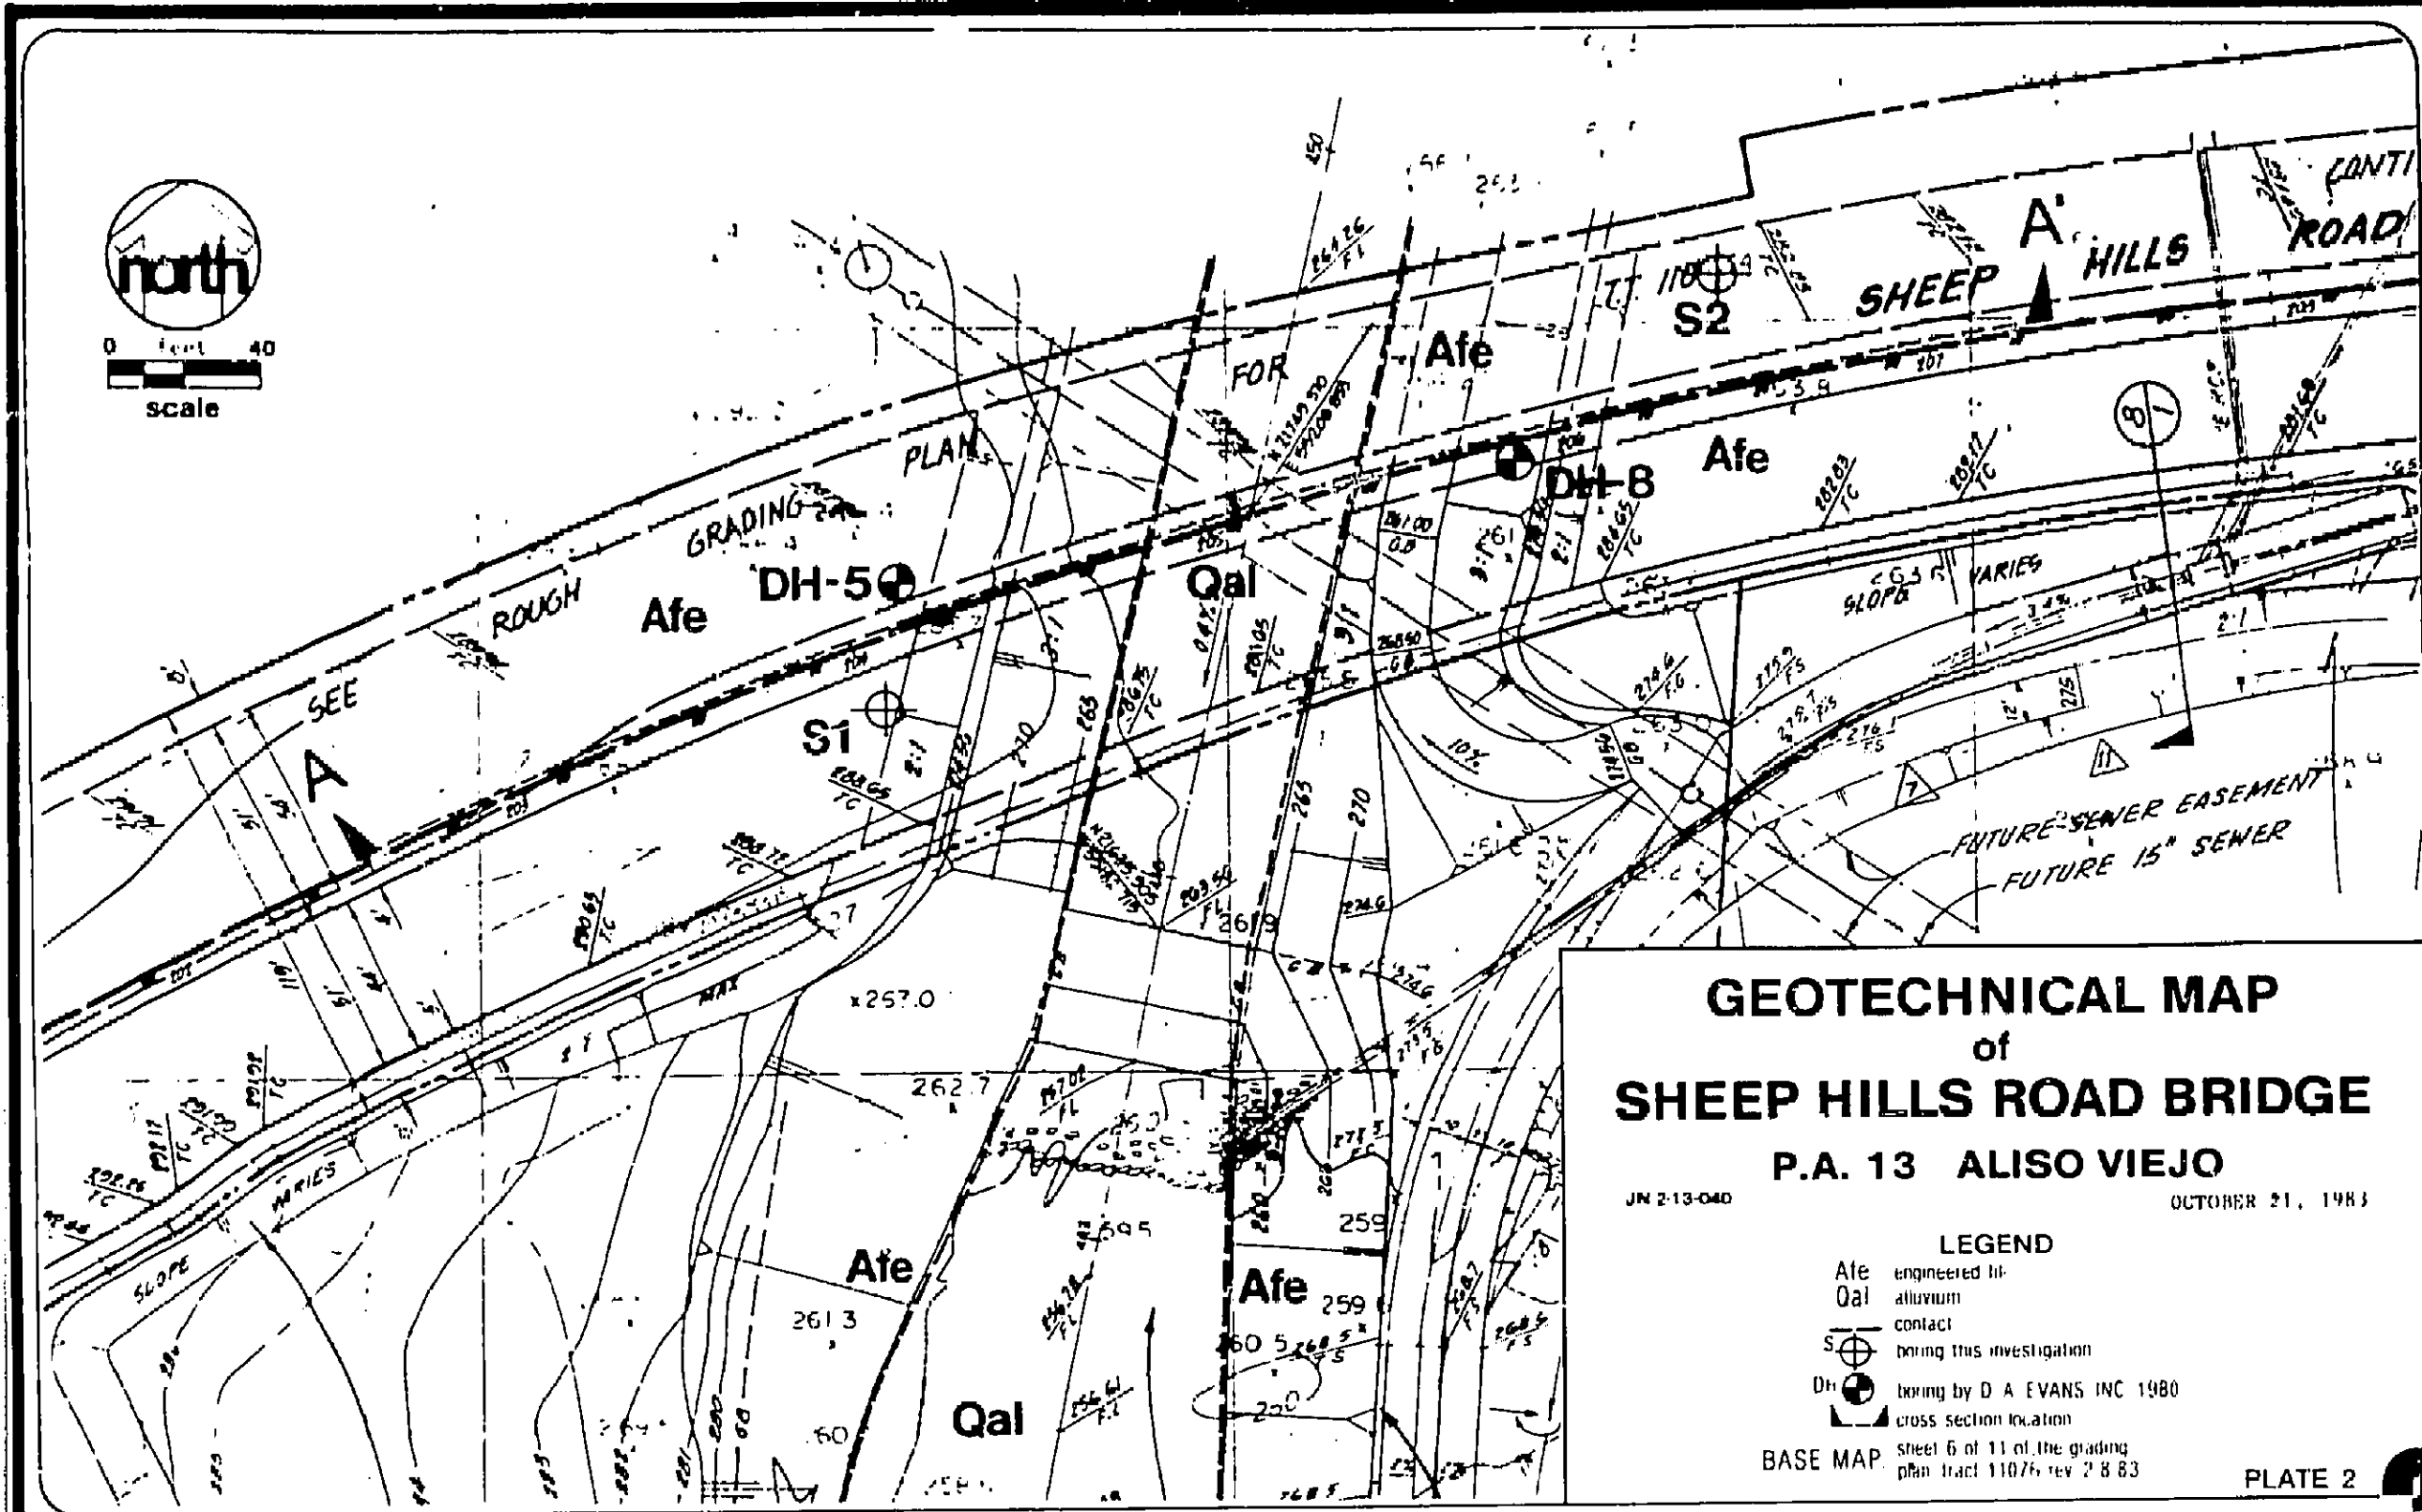

Jack G. Raub Company Engineering & Planning

PLAN SCALE

BORING LOG

SHEET 17

DATE BY REVISION DESCRIPTION APPD DATE CKN DATE

55C - 529 1/2