
Bridge Inspection Records Information System

The requested documents have been generated by the BIRIS.

The documents provided are considered confidential and may only be released outside of the department of transportation upon proper execution of the confidentiality agreement.

State of California
Department of Transportation

**Division of Maintenance
Structures Maintenance & Investigations**



DEPARTMENT OF TRANSPORTATION
Structure Maintenance & Investigations

Bridge Number : 55C0628
Facility Carried: ANTONIO PARKWAY
Location : 0.2 MI. N/O ORTEGA HWY
City :
Inspection Date : 10/24/2002
Inspection Type

Bridge Inspection Report

Routine ☒ Group A ☐ Underwater ☐ Special ☐ Other ☐

STRUCTURE NAME: SAN JUAN CREEK

CONSTRUCTION INFORMATION

Year Built : 1997 Skew (degrees): 22
Year Widened : N/A No. of Joints : 2
Length (m) : 236.5 No. of Hinges : 0

Structure Description: Continuous five span CIP/PS concrete box girder (five cells) with RC two column bents and with RC closed end seat abutments, all supported upon driven steel H-piles, and upon CIDH concrete piles.

Span Configuration : (S) 38.1 m, 3 @ 53.0 m, 38.1 m (N) c/c

LOAD CAPACITY AND RATINGS

Design Live Load : MS - 18 OR HS - 20
Inventory Rating : 32.6 metric tons Calculation Method : LOAD FACTOR
Operating Rating : 53.5 metric tons Calculation Method : LOAD FACTOR
Permit Rating : PPPPP
Posting Load : Type 3 English tons Type 3S2 English tons Type 3-3 English tons

DESCRIPTION ON STRUCTURE

Deck X-Section: (W) 0.5 m br, 19.7 m, 0.5 m br (E)
Total Width : 20.7 m Net Width : 19.7 m No. of Lanes : 4
Rail Description : Type 25 concrete railings. Rail Code : 1110
Min. Vertical Clearance: Unimpaired

DESCRIPTION UNDER STRUCTURE

Channel Description : Wide natural earth channel

CONDITION OF STRUCTURE

The structure is in excellent condition.

SCOUR

The scour rating of A1 is appropriate.

MISCELLANEOUS

Vehicular parking is at the southeast quadrant. Take photographs during the next inspection.

ELEMENT INSPECTION RATINGS

F#	Elem No.	Element Description	Env	Total Units Qty	Qty in each Condition State				
					St. 1	St. 2	St. 3	St. 4	St. 5
01 12		Concrete Deck - Bare	2	4896 sq.m.	4896	0	0	0	0
01 104		P/S Conc Closed Web/Box Girder	2	236 m.	236	0	0	0	
01 205		Reinforced Conc Column or Pile Extension	2	8 ea.	8	0	0	0	
01 215		Reinforced Conc Abutment	2	40 m.	40	0	0	0	
01 220		Reinforced Conc Submerged Pile Cap/Footing	2	10 ea.	10	0	0	0	
01 225		Unpainted Steel Submerged Pile	2	306 ea.	306	0	0	0	
01 252		Cast-In-Drilled Hole Concrete Pile	2	50 ea.	50	0	0	0	
01 303		Assembly Joint/Seal (modular)	2	40 m.	40	0	0		
01 312		Enclosed/Concealed Bearing	2	2 ea.	2	0	0		

Printed on: Friday 10/25/2002 11:06 AM

55C0628/AAAA/860

NOV - 6 2002

F#	Elem No.	Element Description	Env	Total Qty	Units	Qty in each Condition State				
						St. 1	St. 2	St. 3	St. 4	St. 5
01 321		Reinforced Conc Approach Slab w/ or w/o AC Ovly	2	8	ea.	8	0	0	0	
01 331		Reinforced Conc Bridge Railing	2	510	m.	510	0	0	0	

WORK RECOMMENDATIONS - NONE

Inspected By : M. Ogata

M. Ogata
Registered Civil Engineer



CC: TMRut
Orange County
WLindsey

NOV - 6 2002

STRUCTURE INVENTORY AND APPRAISAL REPORT

***** IDENTIFICATION *****

(1) STATE NAME- CALIFORNIA 069
 (8) STRUCTURE NUMBER 55C0628
 (5) INVENTORY ROUTE (ON/UNDER)- ON 140
 (2) HIGHWAY AGENCY DISTRICT 12
 (3) COUNTY CODE 059 (4) PLACE CODE
 (6) FEATURE INTERSECTED- SAN JUAN CREEK
 (7) FACILITY CARRIED- ANTONIO PARKWAY
 (9) LOCATION- 0.2 MI. N/O ORTEGA HWY
 (11) MILEPOINT/KILOMETERPOINT
 (12) BASE HIGHWAY NETWORK- NOT ON NET 0
 (13) LRS INVENTORY ROUTE & SUBROUTE
 (16) LATITUDE 33 DEG 31 MIN 30 SEC
 (17) LONGITUDE 117 DEG 37 MIN 12 SEC
 (98) BORDER BRIDGE STATE CODE % SHARE %
 (99) BORDER BRIDGE STRUCTURE NUMBER

***** STRUCTURE TYPE AND MATERIAL *****

(43) STRUCTURE TYPE MAIN:MATERIAL- CONCRETE CONT
 TYPE- BOX BEAM OR GIRDER - MULTI CODE 205
 (44) STRUCTURE TYPE APPR:MATERIAL-
 TYPE- BOX BEAM OR GDR - MULTIPLE CODE
 (45) NUMBER OF SPANS IN MAIN UNIT 5
 (46) NUMBER OF APPROACH SPANS
 (107) DECK STRUCTURE TYPE- CIP CONCRETE CODE 1
 (108) WEARING SURFACE / PROTECTIVE SYSTEM:
 A) TYPE OF WEARING SURFACE- CONCRETE CODE 1
 B) TYPE OF MEMBRANE- NONE CODE 0
 C) TYPE OF DECK PROTECTION- NONE CODE 0

***** AGE AND SERVICE *****

(27) YEAR BUILT 1997
 (106) YEAR RECONSTRUCTED
 (42) TYPE OF SERVICE: ON- HIGHWAY-PEDESTRIAN 5
 UNDER- WATERWAY 5
 (28) LANES: ON STRUCTURE 04 UNDER STRUCTURE
 (29) AVERAGE DAILY TRAFFIC 10000
 (30) YEAR OF ADT 1998 (109) TRUCK ADT 1 %
 (19) BYPASS, DETOUR LENGTH 10 KM

***** GEOMETRIC DATA *****

(48) LENGTH OF MAXIMUM SPAN 53 M
 (49) STRUCTURE LENGTH 236.5 M
 (50) CURB OR SIDEWALK: LEFT M RIGHT M
 (51) BRIDGE ROADWAY WIDTH CURB TO CURB 19.7 M
 (52) DECK WIDTH OUT TO OUT 20.7 M
 (32) APPROACH ROADWAY WIDTH (W/SHOULDERS) 19.7 M
 (33) BRIDGE MEDIAN- CLOSED (NO BARRIER) 2
 (34) SKEW 22 DEG (35) STRUCTURE FLARED NO
 (10) INVENTORY ROUTE MIN VERT CLEAR 99.99 M
 (47) INVENTORY ROUTE TOTAL HORIZ CLEAR 19.7 M
 (53) MIN VERT CLEAR OVER BRIDGE RDWY 99.99 M
 (54) MIN VERT UNDERCLEAR REF- NOT H/RR M
 (55) MIN LAT UNDERCLEAR RT REF- NOT H/RR M
 (56) MIN LAT UNDERCLEAR LT M

***** NAVIGATION DATA *****

(38) NAVIGATION CONTROL- NOT APPLICABLE CODE N
 (111) PIER PROTECTION- NOT REQUIRED CODE 1
 (39) NAVIGATION VERTICAL CLEARANCE 0 M
 (116) VERT-LIFT BRIDGE NAV MIN VERT CLEAR 0 M
 (40) NAVIGATION HORIZONTAL CLEARANCE 0 M

***** SUFFICIENCY RATING *****

SUFFICIENCY RATING = 95.3

***** STATUS *****

HEALTH INDEX 100.0

PAINT CONDITION INDEX N/A

***** CLASSIFICATION *****

(112) NBIS BRIDGE LENGTH- YES Y
 (104) HIGHWAY SYSTEM- NOT ON NHS 0
 (26) FUNCTIONAL CLASS- MINOR ARTERIAL URBAN 16
 (100) DEFENSE HIGHWAY- NOT STRAHNET 0
 (101) PARALLEL STRUCTURE- NONE EXISTS N
 (102) DIRECTION OF TRAFFIC- 2 WAY 2
 (103) TEMPORARY STRUCTURE-
 (105) FED.LANDS HWY- NOT APPLICABLE 0
 (110) DESIGNATED NATIONAL NETWORK - NOT ON NET 0
 (20) TOLL- ON FREE ROAD 3
 (21) MAINTAIN- COUNTY HIGHWAY AGENCY 02
 (22) OWNER- COUNTY HIGHWAY AGENCY 02
 (37) HISTORICAL SIGNIFICANCE- NOT ELIGIBLE 5

***** CONDITION *****

(58) DECK 7
 (59) SUPERSTRUCTURE 8
 (60) SUBSTRUCTURE
 (61) CHANNEL & CHANNEL PROTECTION 8
 (62) CULVERTS

***** LOAD RATING AND POSTING *****

(31) DESIGN LOAD- MS - 18 OR HS - 20 5
 (63) OPERATING RATING METHOD- LOAD FACTOR 1
 (64) OPERATING RATING- 53.5
 (65) INVENTORY RATING METHOD- LOAD FACTOR 1
 (66) INVENTORY RATING- 32.6
 (70) BRIDGE POSTING-
 (41) STRUCTURE OPEN, POSTED OR CLOSED- A
 DESCRIPTION- OPEN, NO RESTRICTION

***** APPRAISAL *****

(67) STRUCTURAL EVALUATION 8
 (68) DECK GEOMETRY 7
 (69) UNDERCLEARANCES, VERTICAL & HORIZONTAL N
 (71) WATER ADEQUACY 8
 (72) APPROACH ROADWAY ALIGNMENT 8
 (36) TRAFFIC SAFETY FEATURES 1110
 (113) SCOUR CRITICAL BRIDGES 6

***** PROPOSED IMPROVEMENTS *****


(75) TYPE OF WORK- CODE
 (76) LENGTH OF STRUCTURE IMPROVEMENT M
 (94) BRIDGE IMPROVEMENT COST
 (95) ROADWAY IMPROVEMENT COST
 (96) TOTAL PROJECT COST
 (97) YEAR OF IMPROVEMENT COST ESTIMATE
 (114) FUTURE ADT 20000
 (115) YEAR OF FUTURE ADT 2018

***** INSPECTIONS *****


(90) INSPECTION DATE 10/02 (91) FREQUENCY 24 MO
 (92) CRITICAL FEATURE INSPECTION: (93) CFI DATE
 A) FRACTURE CRIT DETAIL- 0 MO A)
 B) UNDERWATER INSP- 0 MO B)
 C) OTHER SPECIAL INSP- 0 MO C)

NOV - 6 2002

A10A	ABBREVIATIONS
A10B	SYMBOLS
A62C	LIMITS OF PAYMENT FOR EXCAVATION AND BACKFILL-BRIDGE
A77A	METAL BEAM GUARD RAILING
A77B	METAL BEAM GUARD RAILING STANDARD HARDWARE
A77C	METAL BEAM GUARD RAILING POST AND BLOCKS
A77D	GUARD RAIL FLARES
B0-1	BRIDGE DETAILS
B0-5	BRIDGE DETAILS
B0-13	BRIDGE DETAILS
B7-1	BOX GIRDER DETAILS
B7-6	DECK DRAINS TYPES D-1 AND D-2
B7-10	UTILITY OPENING - BOX GIRDER
B7-11	UTILITY DETAILS
B8 5	CAST-IN-PLACE PRESTRESSED GIRDER DETAILS
B11-51	TUBULAR HAND RAILING
B11-53	CONCRETE BARRIER TYPE 25
ES-7A	SIGNAL, LIGHTING AND ELECTRICAL SYSTEMS ELECTRICAL DETAILS STRUCTURE INSTALLATIONS
ES-7C	SIGNAL LIGHTING AND ELECTRICAL SYSTEMS ELECTRICAL DETAILS STRUCTURE INSTALLATIONS

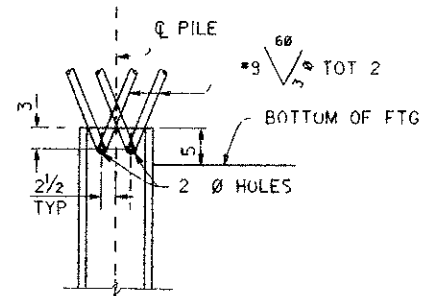

HP 10X57 STEEL PILE ANCHOR

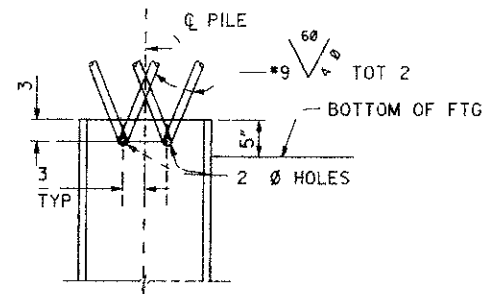

HP 14X89 STEEL PILE ANCHOR

GENERAL NOTES

LOAD FACTOR DESIGN

```

DESIGN                BRIDGE DESIGN SPECIFICATIONS
                      (1992 AASHTO WITH INTERIMS AND
                      REVISIONS BY CALTRANS)

DEAD LOAD             INCLUDES 35 psf FOR FUTURE WEARING SURFACE

LIVE LOADING          HS20-44 AND ALTERNATIVE AND PERMIT DESIGN LOAD

SEISMIC LOADING       PEAK ROCK ACCELERATION = 0.3g
                      DEPTH OF ALLUVIUM - 10 TO 80 FEET

                      DESIGN BASED ON CURRENT SPECIFICATION
                      WITH DUCTILITY/RISK FACTOR Z= 6.0

REINFORCED CONCRETE   fy = 60 000 psi
                      fc = 3 500 psi  UNLESS OTHERWISE NOTED
                      n = 9
                      (SEE CAMBER DIAGRAM AND CONCRETE STRENGTH & TYPE LIMITS SHEET)

                      TRANSVERSE DECK SLAB (WORKING STRESS DESIGN)
                      fs = 20 000 psi
                      fc = 1 200 psi
                      n = 10

PRESTRESSED CONCRETE  SEE PRESTRESSING NOTES ON GIRDER LAYOUT SHEETS

```

<u>SHEET NO</u>	<u>TITLE</u>
1	GENERAL PLAN
2	INDEX TO PLANS
3	STRUCTURE PLAN NO 1
4	STRUCTURE PLAN NO 2
5	DECK CONTOURS
6	FOUNDATION PLAN NO 1
7	FOUNDATION PLAN NO 2
8	ABUTMENT DETAILS NO 1
9	ABUTMENT DETAILS NO 2
10	ABUTMENT DETAILS NO 3
11	ABUTMENT DETAILS NO 4
12	BENT DETAILS NO 1
13	BENT DETAILS NO 2
14	BENT DETAILS NO 3
15	BENT DETAILS NO 4
16	TYPICAL SECTION
17	GIRDER LAYOUT NO 1
18	GIRDER LAYOUT NO 2
19	CAMBER DIAGRAM AND CONC STRENGTH & TYPE LIMITS
20	DECK DRAIN DETAILS
21	JOINT SEAL ASSEMBLY (MOVEMENT RATING = $5\frac{1}{2}$)
22	STRUCTURE APPROACH TYPE N (30S)
23	STRUCTURE APPROACH DRAINAGE DETAILS
24	EROSION PROTECTION PLAN
25	SMWD UTILITY DETAILS
26	MISCELLANEOUS DETAILS
27	LOG OF TEST BORINGS

DE 3 (161 8)
heet 50 OF 126

RECORD DRAWING

3 inches on original drawing

ORANGE COUNTY
ENVIRONMENTAL MANAGEMENT AGENCY
ANTONIO PARKWAY
BRIDGE OVER
SAN JUAN CREEK

INDEX TO PLANS

21

DESIGNED <i>Steve A. Whitaker</i>		5
CHECKED <i>R. Hort</i>		
SCALE	DATE	DRAWING NO
AS SHOWN		

DR. 3 (6158)


BR # 55C0628

PLAN PREPARED BY

HNTB

36 EXECUTIVE PARK
SUITE 300
IRVINE, CALIFORNIA 92614

Design Filename p 24897 cadd anoir 1.dgn
Plotted n 17 OCT 1996 16 generated by whtfer

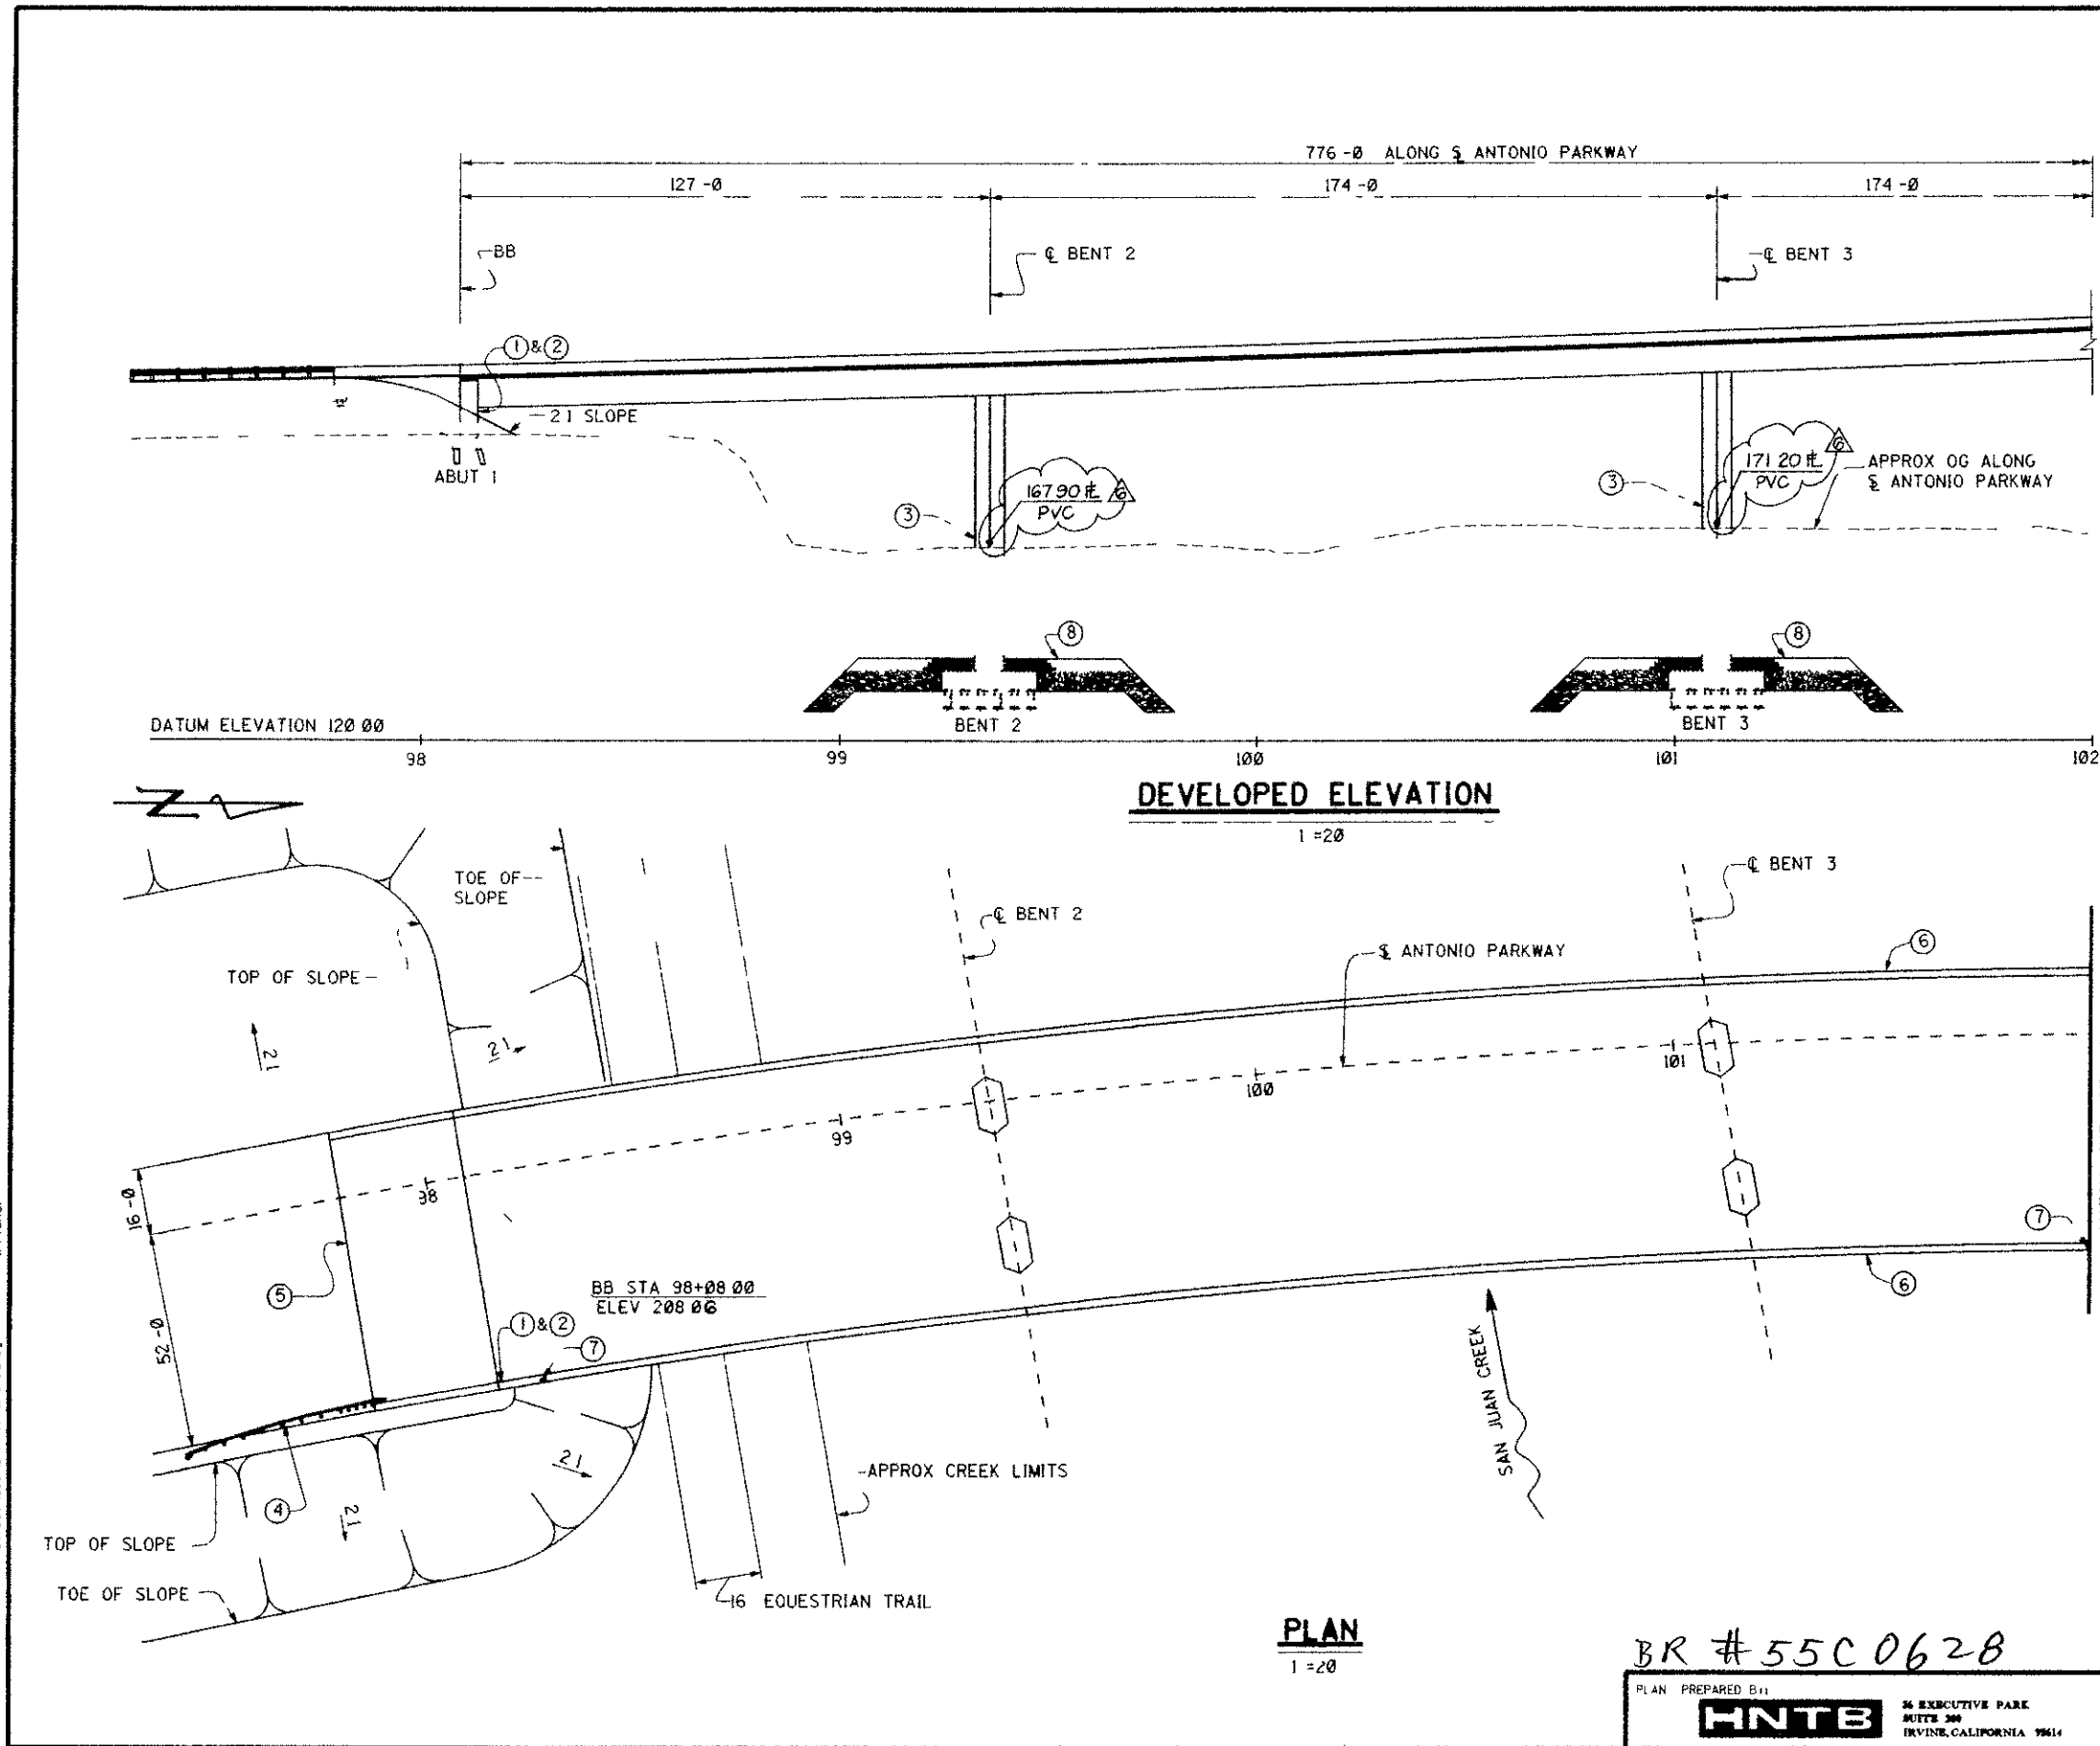

LEGEND

- ① = PAINT BRIDGE NO 55C-628
- ② = PAINT ANTONIO PARKWAY BRIDGE AND YEAR COMPLETED
- ③ = PAINT BENT NO
- ④ = METAL BEAM GUARD RAIL TYPE 1 FLARE (A77A)
- ⑤ = STRUCTURE APPROACH TYPE N(305)
- ⑥ = CONCRETE BARRIER TYPE 25 MOD
- ⑦ = TYPE 9A PULL BOX IN TOP OF BARRIER (TOT 3) SEE MISCELLANEOUS DETAILS SHEET
- ⑧ = RIPRAP PILE CAP PROTECTION SEE EROSION PROTECTION PLAN SHEET

NOTES

- 1 FOR TYPICAL SECTION SEE "GENERAL PLAN SHEET"
- 2 FOR DECK DRAIN LOCATIONS SEE DECK DRAIN DETAILS SHEET
- 3 FOR MANHOLE AND SOFFIT ACCESS OPENINGS SEE GIRDER LAYOUTS

DR 3 (16158)
Sheet 51 of 126

RECORD DRAWING


ORANGE COUNTY ENVIRONMENTAL MANAGEMENT AGENCY	
ANTONIO PARKWAY BRIDGE OVER SAN JUAN CREEK	
STRUCTURE PLAN NO. 1	
3/27	
DESIGNED: Steve A. Whitaker	
DRAWN: L. Wasi	
CHECKED: R. Hart	
SCALE: AS SHOWN	
DATE: 12/26/96	
DRAWING NO: 51	
OF 126	


BR #55C0628


PLAN PREPARED BY:
HNTB
36 EXECUTIVE PARK
SUITE 300
IRVINE, CALIFORNIA 92614

Design: rene
Plotted: r
07 OCT 1996 15:41 Generated by: Whitaker


DR 3 (16158)

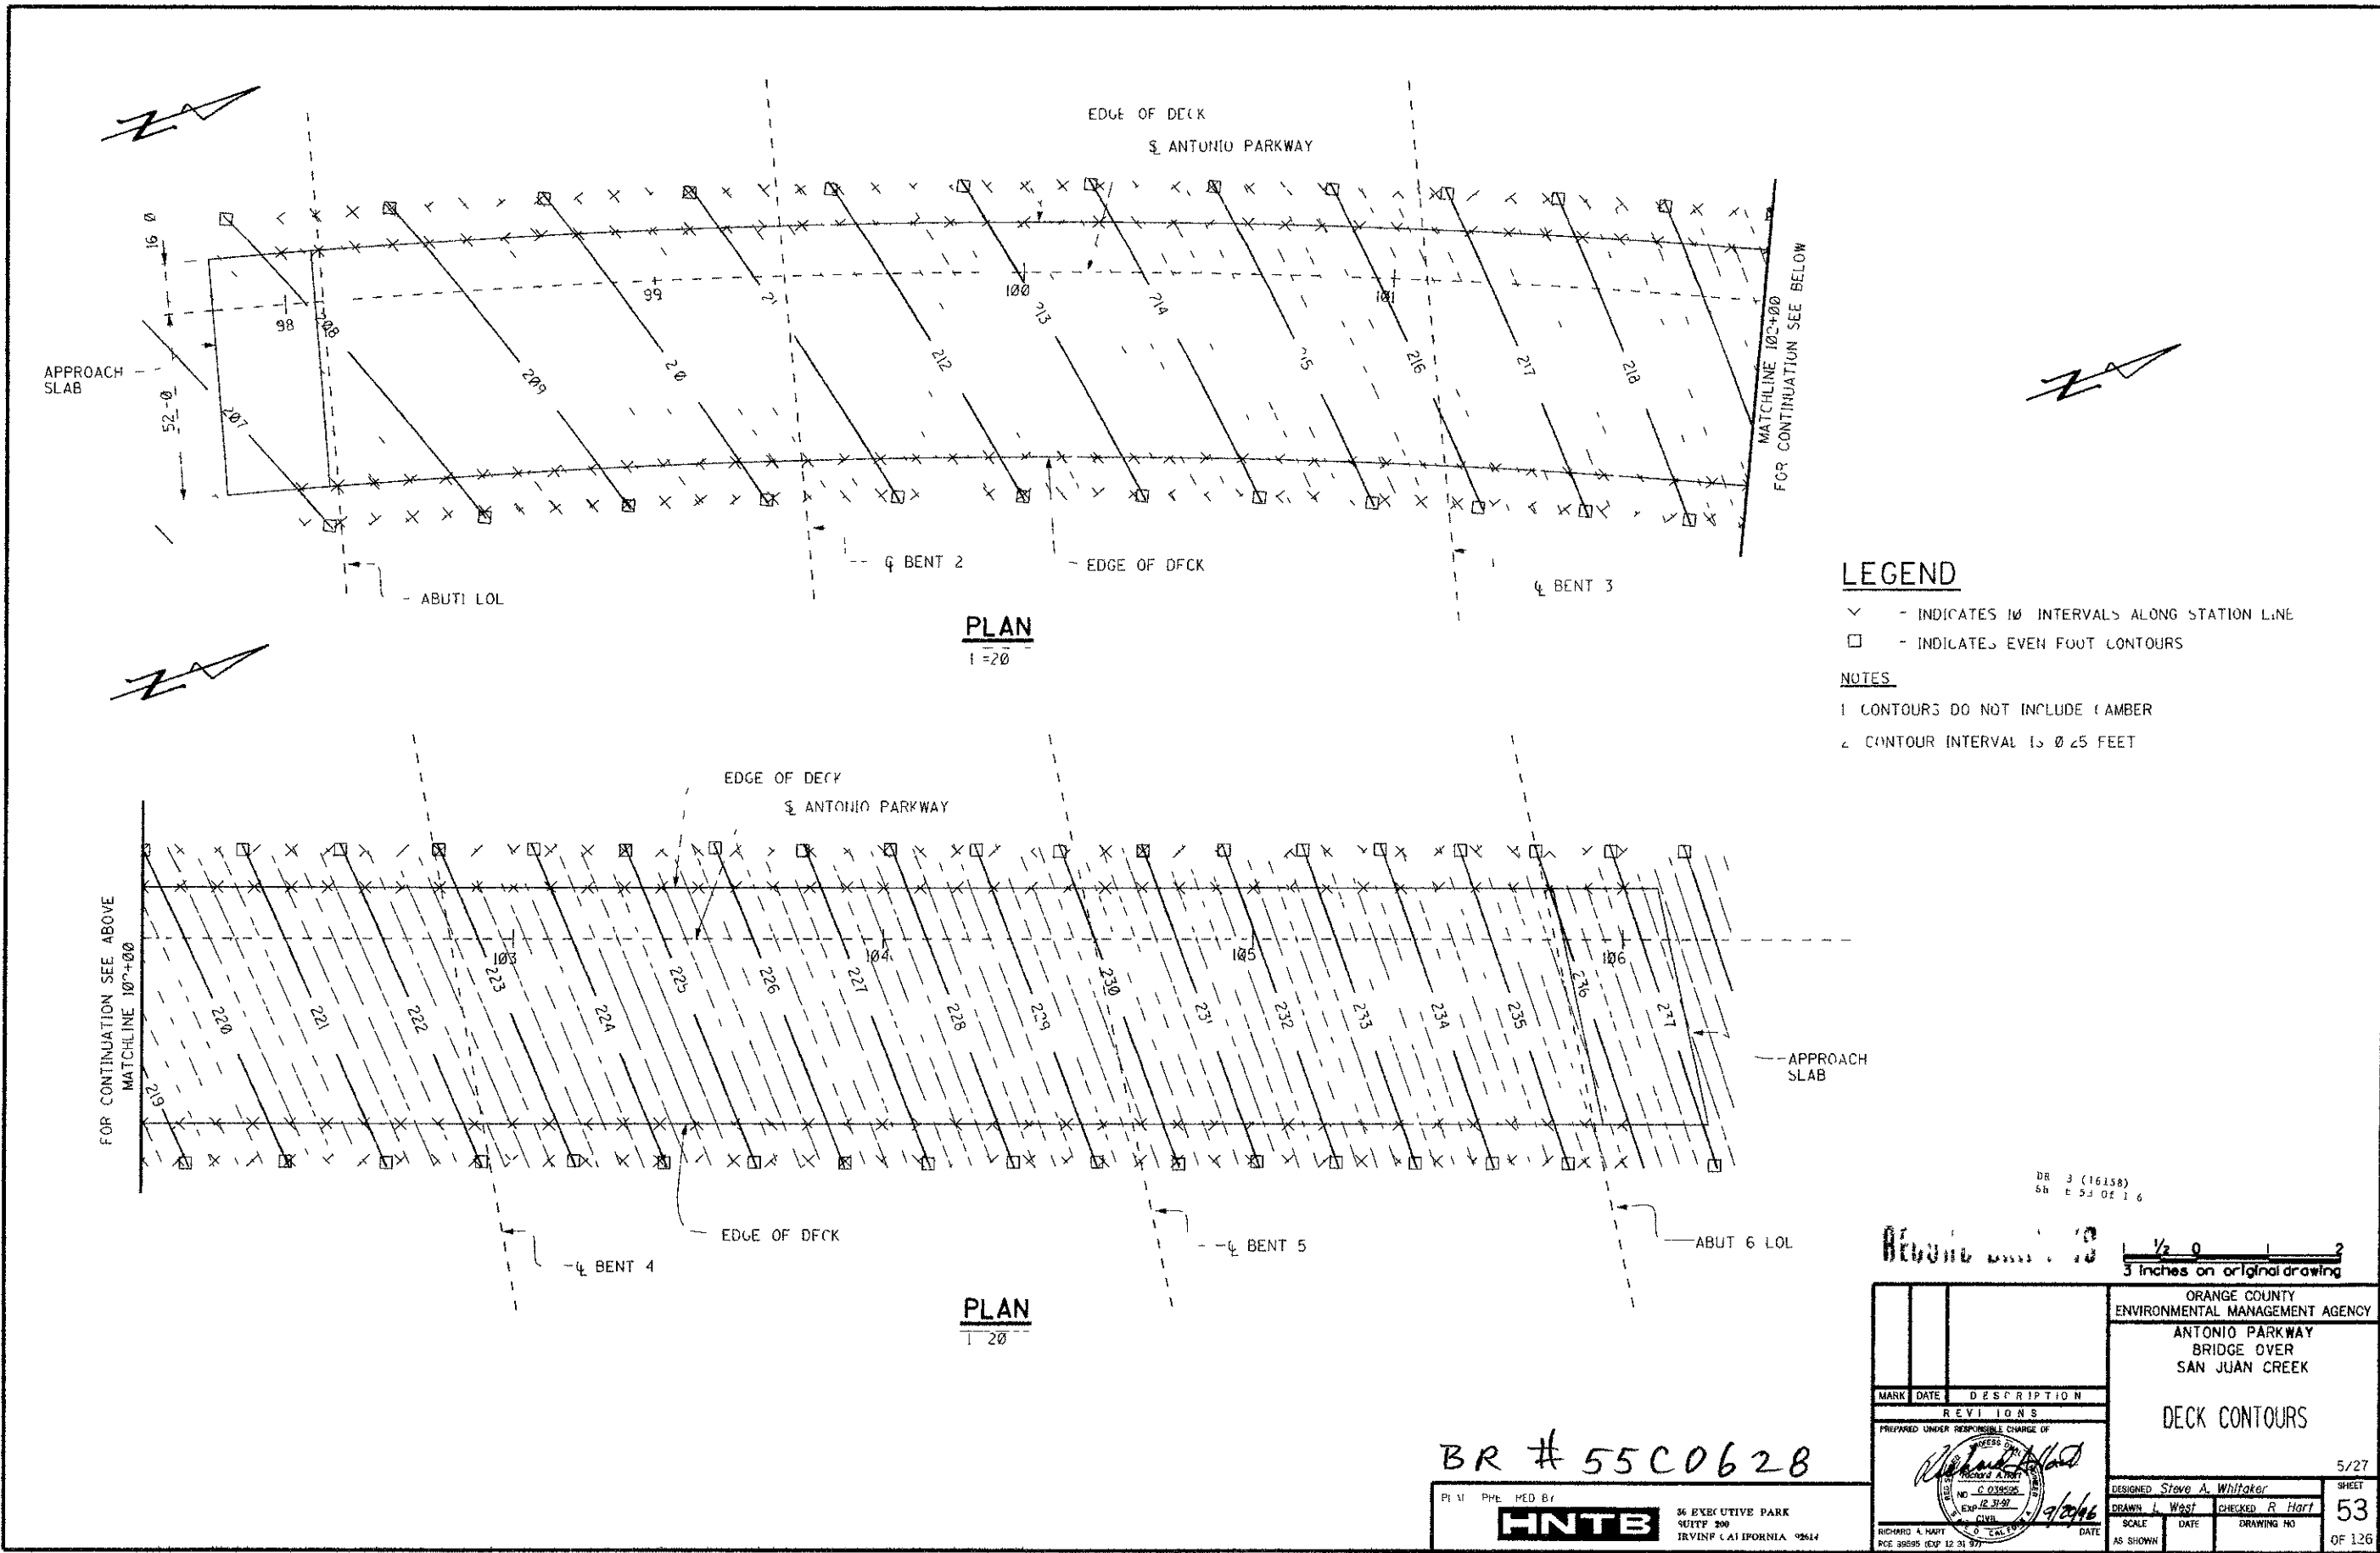

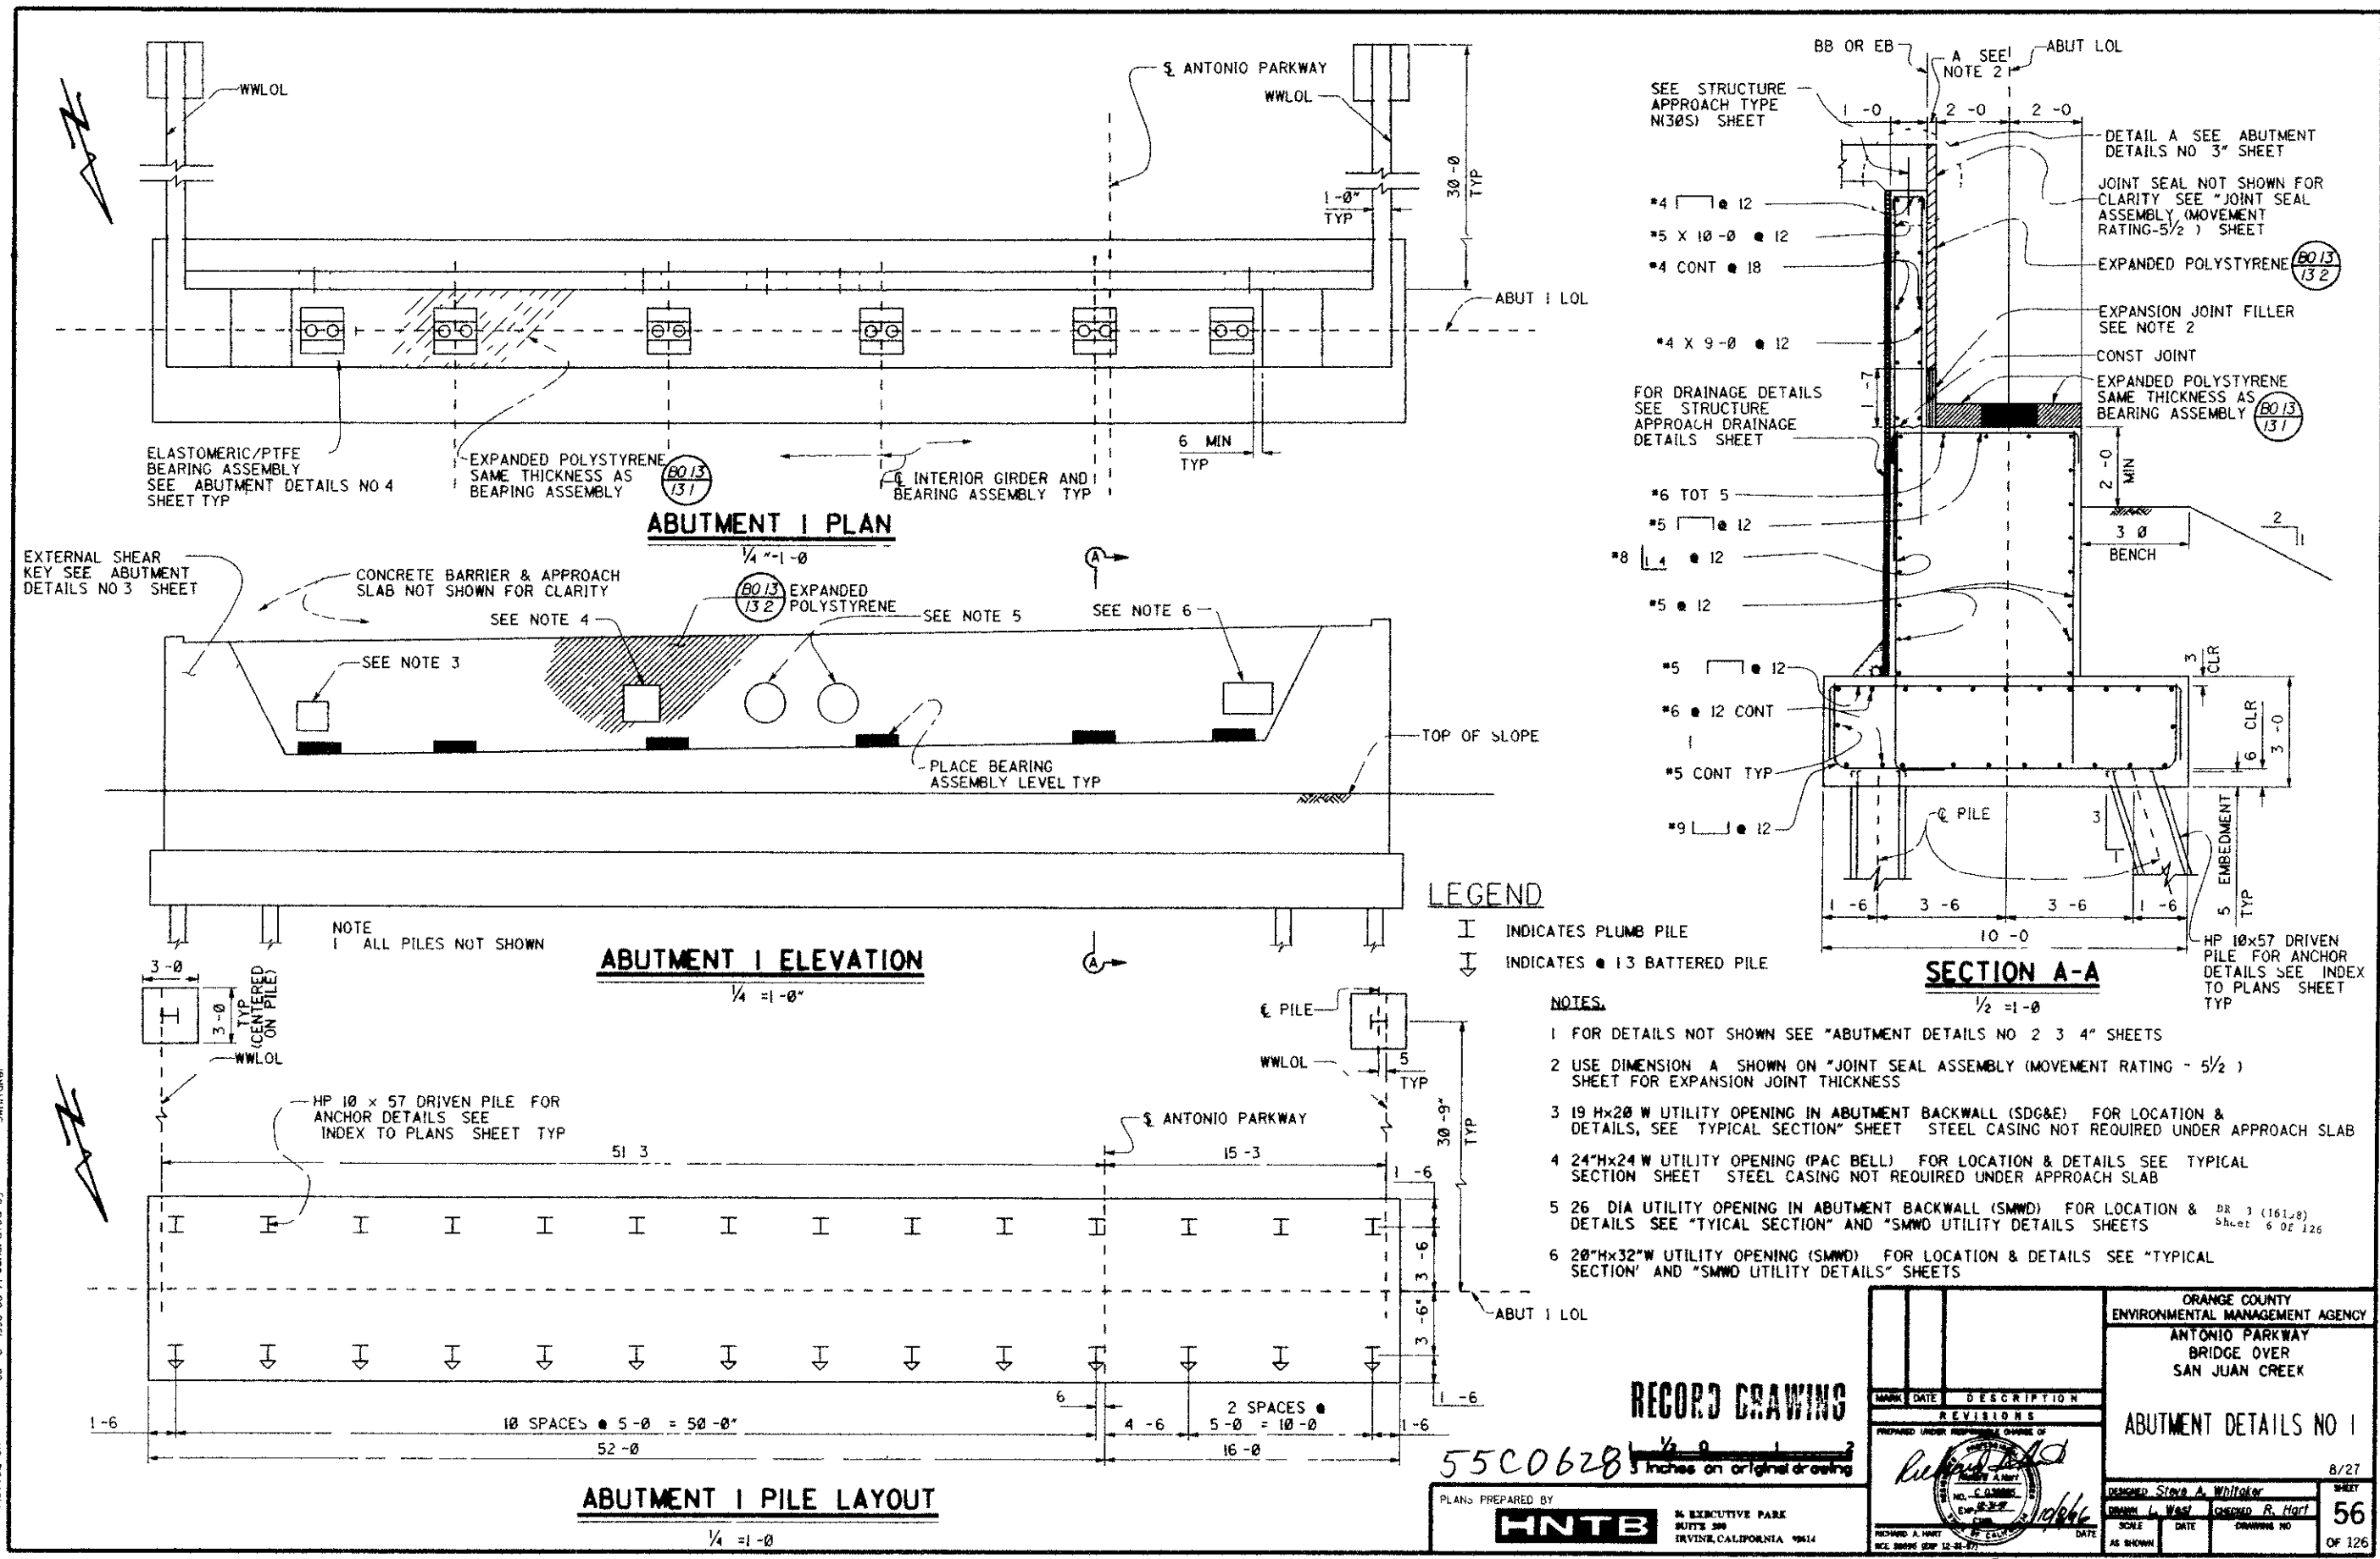


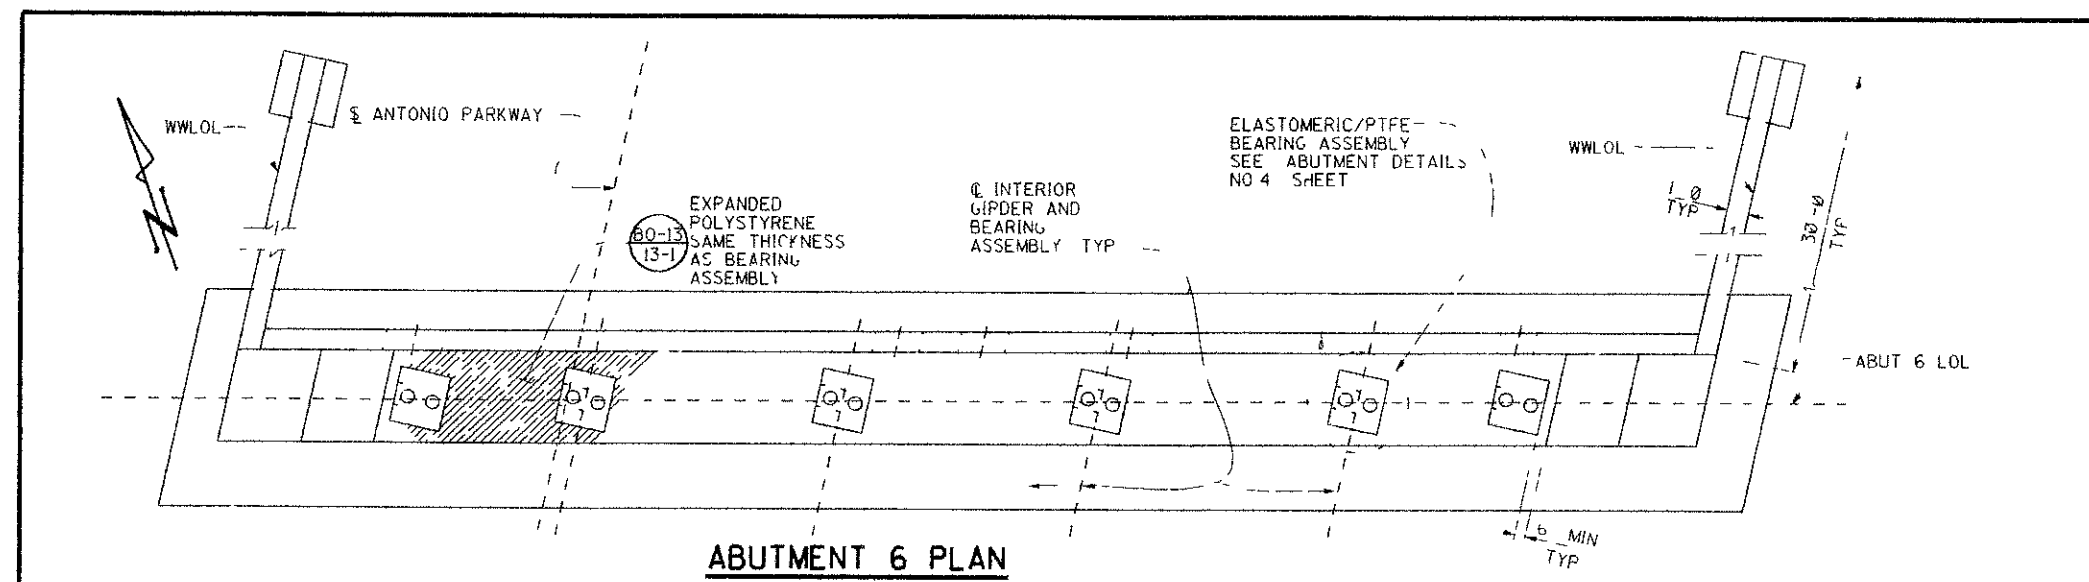

ABUTMENT 6 PLAN

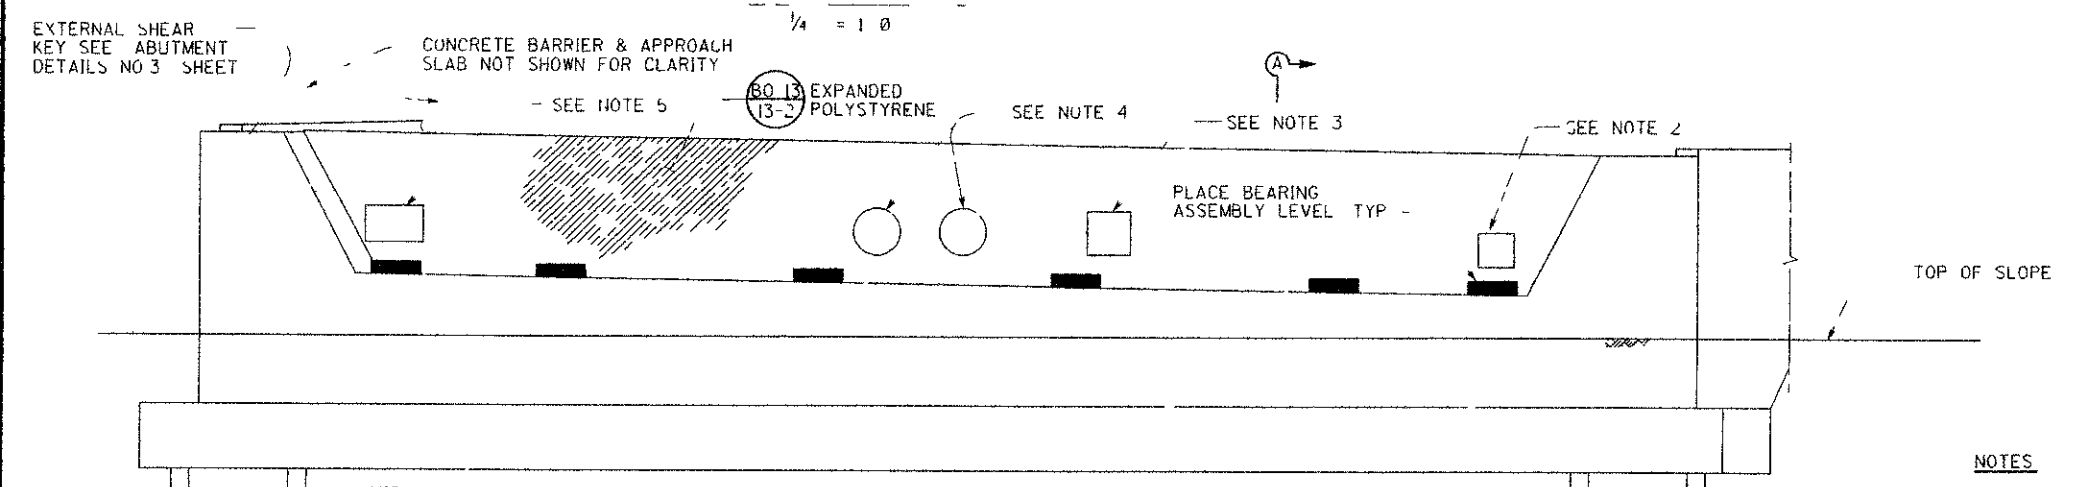

ABUTMENT 6 ELEVATION

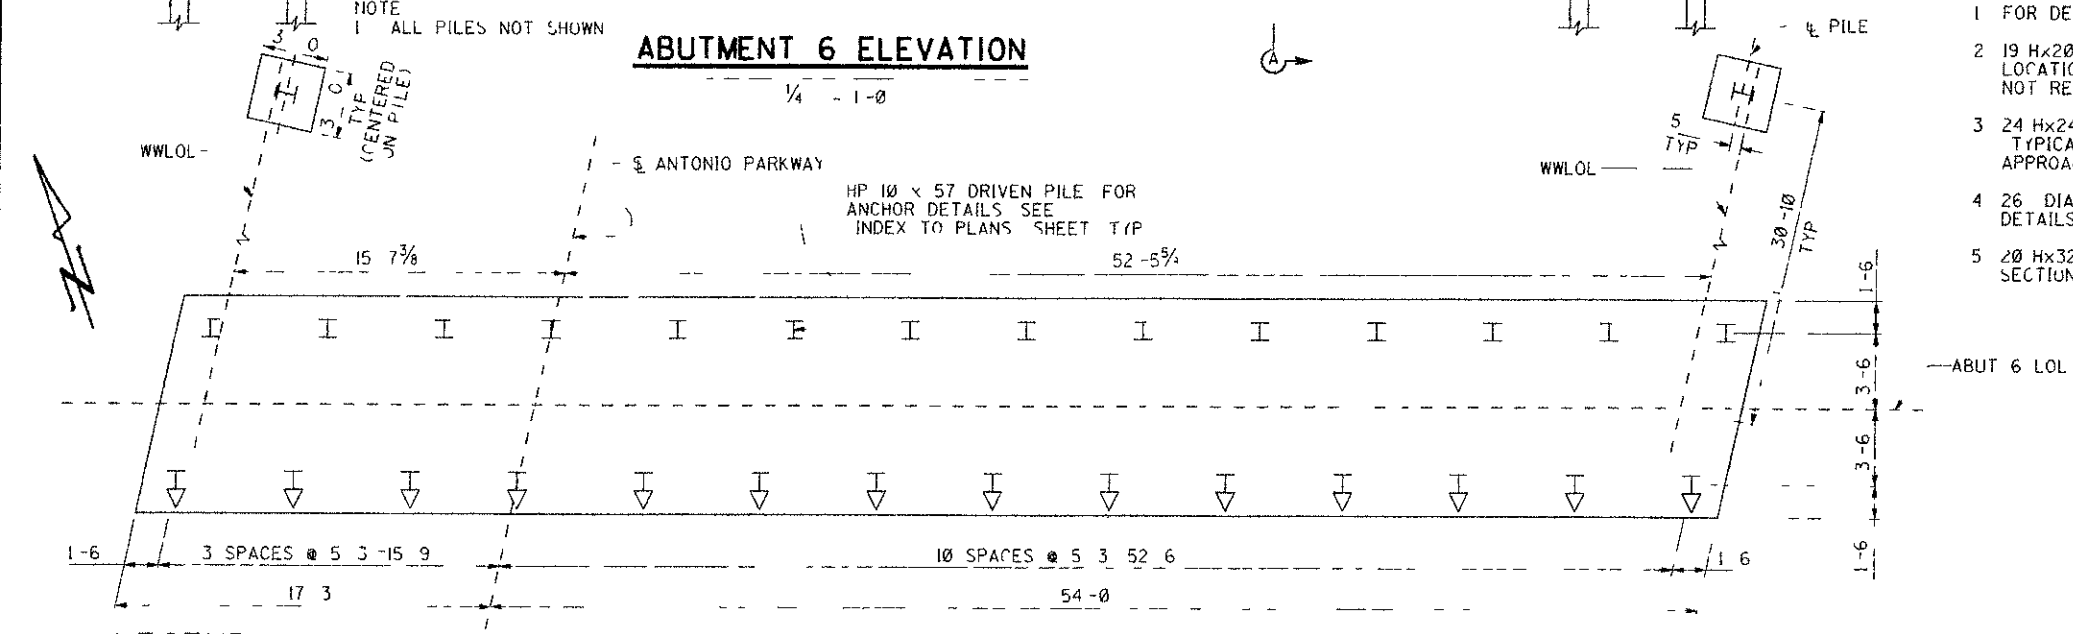

ABUTMENT 6 PILE LAYOUT

LEGEND
 I = INDICATES PLUMB PILE
 T = INDICATES BATTERED PILE

NOTES

- 1 FOR DETAILS NOT SHOWN SEE ABUTMENT DETAILS NO 1 3 4 SHEETS
- 2 19 Hx20 W UTILITY OPENING IN ABUTMENT BACKWALL (SDGRE) FOR LOCATION & DETAILS SEE TYPICAL SECTION SHEET STEEL CASING NOT REQUIRED UNDER APPROACH SLAB
- 3 24 Hx24 W UTILITY OPENING (PAC BELL) FOR LOCATION & DETAILS SEE TYPICAL SECTION SHEET STEEL CASING NOT REQUIRED UNDER APPROACH SLAB
- 4 26 DIA UTILITY OPENING IN ABUTMENT BACKWALL (SMWD) FOR LOCATION & DETAILS SEE TYPICAL SECTION AND SMWD UTILITY DETAILS SHEETS
- 5 20 Hx32 W UTILITY OPENING (SMWD) FOR LOCATION & DETAILS SEE TYPICAL SECTION AND SMWD UTILITY DETAILS SHEETS

DP 3 (16159)
 She r 57 OF 126

3 inches on original drawing

ORANGE COUNTY
 ENVIRONMENTAL MANAGEMENT AGENCY
 ANTONIO PARKWAY
 BRIDGE OVER
 SAN JUAN CREEK

ABUTMENT DETAILS NO 2

9/77

DESIGNED *Steve A. Whitaker*
 DRAWN *L. West* CHECKED *P. Hart*
 SCALE DATE DRAWING NO
 AS SHOWN


BR # 55C 0628



HNTB
 34 EXECUTIVE PARK
 SUITE 200
 IRVINE CALIFORNIA 92614

RICHARD A. HART
 RCE 3909 LEOP 12 31 87

9/77
 57
 OF 126

DR 3 (16159)

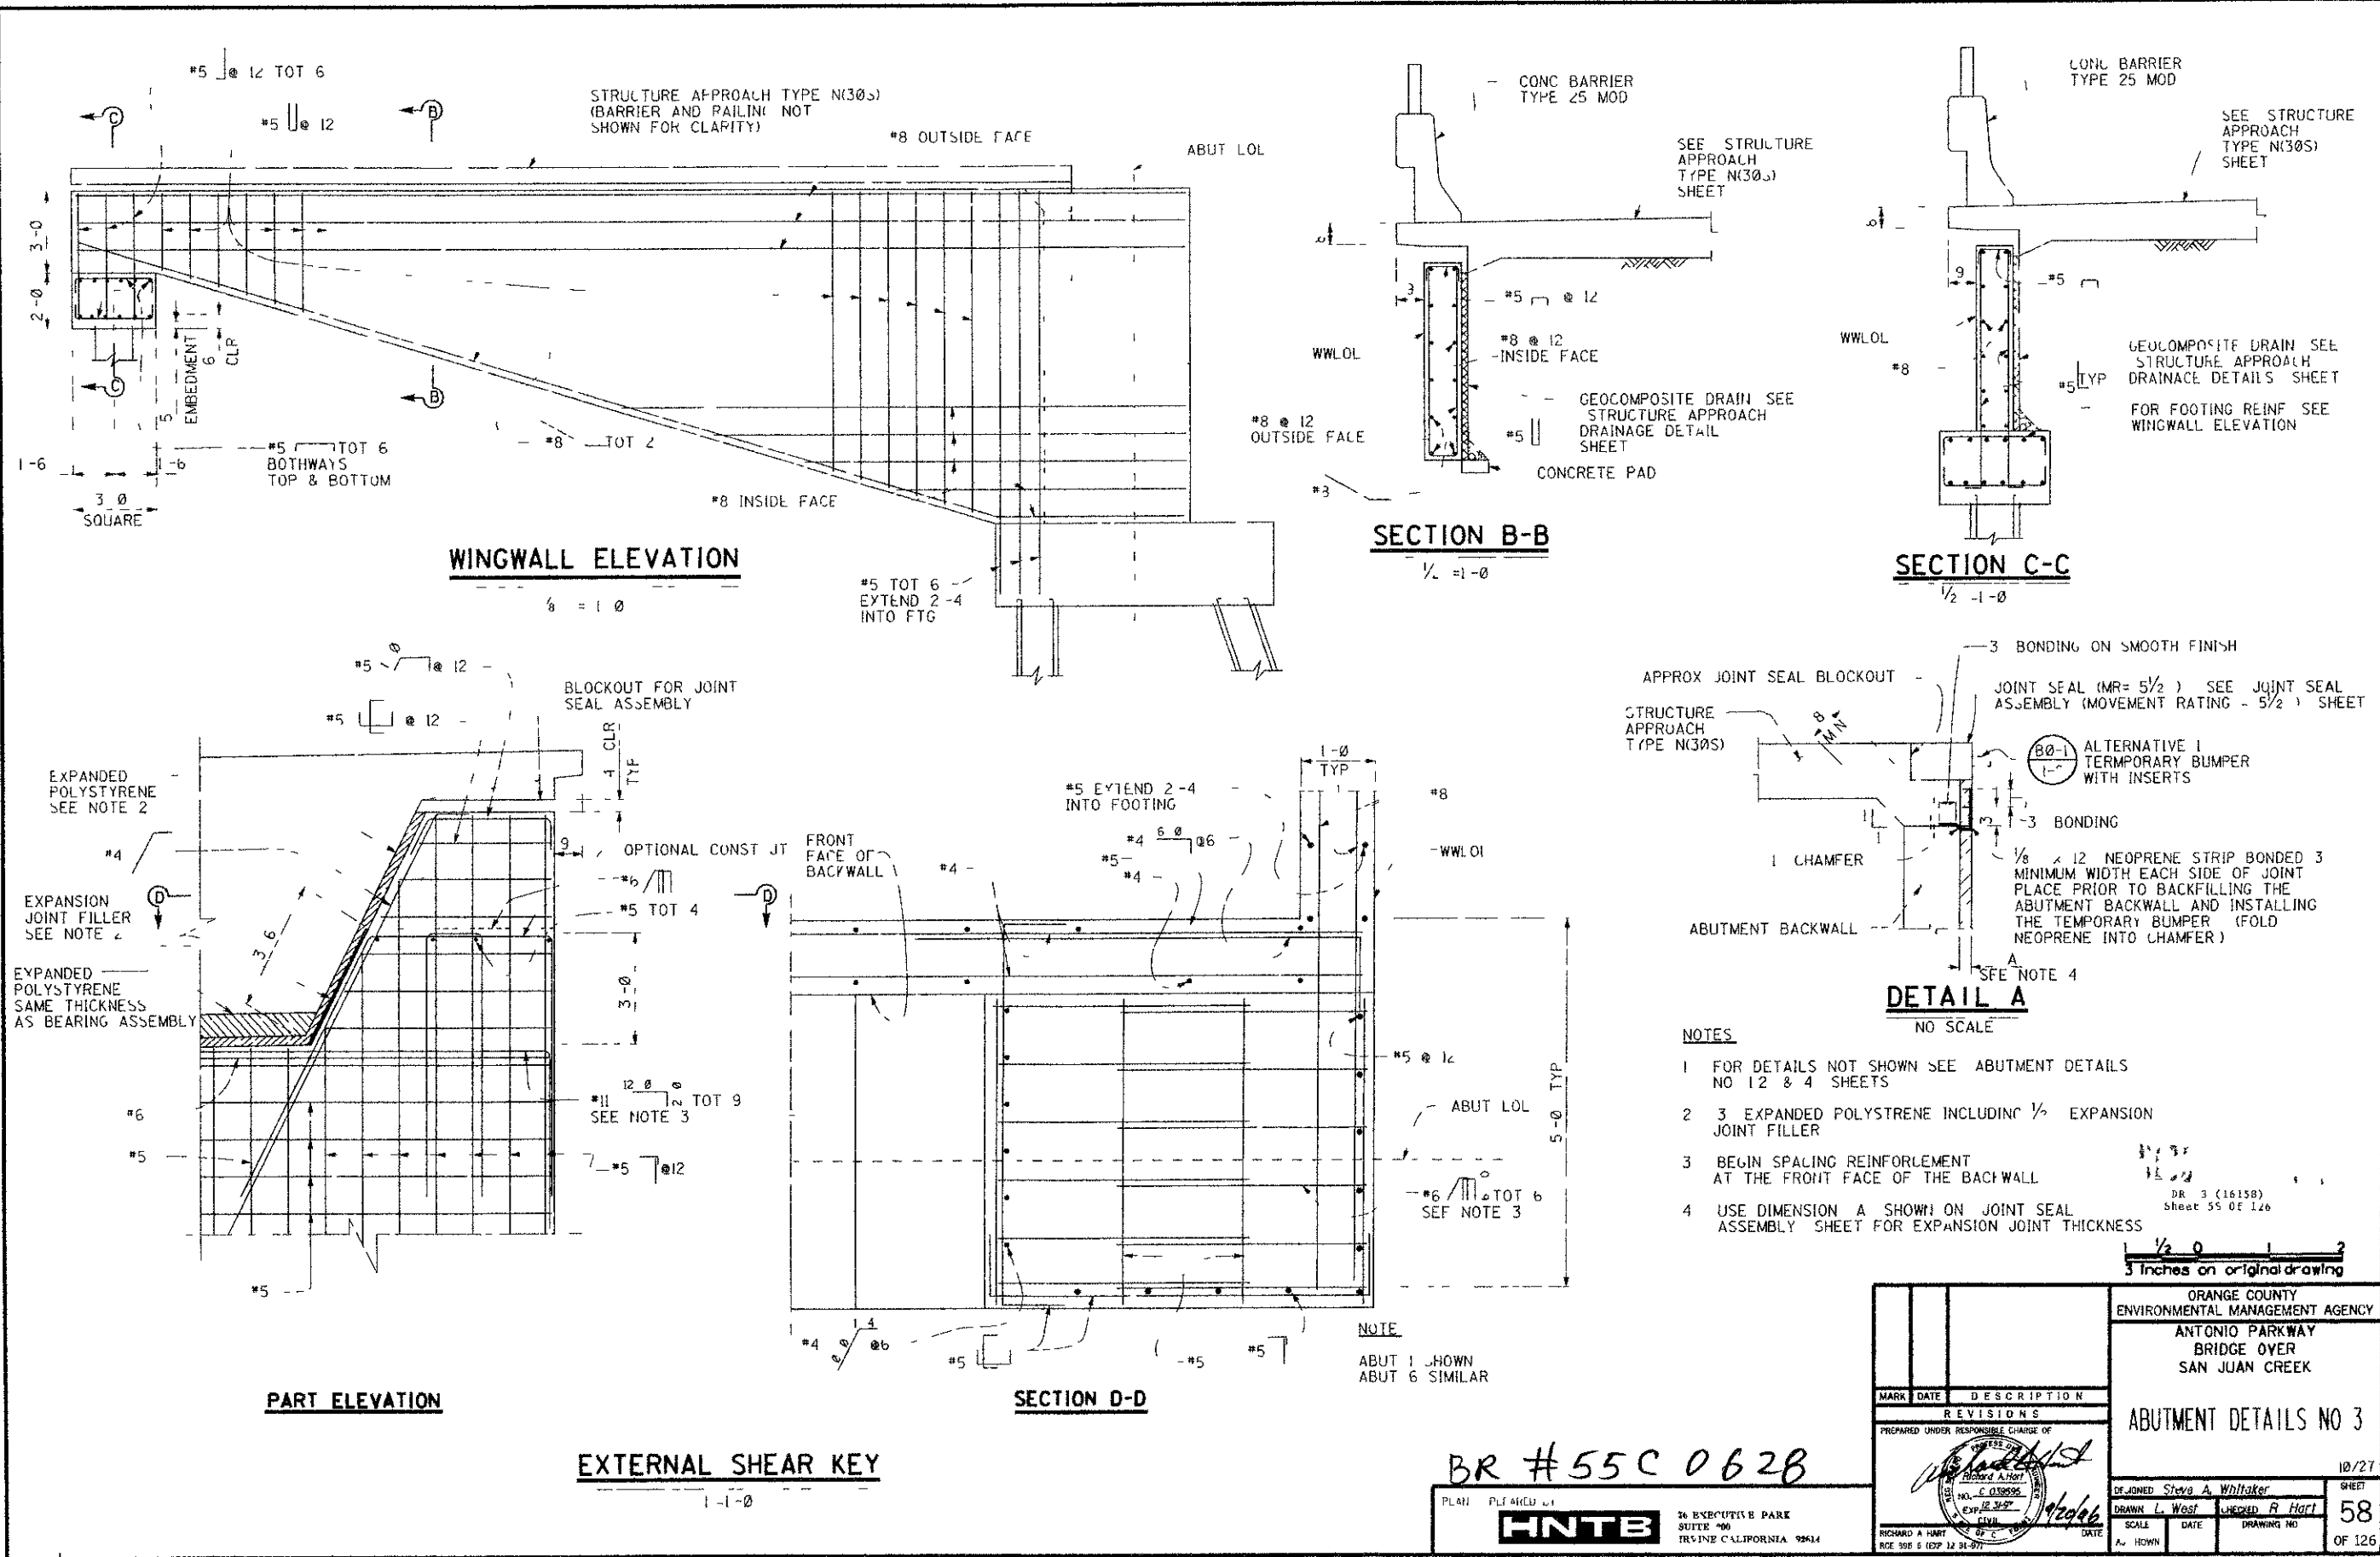

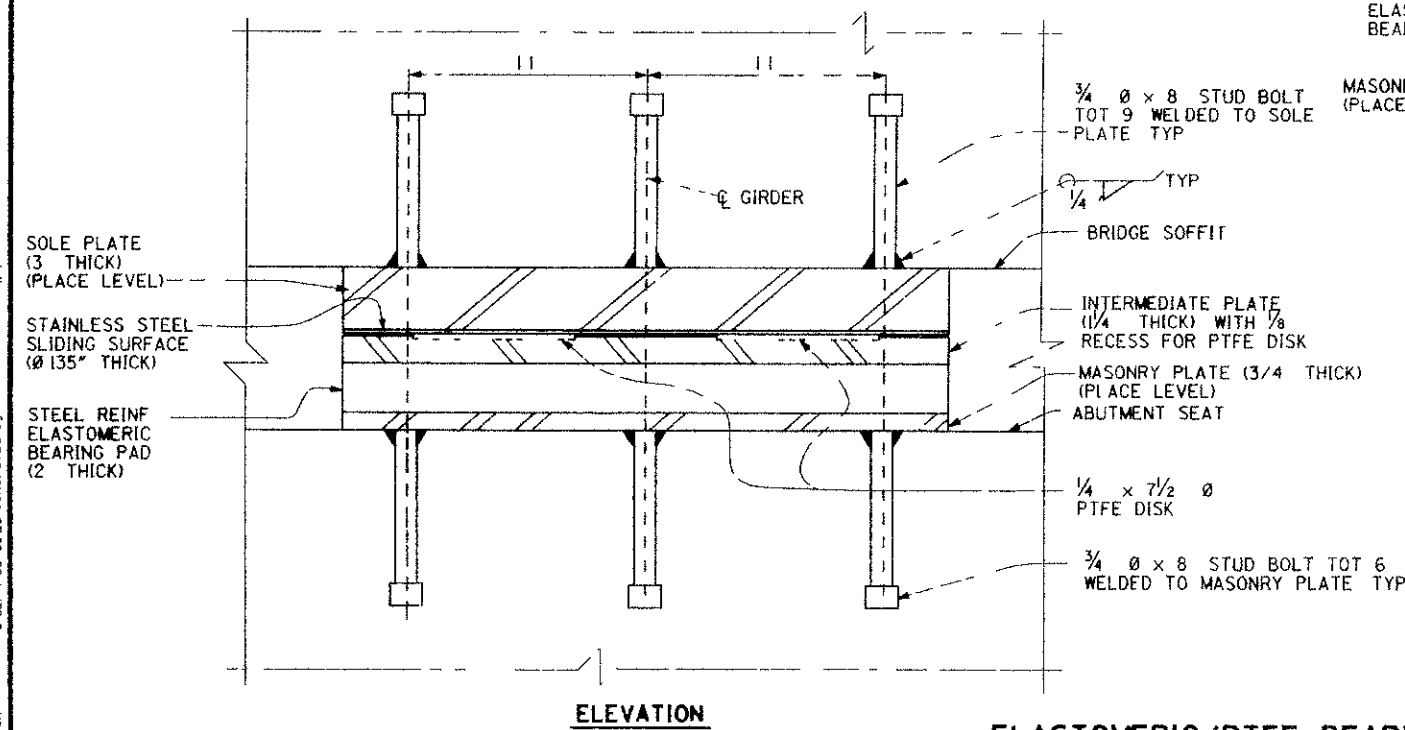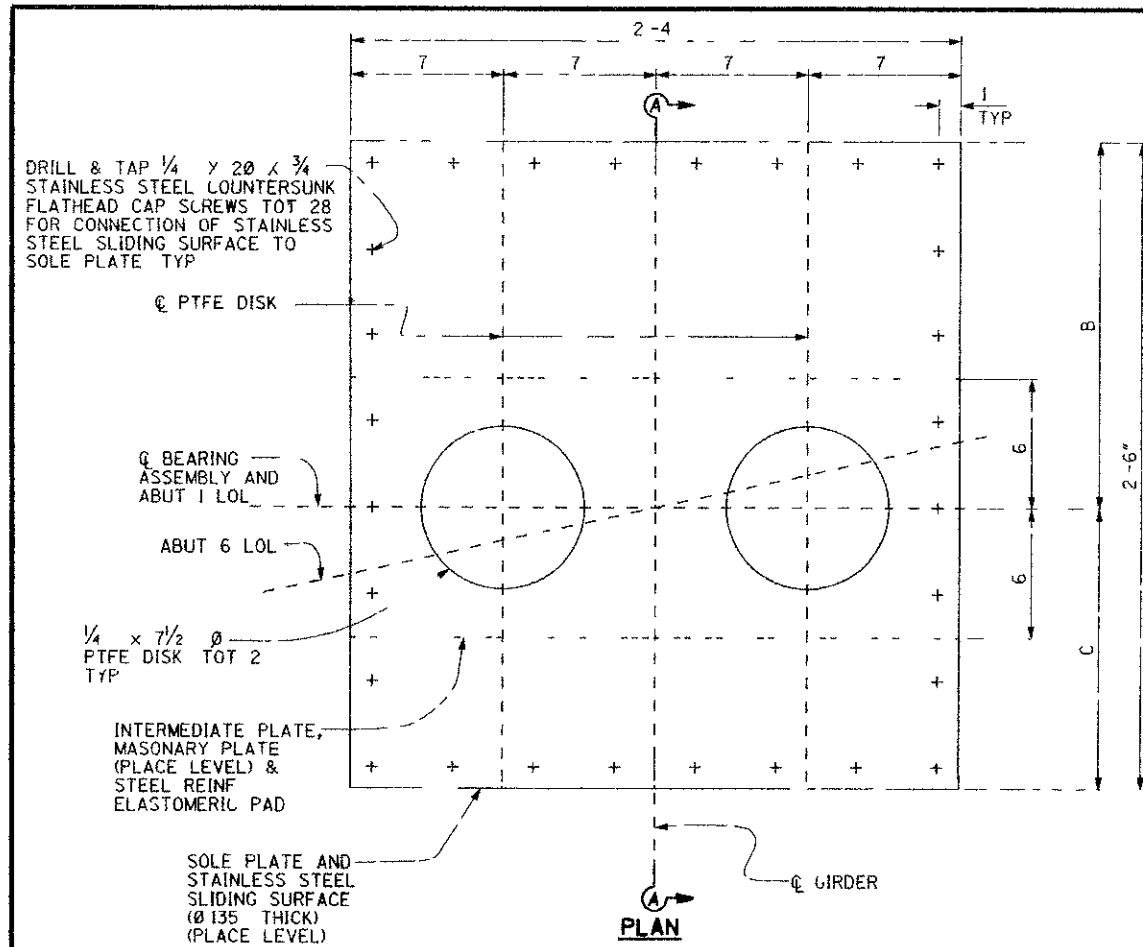


ELASTOMERIC/PTFE BEARING ASSEMBLY

3 = 1 - 0

DESIGN VALUES	
MAXIMUM VERTICAL LOAD (KIPS PER ASSEMBLY)	MINIMUM VERTICAL LOAD (KIPS PER ASSEMBLY)
260	207

LOCATION	B DIMENSION			C DIMENSION		
	WINT	SUMM	SPR/FALL	WINT	SUMM	SPR/FALL
ABUTMENT 1	1-7 $\frac{1}{4}$	1-5	1-6	10 $\frac{3}{4}$	1-1	1-0
ABUTMENT 6	1-7 $\frac{1}{4}$	1-5	1-6	10 $\frac{3}{4}$	1-1	1-0

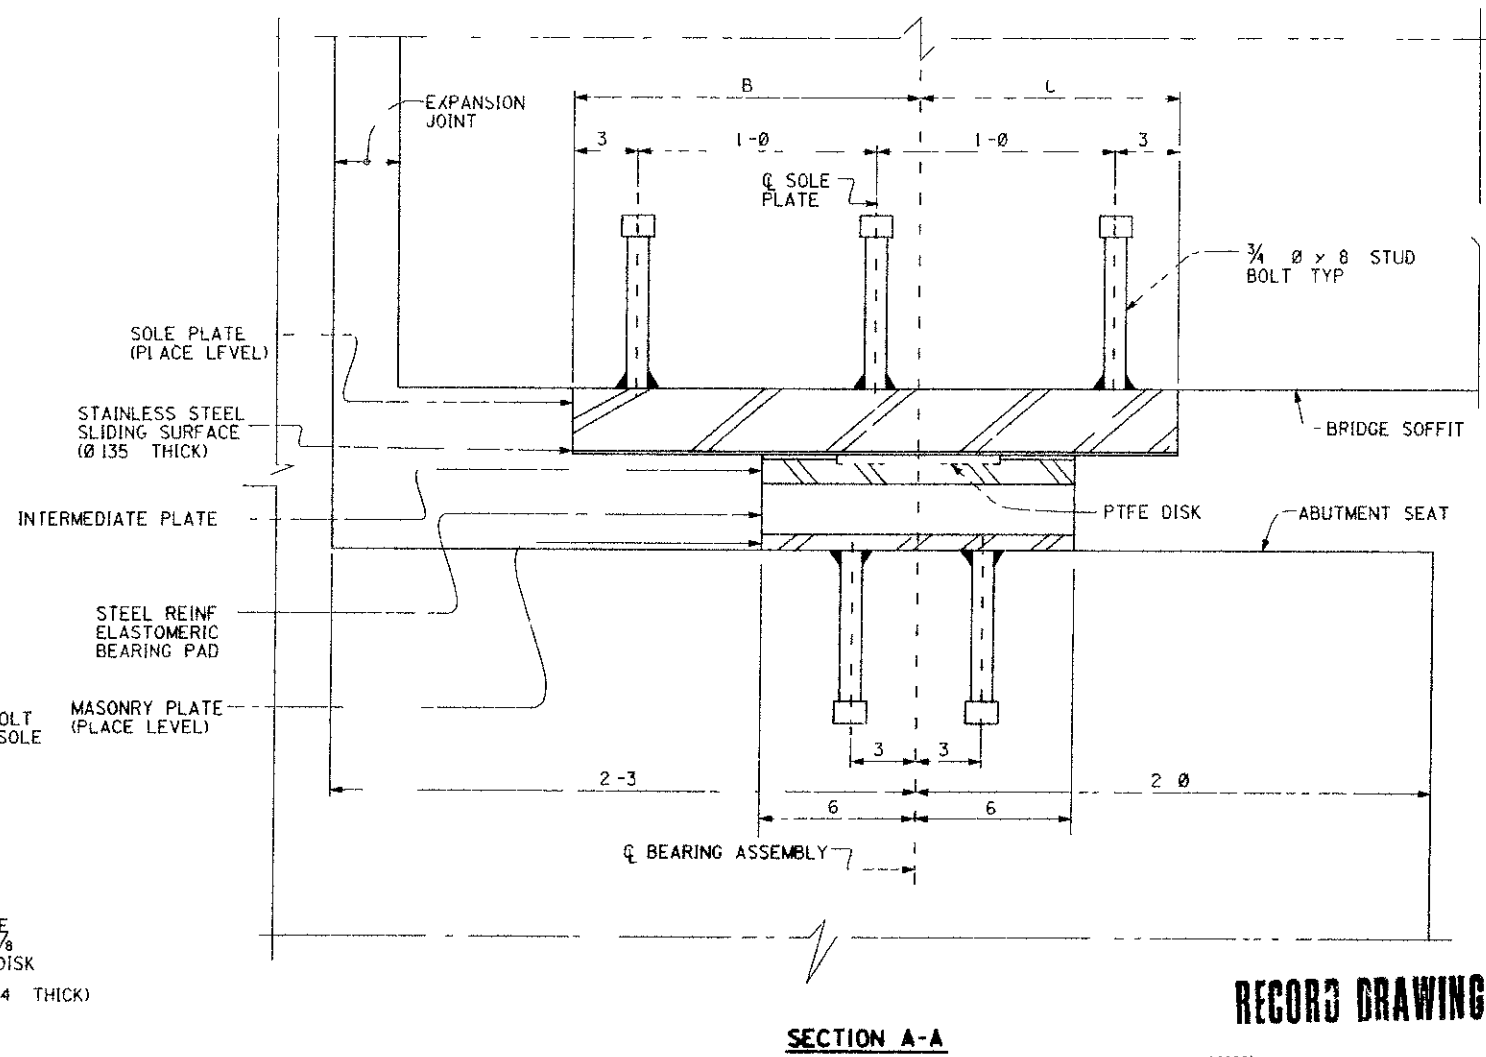

RECORD DRAWING

DR 3 (16158)
Sheet 59 OF 126

1 1/2" = 1'-0" 3 inches on original drawing

ORANGE COUNTY ENVIRONMENTAL MANAGEMENT AGENCY		ANTONIO PARKWAY BRIDGE OVER SAN JUAN CREEK	
ABUTMENT DETAILS NO. 4		11/27	
DESIGNED: Steve A. Whitaker	CHECKED: R. Hart	59	
SCALE: AS SHOWN	DATE: 11/27	OF 126	

PLANS PREPARED BY: HNTB 36 EXCLUSIVE PARK SUITE 300 IRVINE, CALIFORNIA 92614

NO. C-000000


PREPARED UNDER RESPONSIBLE CHARGE OF: [Signature]

DATE: 11/27


BR #55C 0628

DR 8 (16158)

Design File name: P:\2488\0004\0110044.dgn
Plotted on: 0 SEP 1996 09:20 Generated by: [Signature]

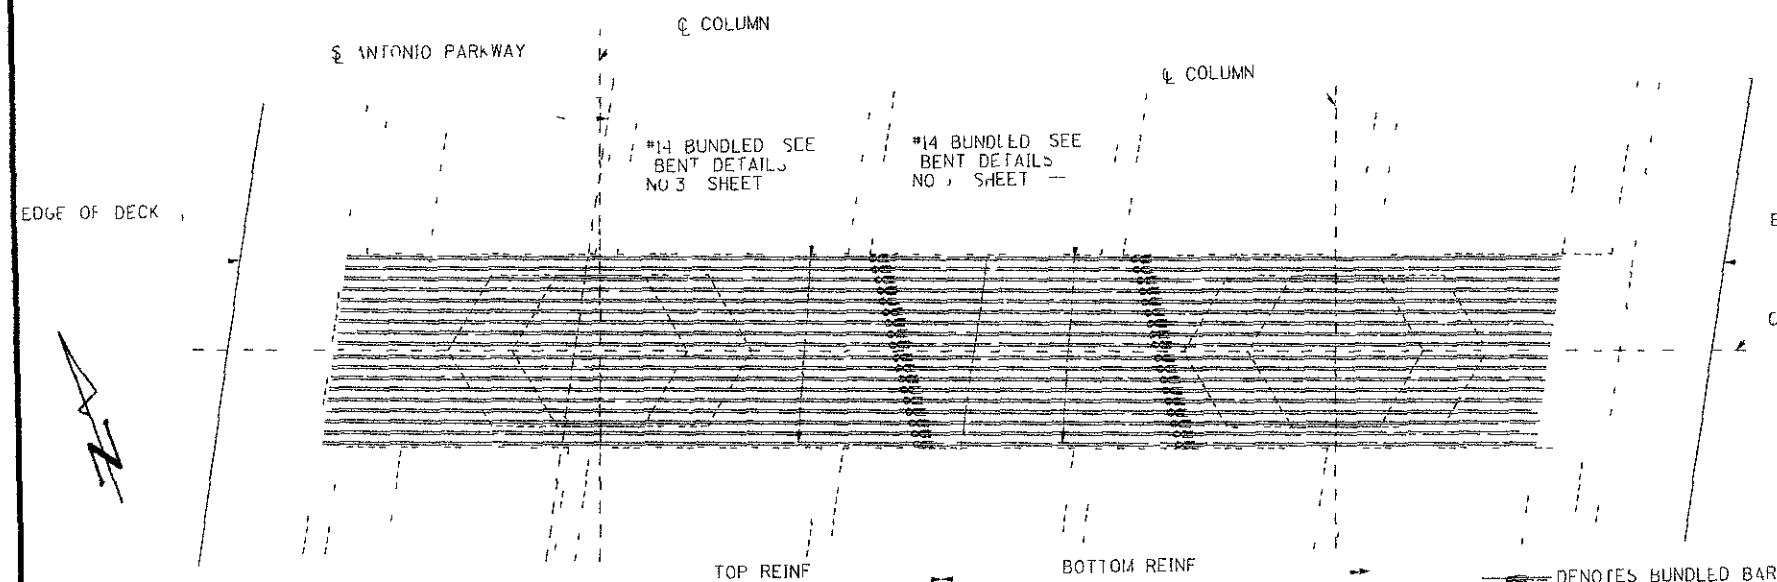


BENTS 2, 3 & 4 PLAN

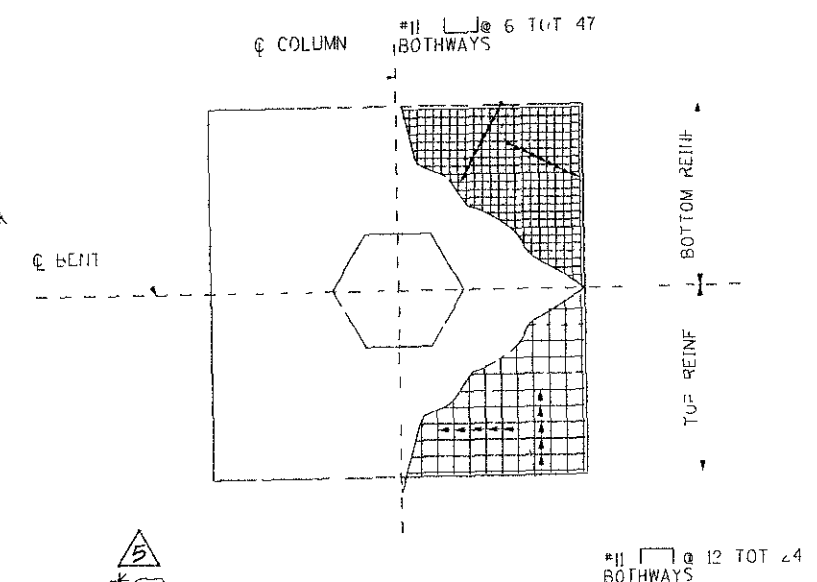

BENTS 2, 3 & 4 FOOTING REINFORCEMENT


#7 STIRRUPS
SPACING EXCEPT AS NOTED PLACE PARALLEL TO GIRDERS

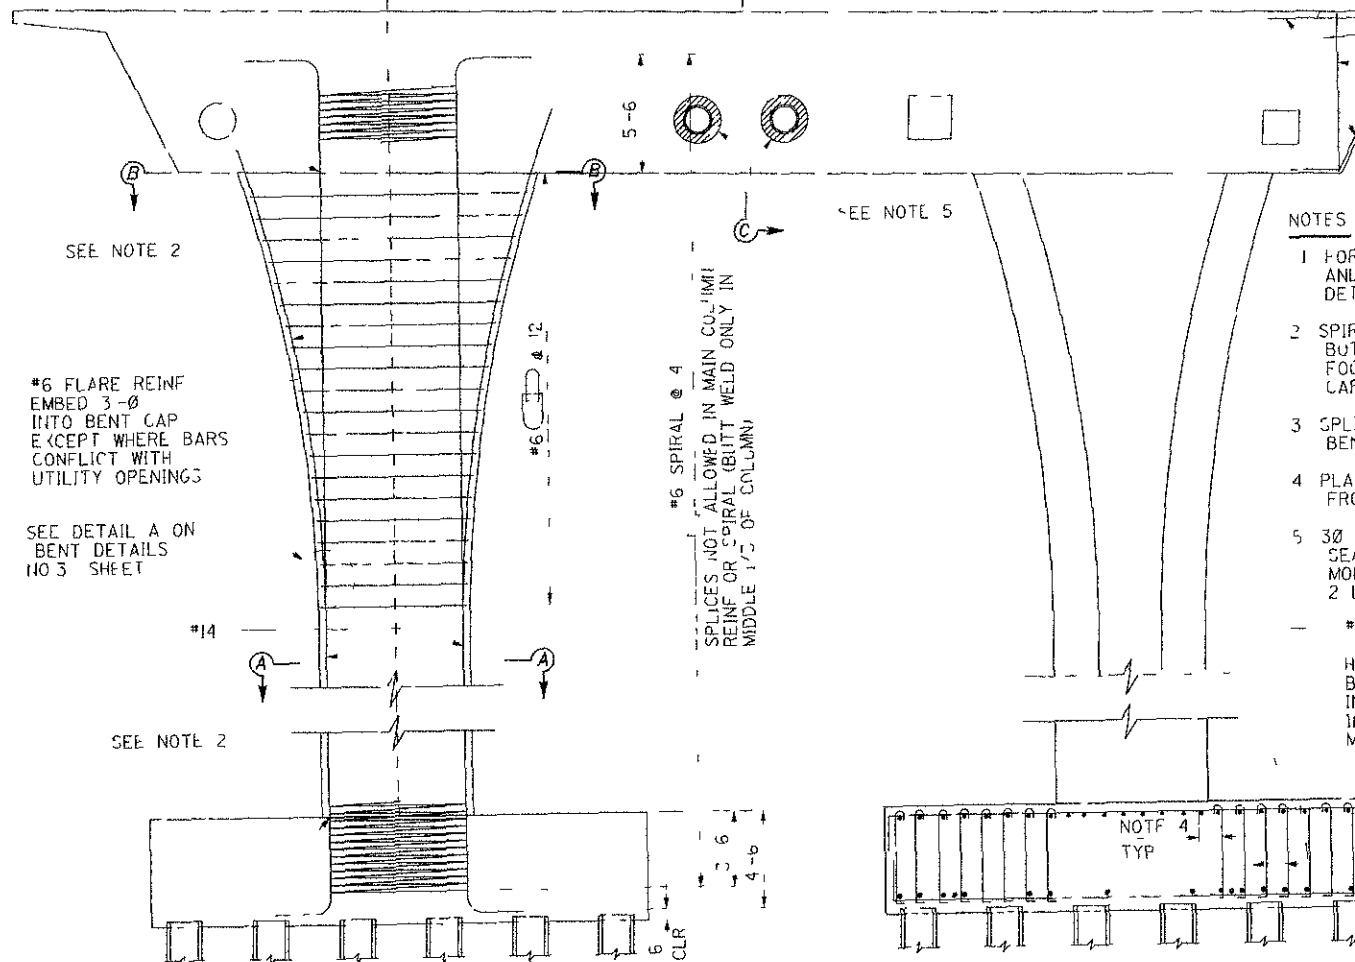

BENTS 2, 3 & 4 ELEVATION

NOTES

- 1 FOR SECTIONS A-A B-B C-C AND DETAILS NOT SHOWN SEE BENT DETAILS NO 3 AND NO 4 SHEETS
 - 2 SPIRAL MAY BE DISCONTINUOUS AT BOTTOM OF BENT CAP OR TOP OF FOOTING TO ALLOW FOR PLACING CAP OR FOOTING REINFORCEMENT
 - 3 SPLICES NOT ALLOWED IN MAIN BENT CAP REINF (BUTT WELD ONLY)
 - 4 PLACE PILE CAP STIRRUPS & MAX FROM MAIN COLUMN REINFORCEMENT
 - 5 30 DAYS AFTER PRESTRESSING IS COMPLETE SEAL AROUND UTILITY WITH CONCRETE OR MORTAR AFTER TIGHTLY WRAPPING WITH 2 LAYERS OF 15# BUILDING PAPER
- #5 @ 12 MAY BOTHWAYS
- HOOK AROUND TOP AND BOTTOM MATS AT EACH INTERSECTION OF BARS IN TOP MAT OUTSIDE MAIN COLUMN REINF

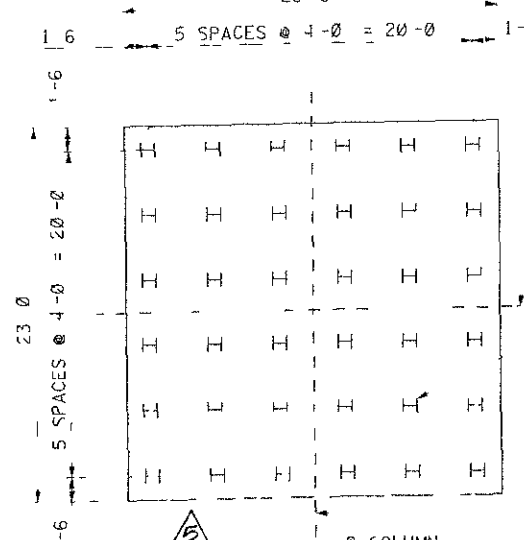

BENTS 2, 3 & 4 PILE LAYOUT

HP 14 (89 DRIVEN) PILE FOR ANCHOR DETAILS SEE INDEX TO PLANS SHEET TYP

BR #55C 0628

* SEE BENT 2 FOOTING REINFORCEMENT & PILE LAYOUT ON BENT DETAILS NO 4 SHEET


HNTB

36 EXECUTIVE PARK
SUITE 200
IRVINE, CALIFORNIA 92614

ORANGE COUNTY ENVIRONMENTAL MANAGEMENT AGENCY	
ANTONIO PARKWAY BRIDGE OVER SAN JUAN CREEK	
BENT DETAILS NO 1	
JUL-3 (16158) sheet 60 OF 126	
DATE 11/24/97	DATE 11/24/97
DESIGNED Steve A. Whitaker	CHECKED R. Hart
DRAWN J. W. F.	DATE 11/24/97
AS SHOWN	DRAWING NO. 60
	OF 126


DR-3 (16158)

56

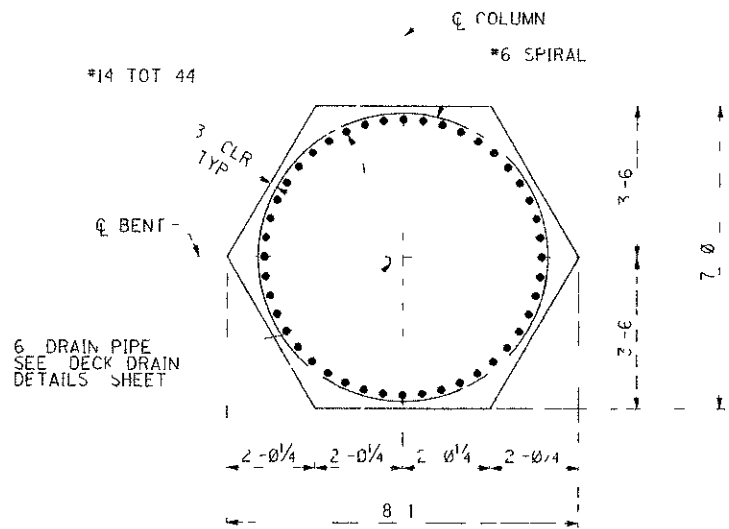


SECTION A-A

1/2 = 1-0

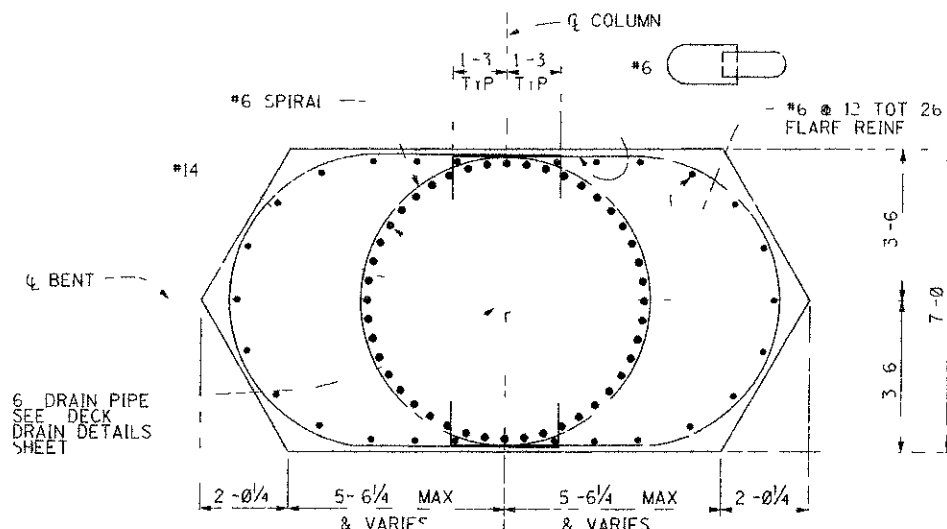


SECTION B-B

1/2 = 1-0

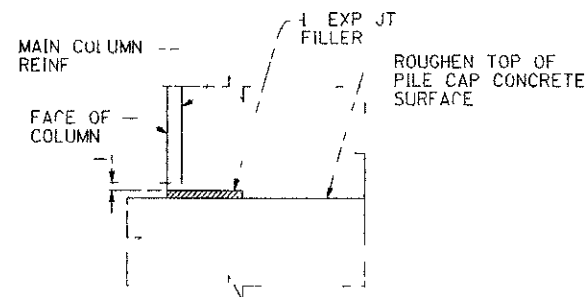


BENT 5 PARTIAL ELEVATION

NO SCALE

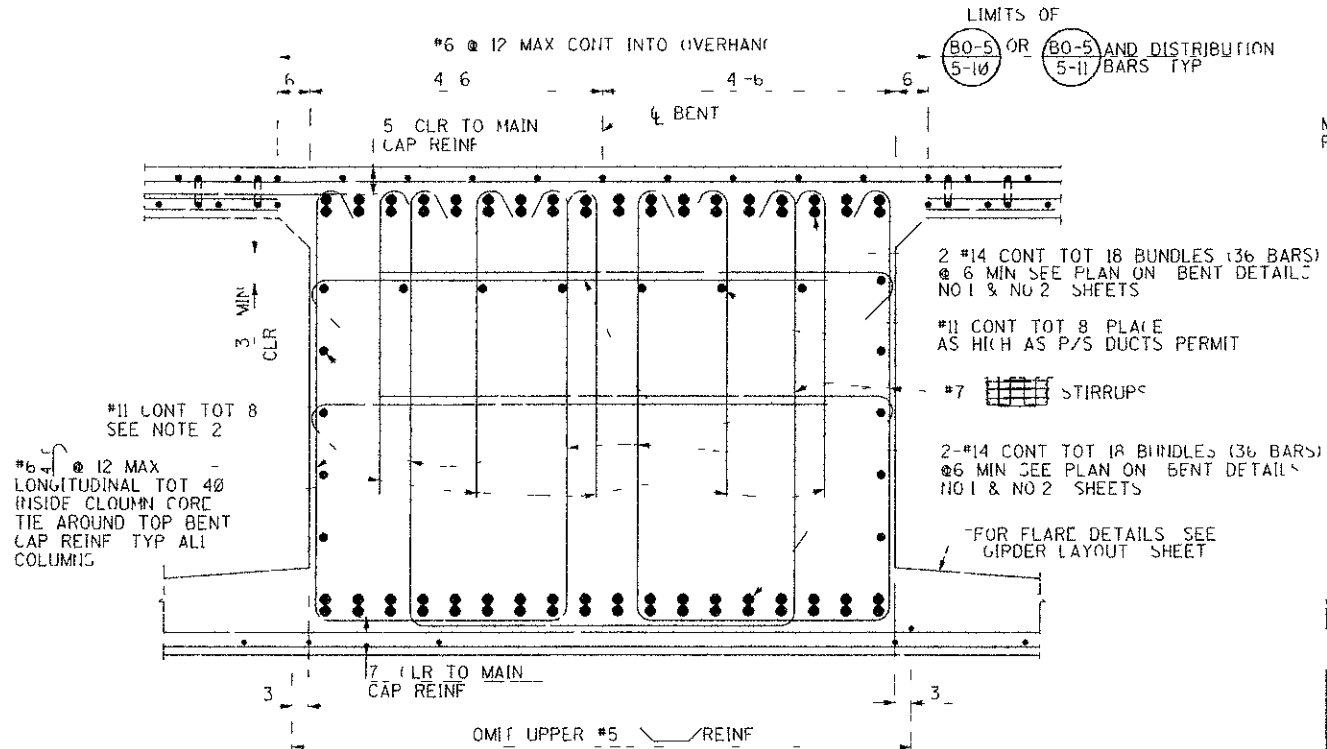

SECTION C-C


3/4 = 1-0

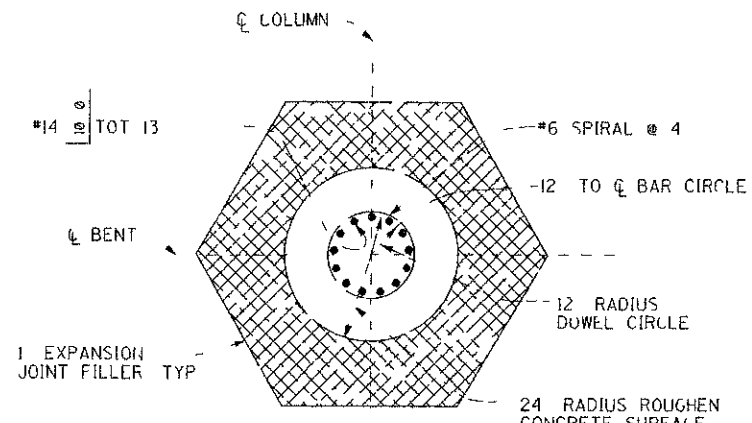

PLAN


BENT 5 COLUMN BOTTOM DETAILS

NO SCALE

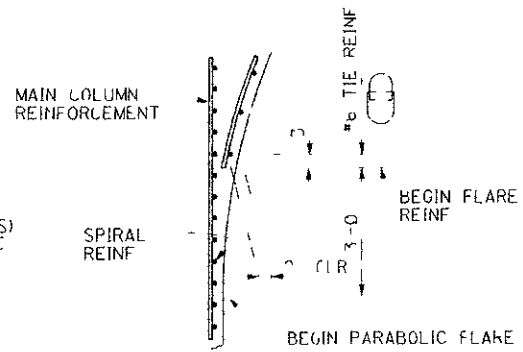

DETAIL A

NO SCALE

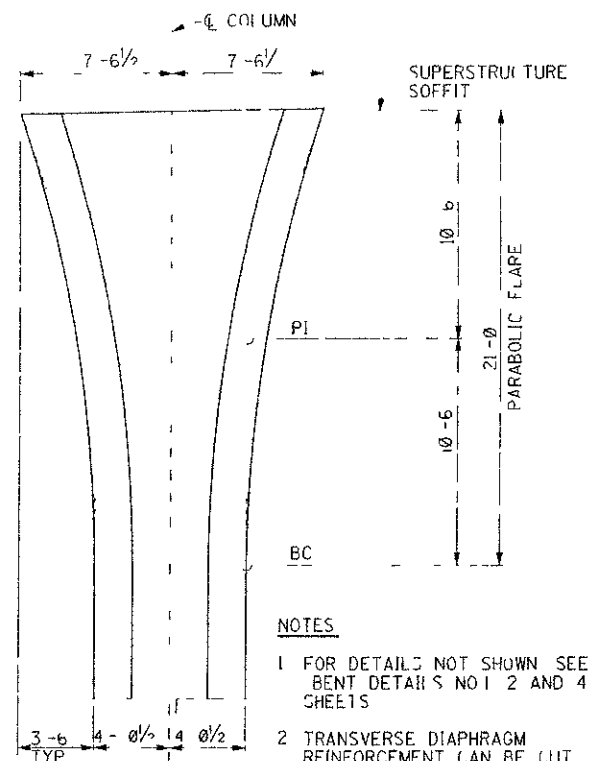

COLUMN GEOMETRICS

NO SCALE

DR 3 (16158)
Sheet 6 of 16


- NOTES**
- 1 FOR DETAILS NOT SHOWN SEE BENT DETAILS NO. 1, 2 AND 4 SHEETS
 - 2 TRANSVERSE DIAPHRAGM REINFORCEMENT CAN BE CUT AT UTILITY OPENING LOCATIONS

BR #55C 06 28

PREPARED BY
HNTB
36 EXECUTIVE PARK
SUITE 300
IRVINE CALIFORNIA 92614


ORANGE COUNTY ENVIRONMENTAL MANAGEMENT AGENCY		ANTONIO PARKWAY BRIDGE OVER SAN JUAN CREEK	
BENT DETAILS NO. 3			
14/27			
DESIGNED: Steve A. Whitaker		SHEET	
DRAWN: L. West		CHECKED: R. Hart	
SCALE		DATE	
AS SHOWN		DRAWING NO.	
DATE		SHEET	
DATE		OF 126	

DR 3 (16158)

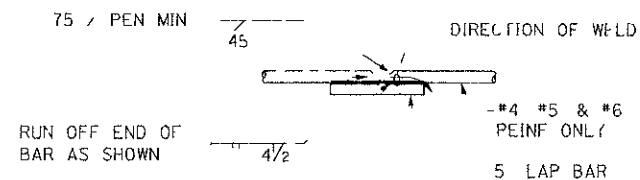

- 1 BUTT WELD TO BE MADE FIRST
- 2 BUTT WELD TO BE MADE IN FLAT OR HORIZ POSITION
- 3 LAP BAR TO BE CENTERED ON SPLICE
- 4 FLARE WELD TO BE MADE IN DIRECTION SHOWN
- 5 LAP BAR EQUAL SIZE TO SPIRAL BAR


VEE GROOVE WELDED SPLICE

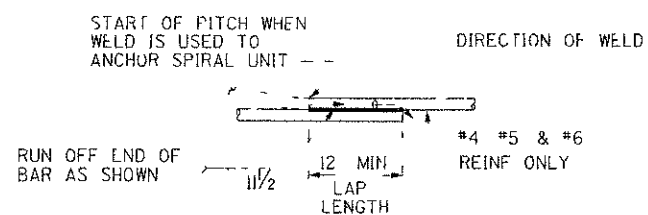

NOTE
FLARE WELD TO BE MADE IN DIRECTION SHOWN

WELDED LAP SPLICE AND ANCHOR

SAME SIZE SPACING AND MATERIAL AS SPIRAL SHOWN ON PLANS

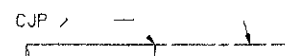


INDIVIDUAL HOOPS MADE CONTINUOUS WITH 100% PENETRATION WELDS MAY BE SUBSTITUTED FOR SPIRALS


BUTT WELDED CONTINUOUS HOOP

BAR SPIRAL SPLICE & SPIRAL ANCHOR AND HOOP DETAIL


NO SCALE

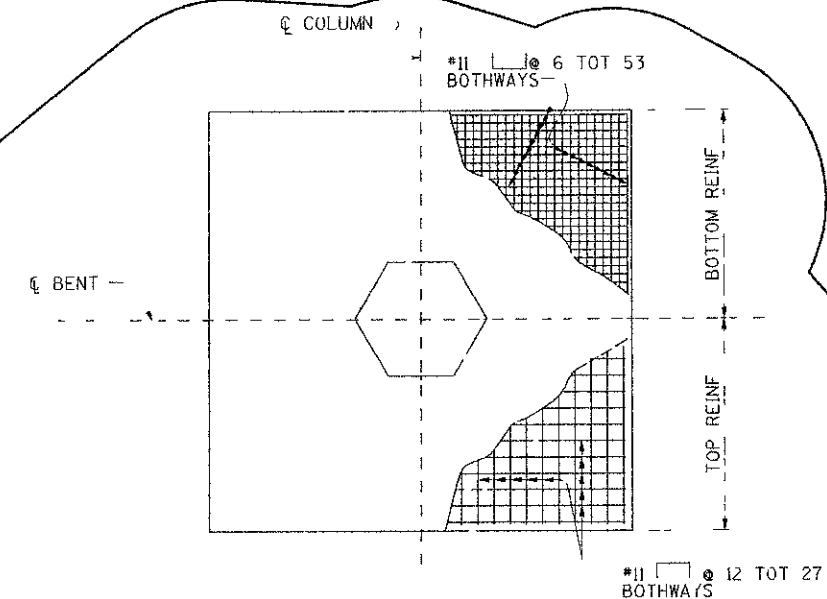

BENTS 2 FOOTING REINFORCEMENT

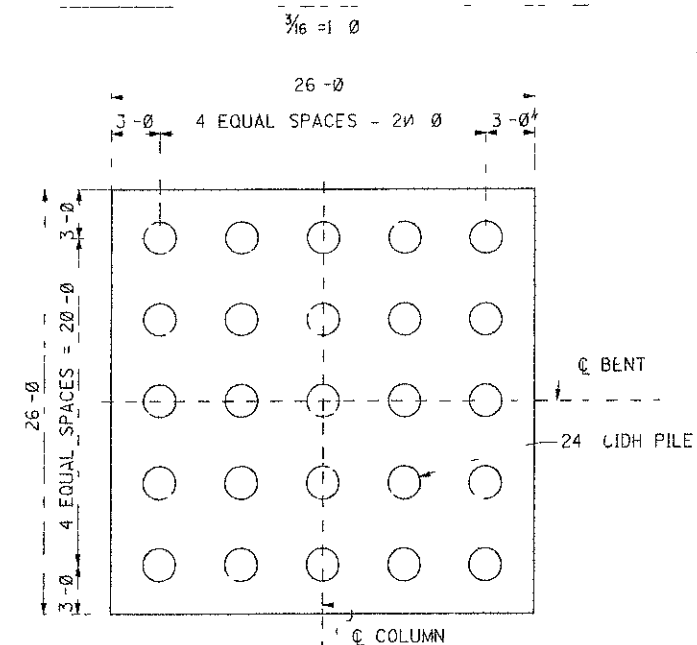

BENTS 2 PILE LAYOUT

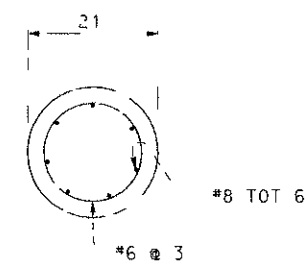

24" CIDH PILE SECTION


NTS
PILE LENGTH = 29 0'





BR # 55C 0628

HNTB
36 EXPLUTIVE PARK
SUITE 200
IRVINE CALIFORNIA 92614

ORANGE COUNTY ENVIRONMENTAL MANAGEMENT AGENCY	
ANTONIO PARKWAY BRIDGE OVER SAN JUAN CREEK	
BENT DETAILS NO 4	
DR - (10158) Sheet 63 of 126	
DESIGNED: Steve A. Whitaker	SHEET
DRAWN: L. West	63
CHECKED: R. Hart	OF 126
DATE: 10/24/97	
SCALE: AS SHOWN	

DR-3 (10158)

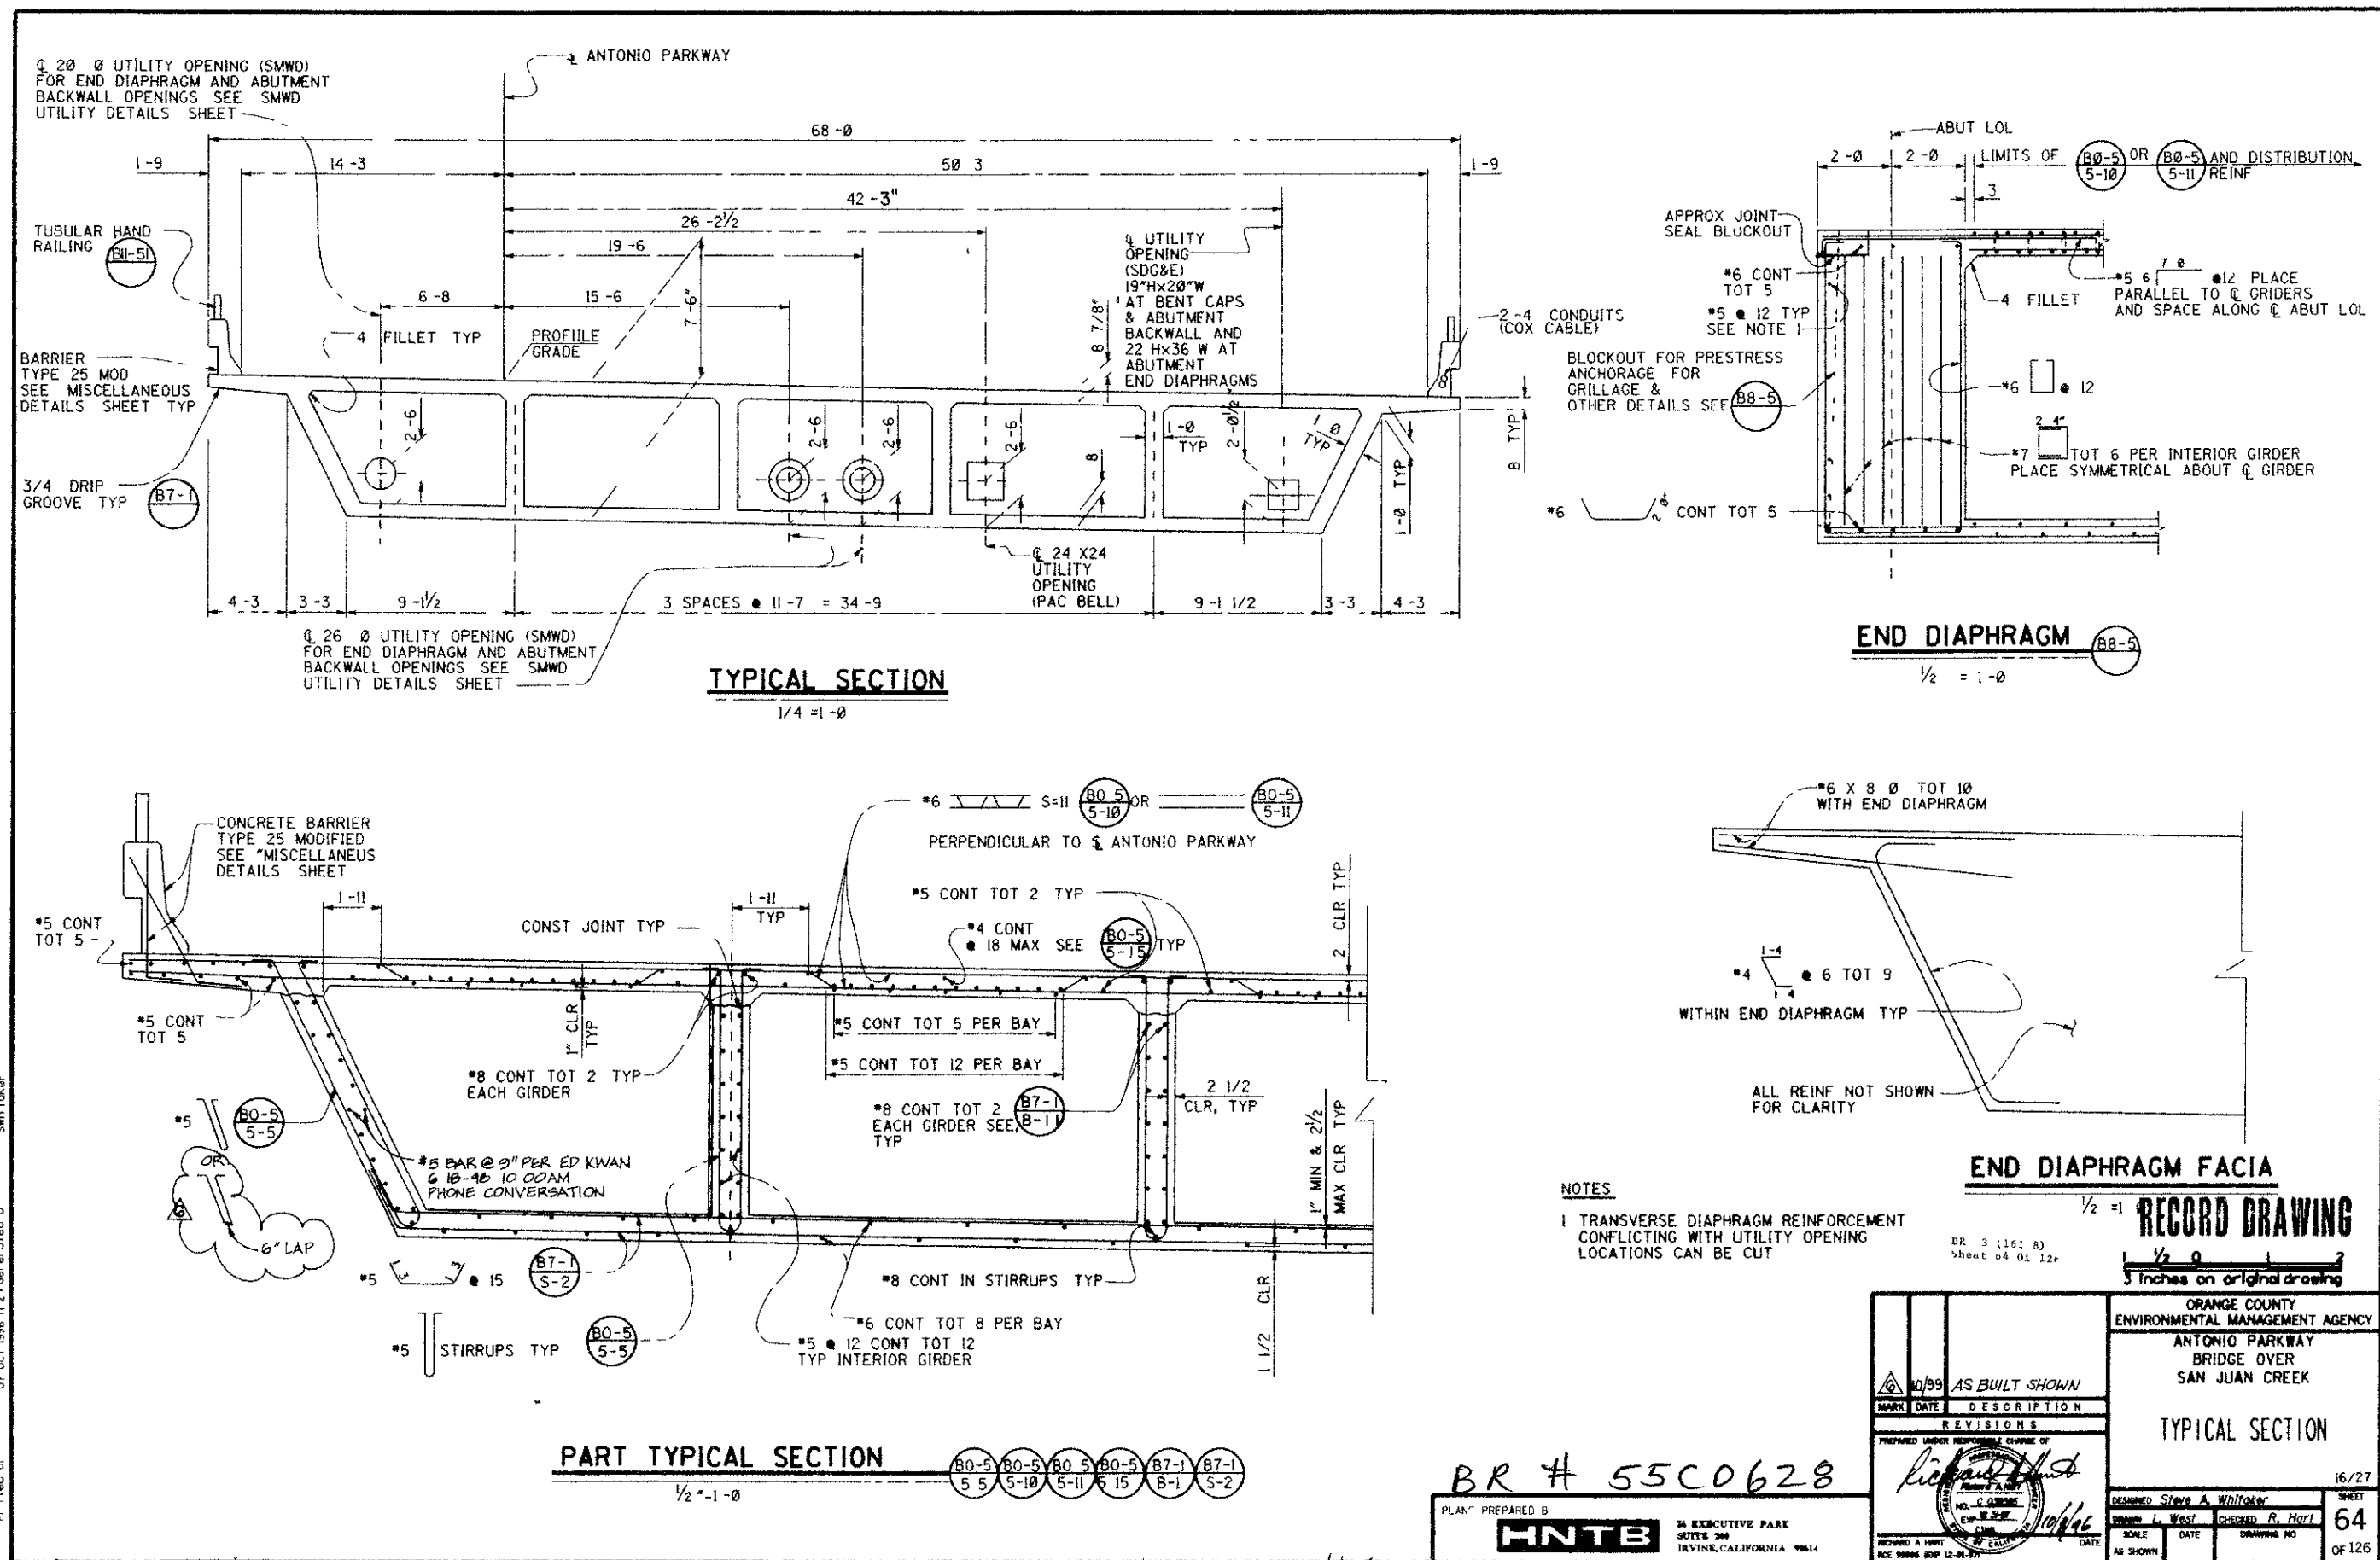

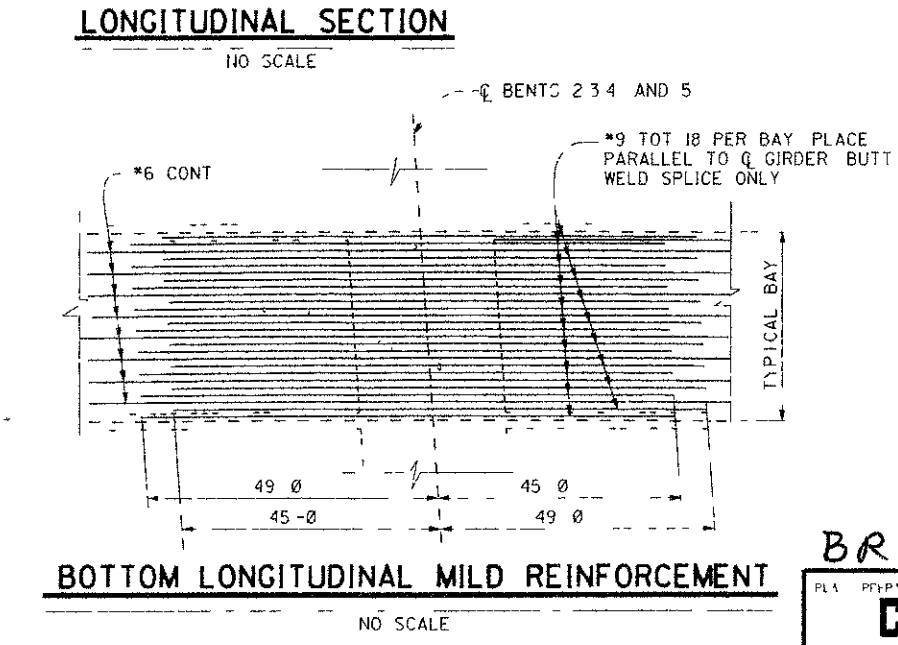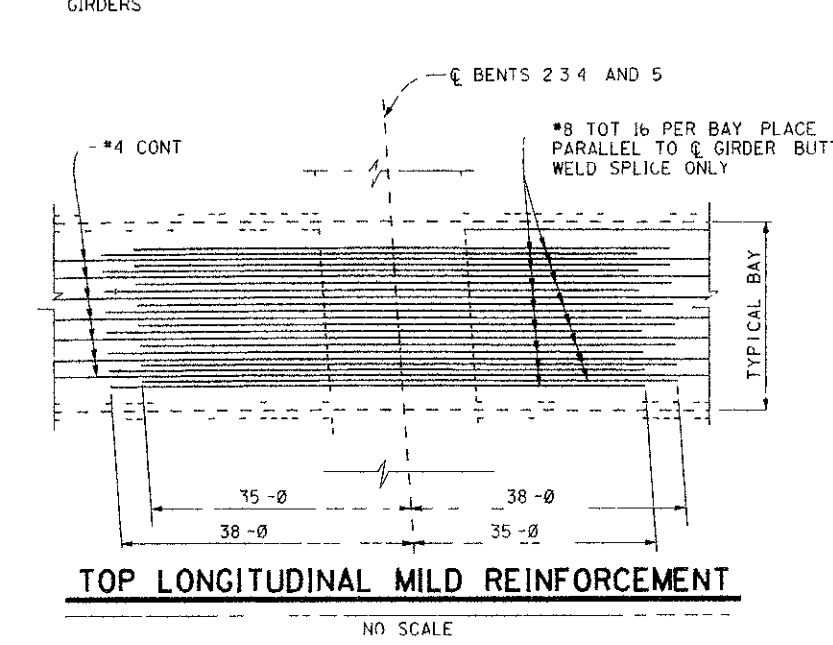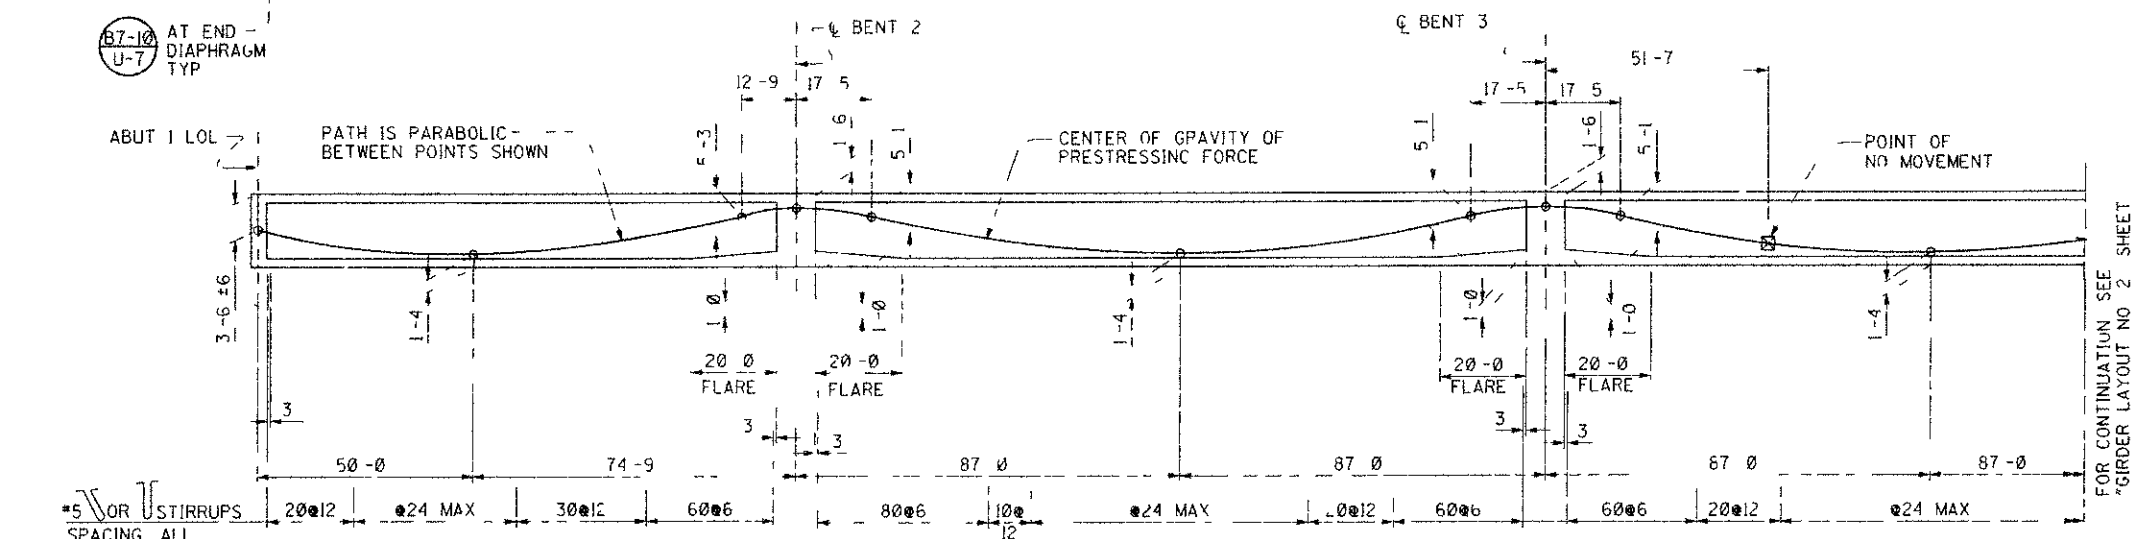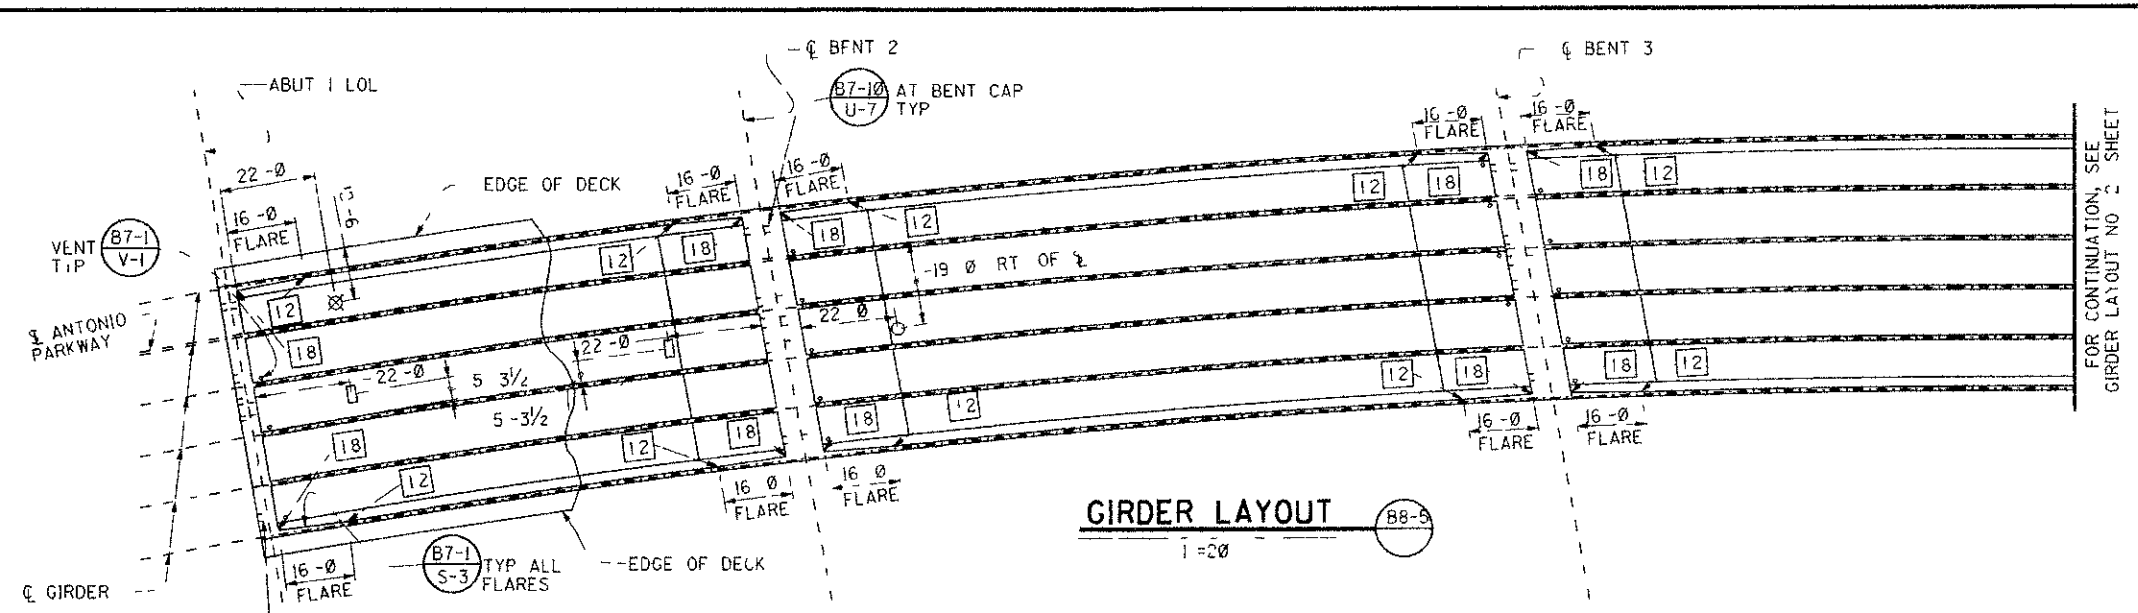

PRESTRESSING NOTES

270 ksi LOW RELAXATION STRAND
 Pack = 12 600 kips
 ANCHOR SET = 3/8 IN
 TOTAL NUMBER OF GIRDERS 6

DISTRIBUTION OF FINAL PRESTRESS FORCE (Pack) BETWEEN GIRDERS SHALL NOT EXCEED THE RATIO OF 3:1
 MAXIMUM FINAL FORCE VARIATION BETWEEN GIRDERS SHALL NOT EXCEED 725 kips

CONCRETE $f_c = 4000$ psi AT 28 DAYS
 $f_{ci} = 3500$ psi AT TIME OF STRESSING

CONTRACTOR SHALL SUBMIT ELONGATION CALCULATIONS BASED ON INITIAL STRESS AT $\sigma = 0.829$ TIMES JACKING STRESS

BOTH END STRESSING SHALL BE PERFORMED

FOR PRESTRESSING DETAILS NOT SHOWN SEE (B8-5)

- LEGEND**
- INDICATES GIRDER FLARE WIDTH IN INCHES SEE (B7-1 S-3)
 - SOFFIT ACCESS OPENING SEE MISCELLANEOUS DETAILS SHEET
 - MANHOLE DECK OPENING (B7-11)
COVER SHALL BE STAMPED SMWD WATER PER SMWD STANDARD DRAWING S 1
 - ⊗ SOFFIT ACCESS OPENING (CIRCULAR) (B14-5)

DR 3 (16158)
 Sheet 5 of 12

3 inches on original drawing

ORANGE COUNTY
 ENVIRONMENTAL MANAGEMENT AGENCY
 ANTONIO PARKWAY
 BRIDGE OVER
 SAN JUAN CREEK

GIRDER LAYOUT NO. 1


MARK	DATE	DESCRIPTION
REVISIONS		
PREPARED UNDER RESPONSIBLE CHARGE OF		
 Richard A. Hart NO. 5-029595 EXP. 12-31-97 CIVIL		
DESIGNED	Steve A. Whitaker	17 27
DRAWN	L. West	CHECKED R. Hart
SCALE	DATE	DRAWING NO.
AS SHOWN		65
		OF 126

BR # 55C0628

PL1 PREPARED BY
HNTB
 36 EXECUTIVE PARK
 SUITE 200
 IRVINE CALIFORNIA 92614

DATE 10/4/96

DR 3 (16158)

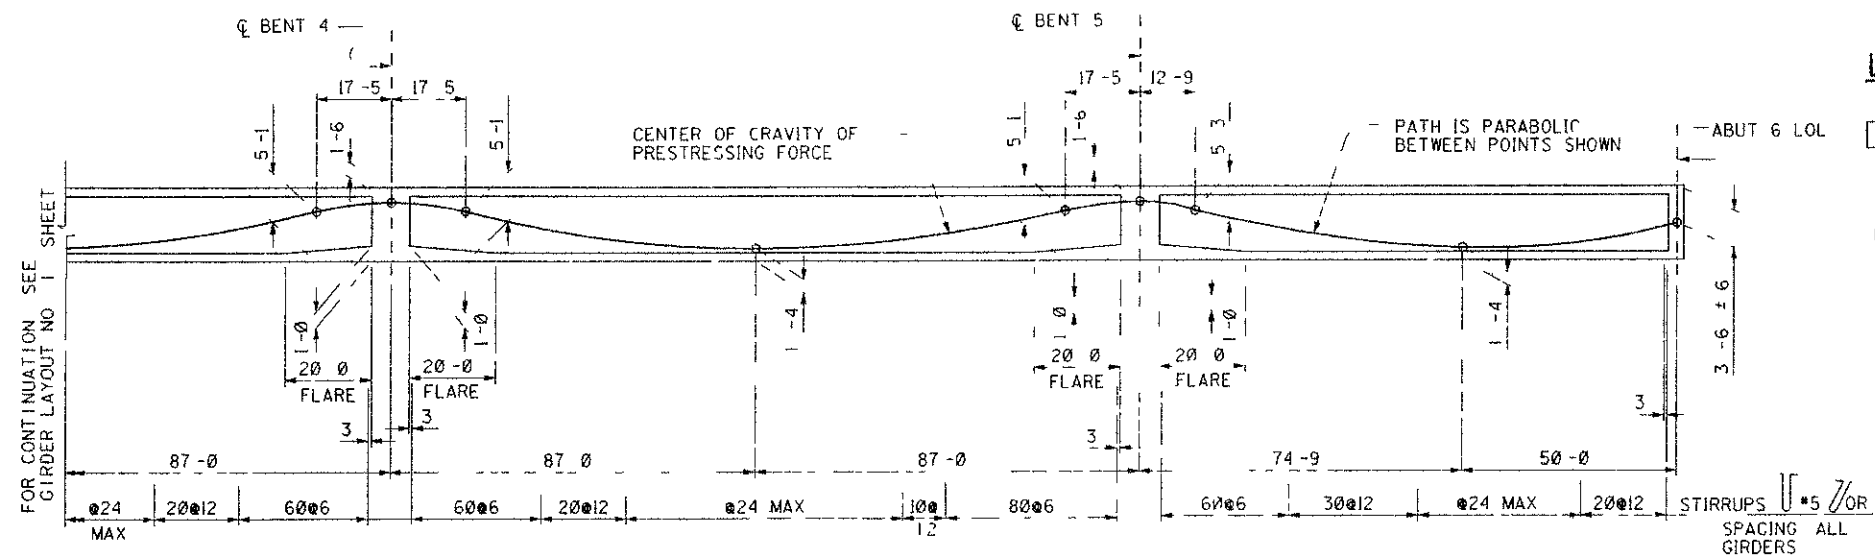

NO SCALE

 = INDICATES GIRDER FLARE WIDTH IN INCHES 


 = SOFFIT ACCESS OPENING SEE MISCELLANEOUS DETAILS SHEET

 = MANHOLE DECK OPENING 
 COVER SHALL BE
 STAMPED SMWD WATER
 PER SMWD STANDARD DRAWING S-1

 = SOFFIT ACCESS OPENING (CIRCULAR) 

DR 8 (1615P)
Sheet 6 of 12p

3 inches on original drawing

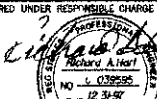ORANGE COUNTY ENVIRONMENTAL MANAGEMENT AGENCY ANTONIO PARKWAY BRIDGE OVER SAN JUAN CREEK		
MARK	DATE	DESCRIPTION
REVISIONS		
PREPARED UNDER RESPONSIBLE CHARGE OF		
		
RICHARD A. HART P.E. 3859* EXP. 12-31-97		DATE
GIRDER LAYOUT NO. 2		
18/27		
DESIGNED <u>Steve A. Whitaker</u>		SHEET
DRAWN <u>L. West</u>	CHECKED <u>R. Hart</u>	66
SCALE	DATE	OF 126
AS SHOWN	DRAWING NO.	

BR # 55C0628


PLAN PREPARED BY

HNTB

36 EXECUTIVE PARK
SUITE 200
IRVINE, CALIFORNIA 92614

DR 3 (16158)

0 30 ft range
PI 103.0
11.17.536.545. entered 2.5
SPH 10/1/07

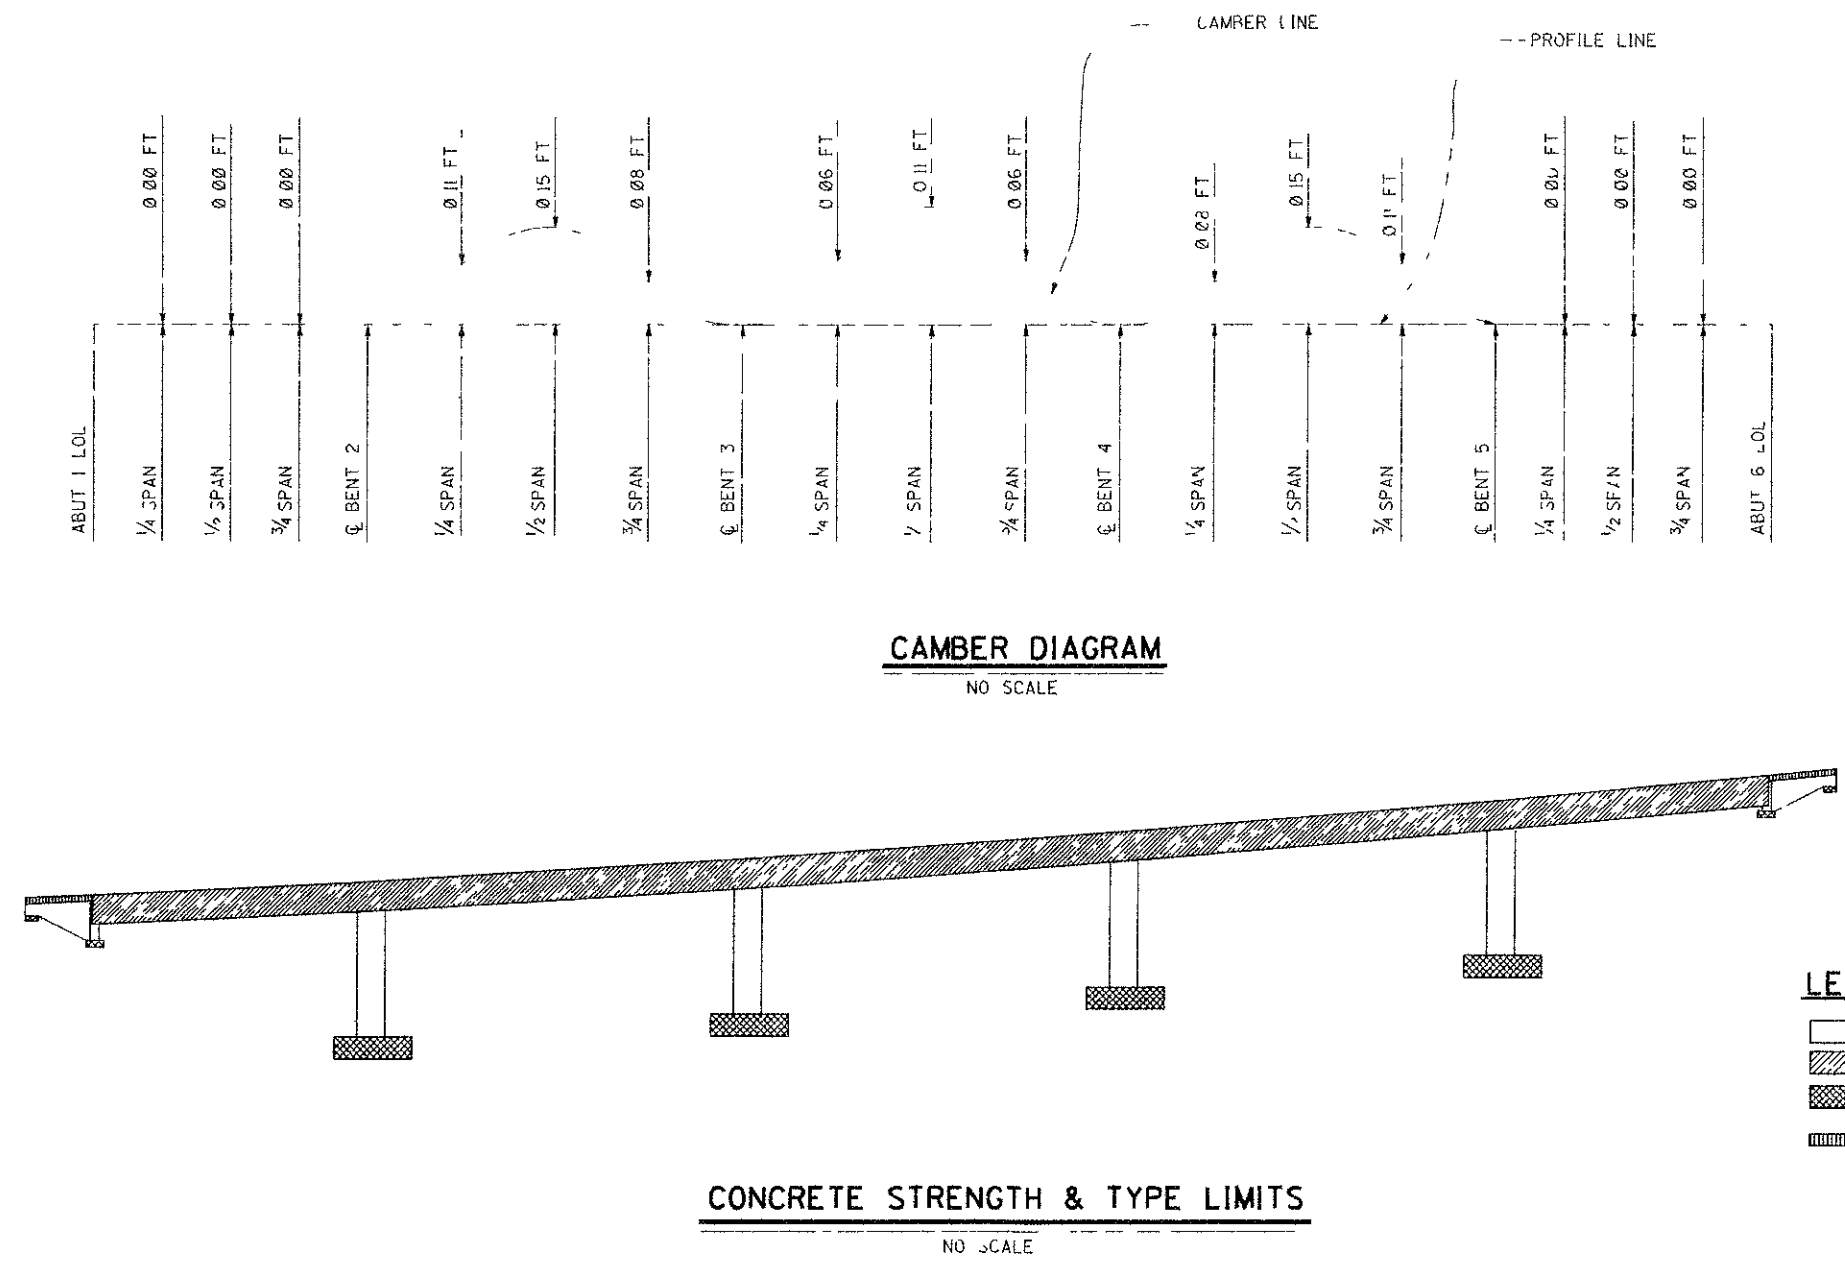

NOTE
CAMBER LINE DOES NOT INCLUDE
ALLOWANCE FOR FALSEWORK SETTLEMENT

DR 3 (1+18)
Sheet 7 of 126


1/2 0 1 2
3 inches on original drawing


BR #55C0628



PREPARED BY
HNTB
36 EXECUTIVE PARK
SUITE 200
IRVINE CALIFORNIA 92614

ORANGE COUNTY ENVIRONMENTAL MANAGEMENT AGENCY ANTONIO PARKWAY BRIDGE OVER SAN JUAN CREEK CAMBER DIAGRAM & CONC STRENGTH & TYPE LIMITS		19/27 SHEET 67 OF 126
DESIGNED Steve A. Whitaker		
DRAWN L. West		
CHECKED R. Hart		
DATE 4/29/06		
SCALE AS SHOWN		
DRAWING NO.		




DR 3 (14158)

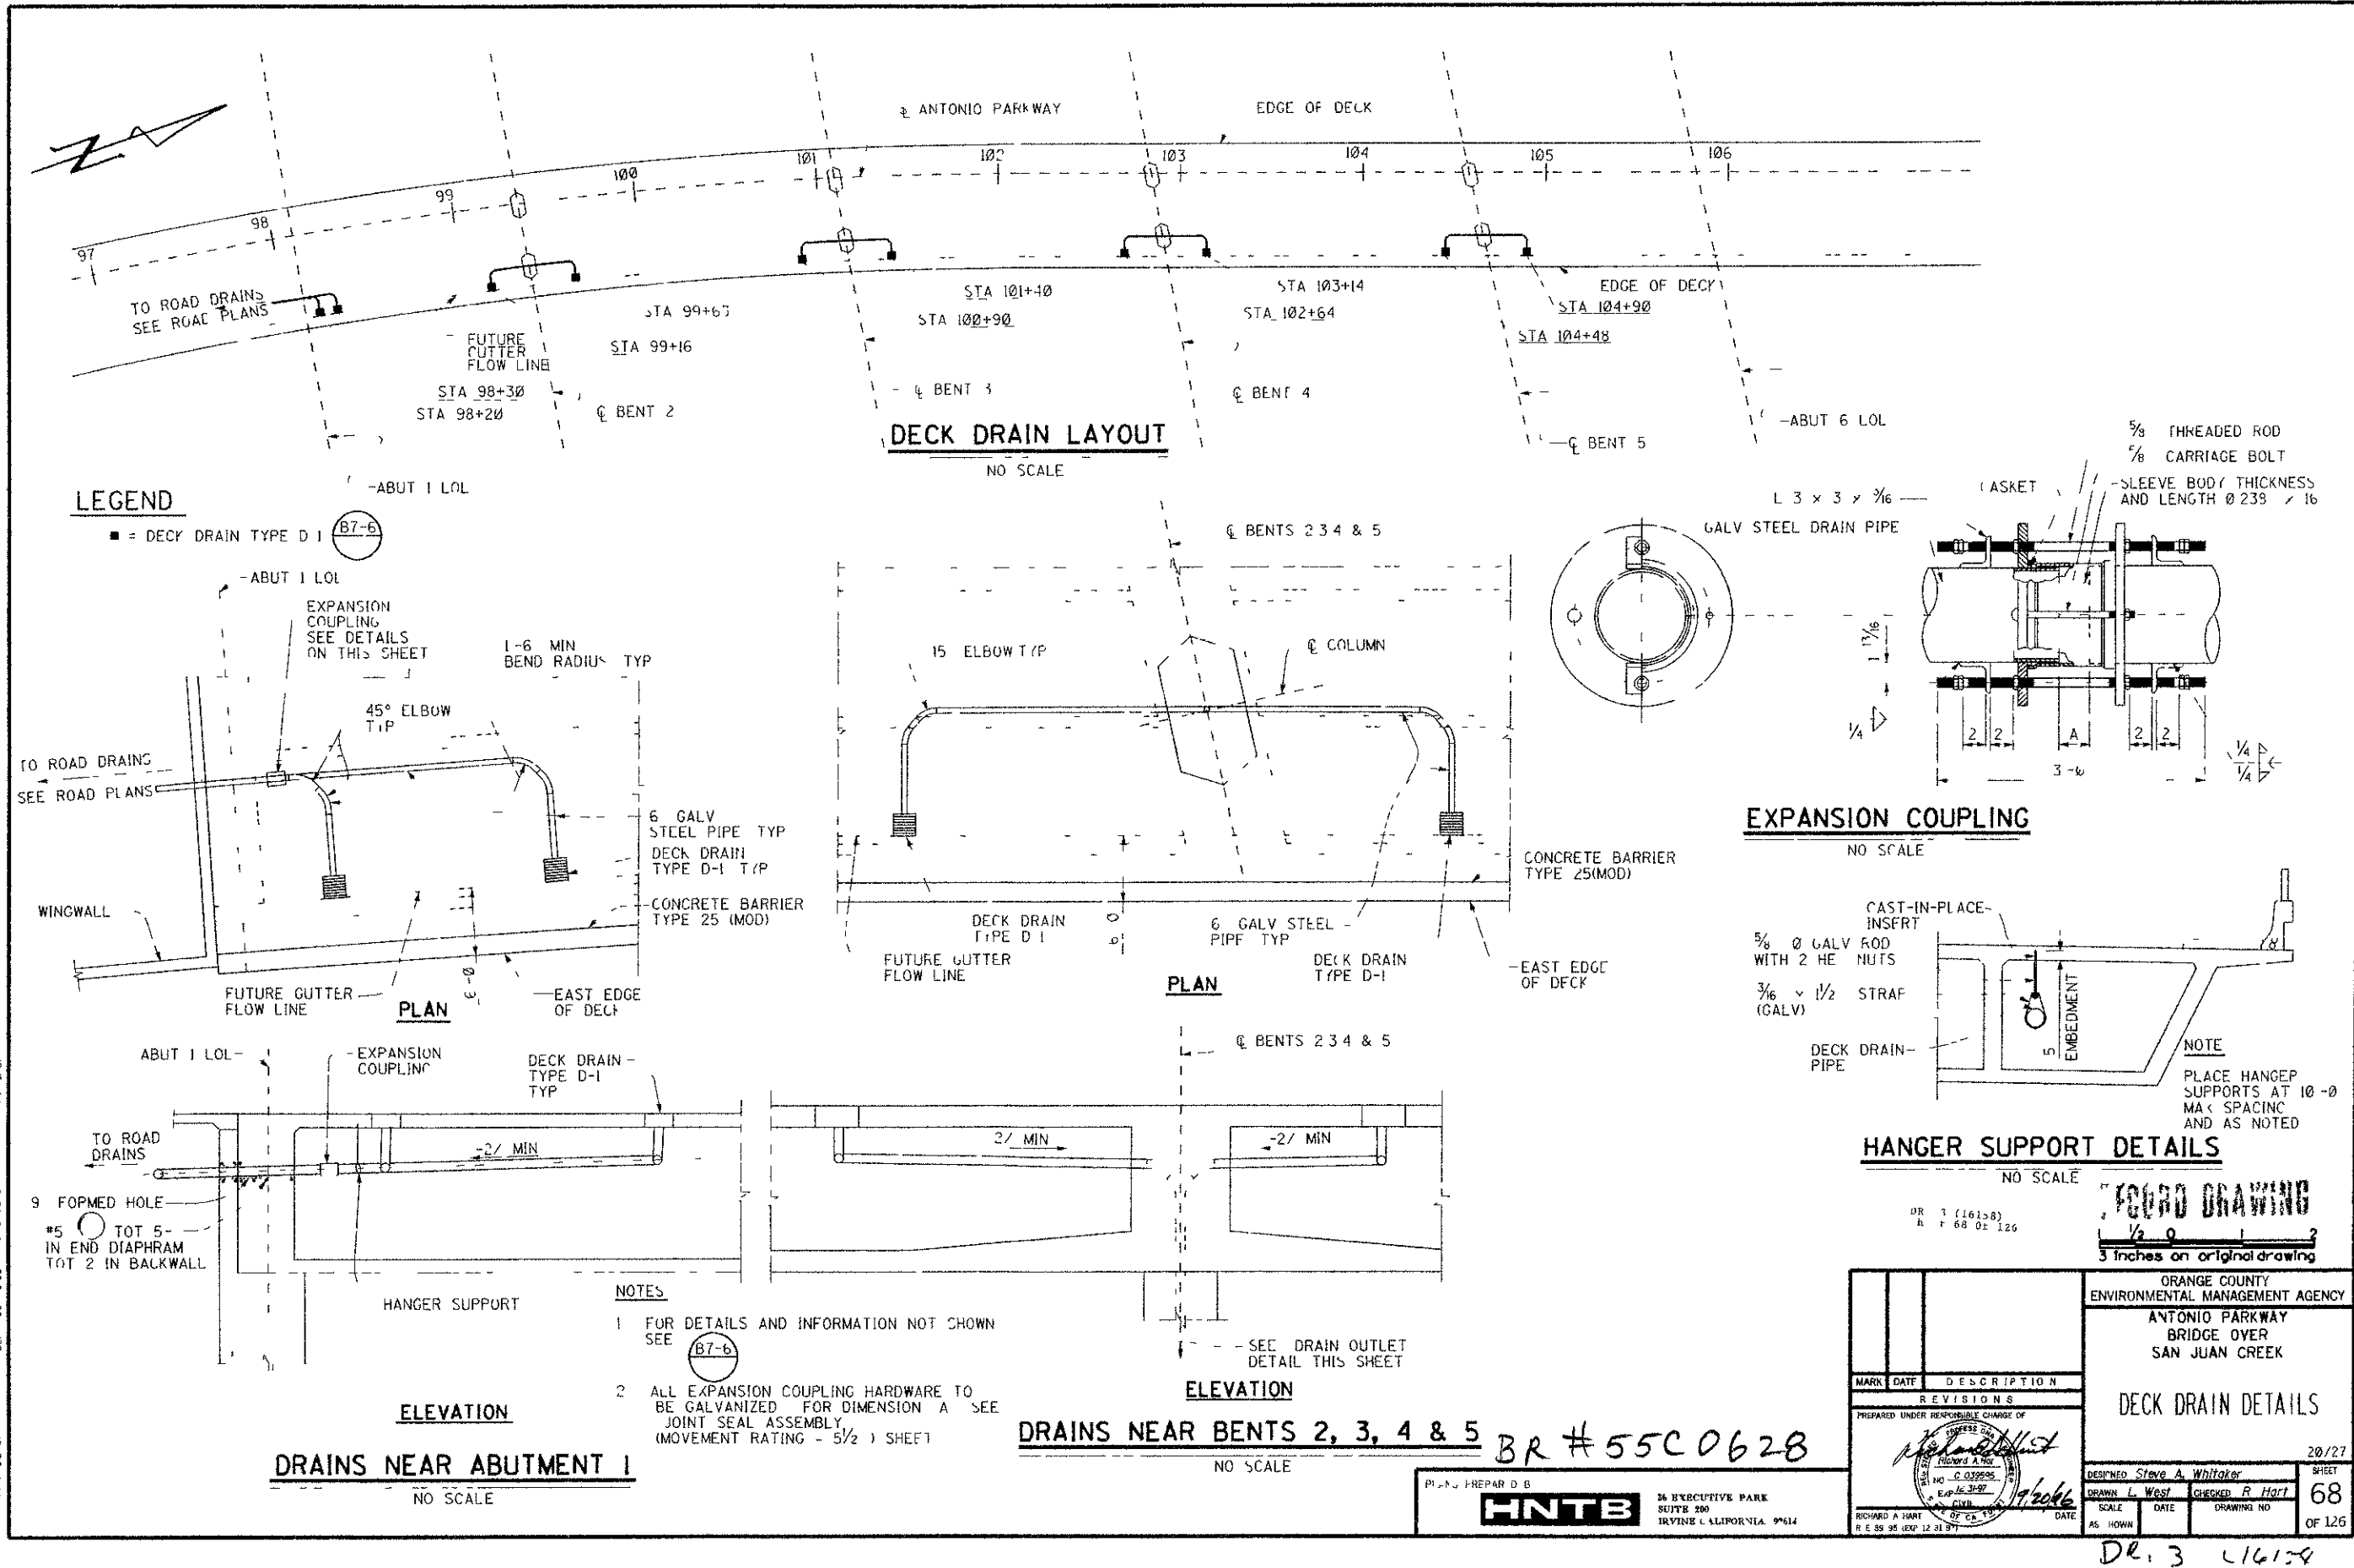


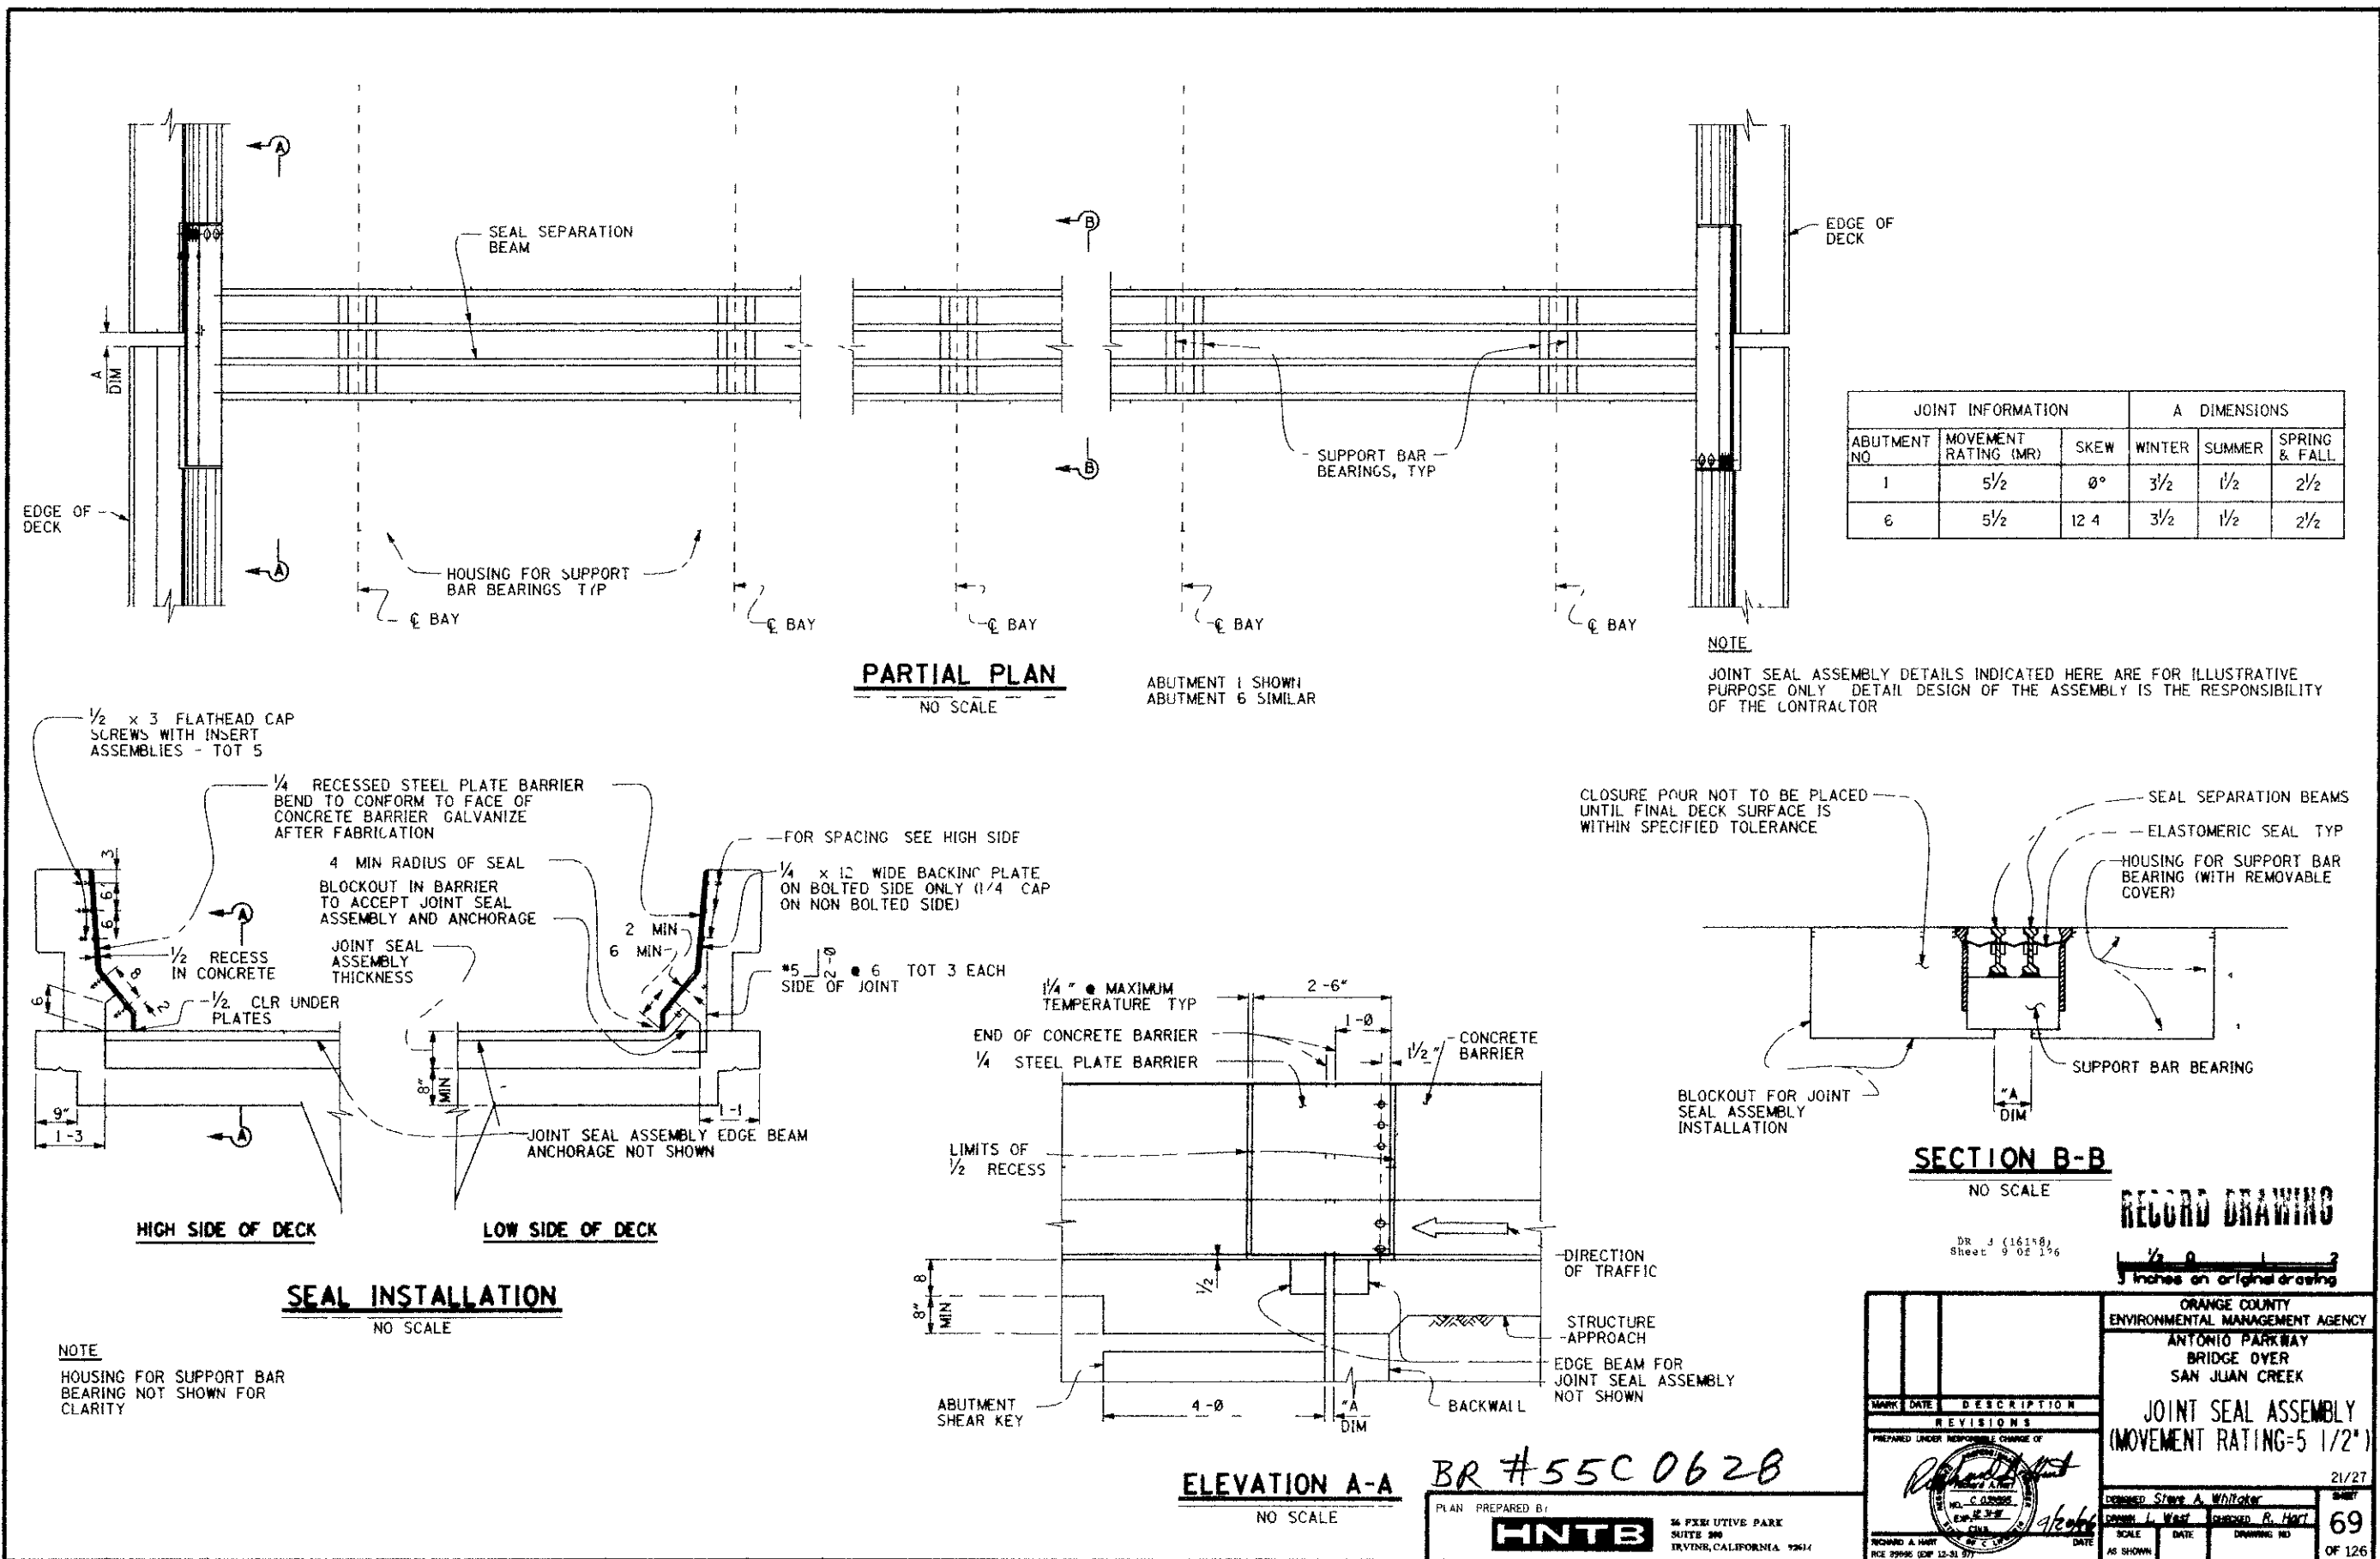


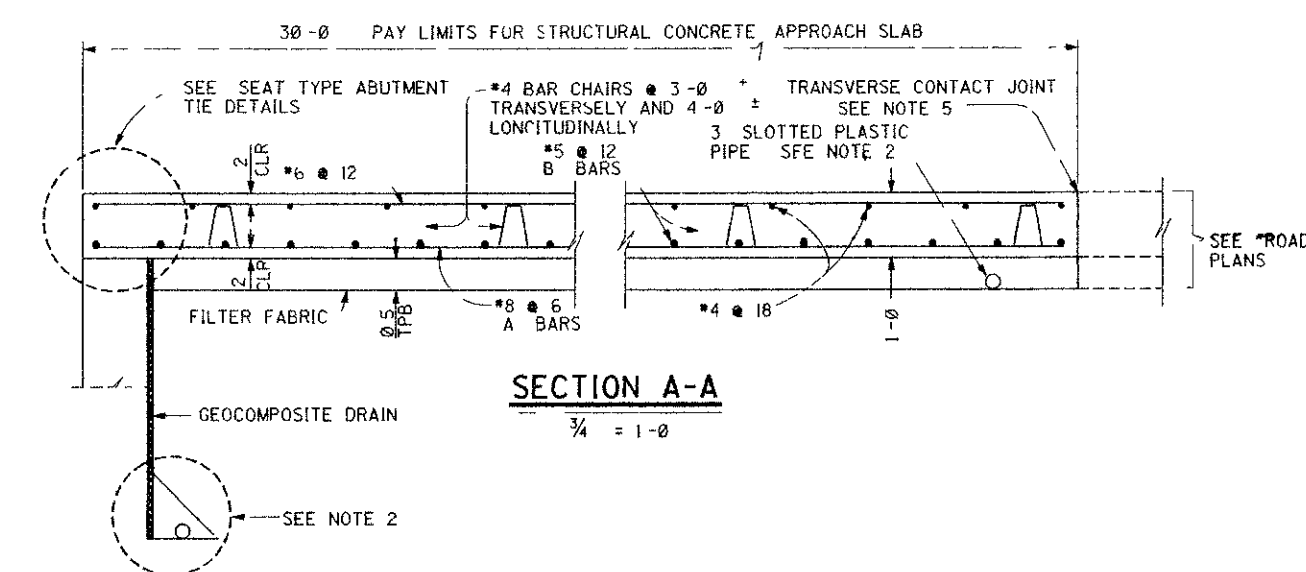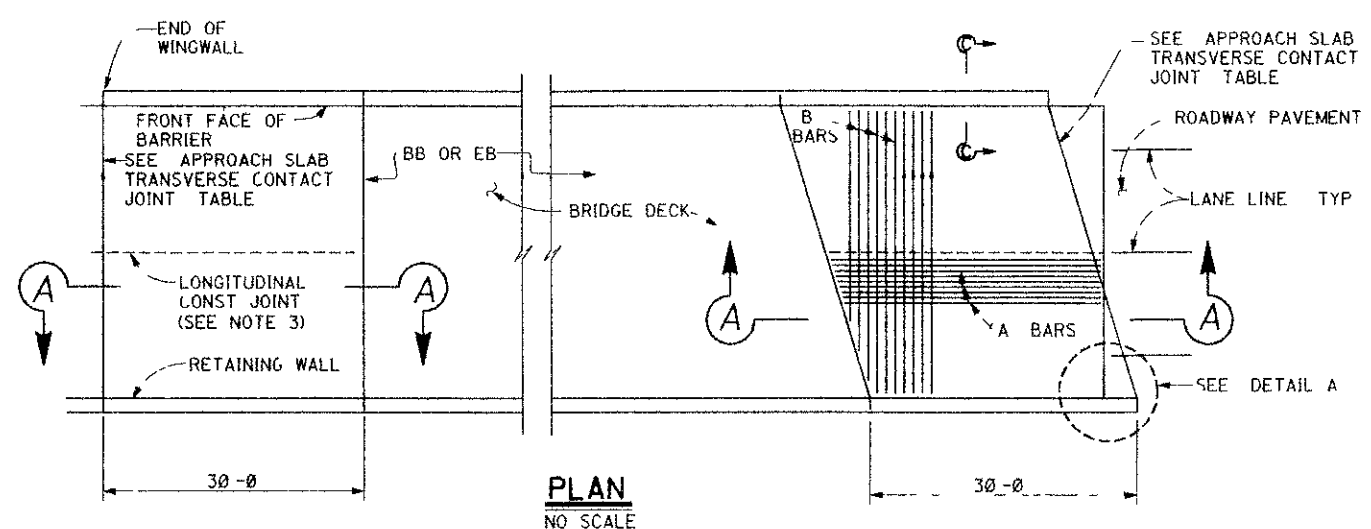

APPROACH SLAB TRANSVERSE CONTACT JOINT		
APPROACH SKEW	WITH AC ROADWAY PAVEMENT	WITH PCC ROADWAY PAVEMENT
< 20°	PARALLEL TO FACE OF PAVING NOTCH	PARALLEL TO FACE OF PAVING NOTCH

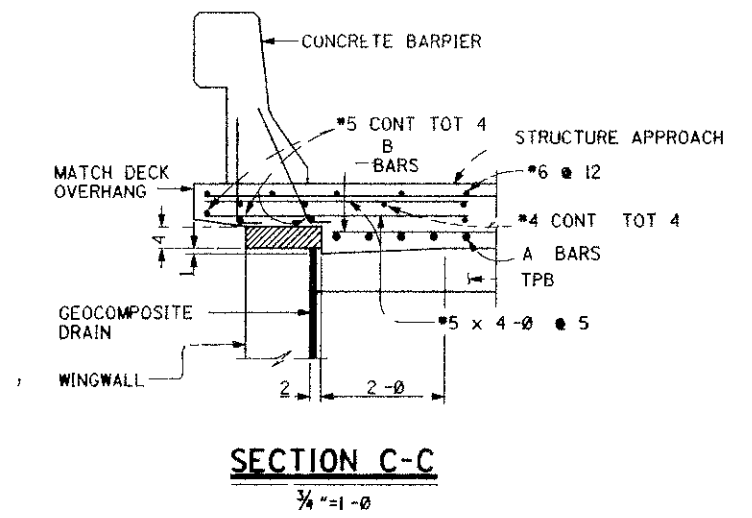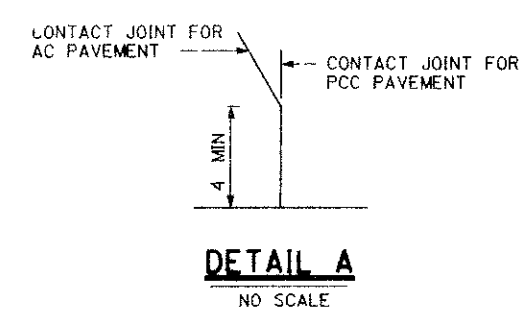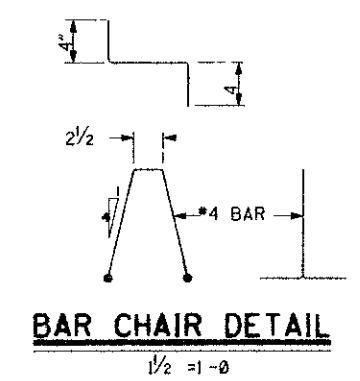

- NOTES**
- FOR DETAILS NOT SHOWN SEE STRUCTURE PLANS
 - FOR DRAINAGE DETAILS SEE STRUCTURE APPROACH DRAINAGE DETAILS SHEET
 - LONGITUDINAL CONSTRUCTION JOINTS WHEN PERMITTED BY THE ENGINEER SHALL BE LOCATED ON LANE LINES AND/OR AT EDGES OR UTILITY VAULTS
 - END ANGLE AT BEGINNING OF BARRIER TRANSITION END OF WINGWALL OR END OF STRUCTURE APPROACH AS APPLICABLE
 - FOR TRANSVERSE CONTACT JOINT WITH NEW PCC PAVING REFER TO STANDARD PLAN A35-A
 - AT THE CONTRACTOR'S OPTION APPROACH SLAB TRANSVERSE REINFORCEMENT MAY BE PLACED PARALLEL TO PAVING NOTCH SPACING OF TRANSVERSE REINFORCEMENT IS MEASURED ALONG C ROADWAY

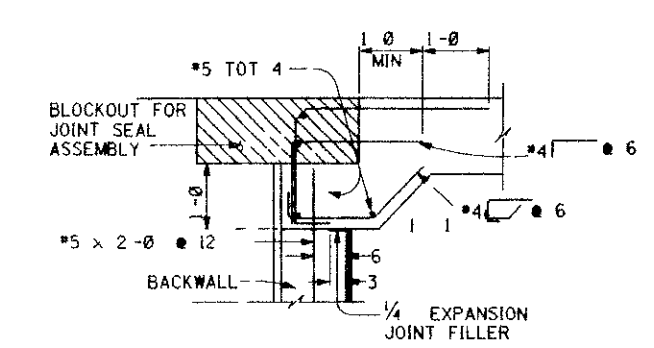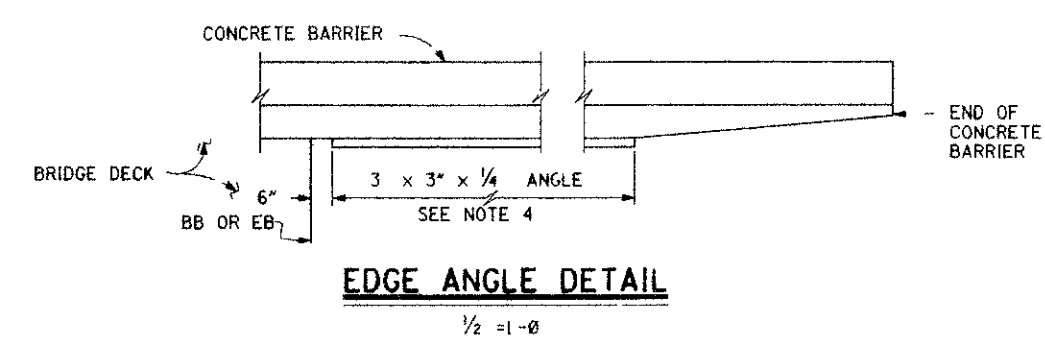

REMOVE ALL POLYSTYRENE

RECORD DRAWING

ORANGE COUNTY ENVIRONMENTAL MANAGEMENT AGENCY
ANTONIO PARKWAY BRIDGE OVER SAN JUAN CREEK
STRUCTURE APPROACH TYPE N(30S)

22/27

DESIGNED: Steve A. Whitaker
DRAWN: L. West
SCALE: AS SHOWN
DATE: 7/20/06
CHECKED: A. Hart
DATE: 7/20/06


BR # 55C0628

PLANS PREPARED BY: **HNTB**
36 EXETER PARK SUITE 200 IRVINE, CALIFORNIA 92614


OF 126

DR. 3 (16158)


Design File: p:\4897\road\as2 18.dgn
 0 SEP 1996 19:07 Generated by
 Printed on

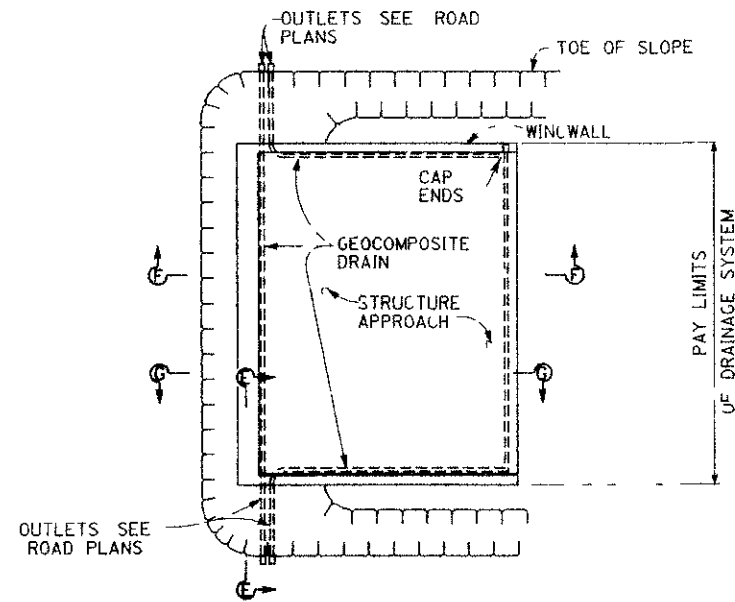


TYPICAL PLAN
NO SCALE

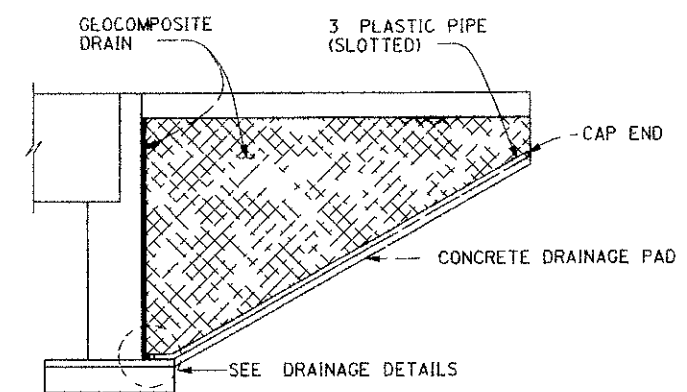


SECTION F-F
NO SCALE

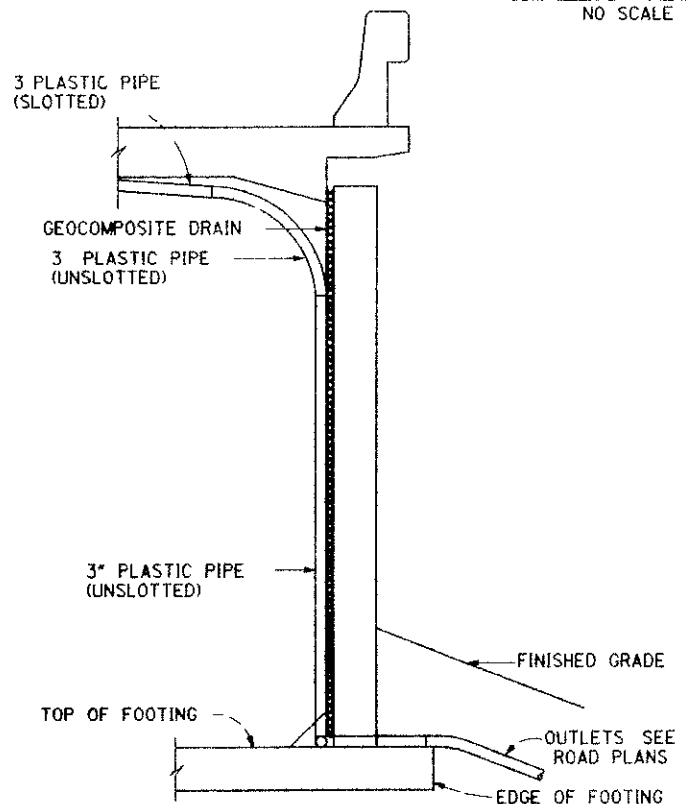

SECTION E-E
NO SCALE

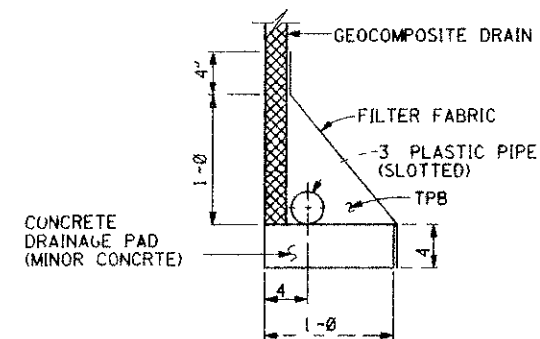

WITHOUT FOOTING

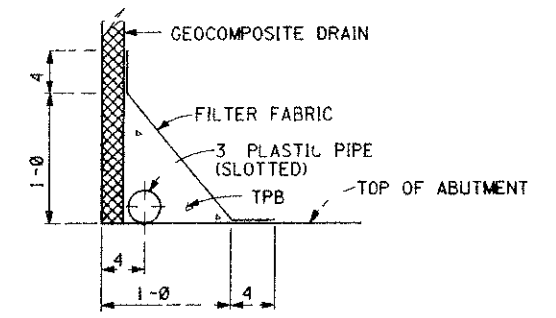

WITH FOOTING

DRAINAGE DETAILS
NO SCALE

NOTE
BENDS AND JUNCTIONS IN 3 PLASTIC PIPE ARE 30" RADIUS MIN

BR # 55C 0628

PLAN PREPARED BY
HNTB
IN EXECUTIVE PARK
SUITE 200
IRVINE, CALIFORNIA 92614

RECORD DRAWING

DR 3 (16158)
Sheet 71 of 126

3 inches on original drawing

ORANGE COUNTY
ENVIRONMENTAL MANAGEMENT AGENCY
ANTONIO PARKWAY
BRIDGE OVER
SAN JUAN CREEK

**STRUCTURE APPROACH
DRAINAGE DETAILS**




23/27

NO.	DATE	DESCRIPTION
1	4/20/66	AS SHOWN

DESIGNED: STEVE A. WHITAKER
CHECKED: R. HART
SCALE: AS SHOWN
DATE: 4/20/66
DRAWING NO: 71
OF 126

DR 3 (16158)

489 Nodd x 217 dsn
 20 JP 0996 05 08 unperfected by
 Design File name
 P12112 01

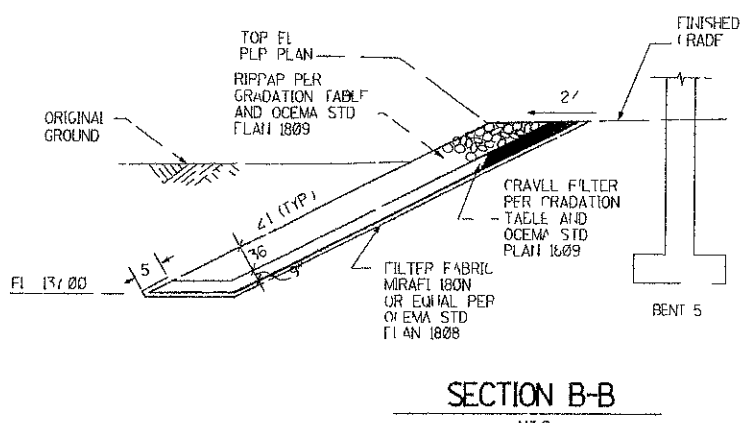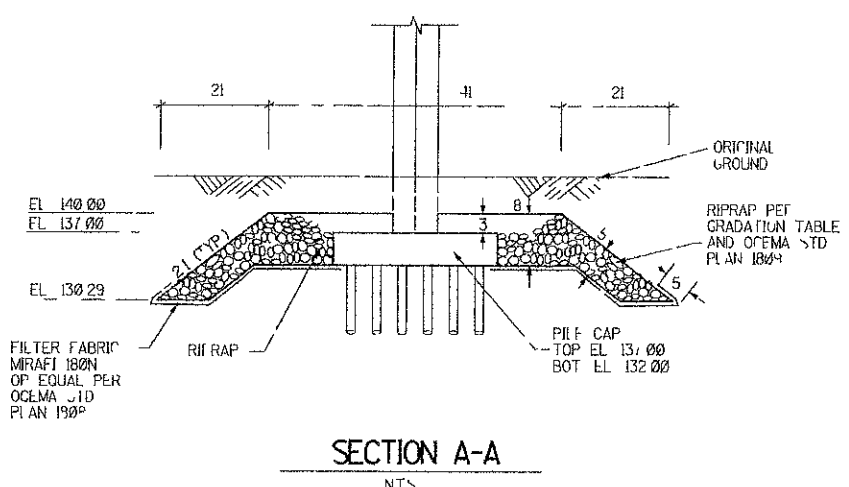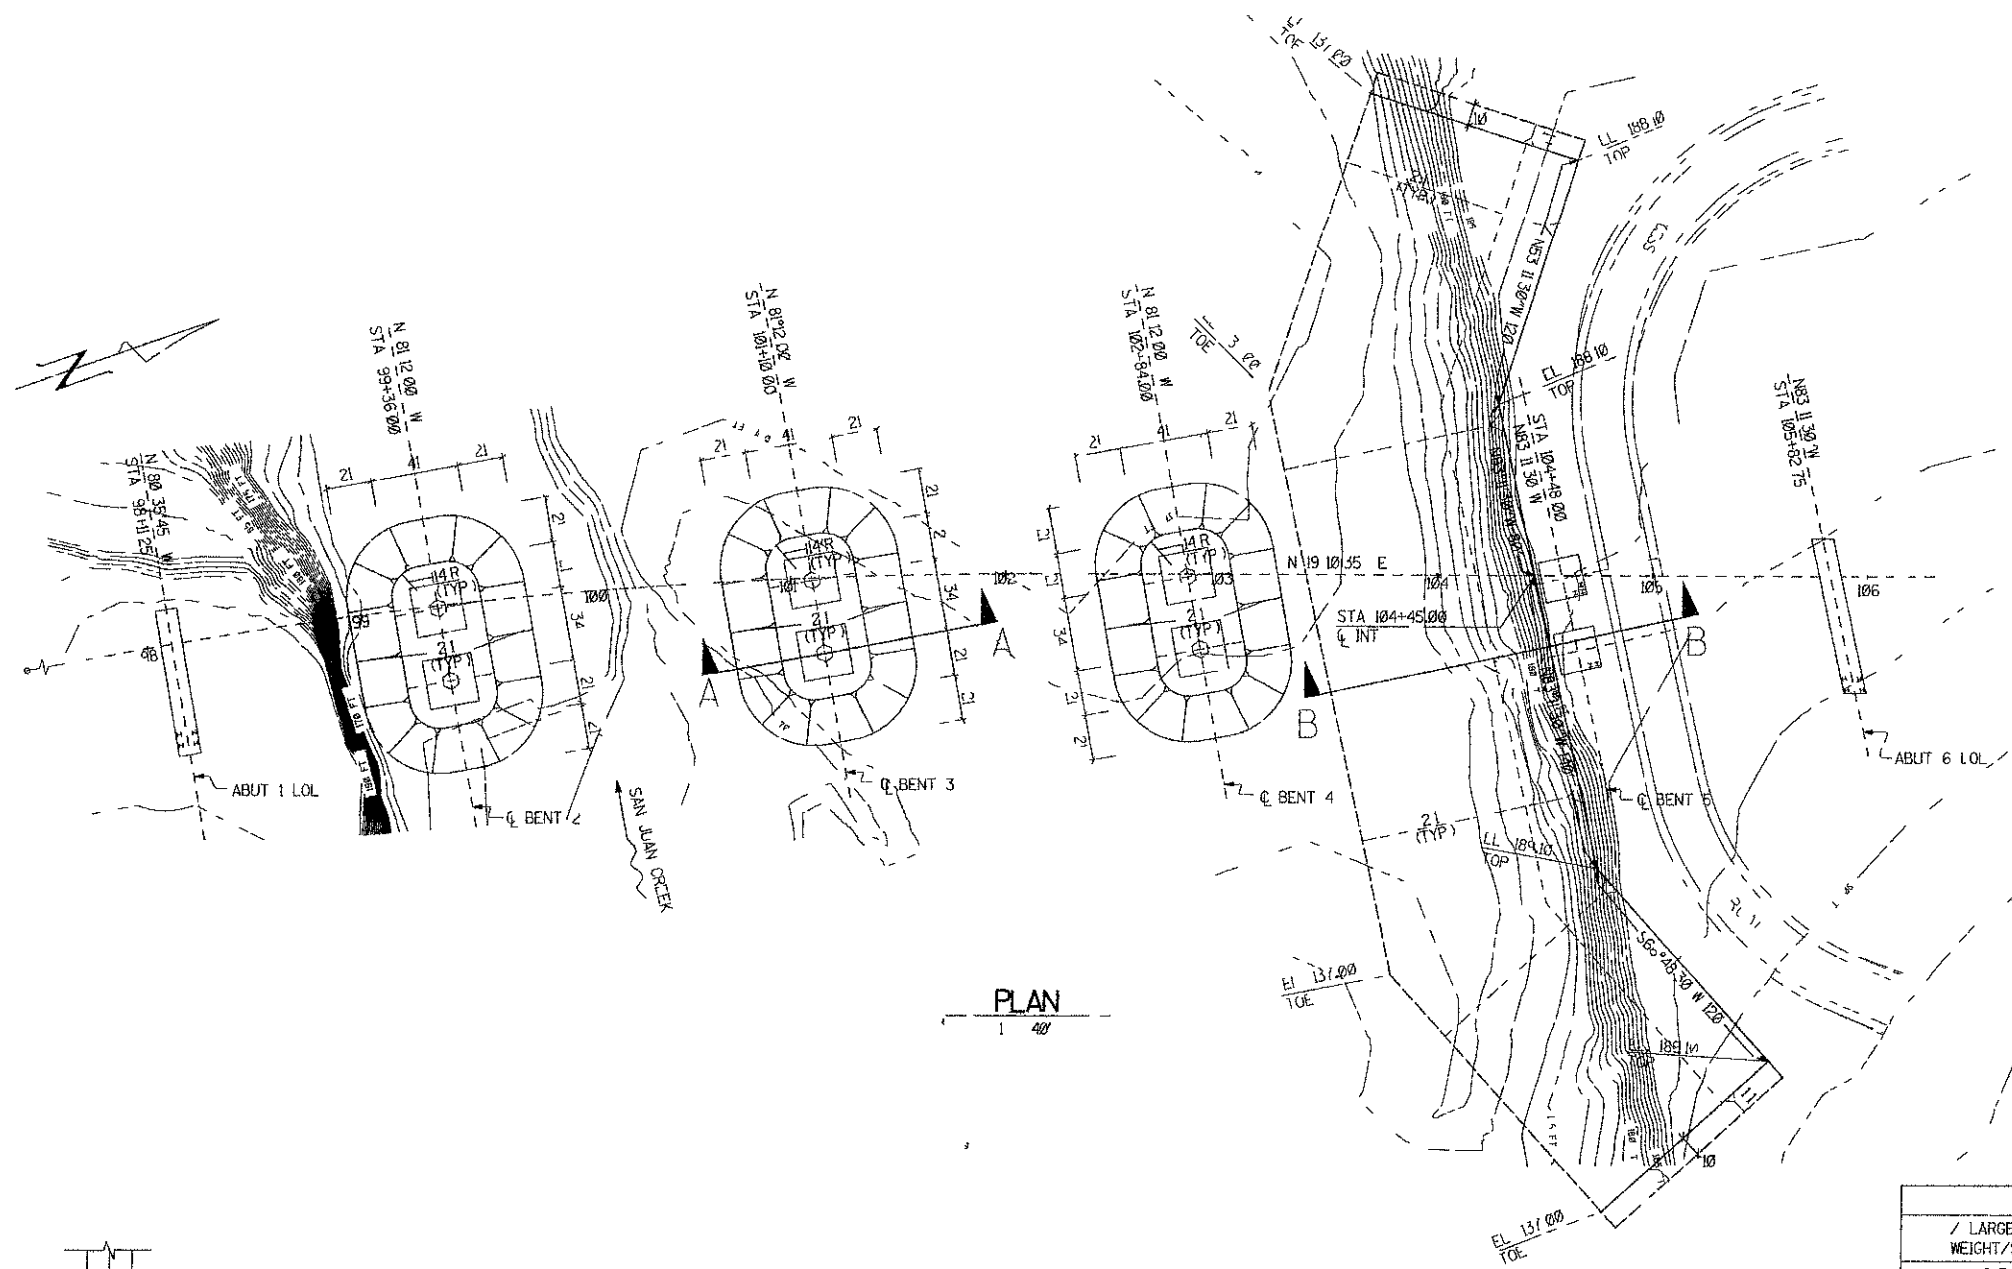

GRADATION		
/ LARGER BY WEIGHT/SIZE	RIPRAP (LB)	GRAVEL FILTER (INCHES)
2-5	1200	5
30-50	500	4
50-65	330	3
90-98	140	1

- NOTES
1. CONTOURS SHOWN ARE ORIGINAL GROUND
 2. CONTRACTOR SHALL VERIFY ALL CONTROLLING FIELD DIMENSIONS BEFORE ORDERING OR FABRICATING ANY MATERIALS

RECORD DRAWING


DR 3 (16158)
h ec OF 12n

PLANS PREPARED BY
sla
3150 BRISTOL STREET
SUITE 500
COSTA MESA CA 92626

ORANGE COUNTY ENVIRONMENTAL MANAGEMENT AGENCY	
ANTONIO PARKWAY BRIDGE OVER SAN JUAN CREEK	
EROSION PROTECTION PLAN	
DESIGNED JOHN LEE	24/27
DRAWN PF	CHECKED YHC
SCALE AS SHOWN	DATE 8-24-96
SHEET 72 OF 126	

BR #55C0628

DR 3 (16158)

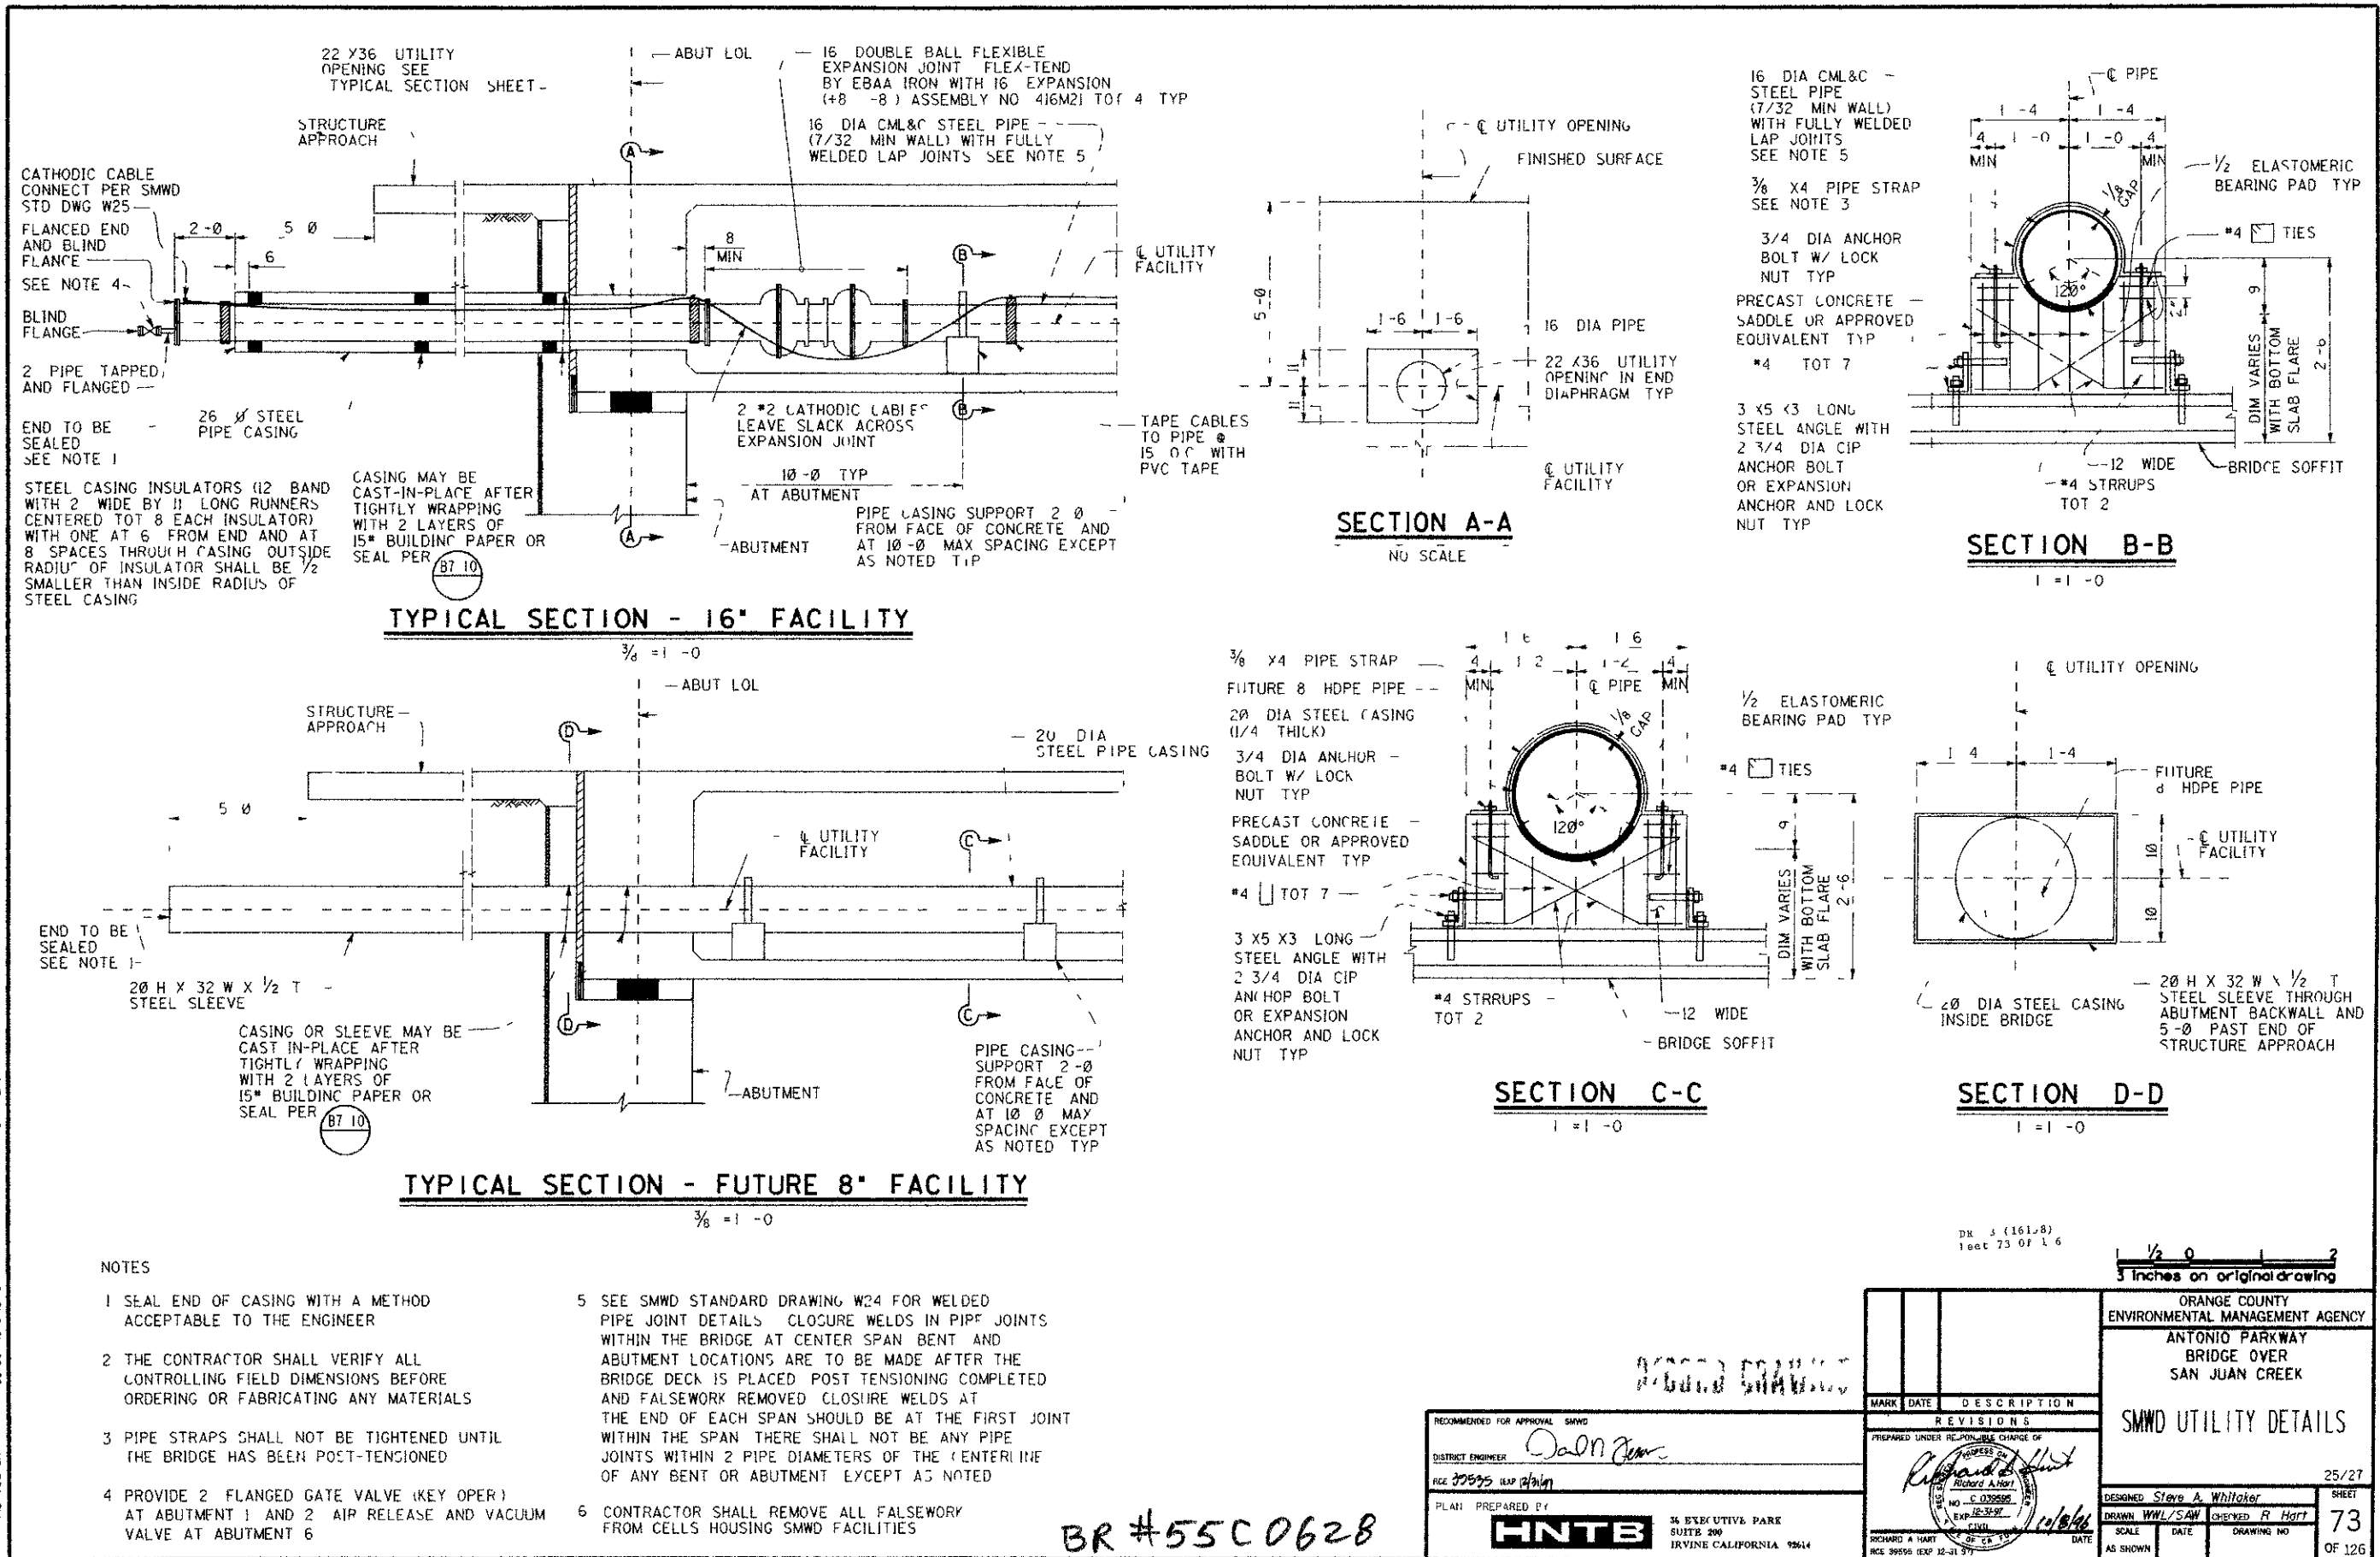

GOFFMAN MCCORMICK & URBAN INC	
PROJECT 95 48	PLATE 3

