

County of Orange




SANTA ANA, CALIFORNIA
SHANE L. SILSBY, DIRECTOR
PLANS FOR CONSTRUCTION OF

SILVERADO CANYON CREEK ROAD OVER SILVERADO CREEK BRIDGE PREVENTATIVE MAINTENANCE

BR. No. 55C0180

W.O. NO. ER 20556 AUGUST 2019

FUNDED BY: SENATE BILL 1(SB-1)
MAINTAINED BY: COUNTY OF ORANGE

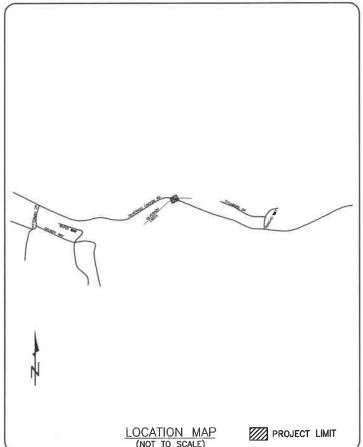

2015 CALTRANS STANDARD PLANS

A3A ABBREVIATIONS (SHEET 1 OF 3)
A3B ABBREVIATIONS (SHEET 2 OF 3)
A3C ABBREVIATIONS (SHEET 3 OF 3)

GENERAL NOTES:

CONTACT DIGALERT AT 1(800)422-4133 BEFORE REGINNING WORK

ALL NATIVE BIRDS ARE PROTECTED FROM DISTURBANCE WHILE NESTING. AS FAR AS POSSIBLE, CONSTRUCTION ACTIVITIES SHOULD TAKE PLACE OUTSIDE OF THE BIRD NESTING SEASON (FEBRUARY 1ST THROUGH SEPTEMBER 15TH), HOWEVER, IF OTHER RESTRICTIONS MAKE IT IMPOSSIBLE TO AVOID THE NESTING SEASON, THE REGULATORY PERMITTING TEAM AT OCPW MUST BE CONTACTED AT (714) 647-3933 TO ARRANGE FOR PRE-CONSTRUCTION NESTING BIRD SURVEYS OF THE CONSTRUCTION AREAS AT LEAST 7 OAYS BEFORE THE START OF WORK. DISTURBANCE TO ANY ACTIVE NESTS MUST BE AVOIDED. CONSTRUCTION ACTIVITY WITHIN 300 FEET OF AN ACTIVE NEST [500 FEET FOR RAPTORS] SHOULD BE DELAYED UNTIL THE NEST IS NO LONGER ACTIVE, OR OTHERWISE APPROVED BY THE REGULATORY PERMITTING TEAM OR THEIR REPRESENTATIVE.

ANY CRACKS OR CREVICES, VOIDS OR HOLES IN BRIDGES, TREES, BUILDINGS OR OTHER STRUCTURES HAVE THE POTENTIAL TO SUPPORT ROOSTING BATS. THE REGULATORY PERMITTING TEAM MUST BE CONTACTED AT (714) 647-3933 AT LEAST 7 DAYS BEFORE THE START OF WORK TO CONDUCT A BAT SURVEY.



RECORD DRAWING

CONTRACTOR:

RESIDENT ENGINEER:
INSPECTOR:

CONSTRUCTION START DATE:

CONSTRUCTION COMPLETION DATE:


PREPARED BY

PREPARED UNDER RESPONSIBLE CHARGE OF:
NCM ENGINEERING CORP.
22362 GILBERTO
RANCHO SANTA MARGARITA, CA 92688

INDEX OF SHEETS


SHEET	REF	DESCRIPTION
1	T1	TITLE SHEET
2	S1	GENERAL PLAN
3	S2	SPALL & CRACK REPAIR DETAILS


UTILITY OWNER	CONTACT	PHONE NO.
IRVINE RANCH WATER DISTRICT	BRIANNA PALECEK	(949) 453-5811
SCE DISTRIBUTION	JEFF LAMENDOLA	(949) 458-4667

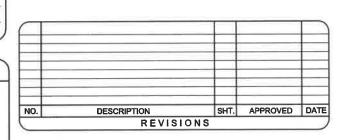

W. O. NO. <u>ER 20556</u> DWG. NO. <u>T1</u>

SHEET 1 OF 3

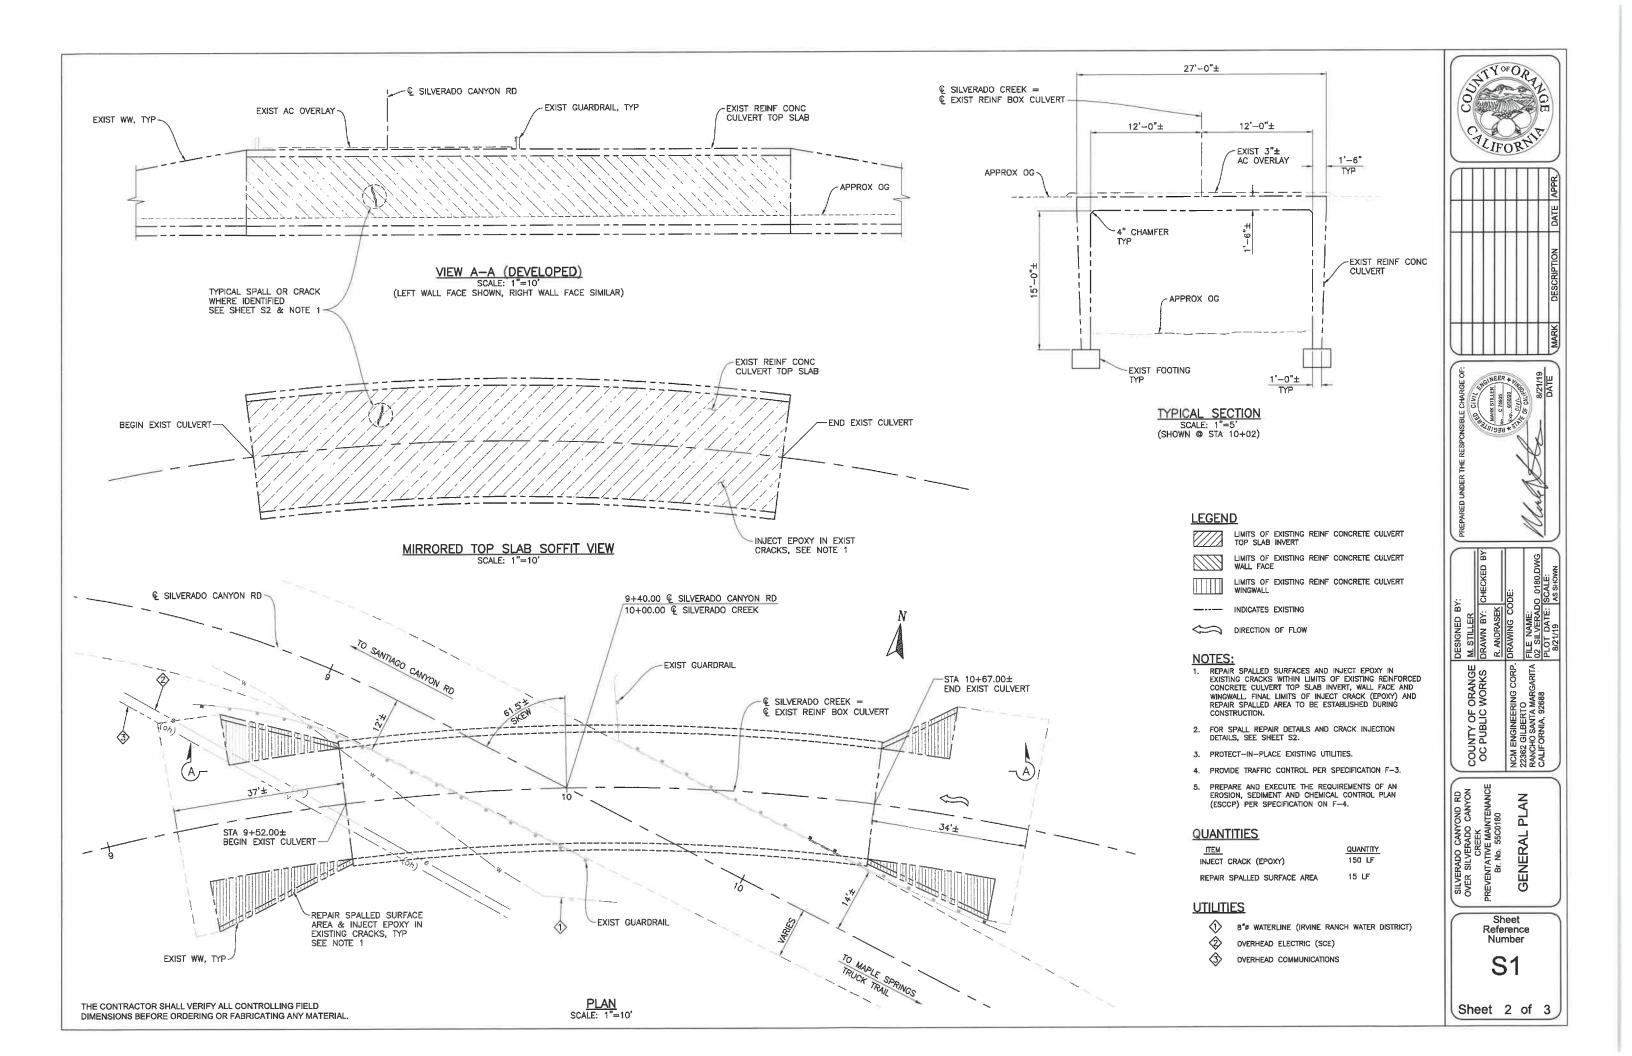

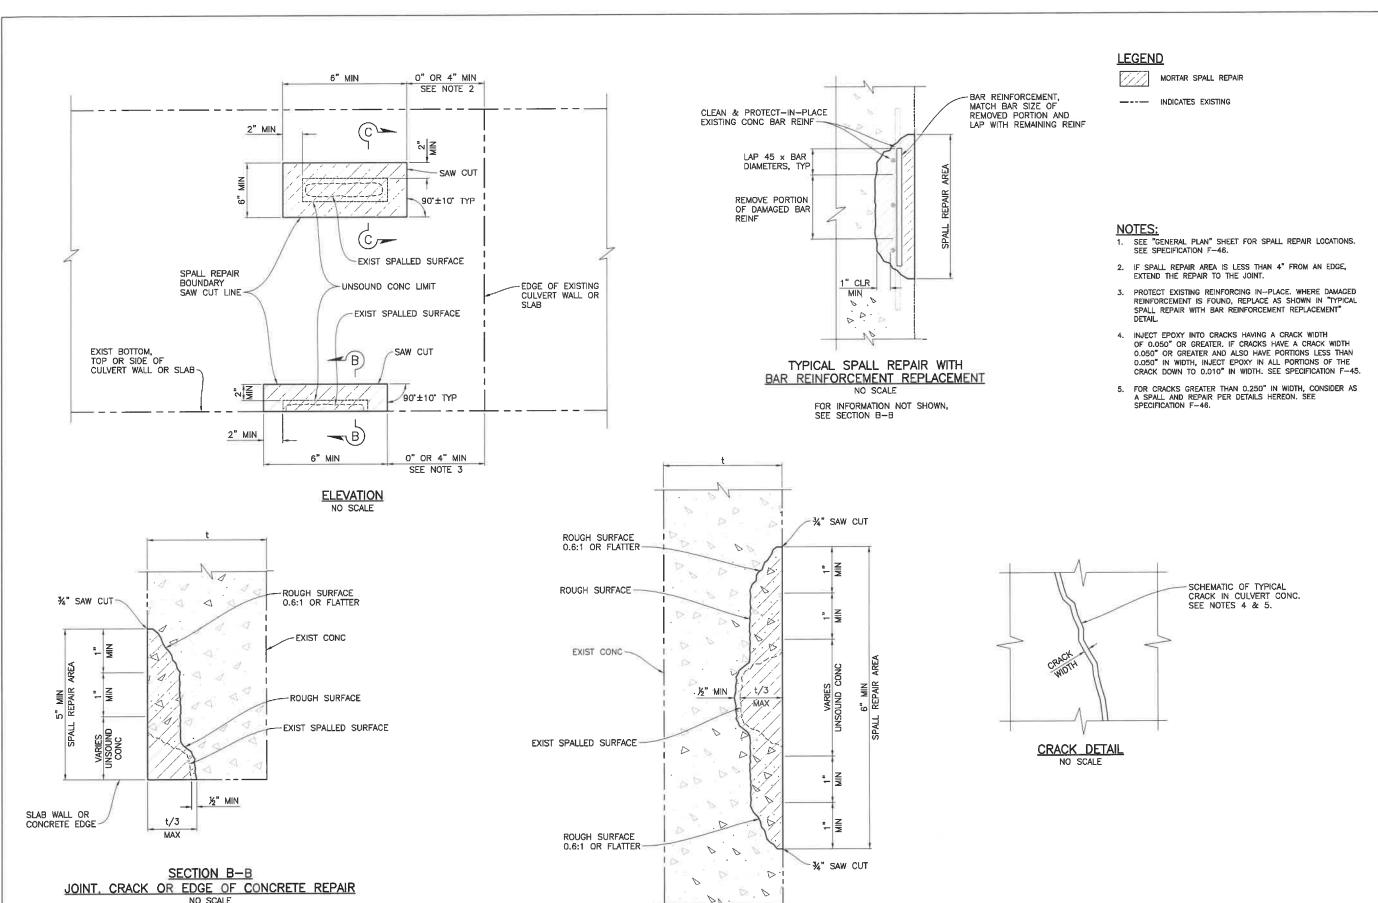







COUNTY OF ORANGE DESIGNED DITTER OC PUBLIC WORKS DRAWN BY CHECKED BY RANDRASEK DRAWNING CODE: 22362 GILBERTO FRANCHO SANTA MARGARITA GIS SILVERADO 0180.DWG CALIFORNIA, 92688 PLOT DATE: SCALE:	_					_
COUNTY OF ORANGE M. STILLER OC PUBLIC WORKS DRAWN BY ANDRASEK RANDRASEK DRAWNERTO DRAWNERTO RANCHO SANTA MARGARITA DELE NAME: CALIFORNIA, 92688 PLOT DATE:		CHECKED BY		DE:	D 0180.DWG	SCALE:
COUNTY OF ORANGE OC PUBLIC WORKS NCM ENGINEERING CORP. 22362 GILBERTO RANCHO SANTA MARGARITA CALIFORNIA, 92688	M. STILLER	DRAWN BY:	R. ANDRASEK	DRAWING CO	FILE NAME: 03 SILVERADO	PLOT DATE:
	COUNTY OF ORANGE OC PUBLIC WORKS NOM ENGINEERING CORP. 22362 GILBERTO RANCHO SANTA MARGARITA CALIFORNIA, 92688					
	_	_	_	_	_	_

OVER SILVERADO CANYON
CREEK
PREVENTATIVE MAINTENANCE
Br. No. 55C0180
SPALL & CRACK
REPAIR DETAILS

Sheet Reference Number

SZ

Sheet 3 of 3

THE CONTRACTOR SHALL VERIFY ALL CONTROLLING FIELD DIMENSIONS BEFORE ORDERING OR FABRICATING ANY MATERIAL.

SECTION C-C MISCELLANEOUS SPALL REPAIR NO SCALE