




Access Compliance Report - Public Rights-of-Way (Corridor: Sidewalk & Intersection Items)

Corridor ID: ANDAZA_ST_003

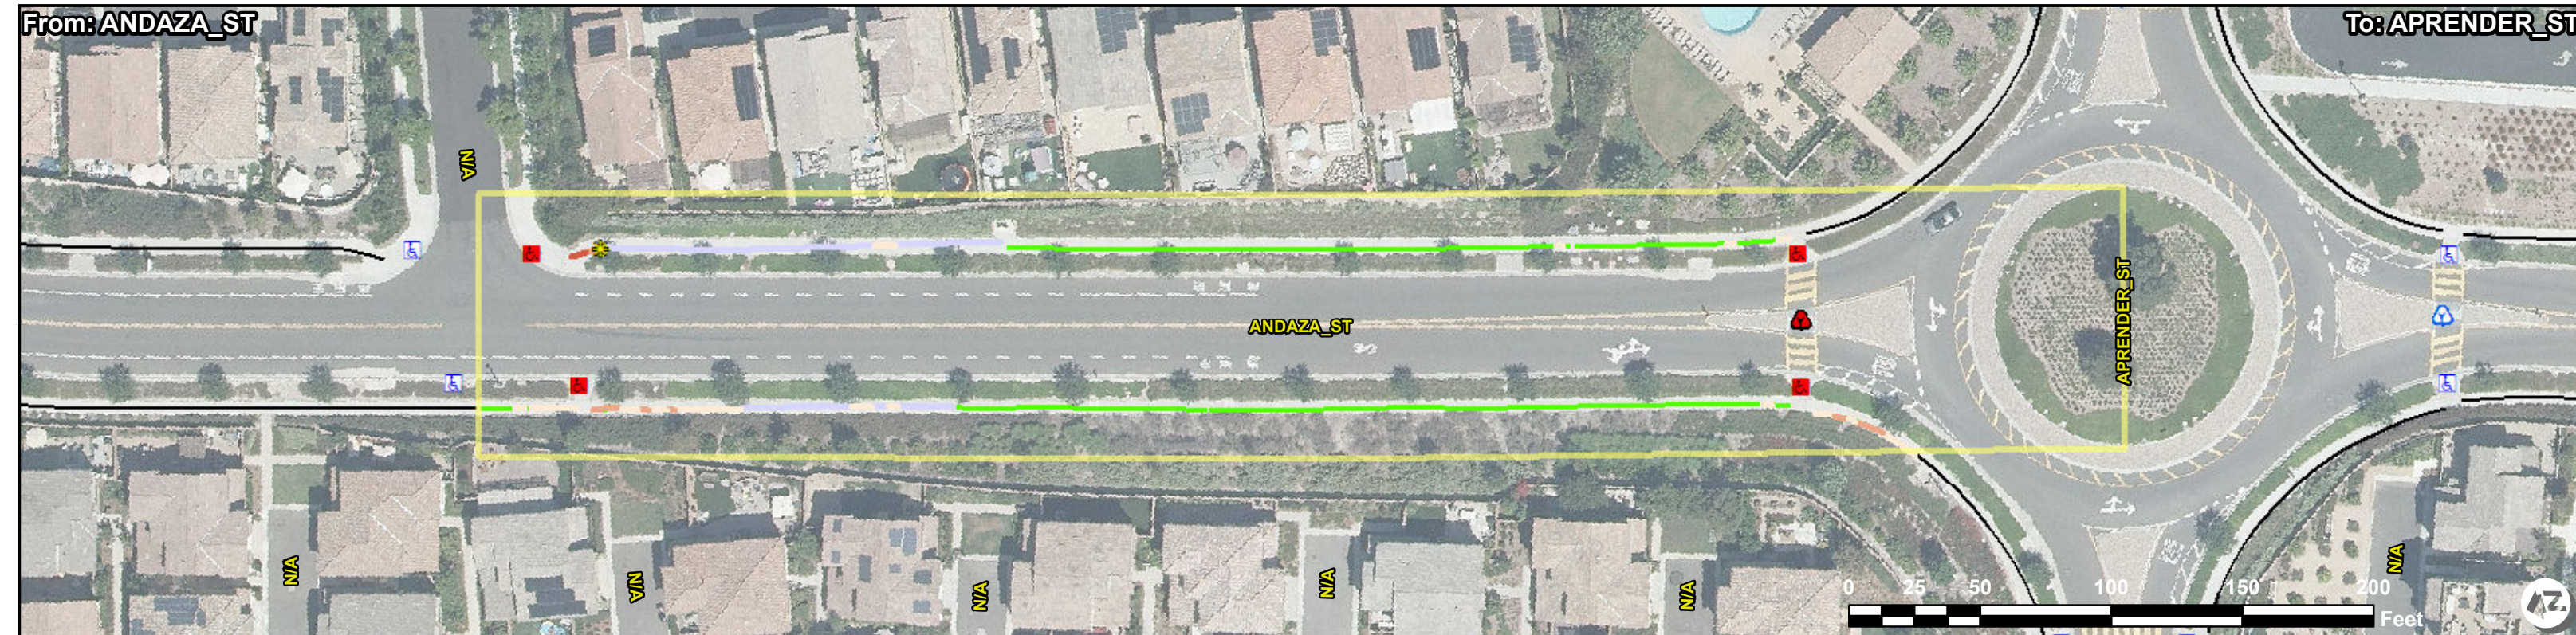

ADA Survey Summary

Item	Description	Quantity	Unit	Inventory Symbology
1	Vertical Displacement <= 1"	1	EA	Yellow diamond
2	Vertical Displacement > 1"	0	EA	Orange diamond
3	Uneven Vertical Displacement	0	EA	Red diamond
4	Horizontal Opening > 0.5"	0	EA	Purple diamond
5	Poor Surface Condition	0	SY	Yellow bar
6	Utility Obstruction	0	EA	Black circle
7	Power Pole Obstruction	0	EA	Blue circle
8	Traffic Signal Obstruction	0	EA	Pink circle
9	Sign Obstruction	0	EA	Grey circle
10	Low Vegetative Obstruction	0	EA	Light green circle
11	Overhead Vegetative Obstruction	0	EA	Dark green circle
12	Other Obstruction*	0	EA	White circle
13	Miscellaneous Obstruction	0	EA	Blue circle
14	Temp/Private Obstruction	0	EA	White circle
15	Commercial Driveway	0	LF	Purple square
16	Residential Driveway	0	LF	Pink square
17	Total Sidewalk Length Assessed	996	LF	Green line
18	Average Sidewalk Width	65	IN	Yellow line
19	Curb Ramps In Corridor	4	EA	Blue wheelchair icon
20	Island Curb Cuts In Corridor	1	EA	Blue island icon
21	Signal Push Buttons In Corridor	0	EA	Blue push button icon
22	Accessible Parking Spaces In Corridor	0	EA	Pink line
23	Missing Sidewalk/Gaps in Connectivity	0	LF	Orange line
24	Buried/Narrow Sidewalk	0	LF	Red line
25	Sidewalk Not Surveyed	0	LF	Blue line
26	No Sidewalk Observed	0	LF	Blue line
27	Corridor Severity Score	15.94		

ADA Compliance Cost Estimate **

Item	Description	Quantity	Unit	Unit Price	Item Cost	Compliance Symbology
1	Vertical Displacement <= 1"	1	EA	\$150.00	\$ 150.00	Yellow star
2	Vertical Displacement > 1"	0	EA	\$2125.00	\$ 0.00	Orange star
3	Uneven Vertical Displacement	0	EA	\$2125.00	\$ 0.00	Red star
4	Horizontal Opening > 0.5"	0	EA	\$1062.00	\$ 0.00	Purple star
5	Poor Surface Condition	0	SY	\$255.50	\$ 0.00	Yellow bar
6	Utility Obstruction	0	EA	\$5000.00	\$ 0.00	Black circle
7	Power Pole Obstruction	0	EA	\$20000.00	\$ 0.00	Blue circle
8	Traffic Signal Obstruction	0	EA	\$5000.00	\$ 0.00	Pink circle
9	Sign Obstruction	0	EA	\$2000.00	\$ 0.00	Grey circle
10	Low Vegetative Obstruction	0	EA	\$200.00	\$ 0.00	Light green circle
11	Overhead Vegetative Obstruction	0	EA	\$400.00	\$ 0.00	Dark green circle
12	Other Obstruction*	0	EA	\$2000.00	\$ 0.00	White circle
13	Miscellaneous Obstruction	0	EA	\$2000.00	\$ 0.00	Blue circle
14	Commercial Driveway	0	LF	\$118.00	\$ 0.00	Purple square
15	Residential Driveway	0	LF	\$118.00	\$ 0.00	Pink square
16	Running Slope Violation	0	SY	\$255.50	\$ 0.00	Blue line
17	Cross Slope Violation	53	SY	\$255.50	\$ 13648.00	Light green circle
18	Running and Cross Slope violations	41	SY	\$255.50	\$ 10574.00	Light green circle
19	Non-Compliant Curb Ramps and Total Cost*	4	EA	VARIABLES	\$ 12824.00	Blue wheelchair icon
20	Non-Compliant Island Curb Cuts and Total Cost*	1	EA	VARIABLES	\$ 504.00	Blue island icon
21	Non-Compliant Signal Push Buttons Cuts and Total Cost*	0	EA	VARIABLES	\$ 0.00	Blue push button icon
22	Non-Compliant Accessible Parking Spaces and Total Cost*	0	EA	VARIABLES	\$ 0.00	Pink line
23	Missing Sidewalk/Gap in Connectivity	0	SY	\$150.00	\$ 0.00	Orange line
24	Buried/Narrow Sidewalk	0	SY	\$255.50	\$ 0.00	Red line
Total:					\$ 37,701.00	

Google Street View Link
http://www.google.com/maps/@?api=1&map_action=pano&viewpoint=33.53799618,-117.59665

*Note: Some items combined for display. See Unit Cost Table for specific unit costs for each type of obstruction, curb ramp, island curb cut. Missing sidewalk/gaps in connectivity reported together in compliance report and are separate in the GIS layers.
 **Note: ADA pedestrian issues have been identified and quantified in the ADA Survey Summary. There are instances where multiple issues can be resolved with a single corrective measure. The ADA Compliance Cost Estimate reflects the best estimation of quantities and cost to resolve all identified ADA issues.