


From: CIRCULA\_PANORAMA

To: ALTA\_PANORAMA

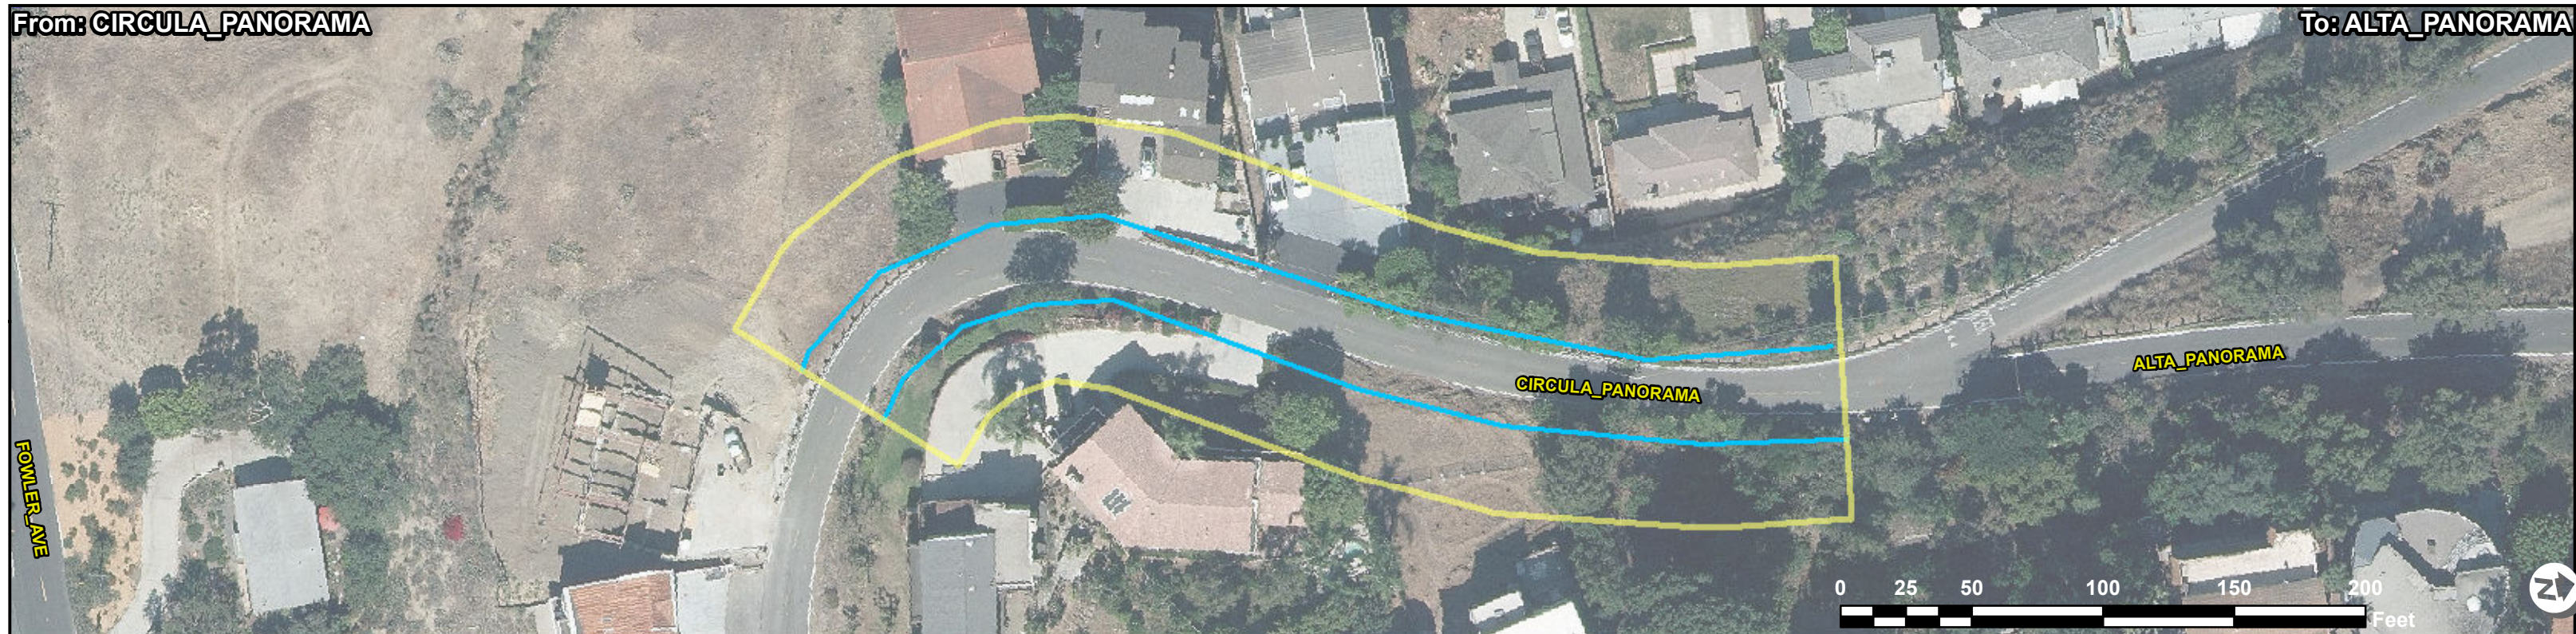

### ADA Survey Summary

Item	Description	Quantity	EA	SY	LF	IN
1	Vertical Displacement <= 1"	0	EA			
2	Vertical Displacement > 1"	0	EA			
3	Uneven Vertical Displacement	0	EA			
4	Horizontal Opening > 0.5"	0	EA			
5	Poor Surface Condition	0	SY			
6	Utility Obstruction	0	EA			
7	Power Pole Obstruction	0	EA			
8	Traffic Signal Obstruction	0	EA			
9	Sign Obstruction	0	EA			
10	Low Vegetative Obstruction	0	EA			
11	Overhead Vegetative Obstruction	0	EA			
12	Other Obstruction*	0	EA			
13	Miscellaneous Obstruction	0	EA			
14	Temp/Private Obstruction	0	EA			
15	Commercial Driveway	0	LF			
16	Residential Driveway	0	LF			
17	Total Sidewalk Length Assessed	0	LF			
18	Average Sidewalk Width	0	IN			
19	Curb Ramps In Corridor	0	EA			
20	Island Curb Cuts In Corridor	0	EA			
21	Signal Push Buttons In Corridor	0	EA			
22	Accessible Parking Spaces In Corridor	0	EA			
23	Missing Sidewalk/Gaps in Connectivity	0	LF			
24	Buried/Narrow Sidewalk	0	LF			
25	Sidewalk Not Surveyed	0	LF			
26	No Sidewalk Observed	815	LF			
27	Corridor Severity Score	0				

Inventory Symbology	Description
Yellow diamond	Running Slope (Aligned, Not Costed)
Light blue line	5.1 – 8.3%
Medium blue line	8.4 – 10.0%
Dark blue line	10.1 – 12.5%
Blue line	12.5%+
Black circle	Collection in Adjacent Corridors
Blue square with white circle	Curb Ramps
Blue circle with white circle	Island Curb Cuts
Blue circle with white circle	Signal Push Buttons
Black line	Sidewalk Collection
Green line	
Pink line	
Orange line	
Blue line	

### ADA Compliance Cost Estimate \*\*

Item	Description	Quantity	Unit	Unit Price	Item Cost
1	Vertical Displacement <= 1"	0	EA	\$150.00	\$ 0.00
2	Vertical Displacement > 1"	0	EA	\$2125.00	\$ 0.00
3	Uneven Vertical Displacement	0	EA	\$2125.00	\$ 0.00
4	Horizontal Opening > 0.5"	0	EA	\$1062.00	\$ 0.00
5	Poor Surface Condition	0	SY	\$255.50	\$ 0.00
6	Utility Obstruction	0	EA	\$5000.00	\$ 0.00
7	Power Pole Obstruction	0	EA	\$20000.00	\$ 0.00
8	Traffic Signal Obstruction	0	EA	\$5000.00	\$ 0.00
9	Sign Obstruction	0	EA	\$2000.00	\$ 0.00
10	Low Vegetative Obstruction	0	EA	\$200.00	\$ 0.00
11	Overhead Vegetative Obstruction	0	EA	\$400.00	\$ 0.00
12	Other Obstruction*	0	EA	\$2000.00	\$ 0.00
13	Miscellaneous Obstruction	0	EA	\$2000.00	\$ 0.00
14	Commercial Driveway	0	LF	\$118.00	\$ 0.00
15	Residential Driveway	0	LF	\$118.00	\$ 0.00
16	Running Slope Violation	0	SY	\$255.50	\$ 0.00
17	Cross Slope Violation	0	SY	\$255.50	\$ 0.00
18	Running and Cross Slope violations	0	SY	\$255.50	\$ 0.00
19	Non-Compliant Curb Ramps and Total Cost*	0	EA	VARIABLES	\$ 0.00
20	Non-Compliant Island Curb Cuts and Total Cost*	0	EA	VARIABLES	\$ 0.00
21	Non-Compliant Signal Push Buttons Cuts and Total Cost*	0	EA	VARIABLES	\$ 0.00
22	Non-Compliant Accessible Parking Spaces and Total Cost*	0	EA	VARIABLES	\$ 0.00
23	Missing Sidewalk/Gap in Connectivity	0	SY	\$150.00	\$ 0.00
24	Buried/Narrow Sidewalk	0	SY	\$255.50	\$ 0.00
<b>Total:</b>					<b>\$ 0.00</b>

Compliance Symbology	Description
Green square with white circle	Compliant Curb Ramp
Red square with white circle	Non-Compliant Curb Ramp
Green circle with white circle	Compliant Island Curb Cut
Red circle with white circle	Non-Compliant Island Curb Cut
Green square	Compliant Signal
Red square	Non-Compliant Signal
Light orange line	Cross Slope 2.01 - 3.0%
Orange line	Cross Slope 3.01 - 4.0%
Dark orange line	Cross Slope 4.01 - 5.0%
Red line	Cross Slope 5.01%+
Light blue line	Running Slope (Deviated, Costed) 5.1 – 8.3%
Medium blue line	Running Slope (Deviated, Costed) 8.4 – 10.0%
Dark blue line	Running Slope (Deviated, Costed) 10.1 – 12.5%
Blue line	Running Slope (Deviated, Costed) 12.5%+