

GENERAL NOTES:

- A. THIS PLAN IS BEING GENERATED TO DOCUMENT AS-BUILT CONDITIONS, AND TO REVIEW THE IN PLACE TRAFFIC SIGNAL INSTALLATION TO VERIFY COMPLIANCE WITH CURRENT APPLICABLE REGULATIONS. UNDERGROUND UTILITY CONSTRUCTION IS NOT A PART OF THE ENGINEER'S REVIEW, BUT IS SHOWN FOR INFORMATIONAL PURPOSES ONLY PER PREVIOUS AS-BUILT PLANS.
- B. TRAFFIC SIGNAL AND HIGHWAY LIGHTING CONSTRUCTION SHOWN HEREON CONFORMED TO THE VERSION OF THE STATE OF CALIFORNIA DEPARTMENT OF TRANSPORTATION STANDARD PLANS AND SPECIFICATIONS AND THE CALIFORNIA MANUAL OF UNIFORM TRAFFIC CONTROL DEVICES THAT WAS CURRENT AT THE TIME THE TRAFFIC SIGNAL WAS INSTALLED.
- C. TRAFFIC SIGNAL PHASING AND SIGNAL TIMING IN PLACE AT THE INTERSECTION SHALL BE AS DIRECTED BY THE CITY ENGINEER OR HIS DESIGNATED REPRESENTATIVE.


EXISTING SIGN ON THIS SHEET




EQUIPMENT SCHEDULE

POLE LOCATION	SIGNAL STANDARD			LUMINAIRE SIZE/TYPE	MOUNTINGS			PEDESTRIAN PUSH BUTTON			POLE LOCATION		I.I.S.N.S.
	TYPE	MAST ARM			VEHICLE		PEDESTRIAN	PHASE	TYPE	QUAD	A	B	
		SIG.	LUM.		POLE	MAST ARM							
(A)	26-4-70	40'	12'	250W	SV-1-T	2-MAS	*SP-1-CS	ø4	A	E	EXISTING	EXISTING	Park Lantern → ←Doheny State Beach
(B)	1-A	-	-	-	TV-1-T	-	*SP-1-CS	ø6	A	S	EXISTING	EXISTING	-
(C)	19-2-70	25'	12'	250W	SV-2-TA	MAS	*SP-1-CS	ø6	B	S	EXISTING	EXISTING	Dana Point Harbor Dr
(D)	1-A	-	-	-	TV-1-T	-	*SP-1-CS	ø8 / ø6	A / A	W / S	EXISTING	EXISTING	-
(E)	24-4-70	35'	12'	250W	SV-1-T	2-MAS	*SP-1-CS	ø8	B	W	EXISTING	EXISTING	← Park Lantern Doheny State Beach →
(F)	1-A	-	-	-	TV-1-T	-	*SP-1-CS	ø2 / ø8	B / A	N / W	EXISTING	EXISTING	-
(G)	17-2-70	20'	12'	250W	SV-1-T	MAS	*SP-1-CS	ø2	B	N	EXISTING	EXISTING	Dana Point Harbor Dr
(H)	1-A	-	-	-	TV-2-T	-	*SP-1-CS	ø4 / ø2	B / A	E / N	EXISTING	EXISTING	-

ALL EQUIPMENT IS EXISTING.
* = PEDESTRIAN INDICATION HEADS SHALL BE DIALITE COUNTDOWN HEADS, MUTCD COMPLIANT.
(A) = ANAODE PUSH BUTTON, (B) = BULL DOG PUSH BUTTON.
• = BIKE PUSH BUTTON.

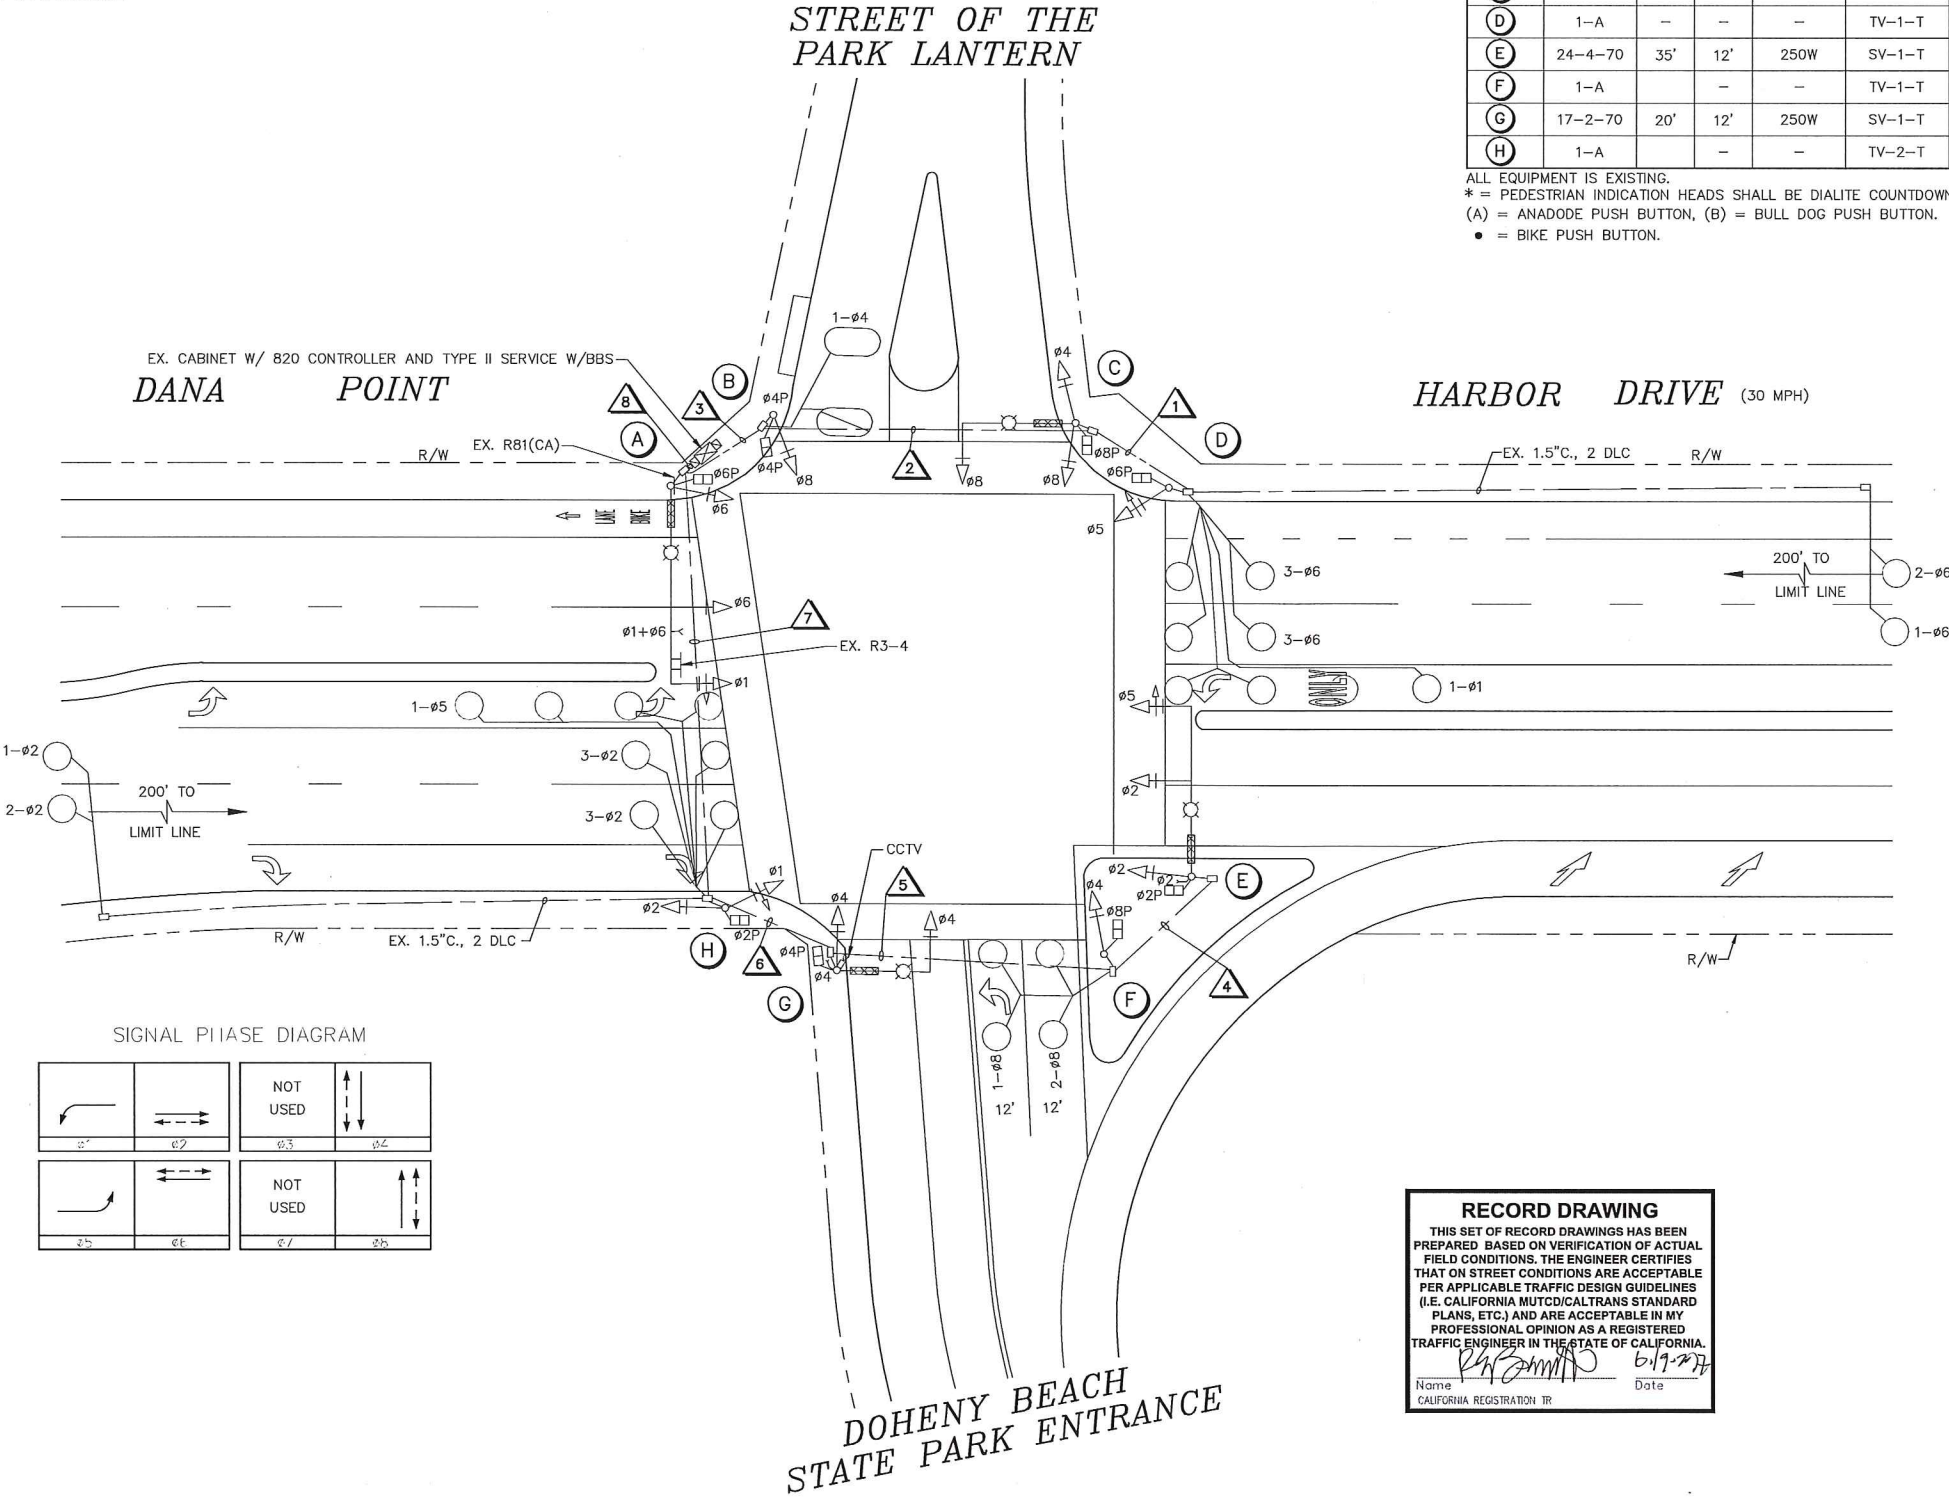

SIGNAL PHASE DIAGRAM

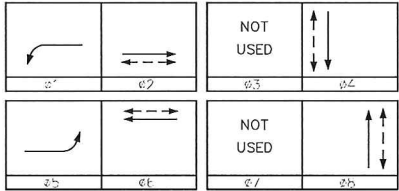


CONDUCTOR SCHEDULE

AWG	CIRCUIT	1	2	3	4	5	6	7	8
#14	Ø1	-	-	-	-	-	-	3	3
	Ø2	-	-	3	3	3	3	3	3
	Ø4	-	3	3	-	3	3	3	6
	Ø5	3	3	3	3	3	3	3	6
	Ø6	-	-	-	-	-	-	-	3
	Ø8	-	3	3	-	-	-	-	3
	Ø2P	-	-	-	2	2	2	2	2
	Ø4P	-	-	2	-	-	2	2	4
	Ø6P	2	2	2	-	-	-	-	2
	Ø8P	-	2	2	-	2	2	2	4
	Ø2PPB	-	-	-	1	1	1	1	1
	Ø4PPB	-	-	-	-	-	1	1	2
	Ø6PPB	-	1	1	-	-	-	-	1
	Ø8PPB	1	1	1	1	1	1	1	2
#10	PPB COMMON	1	1	1	1	1	1	1	2
	ILLUM. ST. NAME SIGN	-	1	1	1	1	1	1	2
	SPARES	3	3	3	3	3	3	3	6
	TOTAL	11	21	23	14	21	23	28	55
TYPE "B" DLC	SIGNAL & SIGN COMMON	1	1	1	1	1	1	1	2
	LUMINAIRE	-	2	2	2	2	2	2	4
	TOTAL	1	3	3	3	3	3	3	6
	Ø1	1	1	1	-	-	-	-	1
	Ø2	-	-	-	-	-	3	3	3
	Ø4	-	-	1	-	-	-	-	1
CCTV	Ø5	-	-	-	-	-	1	1	1
	Ø6	3	3	3	-	-	-	-	3
	Ø8	-	-	-	-	2	2	2	2
	TOTAL	4	4	5	-	2	2	6	11
CCTV		-	-	-	-	-	1	1	1
EVPE		-	-	-	1	1	2	2	3
CONDUIT SIZE		2 1/2"	2 1/2"	3"	2-3"	3"	2"	2"	2"

ALL CONDUCTORS AND CONDUITS ARE EXISTING.
PPB = PED PUSH BUTTON
BPB = BIKE PUSH BUTTON

RECORD DRAWING
THIS SET OF RECORD DRAWINGS HAS BEEN PREPARED BASED ON VERIFICATION OF ACTUAL FIELD CONDITIONS. THE ENGINEER CERTIFIES THAT ON STREET CONDITIONS ARE ACCEPTABLE PER APPLICABLE TRAFFIC DESIGN GUIDELINES (I.E. CALIFORNIA MUTCD/CALTRANS STANDARD PLANS, ETC.) AND ARE ACCEPTABLE IN MY PROFESSIONAL OPINION AS A REGISTERED TRAFFIC ENGINEER IN THE STATE OF CALIFORNIA.
Norme
CALIFORNIA REGISTRATION TR

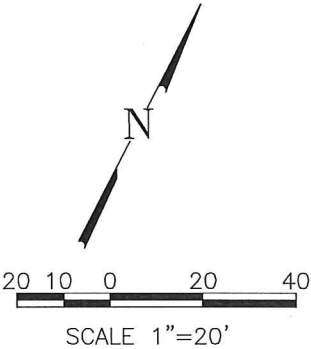

PLAN PREPARED BY: LINSCOTT, LAW & GREENSPAN, ENGINEERS TRANSPORTATION PLANNING - TRAFFIC ENGINEERING - PARKING 600 South Lake Avenue, Suite 500, Pasadena, CA 91106 (626) 796-2322 2 Executive Circle, Suite 250, Irvine, CA 92614 (949) 825-6175 4542 Ruffner Street, Suite 100, San Diego, CA 92111 (619) 300-8800	PLANS REVIEWED BY: CITY OF DANA POINT, PUBLIC WORKS & ENGINEERING SERVICES 33282 GOLDEN LANTERN DANA POINT, CA 92629 <i>Matthew V. Sinacori</i> 6/26/17 MATTHEW V. SINACORI, CITY ENGINEER RCE #59239 EXP. 06/30/17 DATE	TRAFFIC SIGNAL PLAN DANA POINT HARBOR DRIVE AT STREET OF THE PARK LANTERN THE CITY OF DANA POINT Public Works Department	PROJECT NO. 2-16-3741 SHEET 1 OF 1	
NO.	DATE	REVISIONS	APP.	DATE